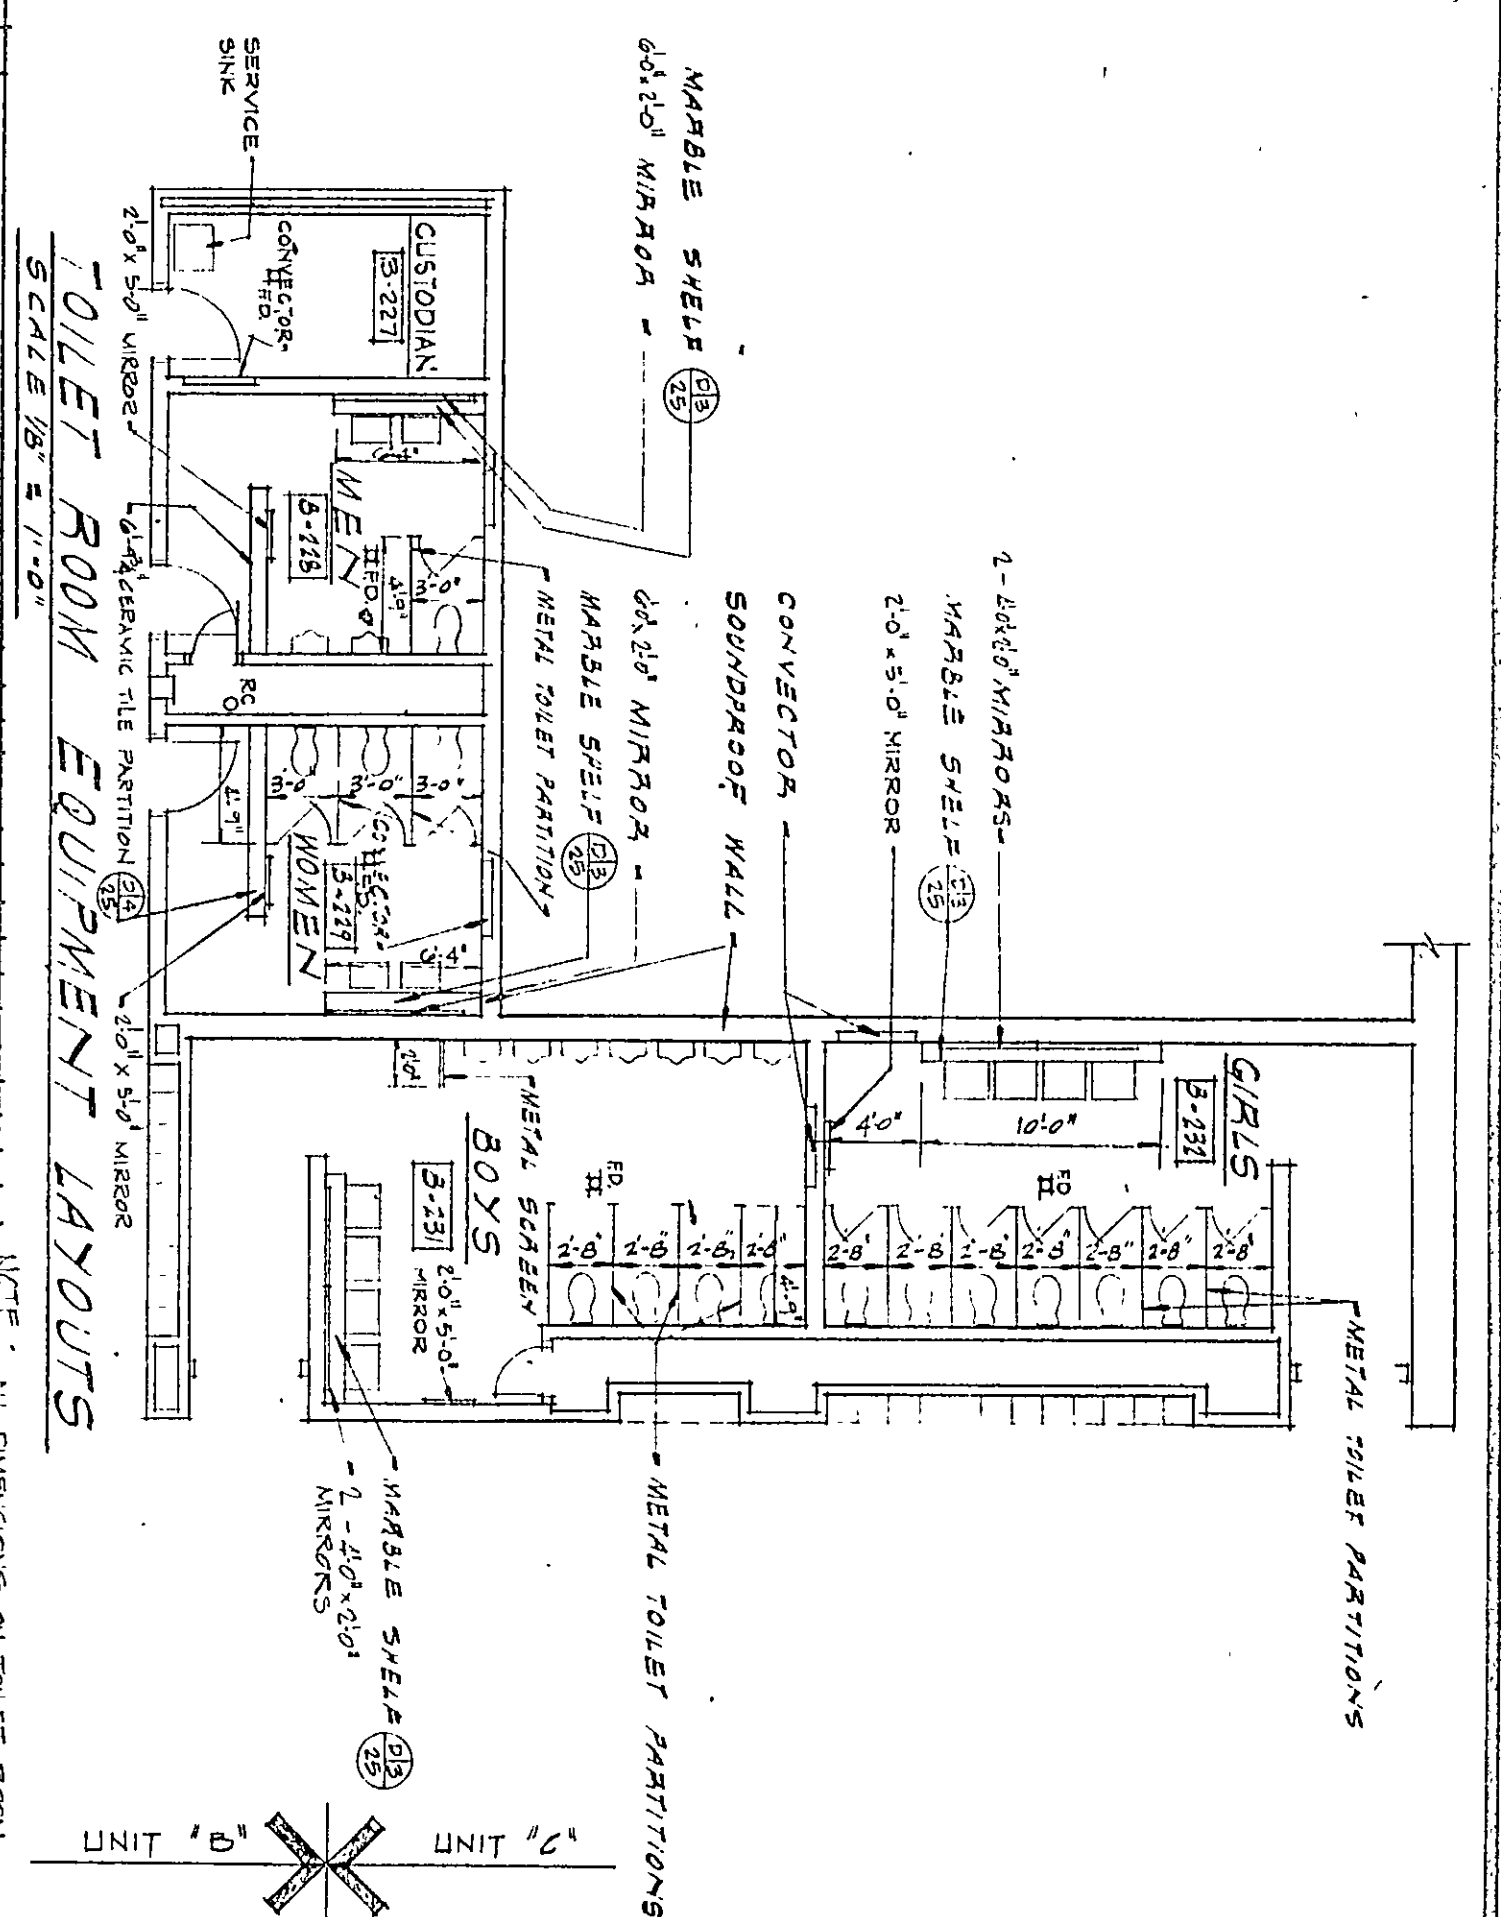
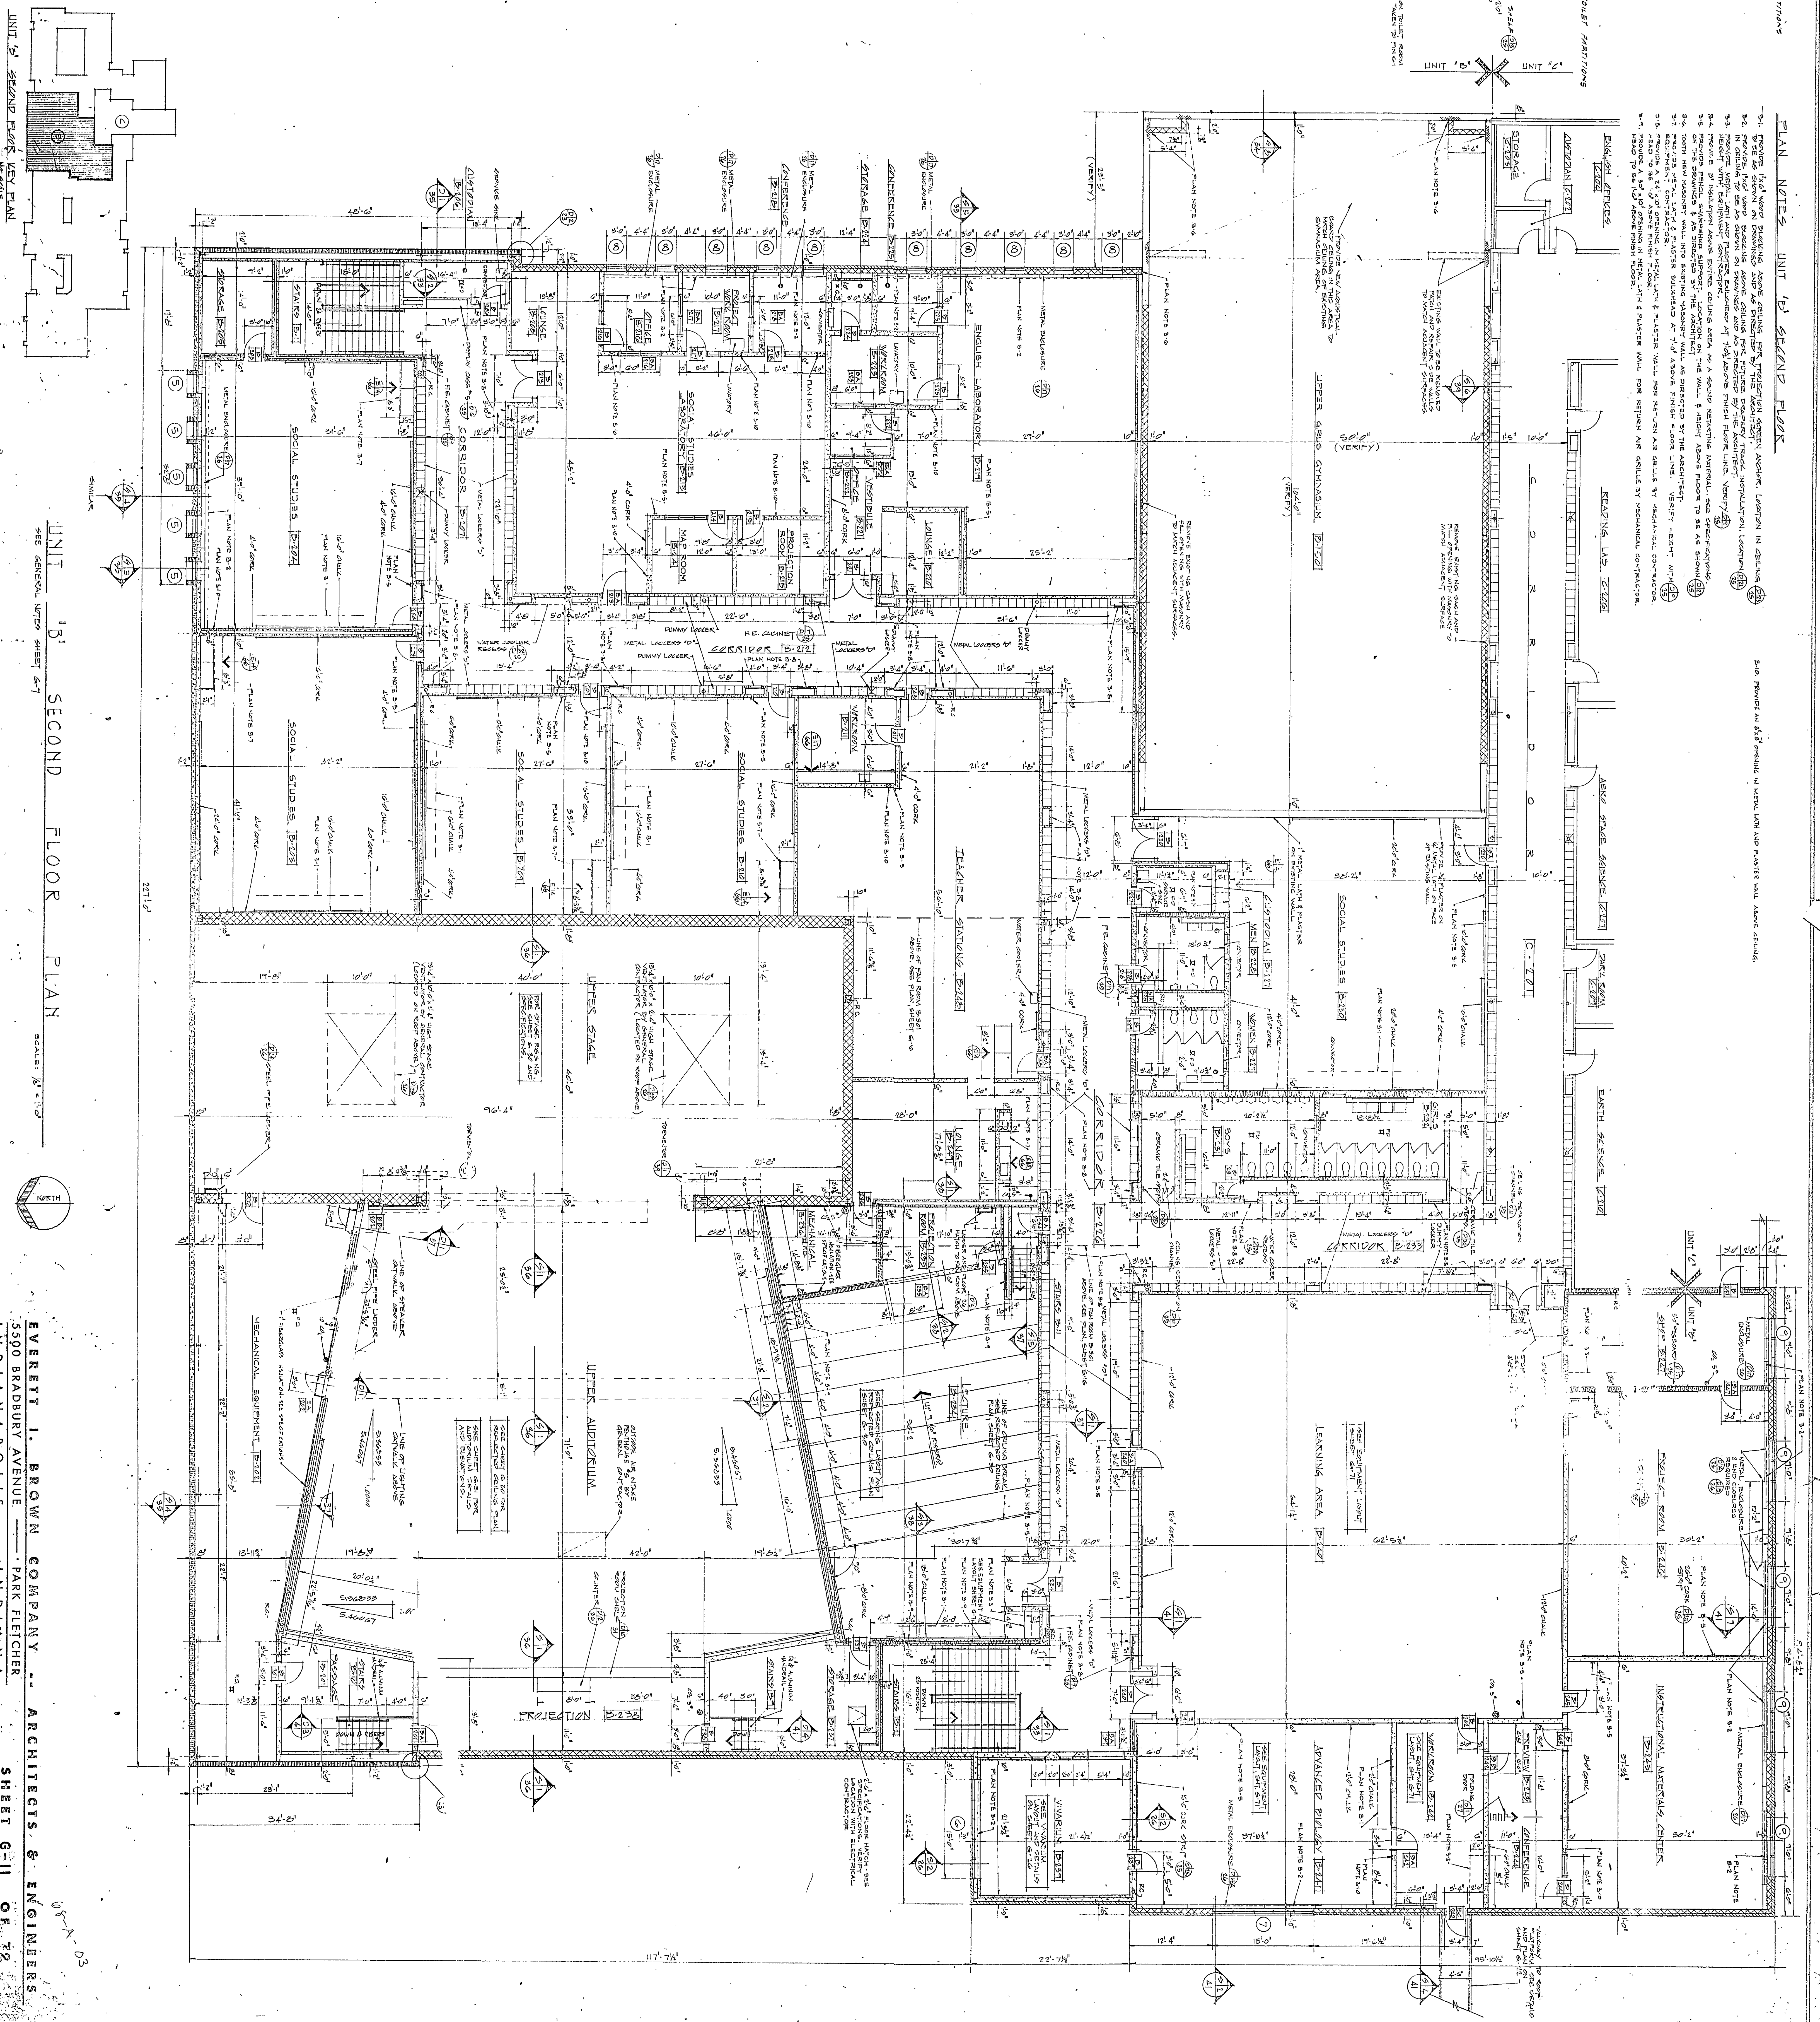


[illegible]

ROOM		FLOOR		WALL		CEILING		WINDOW		REMARKS		FAB WALL COVERING		FAB WALL COVERING		
NO.	NAME	MATERIAL	BASE	MATERIAL	MATERIAL	HGT.	MATERIAL	MATERIAL	N	S	E	W	N	S	E	W
B-231	BOYS	CARPET	3 7/8" CARPET TILE	CERAMIC PLASTER	ACCOUSTICAL TILE	9'-0"	ACCOUSTICAL TILE	MARBLE METAL								
B-232	GIRLS	CARPET	3 7/8" CARPET TILE	CERAMIC PLASTER	ACCOUSTICAL TILE	9'-0"	ACCOUSTICAL TILE	MARBLE METAL								
B-233	EXERCISE	VINYL ASBESTOS	3 7/8" CARPET TILE	CERAMIC PLASTER	ACCOUSTICAL TILE	9'-0"	ACCOUSTICAL TILE	MARBLE METAL								
B-234	LECTURE	VINYL ASBESTOS	3 7/8" CARPET TILE	CERAMIC PLASTER	ACCOUSTICAL TILE	9'-0"	ACCOUSTICAL TILE	MARBLE METAL								
B-235	PROJECTION ROOM	VINYL ASBESTOS	3 7/8" CARPET TILE	CERAMIC PLASTER	ACCOUSTICAL TILE	9'-0"	ACCOUSTICAL TILE	MARBLE METAL								
B-236	MECHANICAL	VINYL ASBESTOS	3 7/8" CARPET TILE	CERAMIC PLASTER	ACCOUSTICAL TILE	9'-0"	ACCOUSTICAL TILE	MARBLE METAL								
B-237	STORAGE	VINYL ASBESTOS	3 7/8" CARPET TILE	CERAMIC PLASTER	ACCOUSTICAL TILE	9'-0"	ACCOUSTICAL TILE	MARBLE METAL								
B-238	PROJECTION	VINYL ASBESTOS	3 7/8" CARPET TILE	CERAMIC PLASTER	ACCOUSTICAL TILE	9'-0"	ACCOUSTICAL TILE	MARBLE METAL								
B-239	VIVARIUM	VINYL ASBESTOS	3 7/8" CARPET TILE	CERAMIC PLASTER	ACCOUSTICAL TILE	9'-0"	ACCOUSTICAL TILE	MARBLE METAL								
B-240	LEARNING AREA	VINYL ASBESTOS	3 7/8" CARPET TILE	CERAMIC PLASTER	ACCOUSTICAL TILE	9'-0"	ACCOUSTICAL TILE	MARBLE METAL								
B-241	ADVANCED ENGINEER	VINYL ASBESTOS	3 7/8" CARPET TILE	CERAMIC PLASTER	ACCOUSTICAL TILE	9'-0"	ACCOUSTICAL TILE	MARBLE METAL								
B-242	WORK ROOM	VINYL ASBESTOS	3 7/8" CARPET TILE	CERAMIC PLASTER	ACCOUSTICAL TILE	9'-0"	ACCOUSTICAL TILE	MARBLE METAL								
B-243	PREVIEW	VINYL ASBESTOS	3 7/8" CARPET TILE	CERAMIC PLASTER	ACCOUSTICAL TILE	9'-0"	ACCOUSTICAL TILE	MARBLE METAL								
B-244	CONFERENCE	VINYL ASBESTOS	3 7/8" CARPET TILE	CERAMIC PLASTER	ACCOUSTICAL TILE	9'-0"	ACCOUSTICAL TILE	MARBLE METAL								
B-245	WATER MATERIALS CENTER	VINYL ASBESTOS	3 7/8" CARPET TILE	CERAMIC PLASTER	ACCOUSTICAL TILE	9'-0"	ACCOUSTICAL TILE	MARBLE METAL								
B-246	PROJECT ROOM	VINYL ASBESTOS	3 7/8" CARPET TILE	CERAMIC PLASTER	ACCOUSTICAL TILE	9'-0"	ACCOUSTICAL TILE	MARBLE METAL								
B-247	SHOP	VINYL ASBESTOS	3 7/8" CARPET TILE	CERAMIC PLASTER	ACCOUSTICAL TILE	9'-0"	ACCOUSTICAL TILE	MARBLE METAL								
B-248	TEACHER STATIONS	VINYL ASBESTOS	3 7/8" CARPET TILE	CERAMIC PLASTER	ACCOUSTICAL TILE	9'-0"	ACCOUSTICAL TILE	MARBLE METAL								
B-249	LOUNGE	VINYL ASBESTOS	3 7/8" CARPET TILE	CERAMIC PLASTER	ACCOUSTICAL TILE	9'-0"	ACCOUSTICAL TILE	MARBLE METAL								
B-1	STAIRS															
B-2	STAIRS															

NOTE: COMPRESS CONCRETE SLAB 5" FOR CARPET. SEE GENERAL NOTE #10
SEE SHEET 694 FOR CARPET BASE DETAILS

[illegible]

EVERETT I. BROWN COMPANY - ARCHITECTS & ENGINEERS
3590 BRADBURY AVENUE - PARK FLETCHER
INDIANAPOLIS, INDIANA
SHEET 6-11 OF 72
AS BUILT