

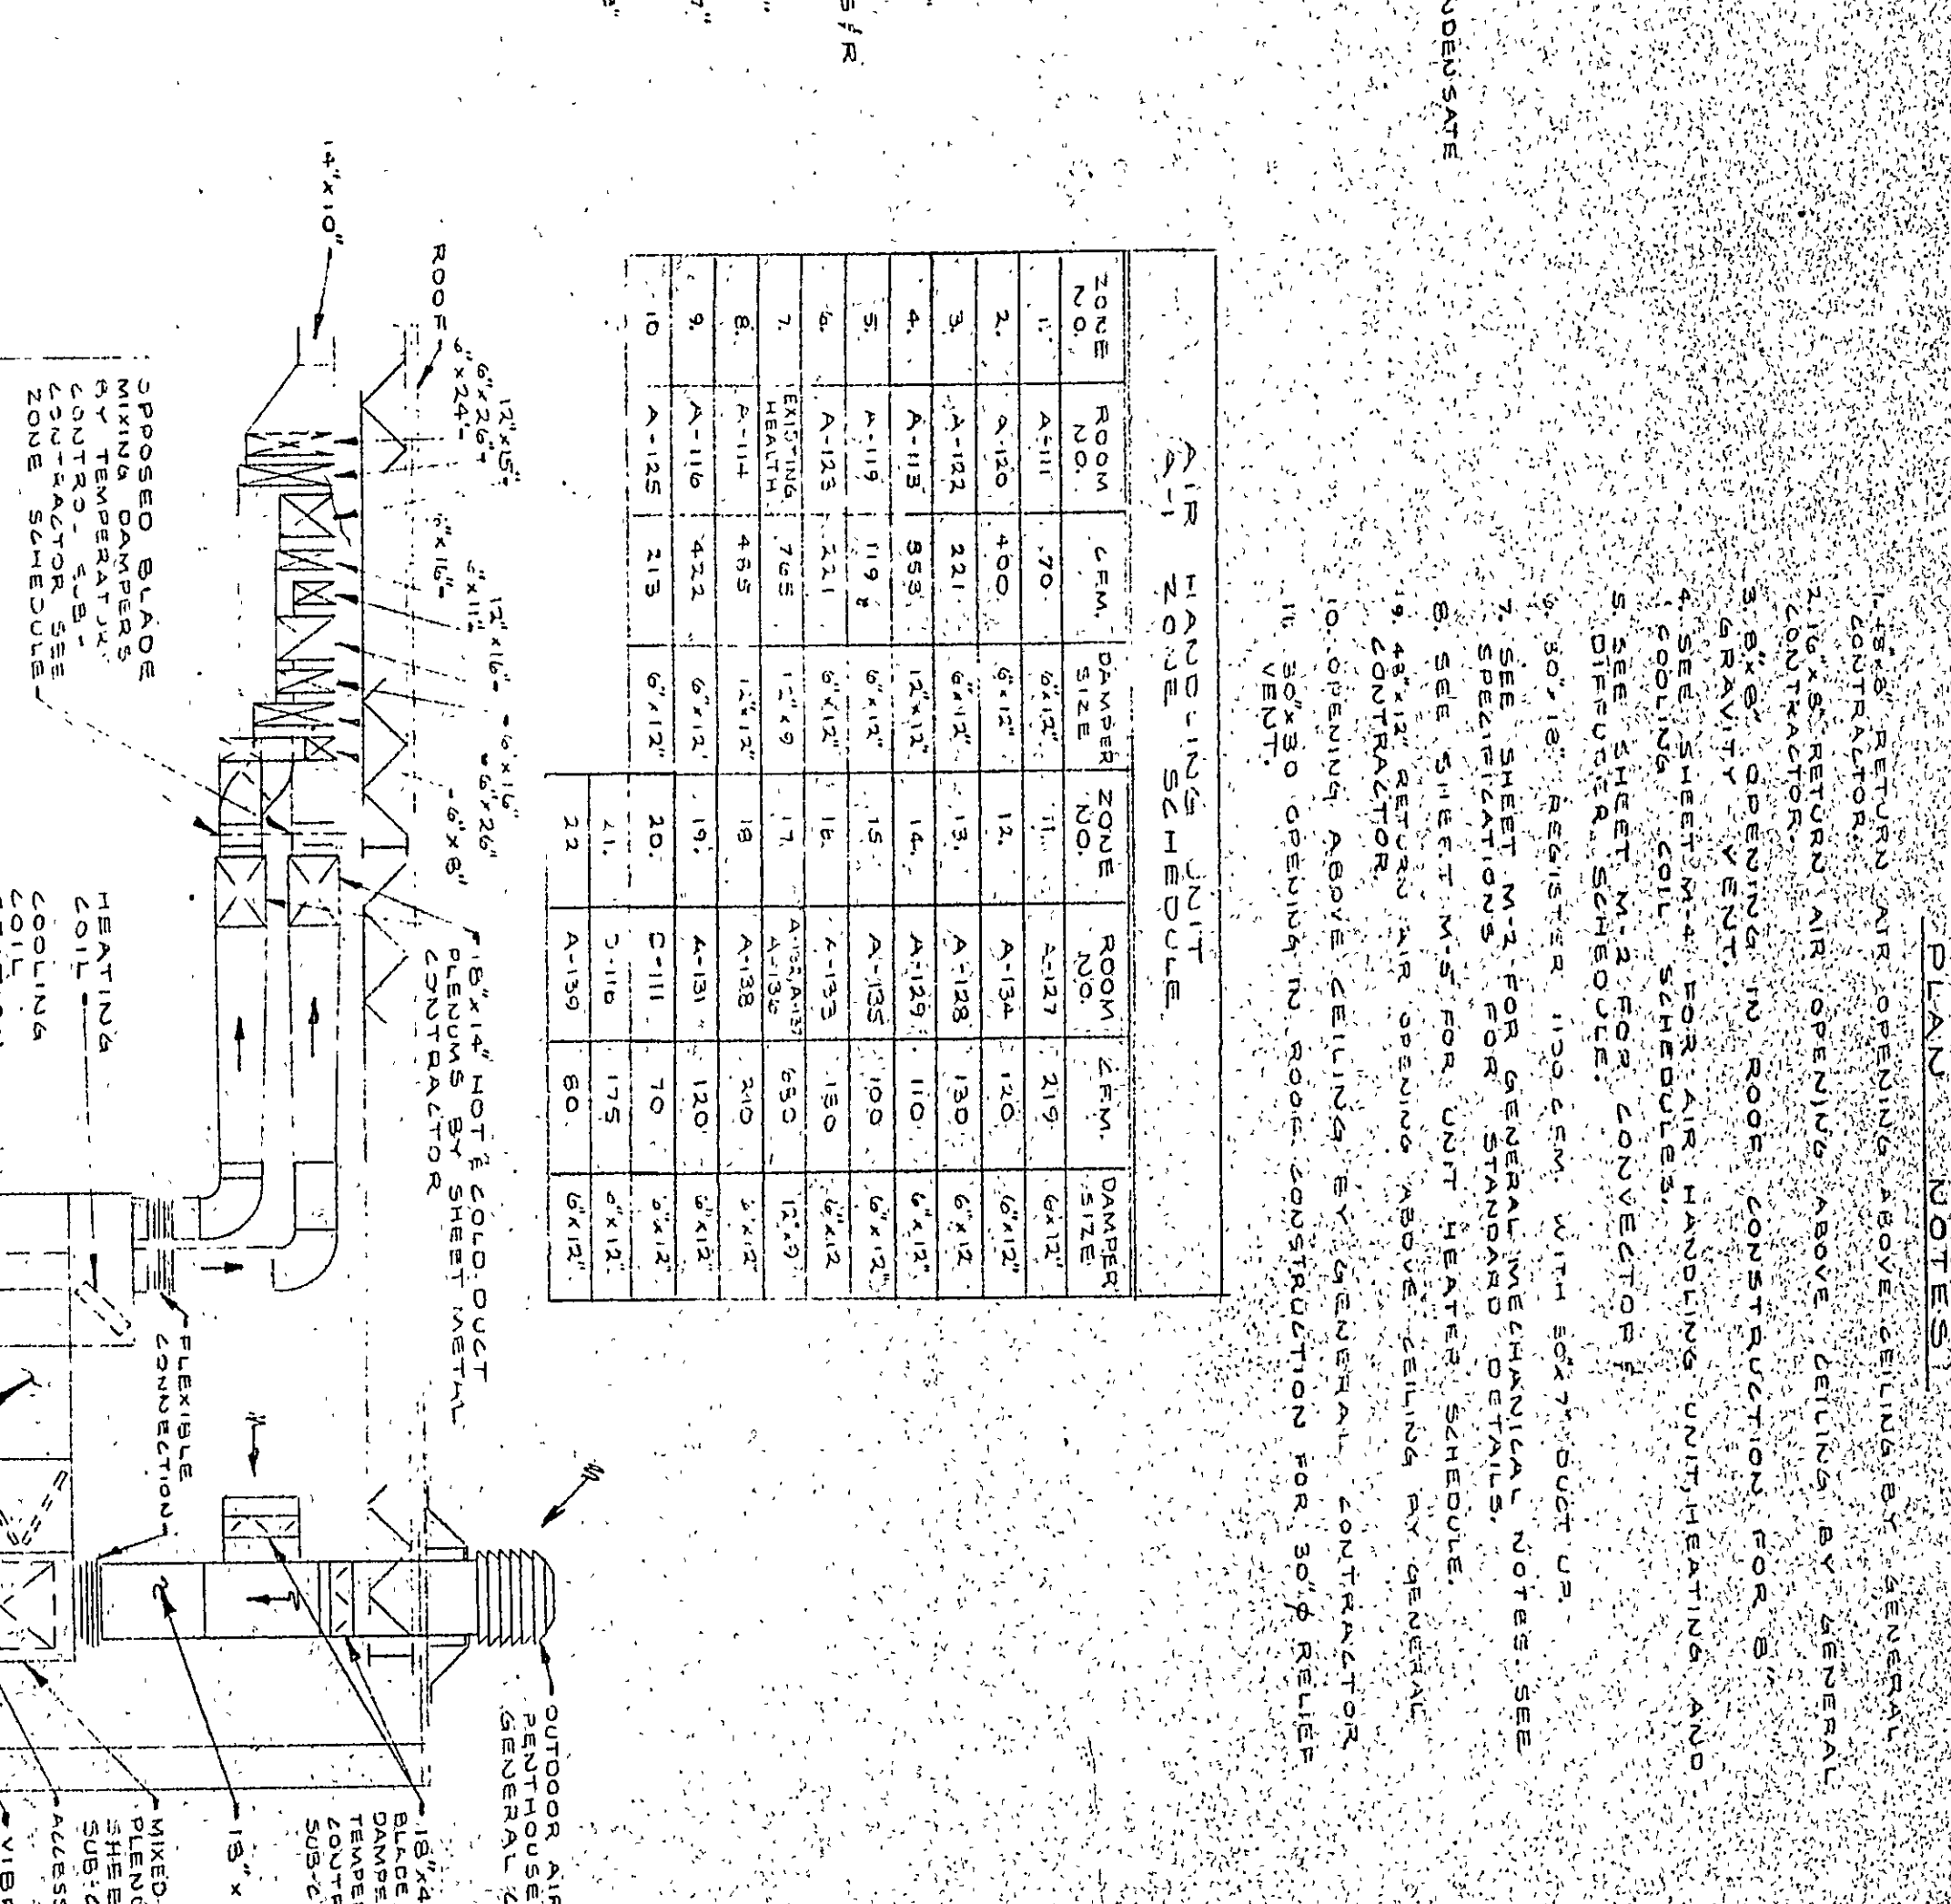
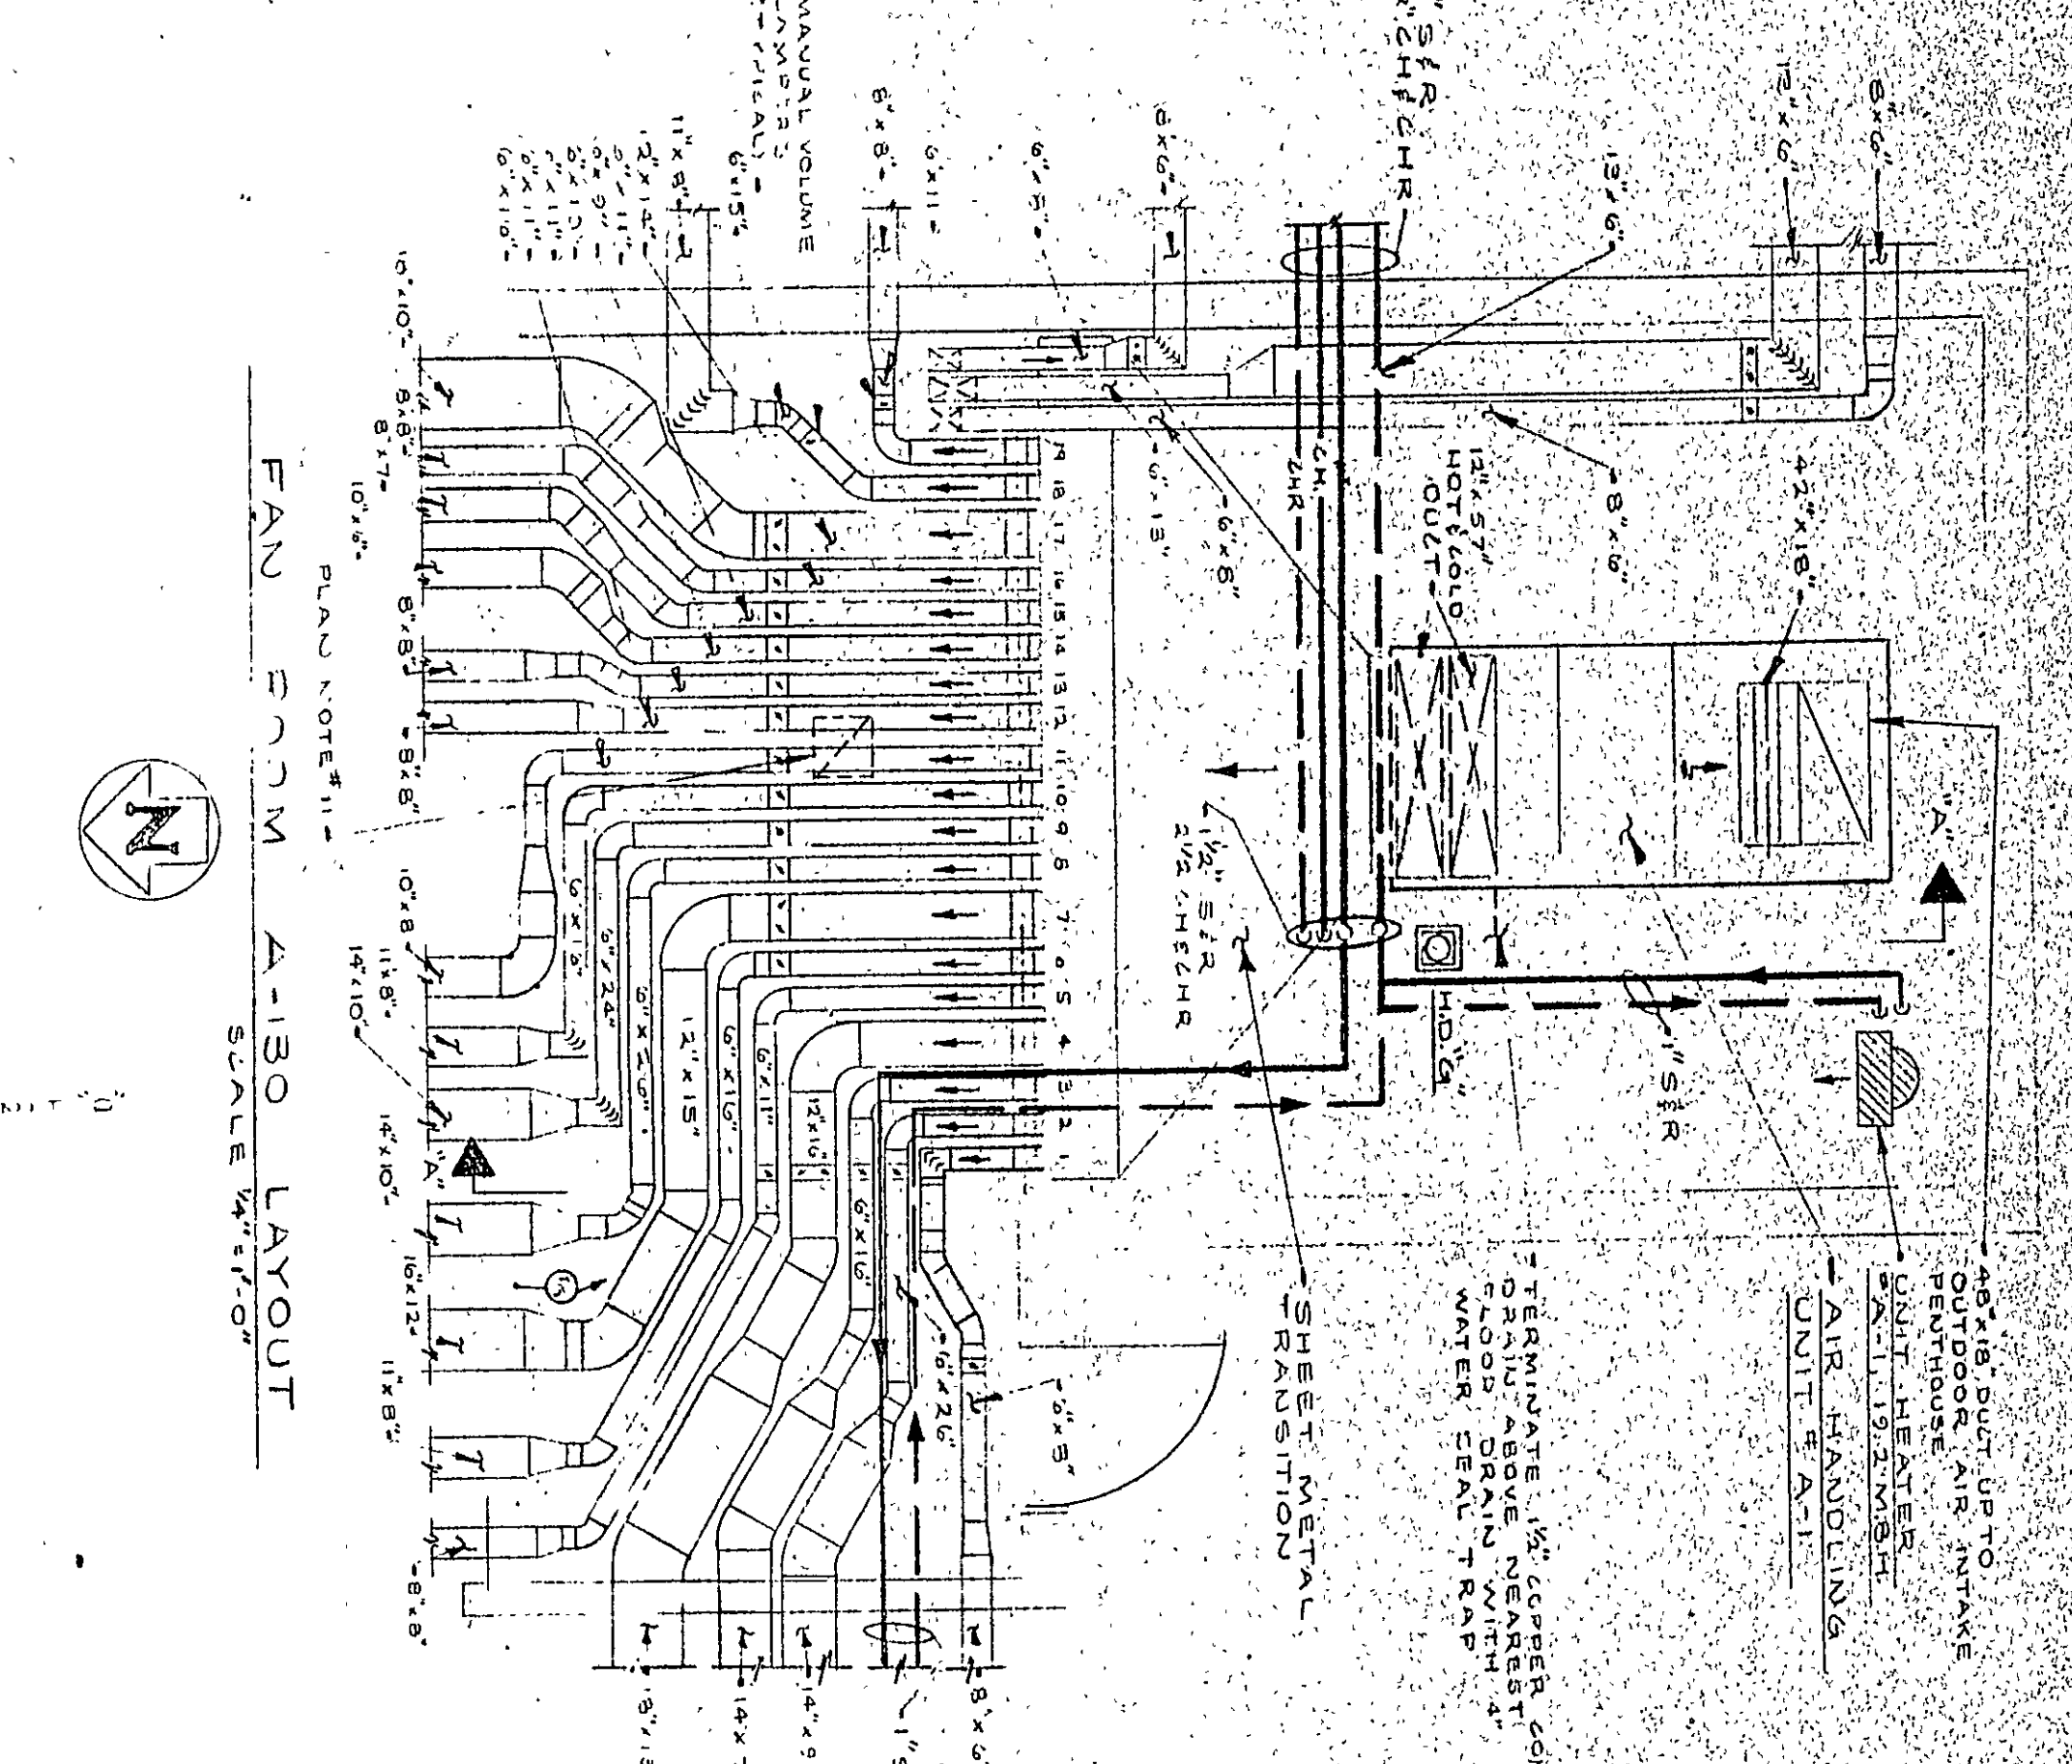
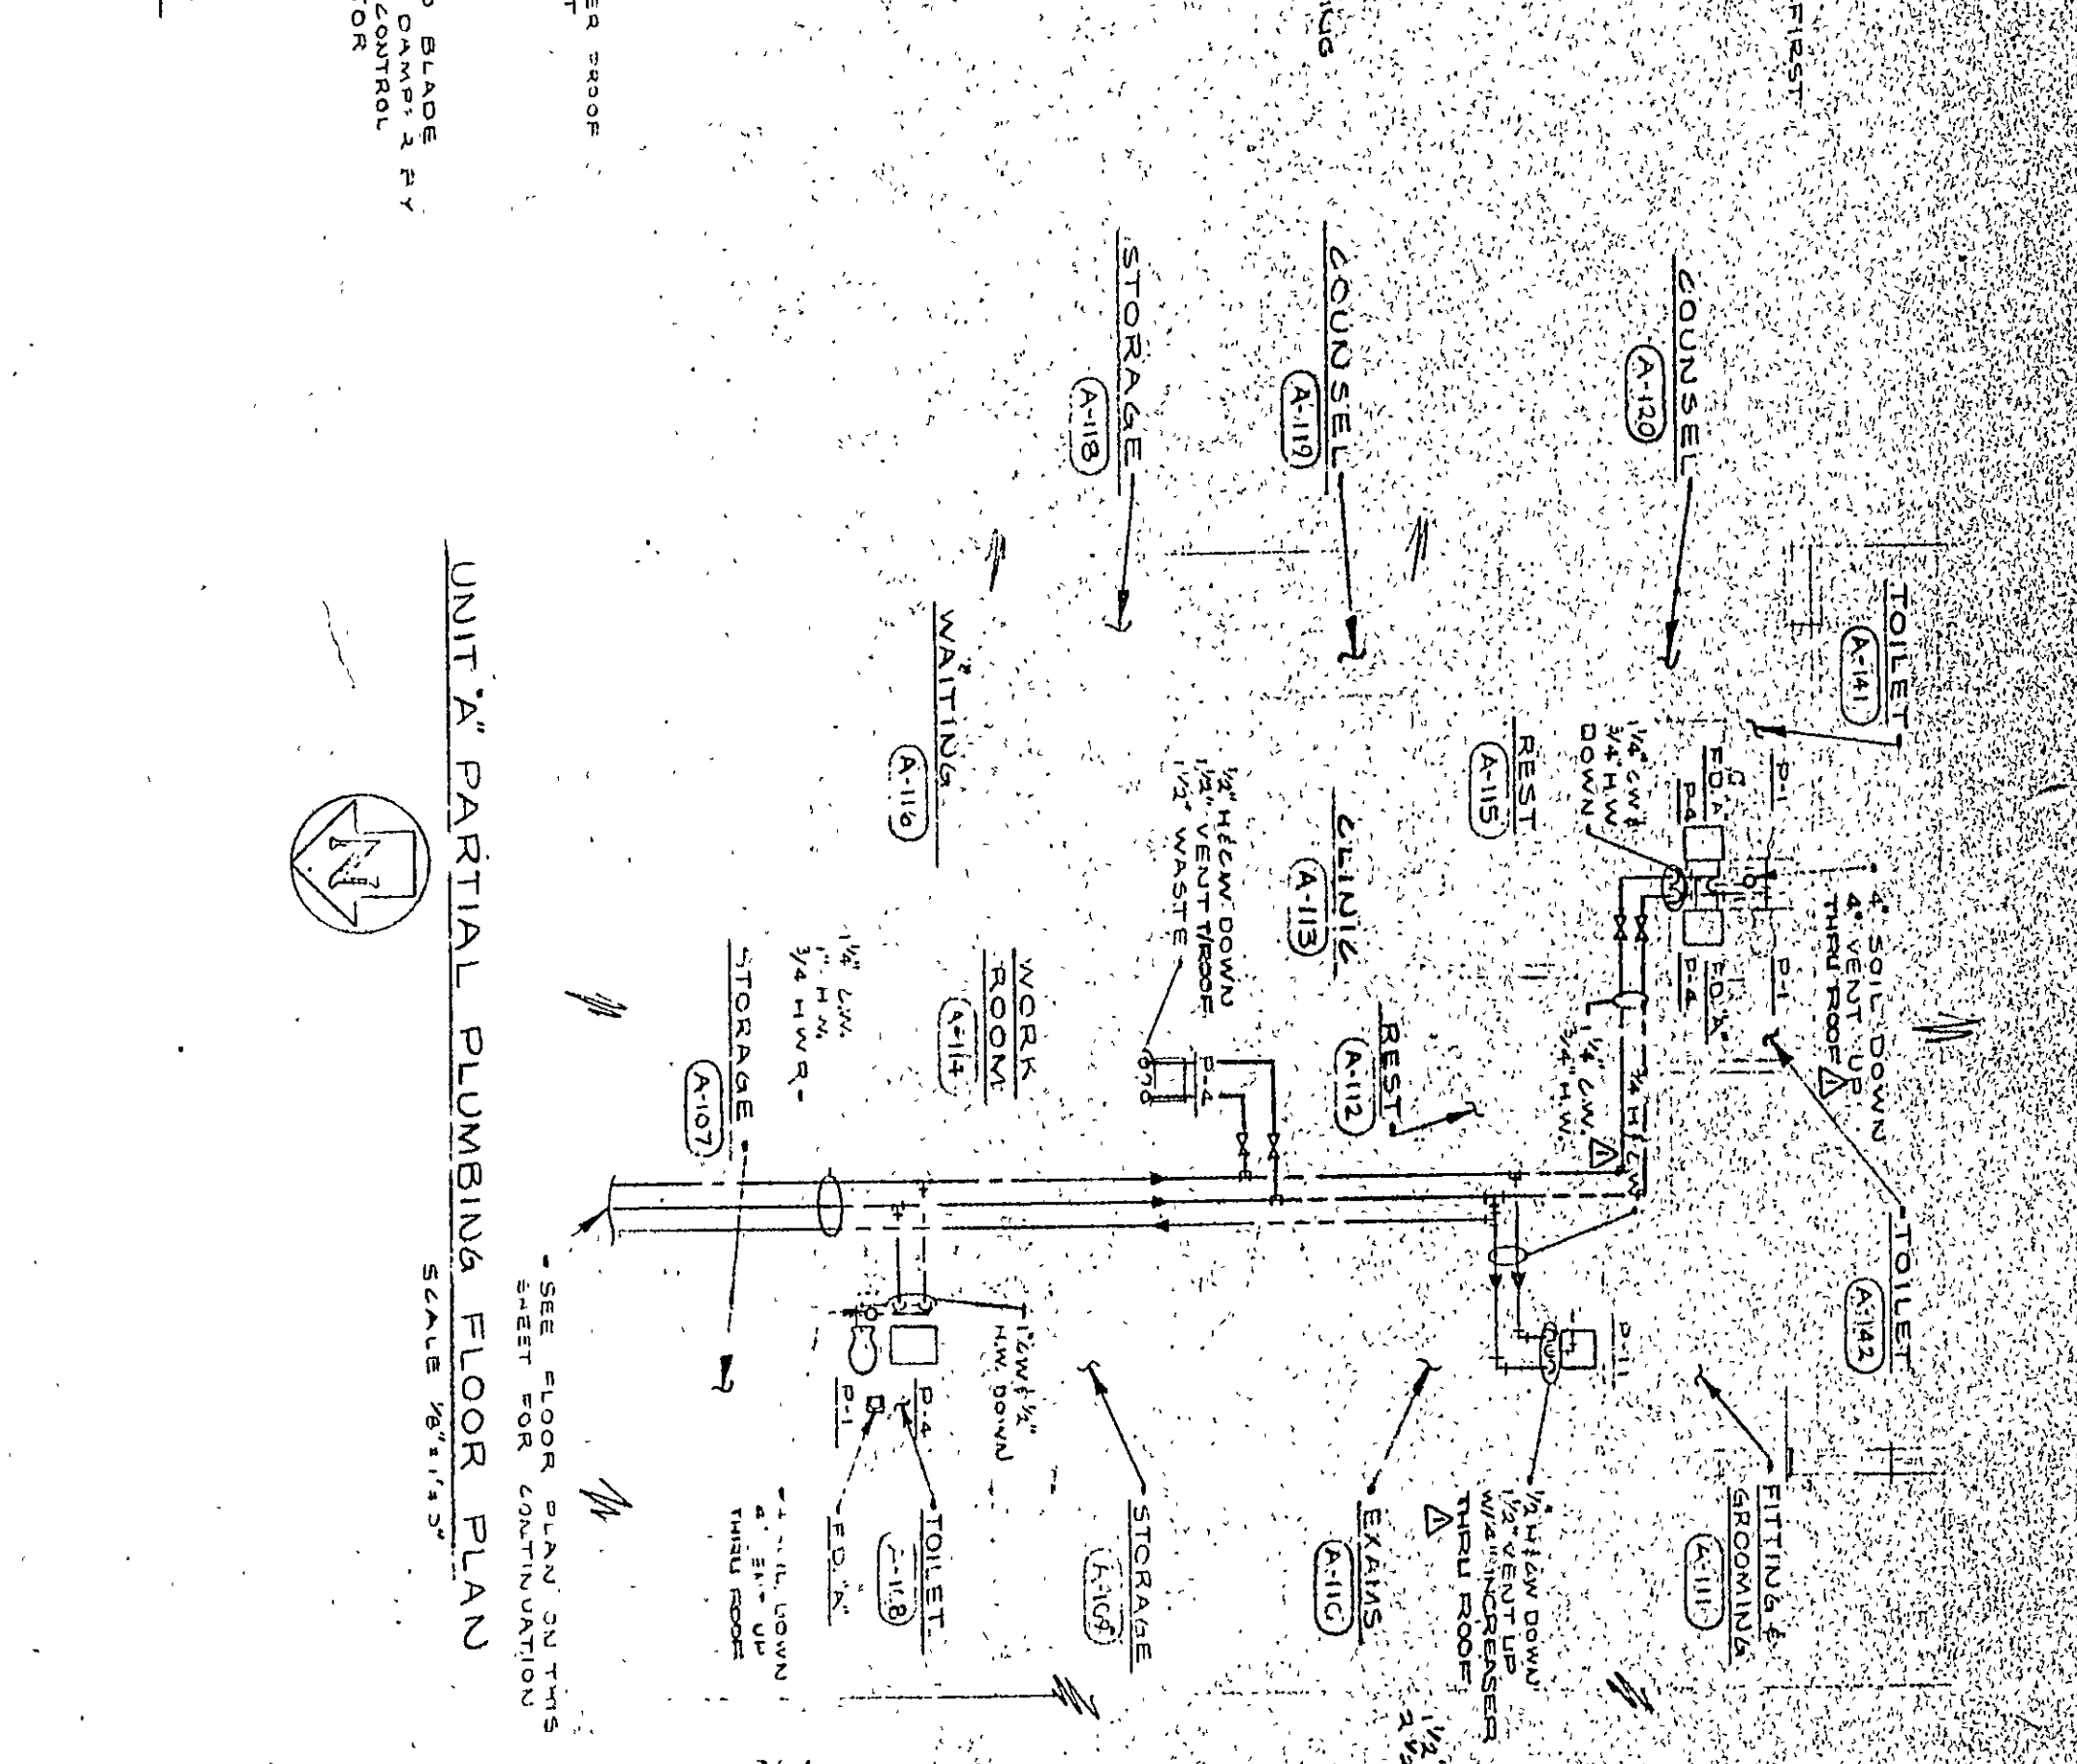
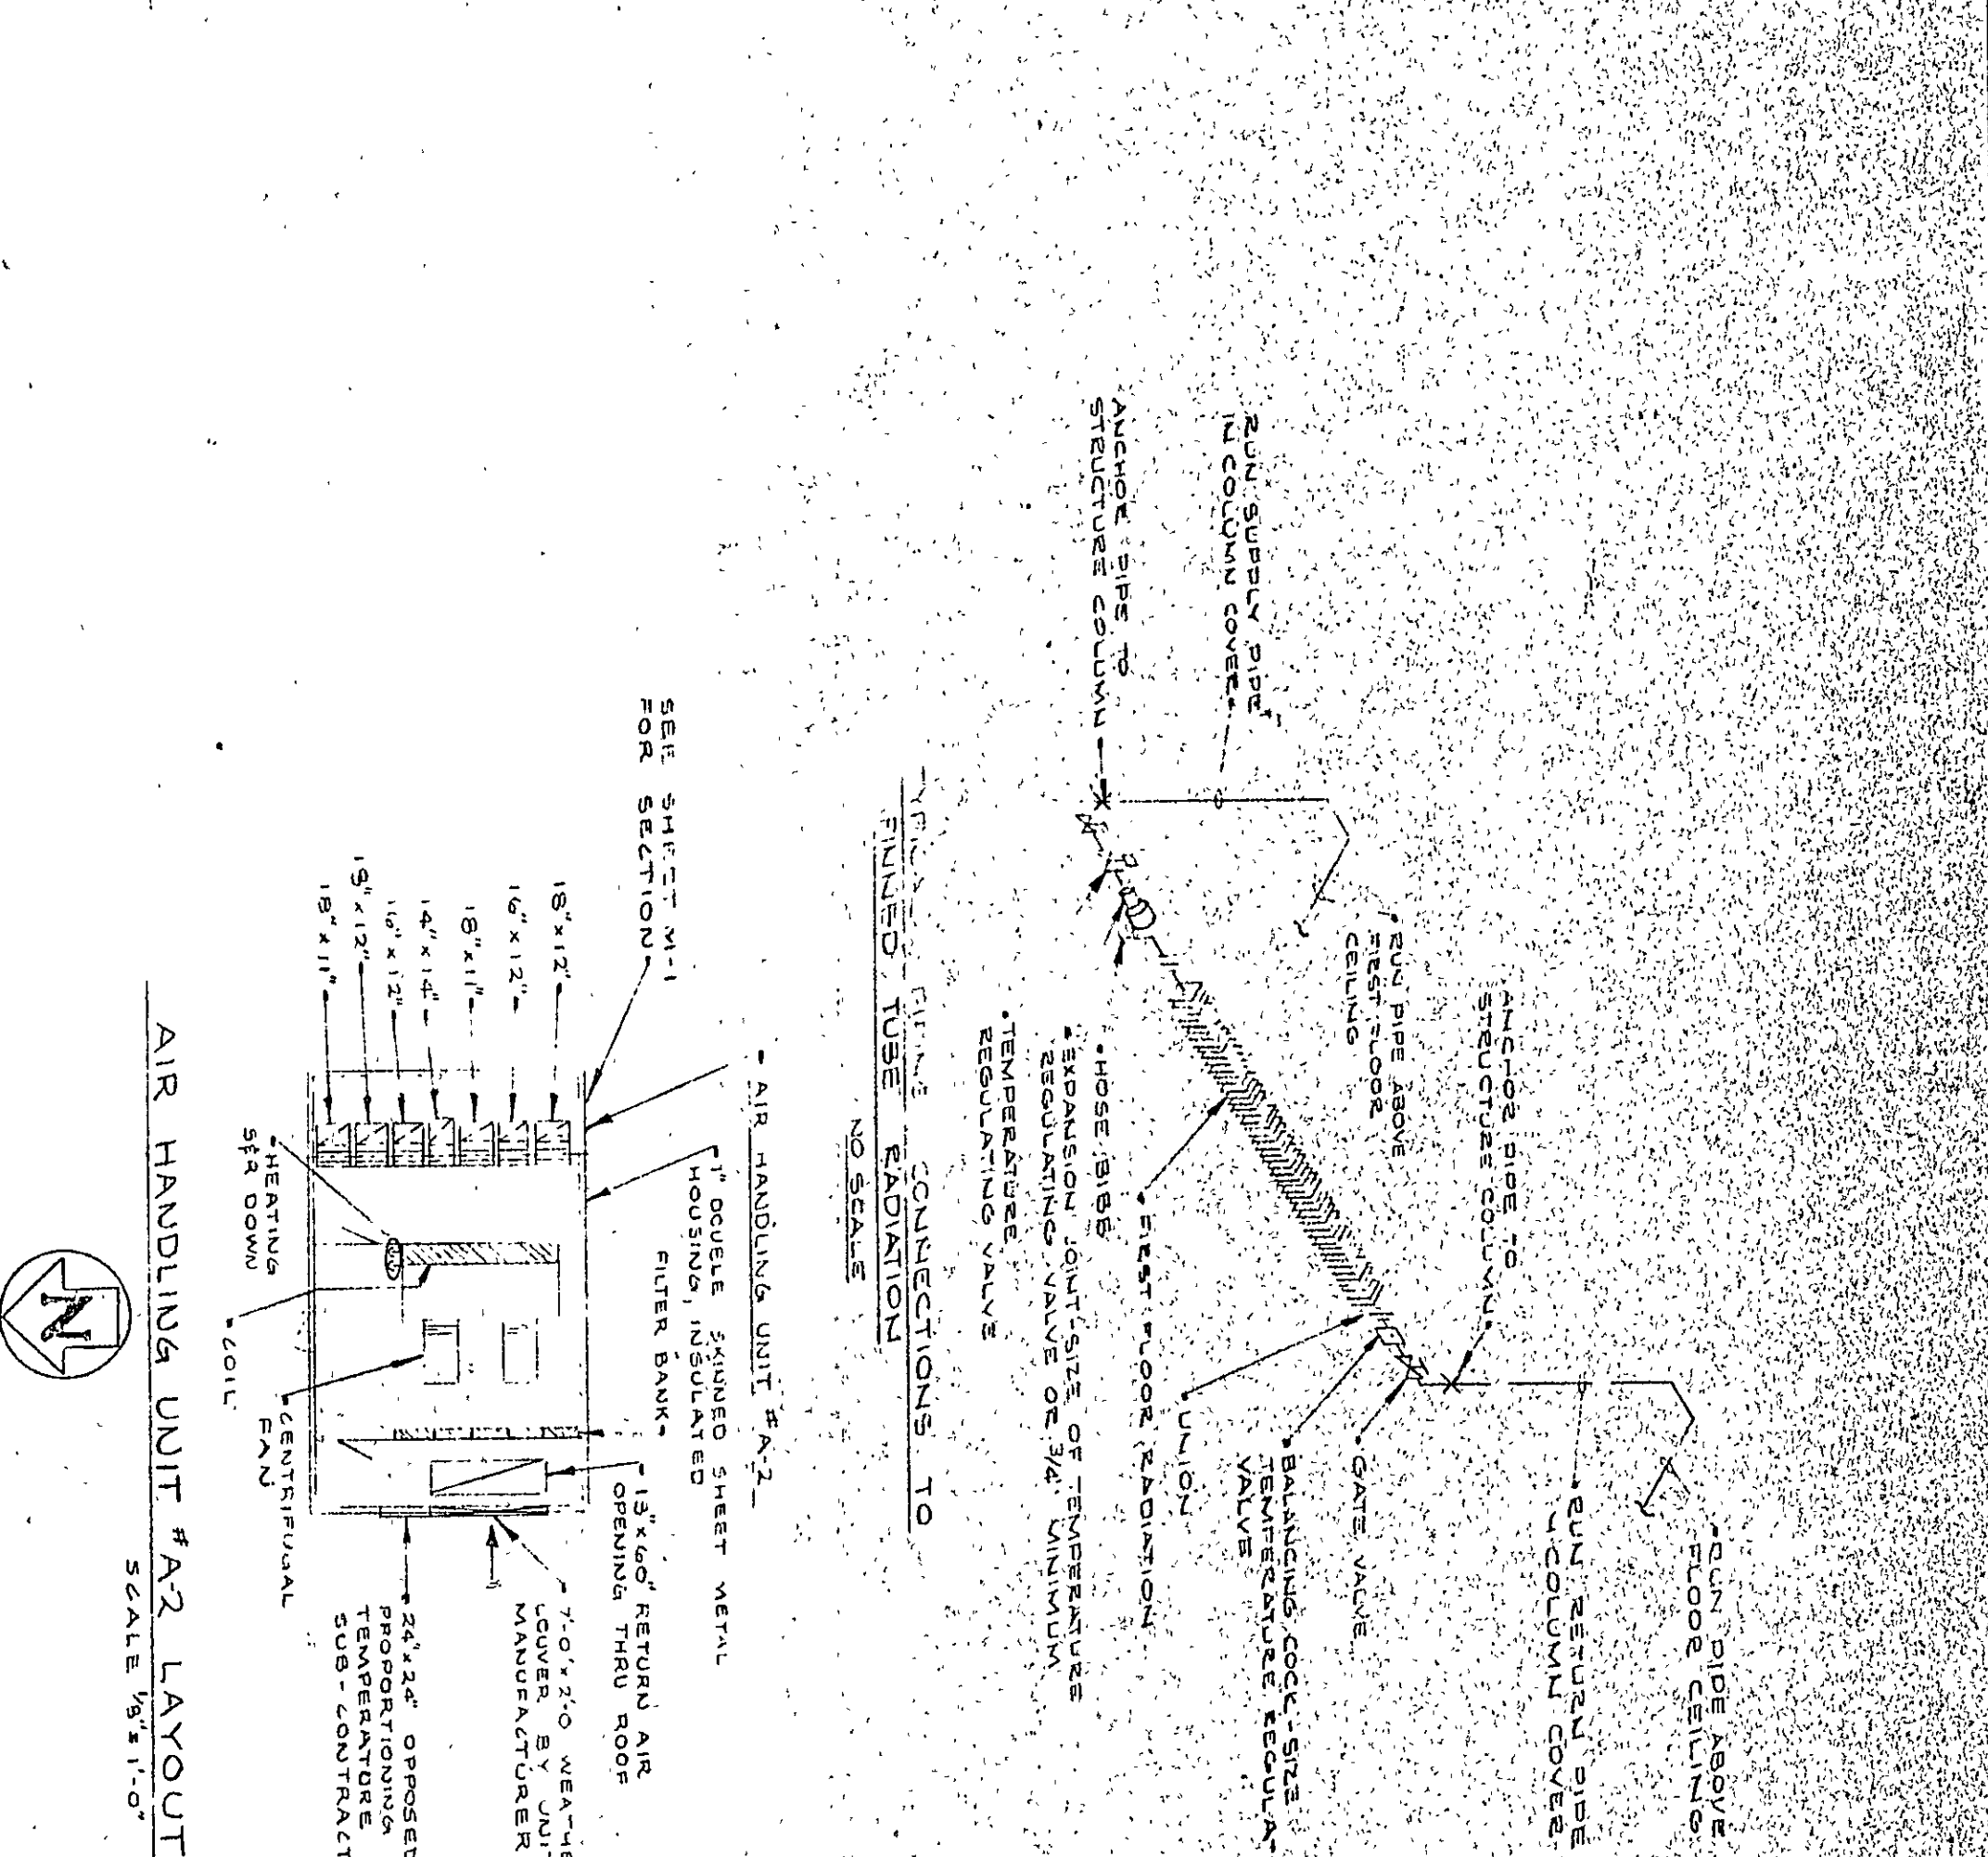
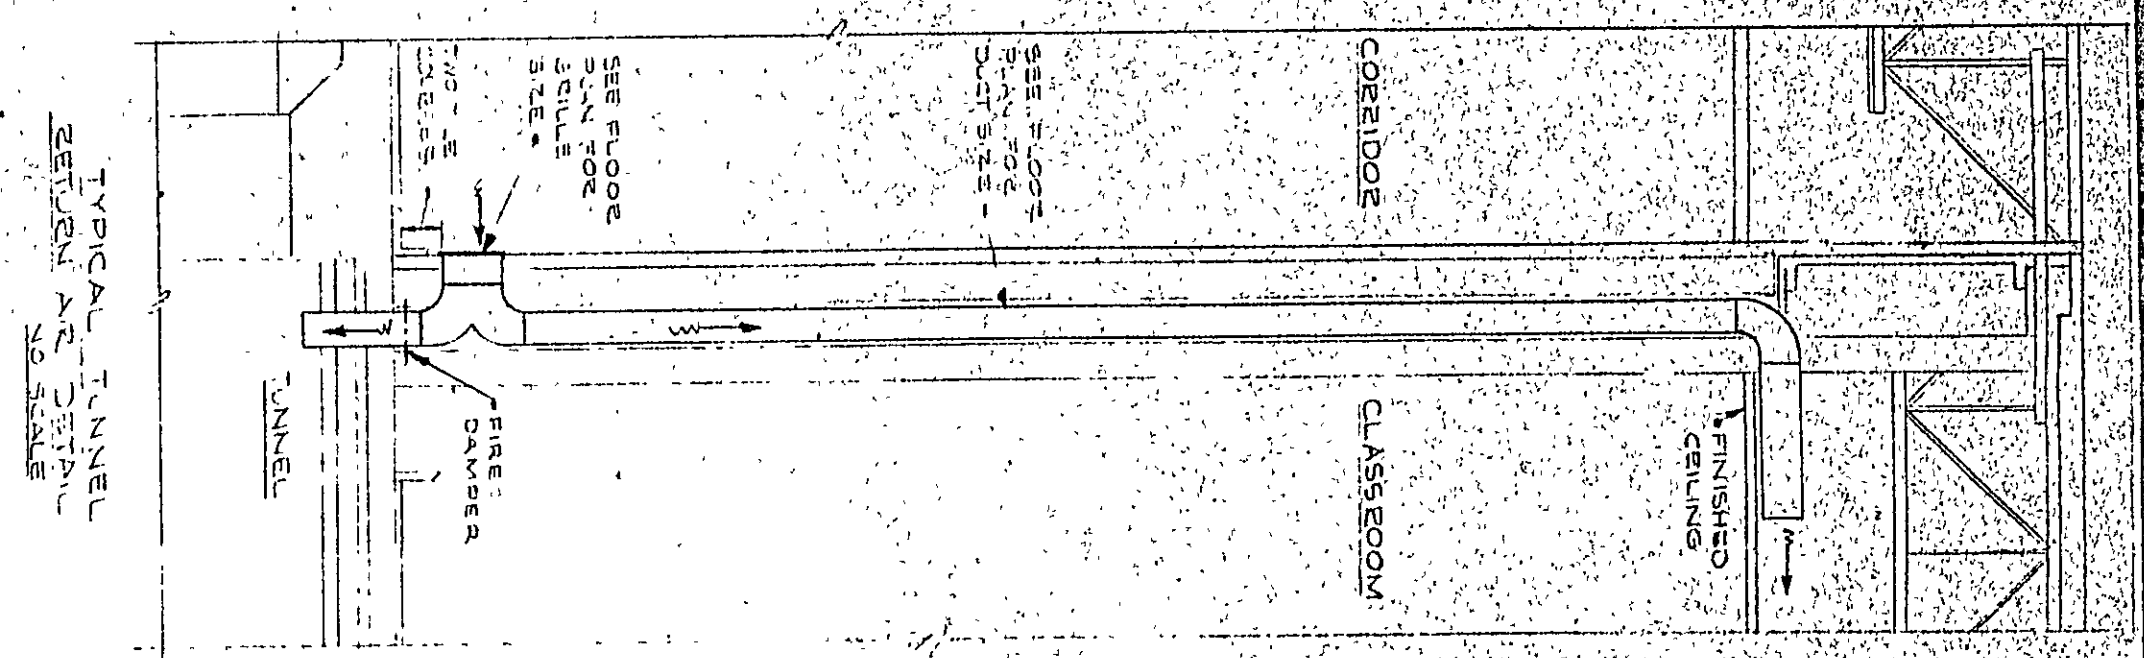


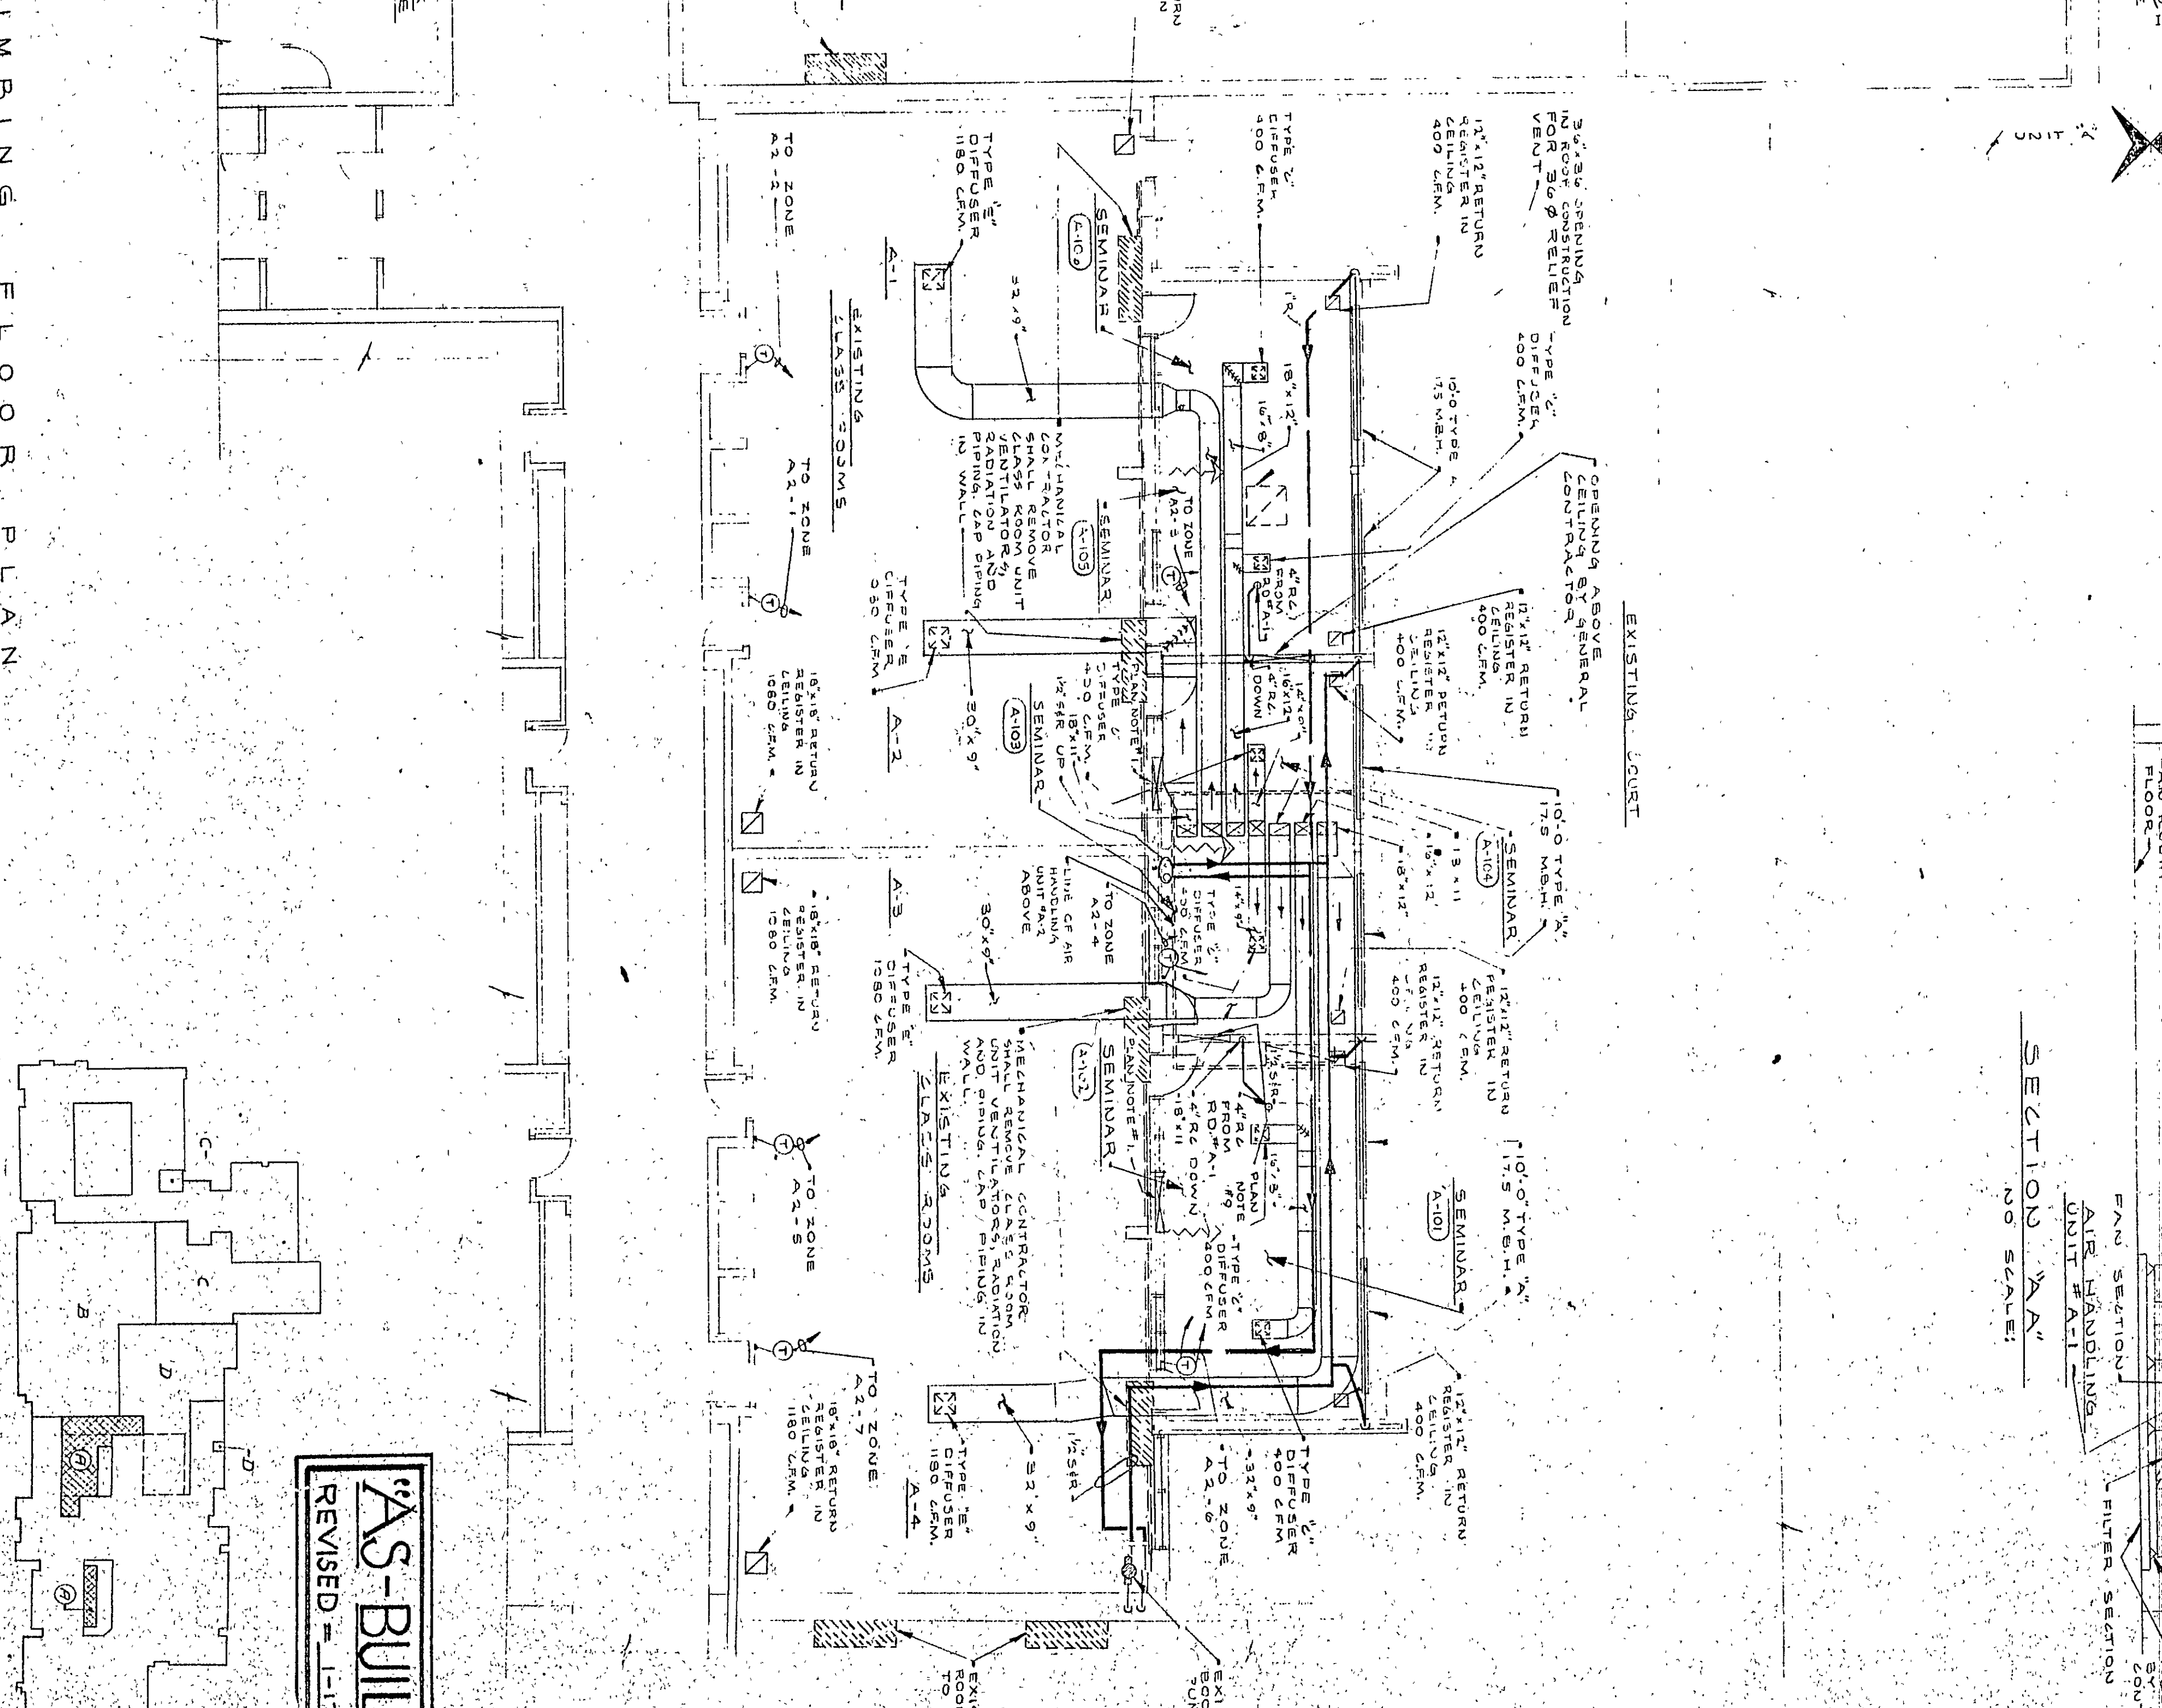

AIR FLOWING SCHEDULE

ZONE	ROOM	AREA	FLOW	TEMP	WATER
1	101	100	100	100	100
2	201	200	200	200	200
3	301	300	300	300	300
4	401	400	400	400	400
5	501	500	500	500	500
6	601	600	600	600	600
7	701	700	700	700	700
8	801	800	800	800	800
9	901	900	900	900	900
10	1001	1000	1000	1000	1000

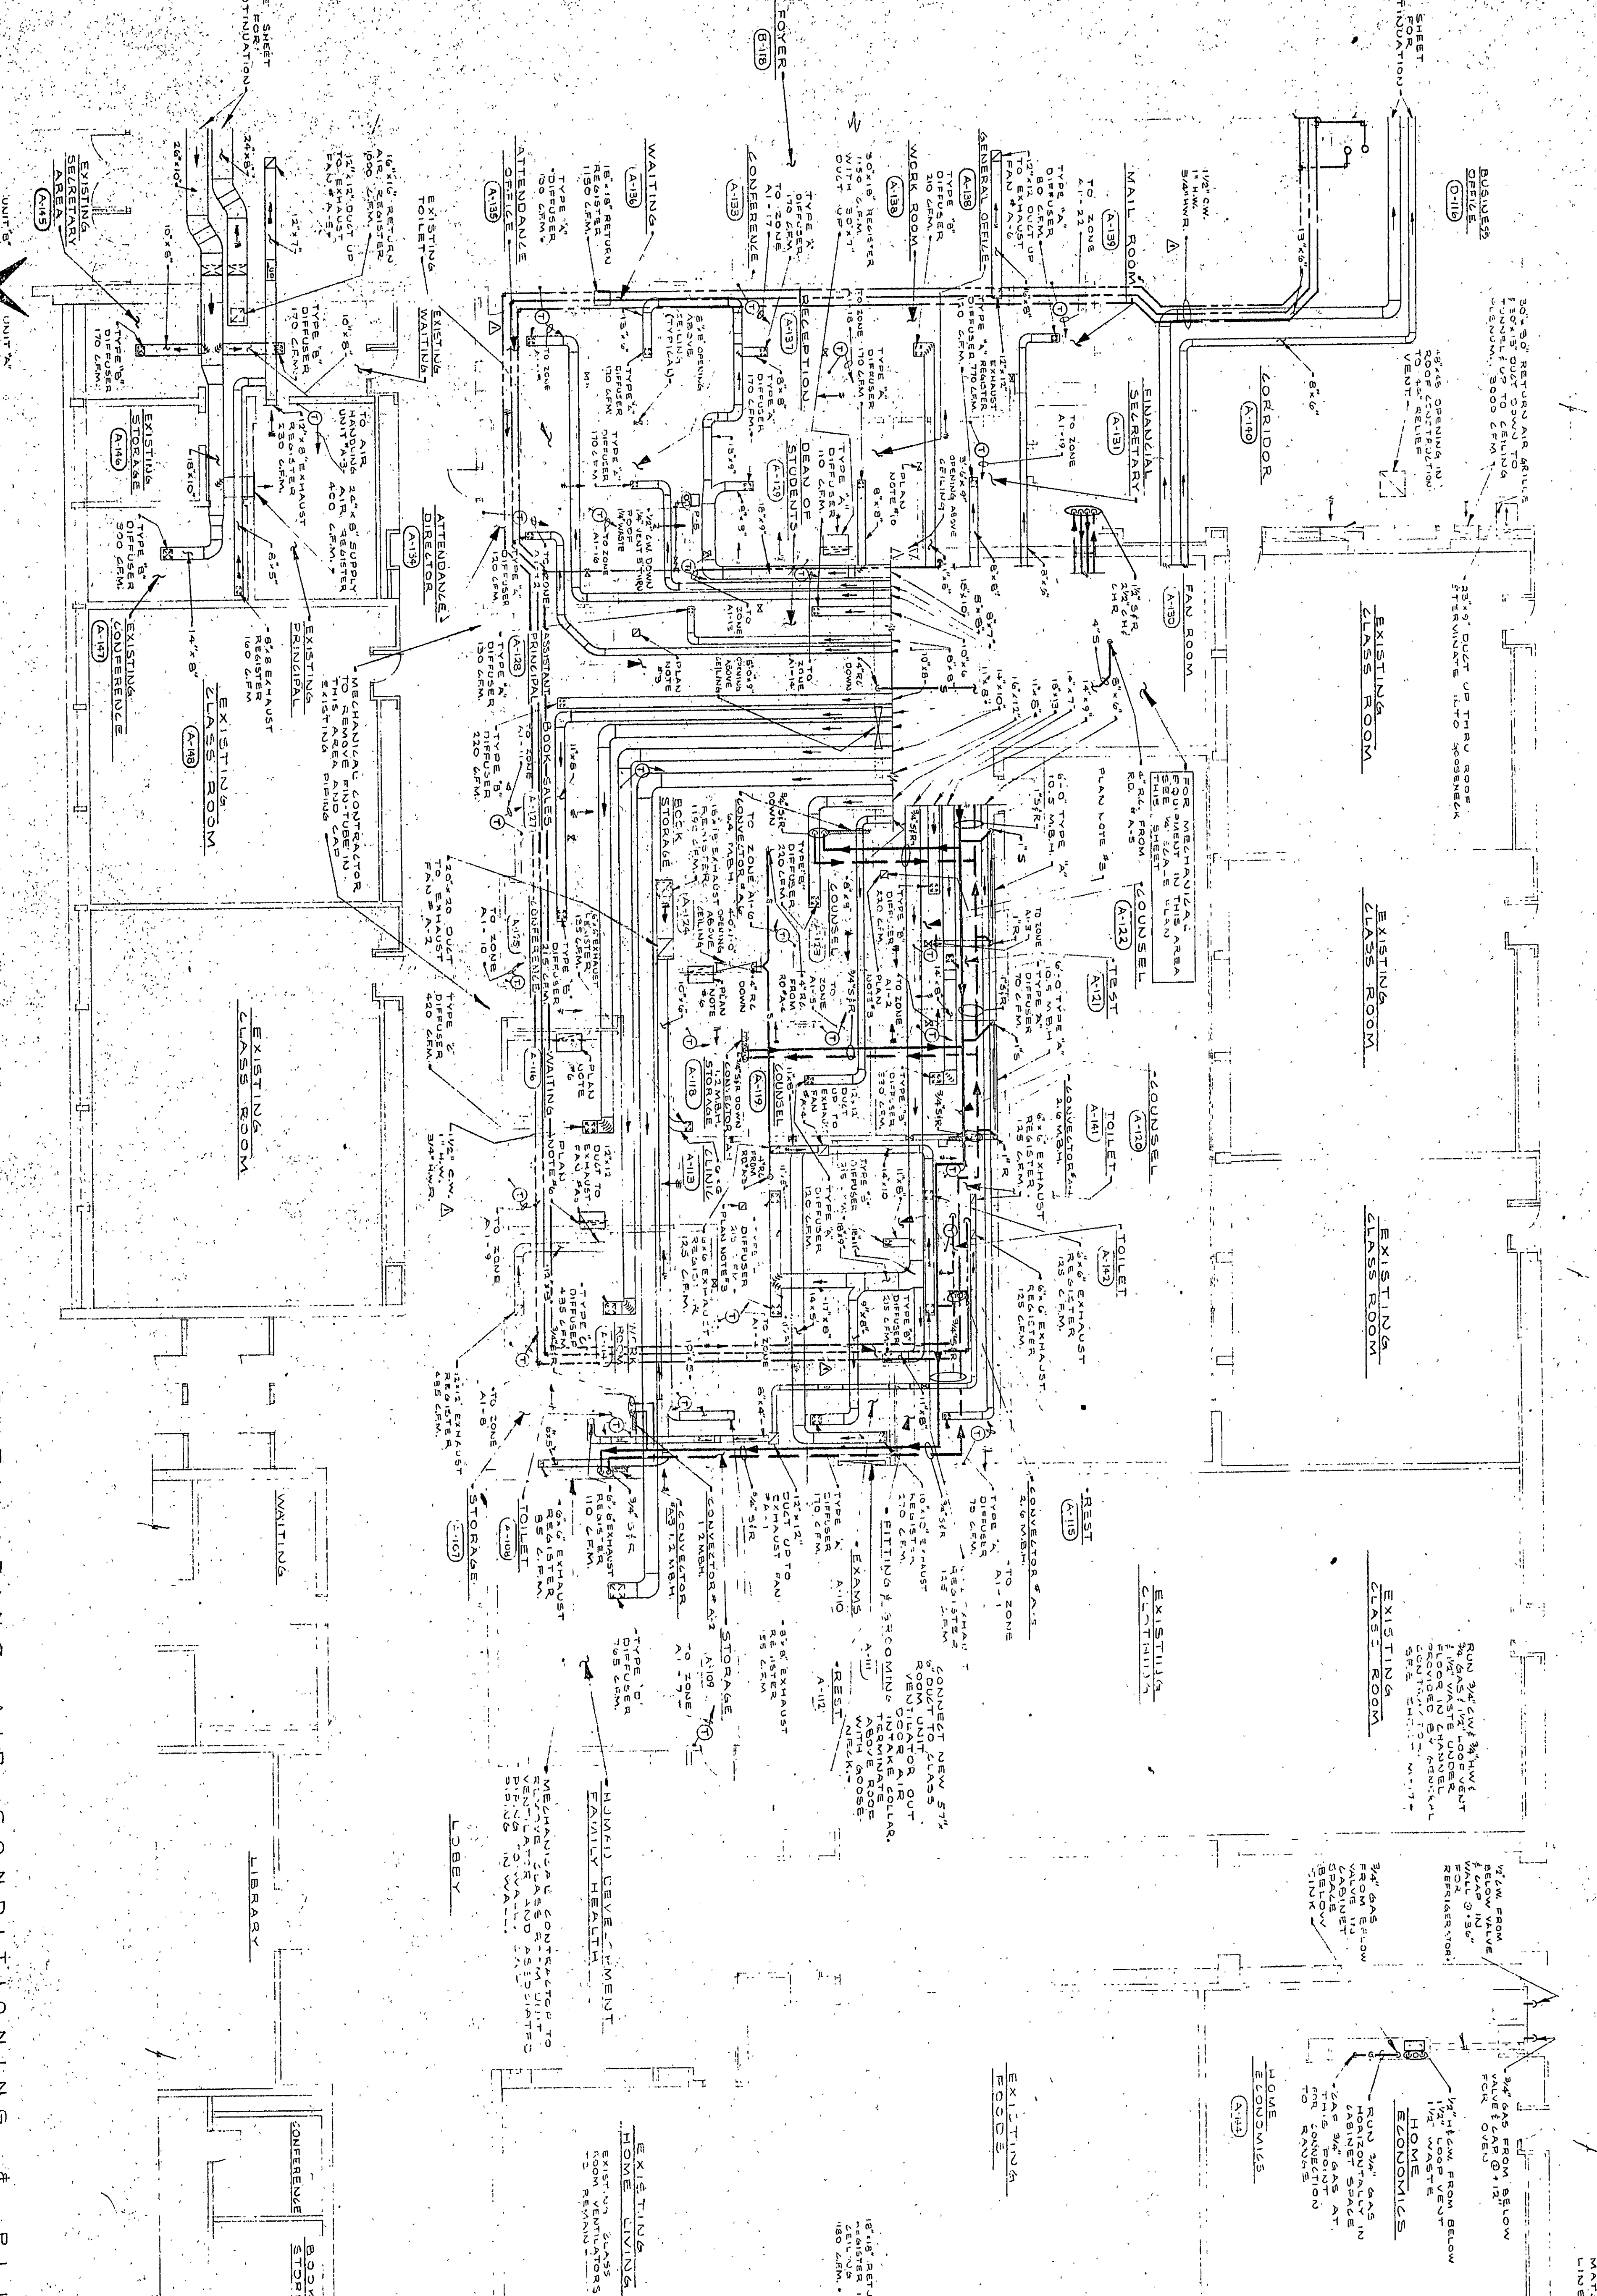

AS-BUILT
REVISED - 1-13-75

EVERETT I. BROWN COMPANY ARCHITECTS & ENGINEERS
5500 BRADBURY AVENUE - PARK FLETCHER
INDIANAPOLIS, INDIANA

ADDITION TO CHESTERTON HIGH SCHOOL