

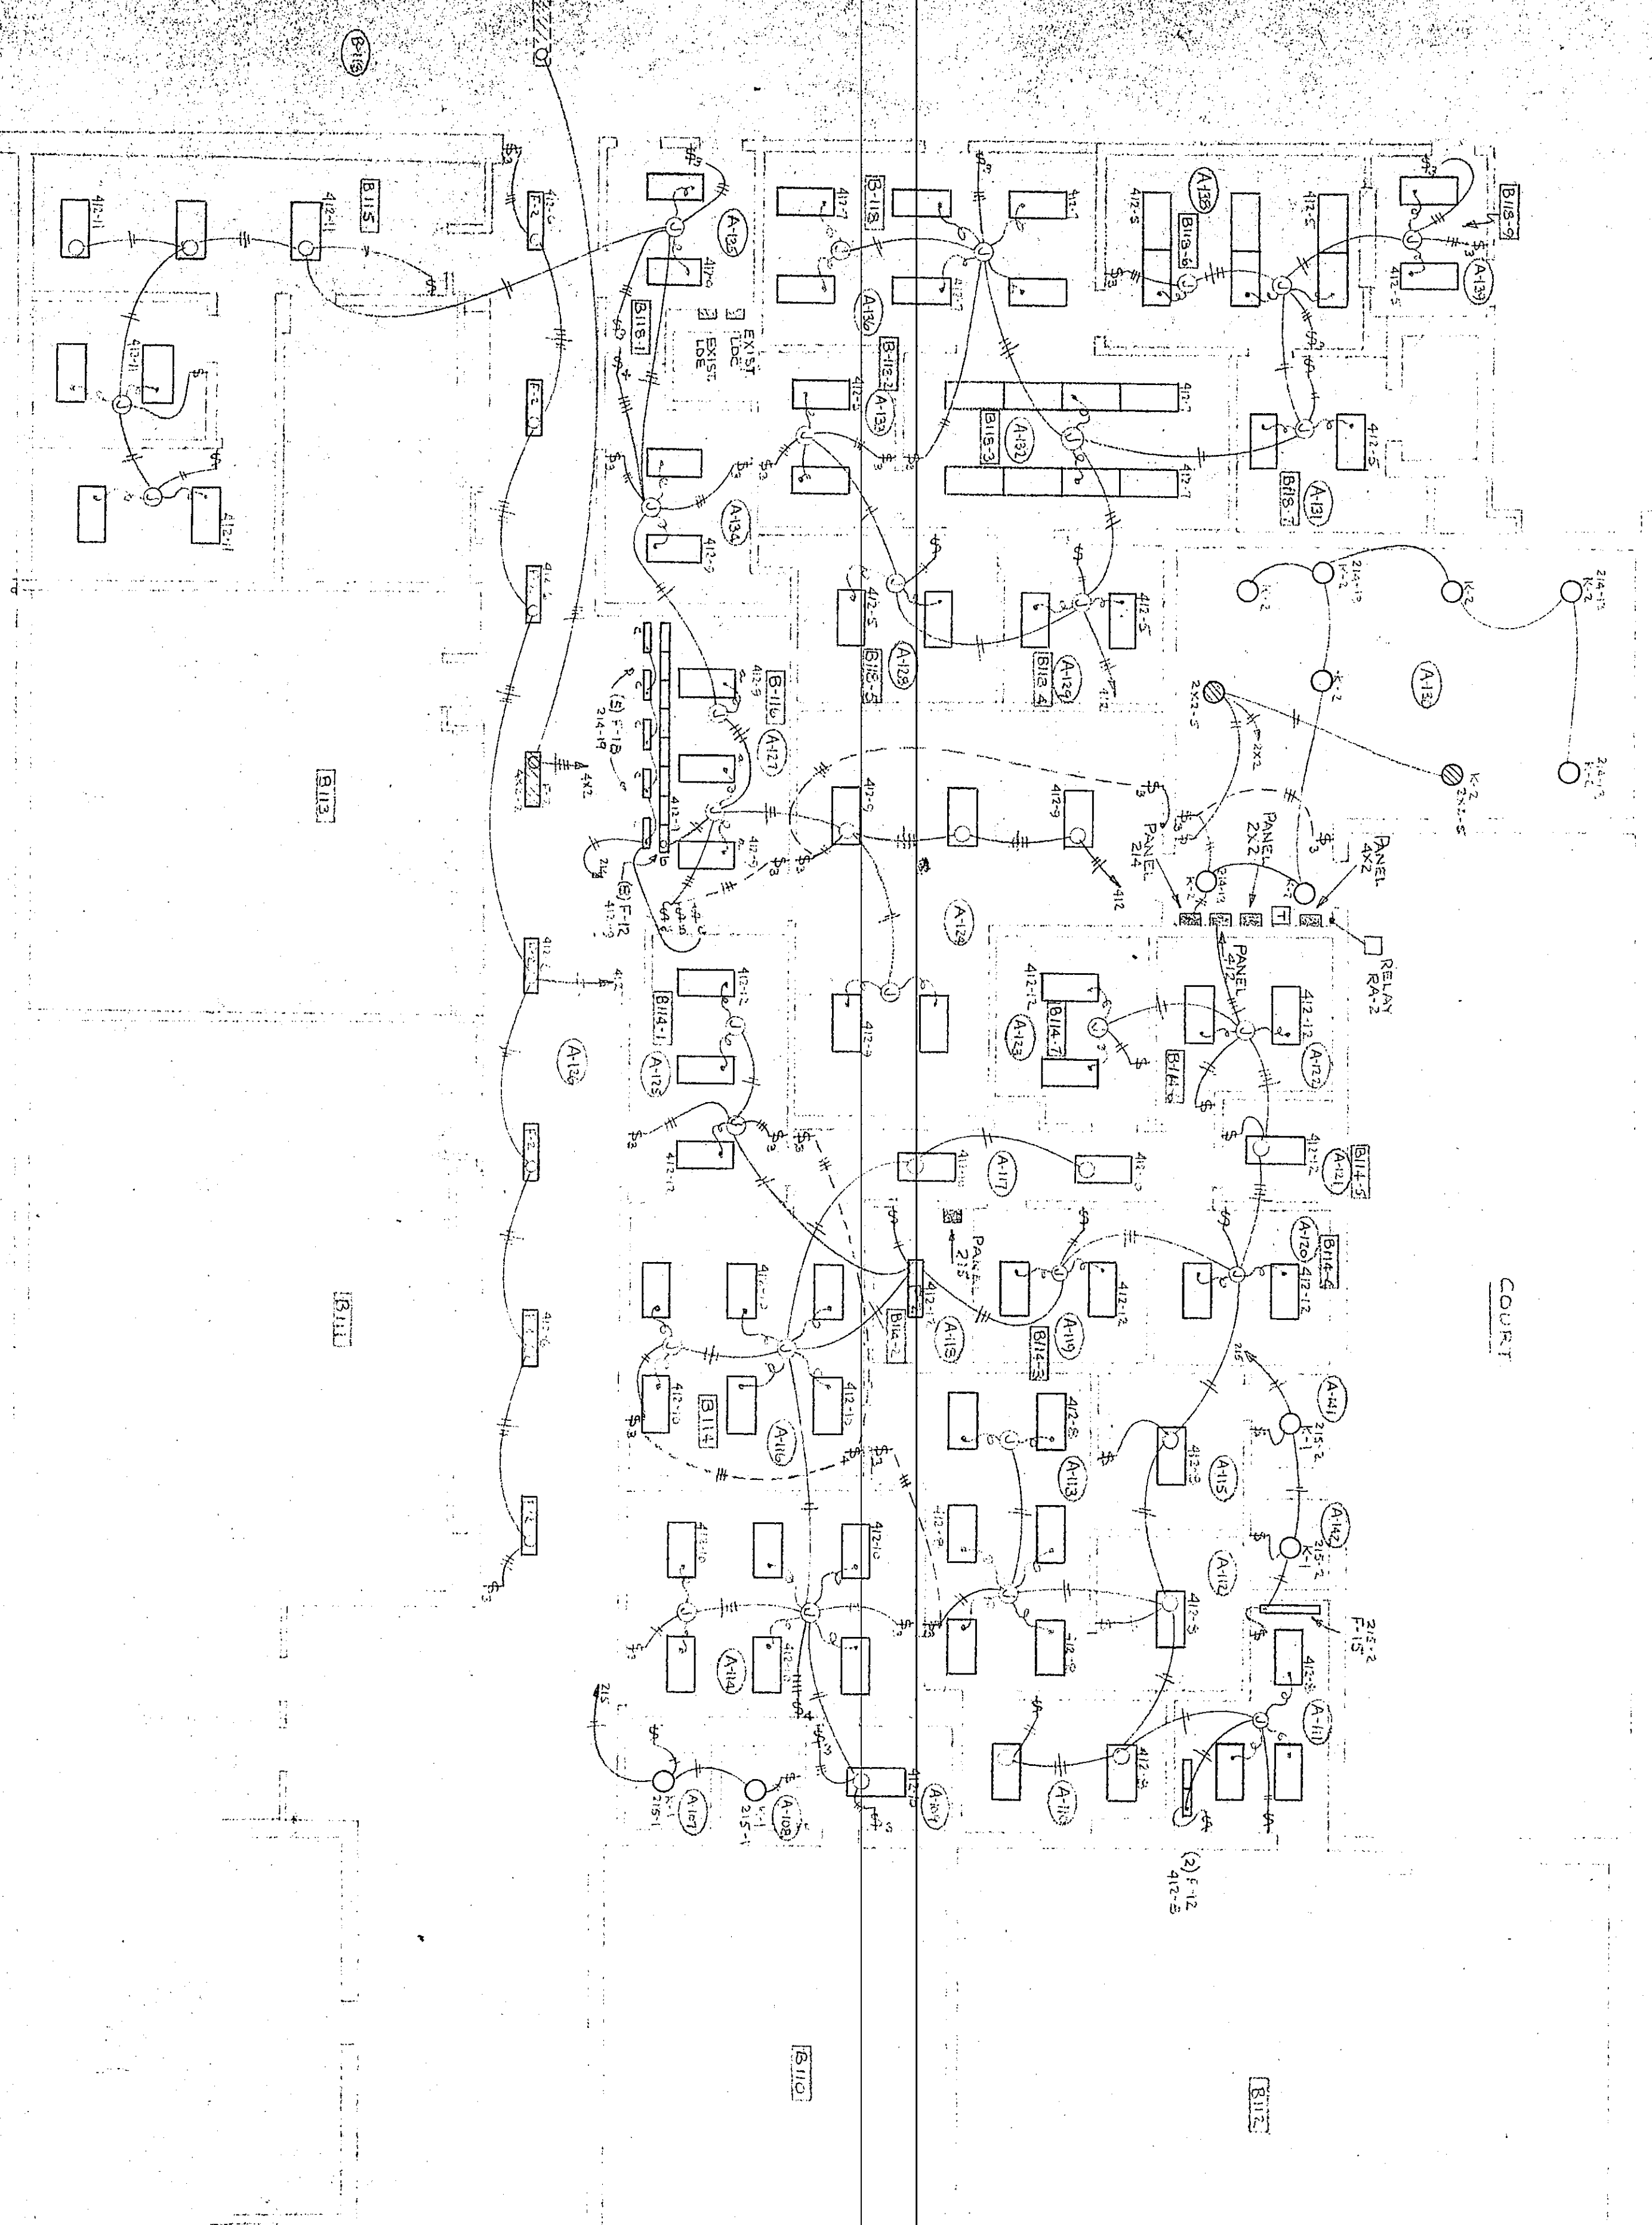


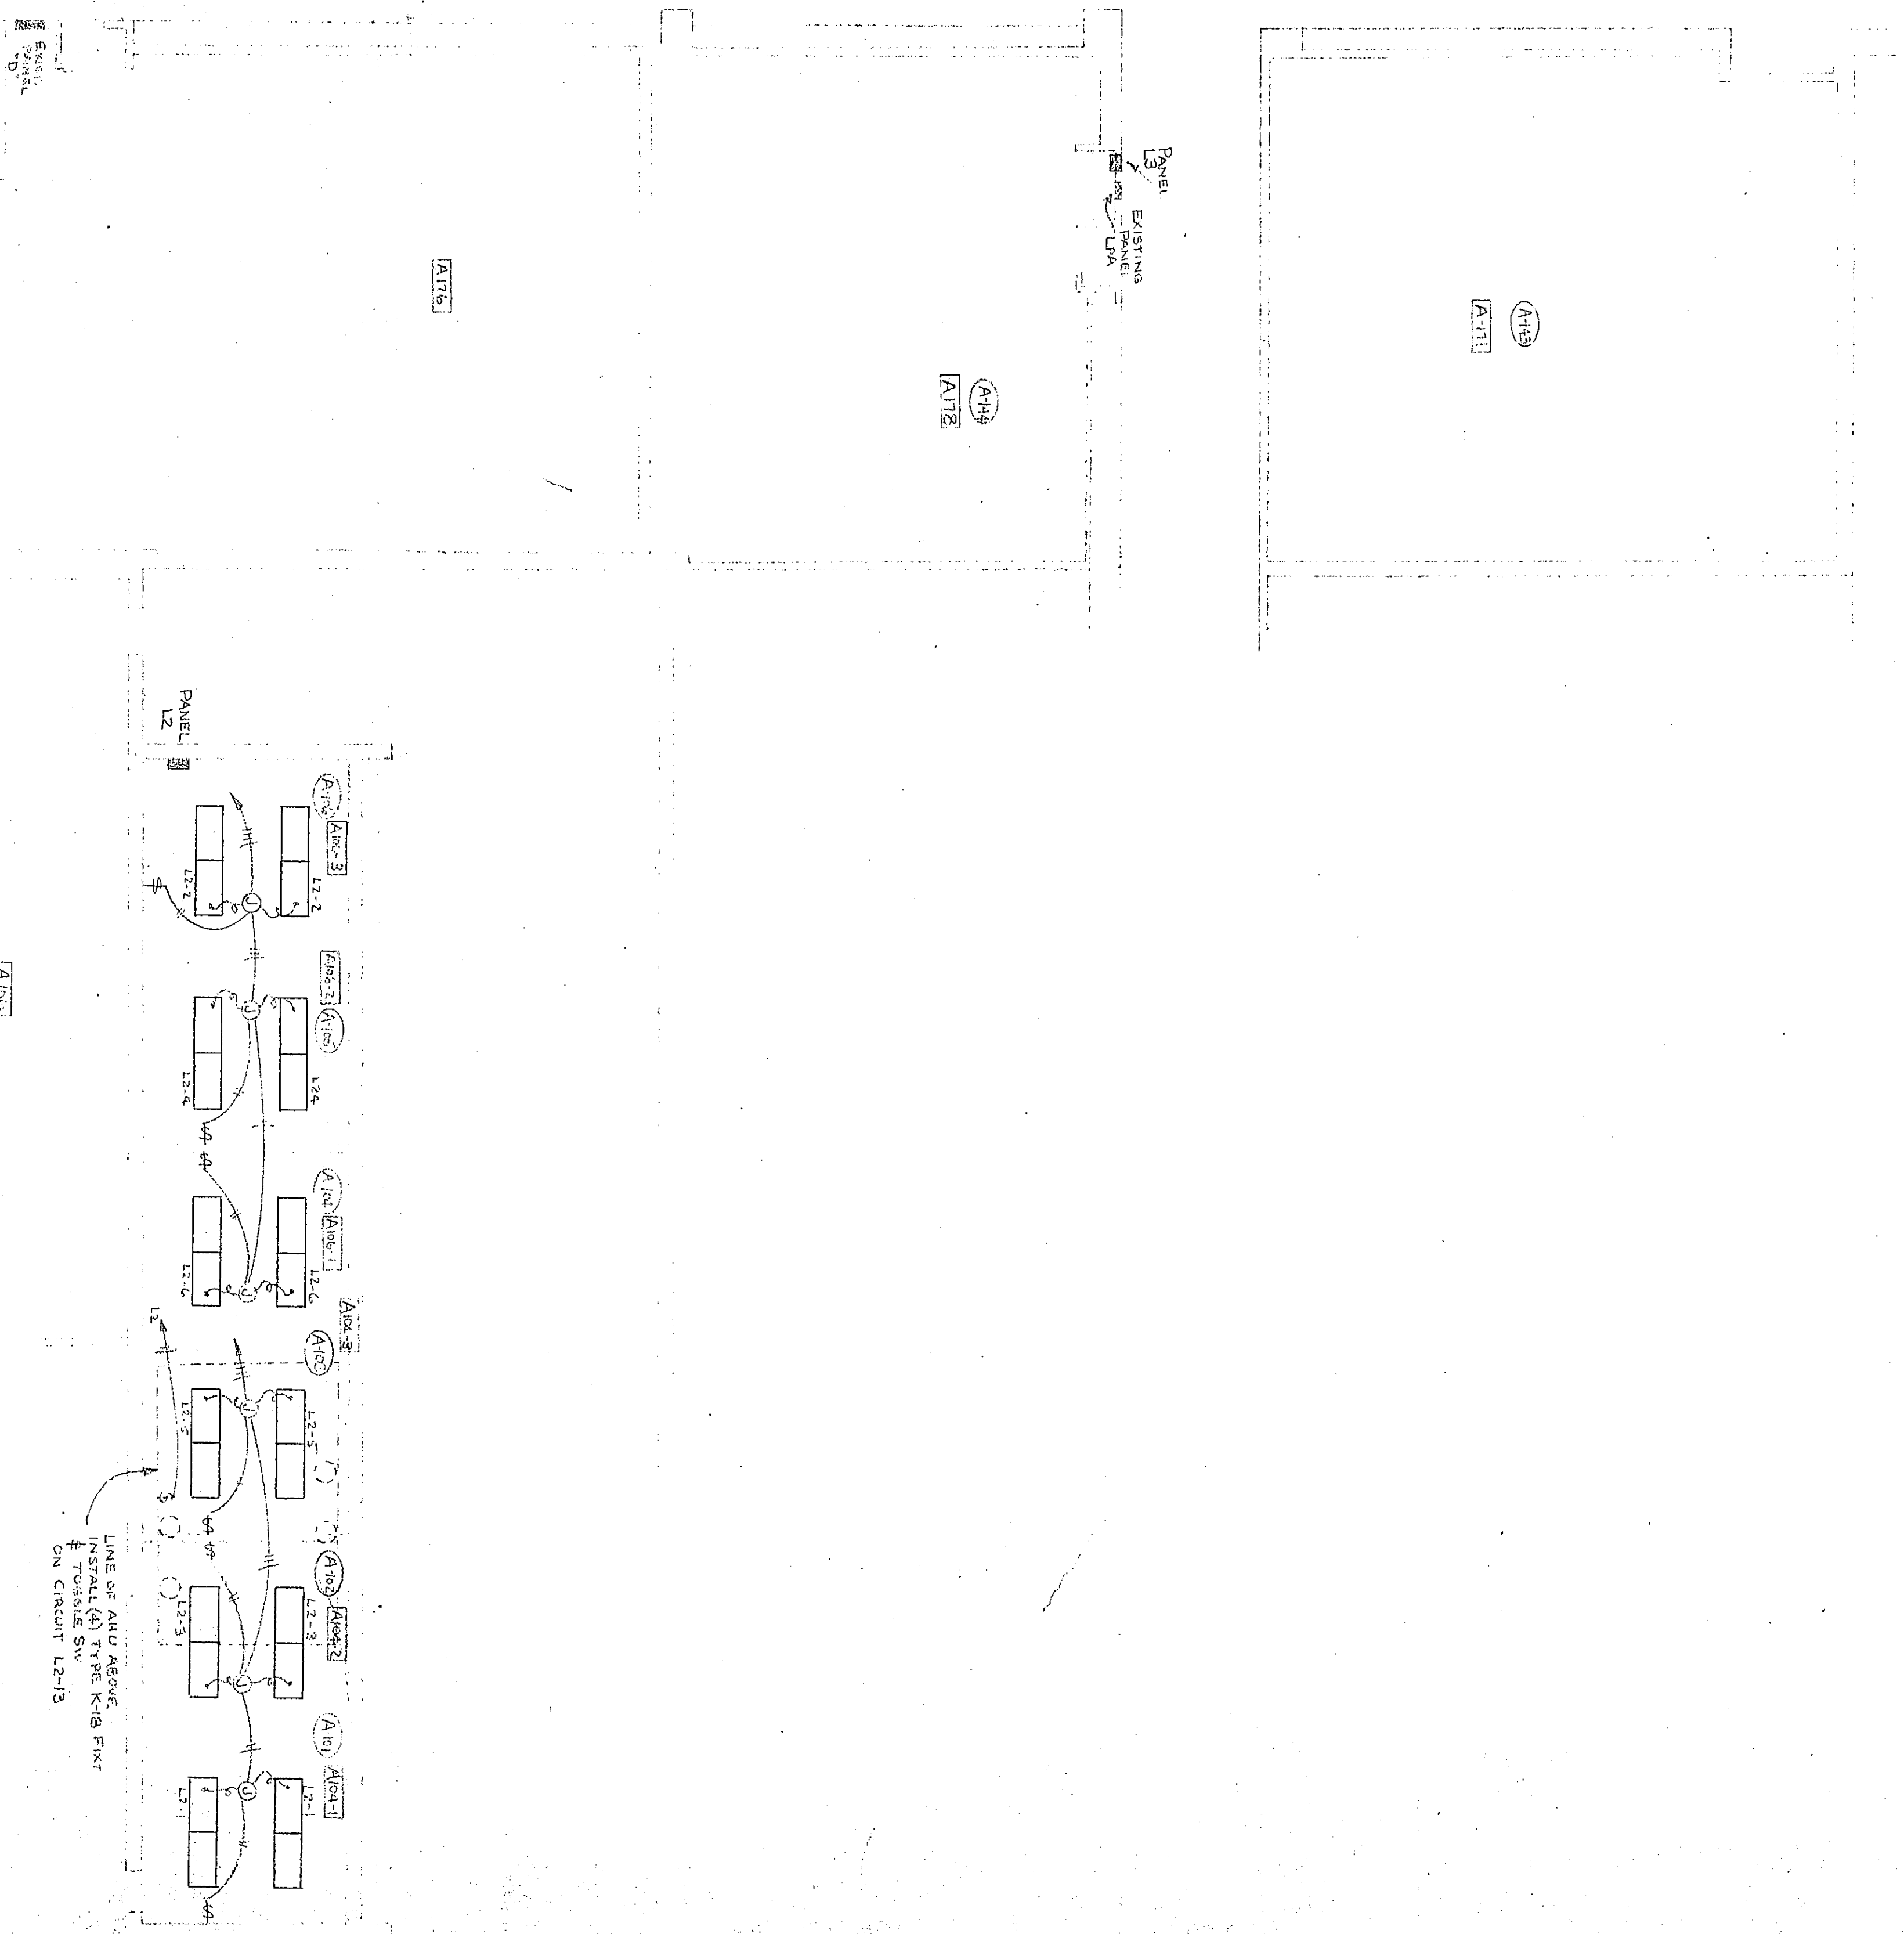

NOTE:
 [Symbol] = CONSTRUCTION DATA
 [Symbol] = FINAL ASSIGNED ROOM #

CIRCLE P ELECTRIC INC.
 CONTRACTOR
 P.O. BOX 130
 PORTAGE, IN 46368-0130

AS-BUILT 5/15/72

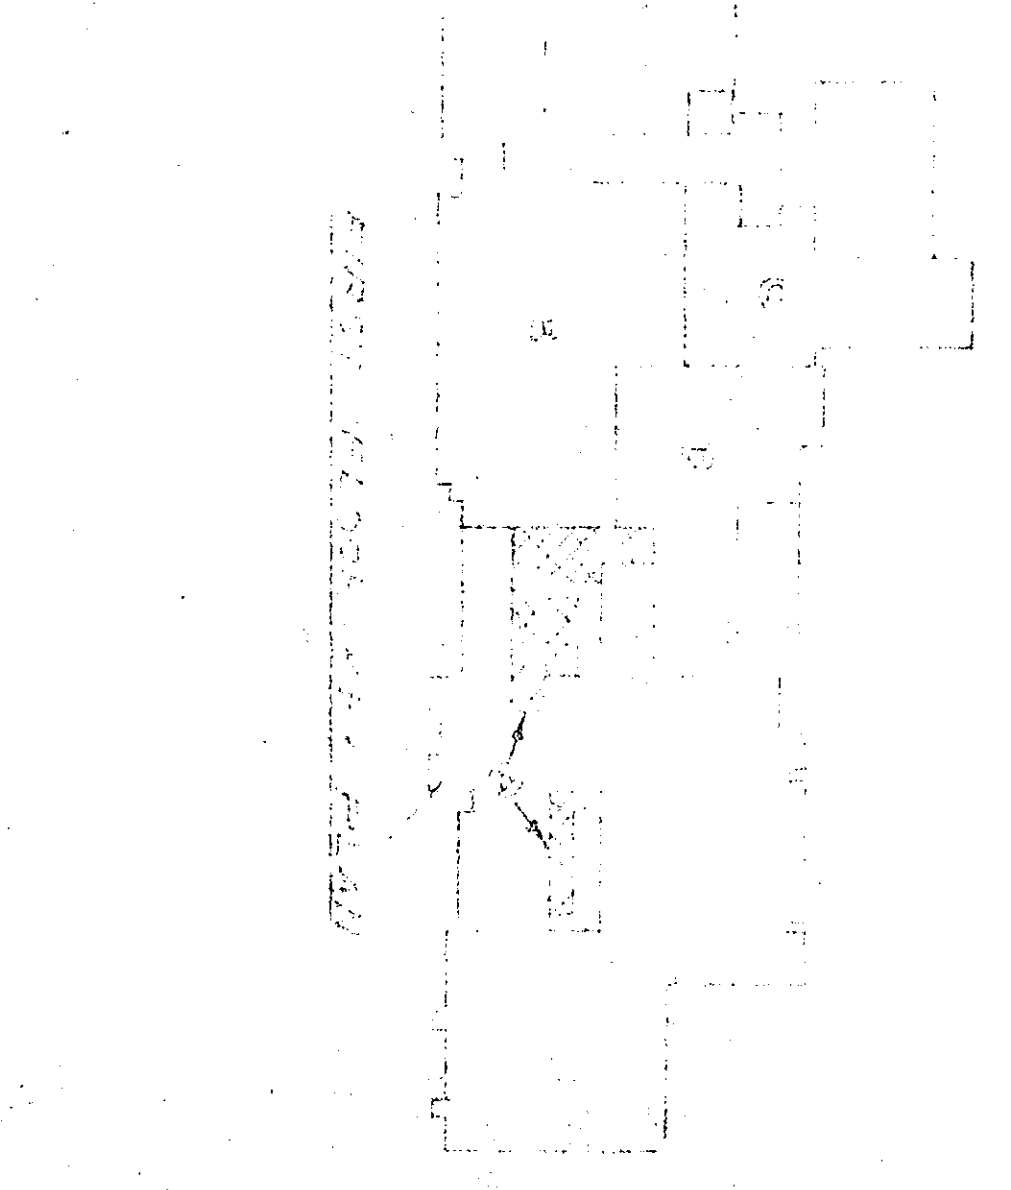

EVERETT I. BROWN CO. ARCH. & ENG.
 CHESTERTON SENIOR HIGH SCHOOL
 E-3-SDA

71E05