


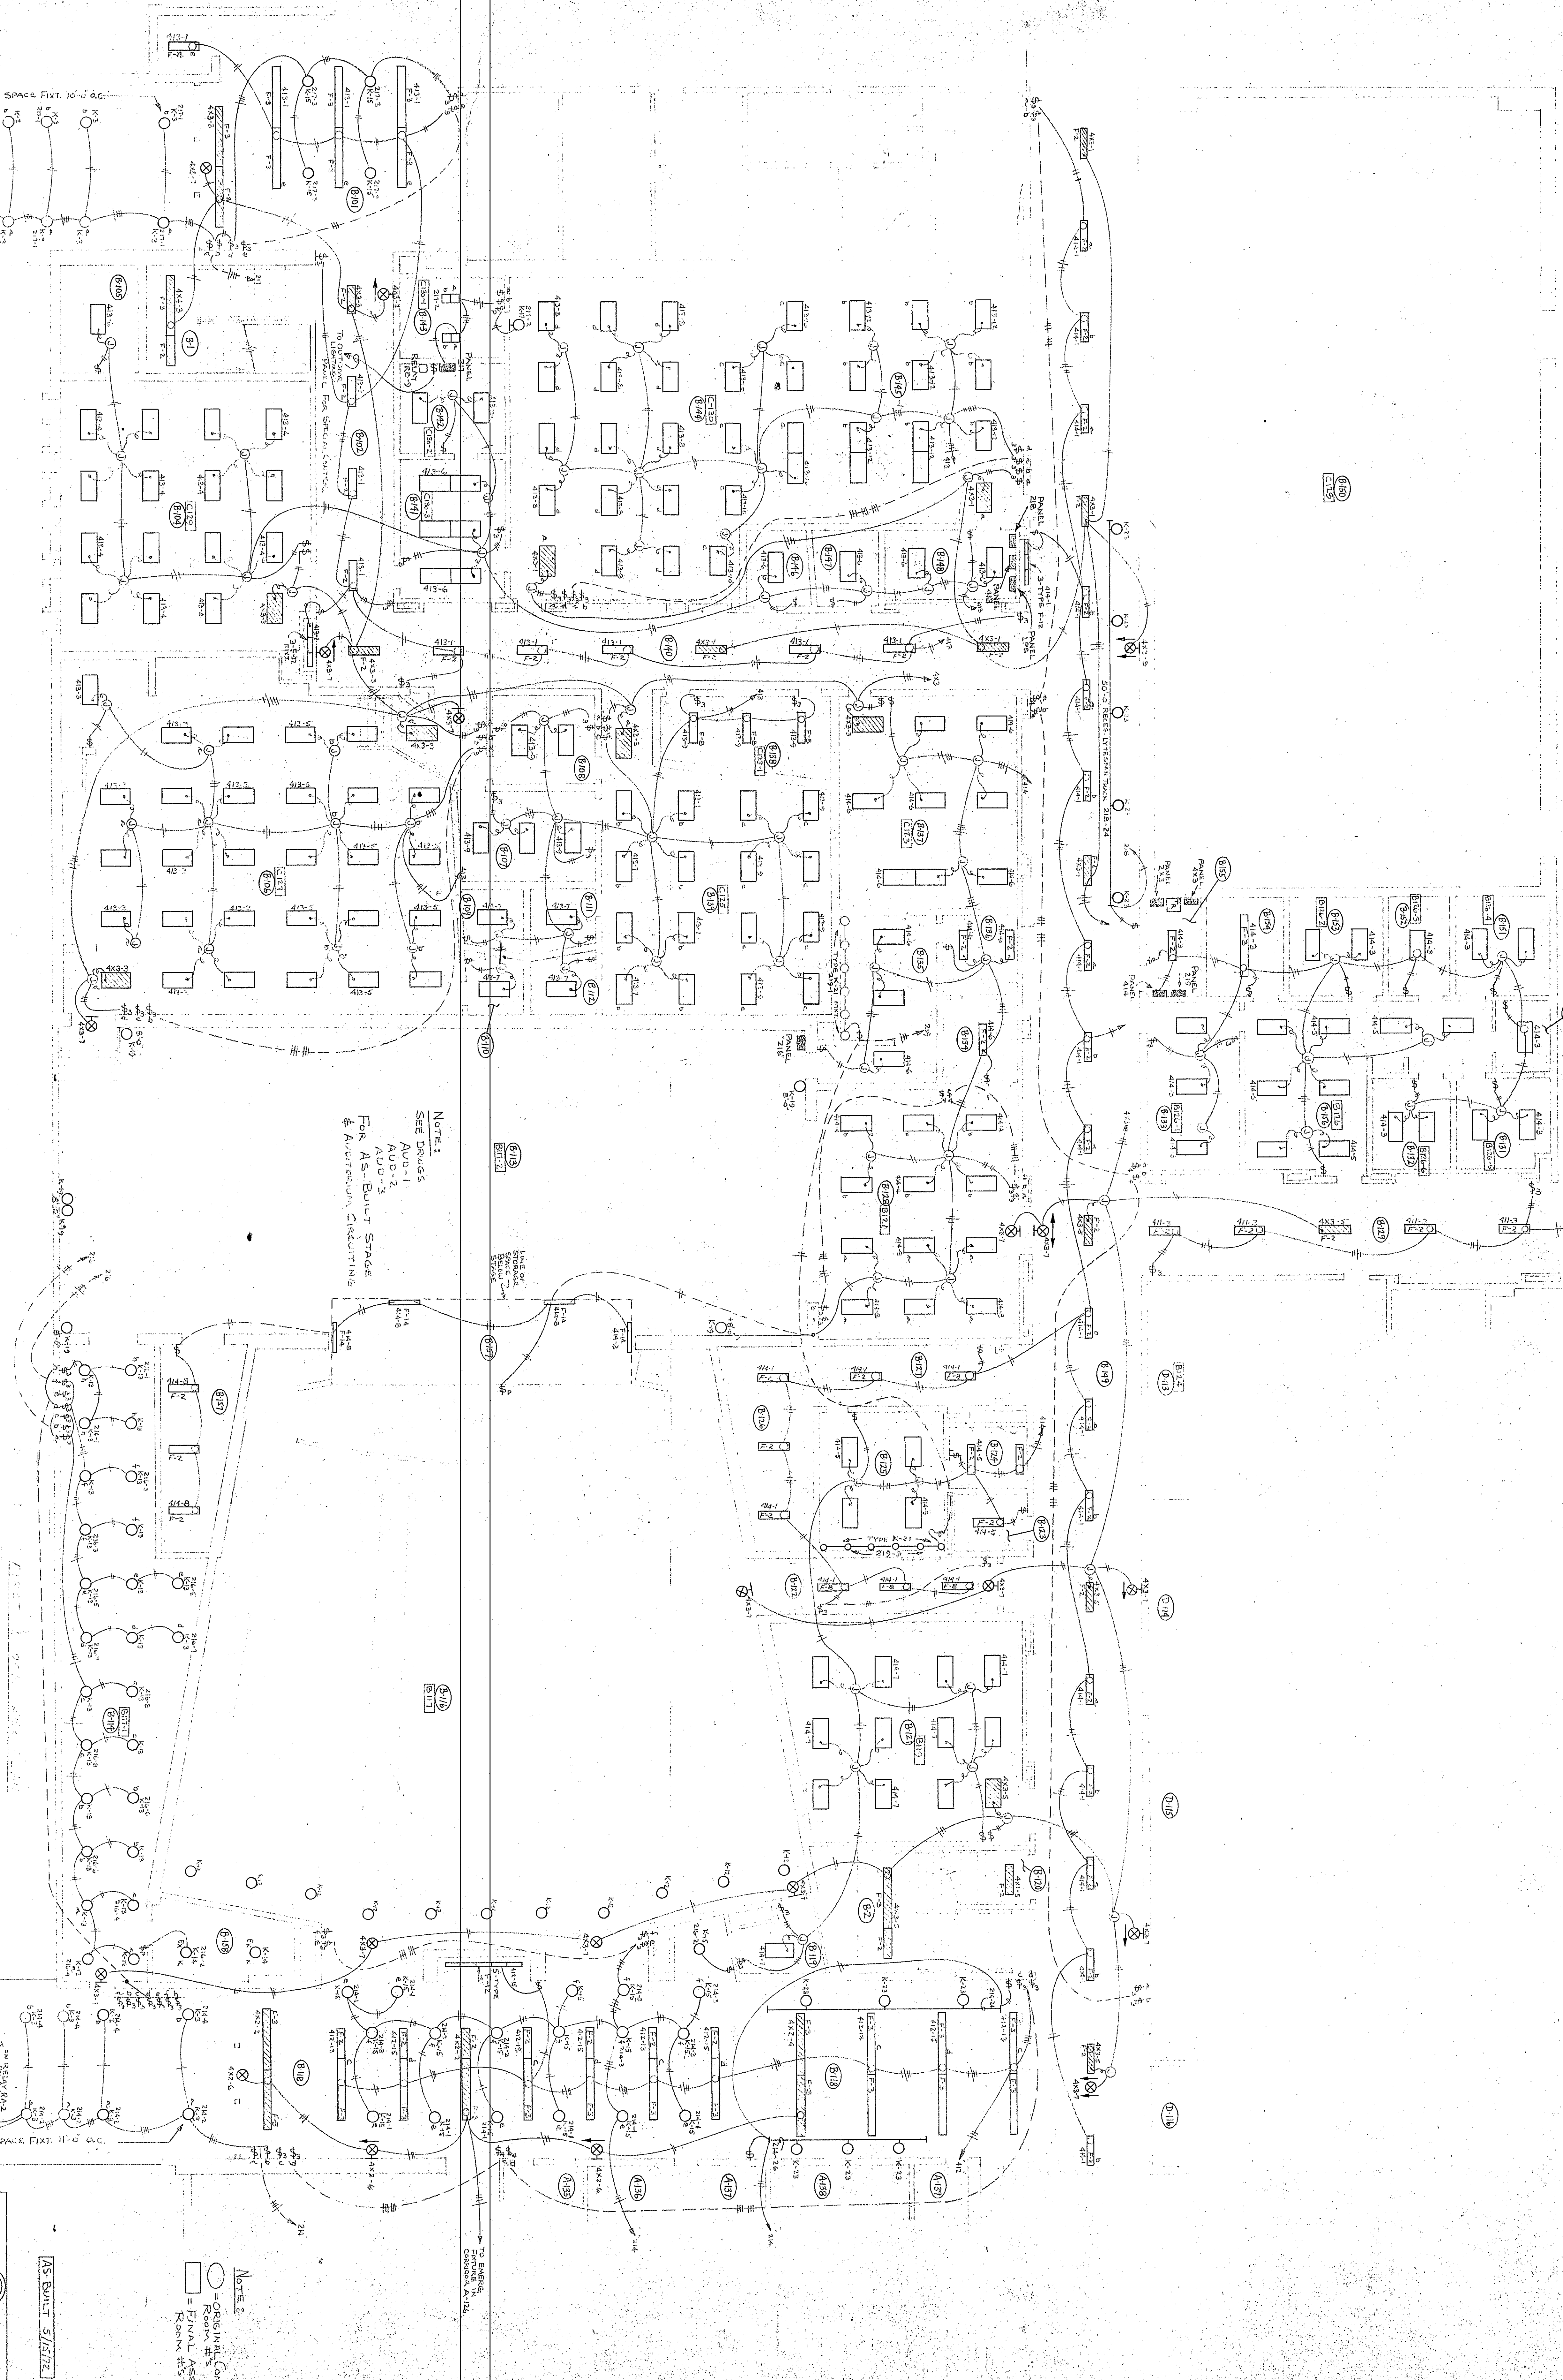

NOTE:
SEE DRUGS
AUD-1
AUD-2
FOR AS-BUILT STAGE
& AUTOMATIC CIRCUITING

NOTE:
○ = ORIGINAL CONSTRUCTION
□ = FINAL ASSIGNED
KONV 4-5

AS-BUILT 5/15/72 J/S

REV	DATE	BY	CHK
1	5/15/72	J/S	W/H
EVERETT I. BROWN CO. ARCH. & ENG.			
CHESTERTON SENIOR HIGH SCHOOL			
E-4 - SDA			
SHOP DRAWING NO.			
PORTAGE, IND.			
CIRCLE ELECTRIC, INC.			
CONTRACTOR			
P.O. BOX 150			
PORTAGE, IND.			