


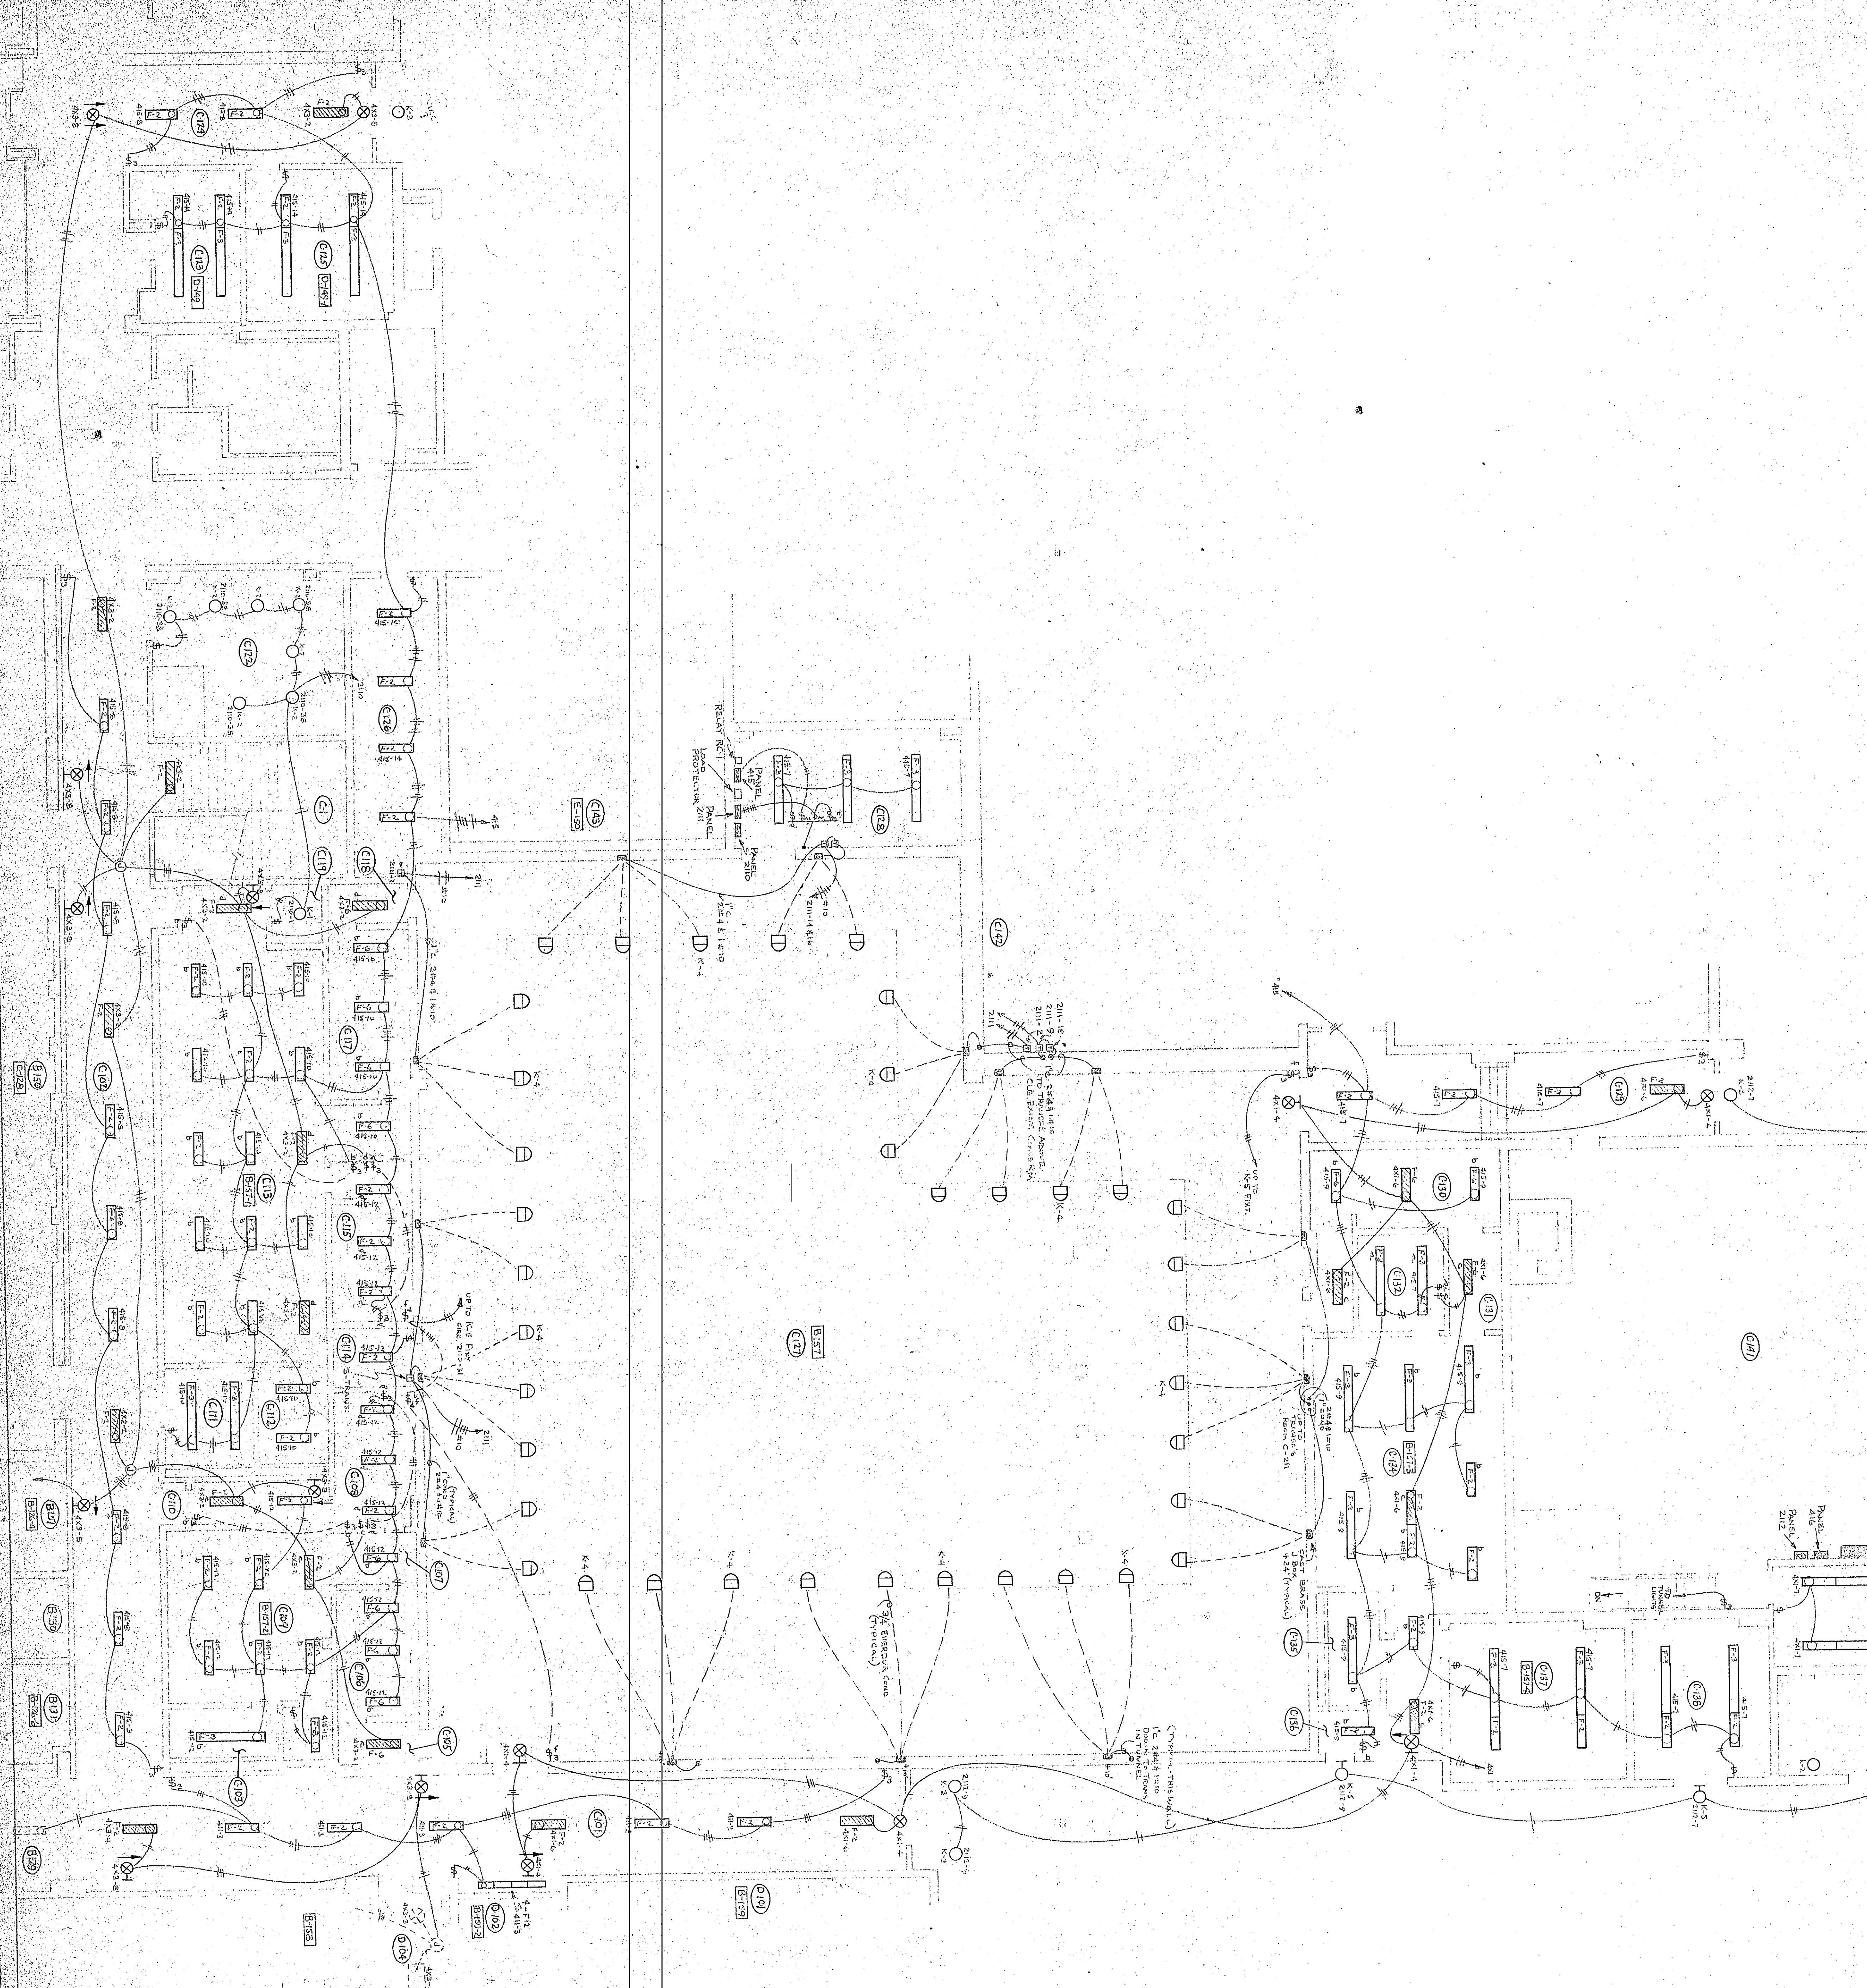

AS-BUILT 5/15/12
EVERETT I. BROWN CO. ARCH. & ENG.
CHESTERSTON SENIOR HIGH SCHOOL
F-7 SDA
SHOP DRAWING NO. 130
PORTAGE, IN

CIRCLE ELECTRIC INC.
CONTRACTOR
130
PORTAGE, IN

1st Floor Key Plan

14-1