
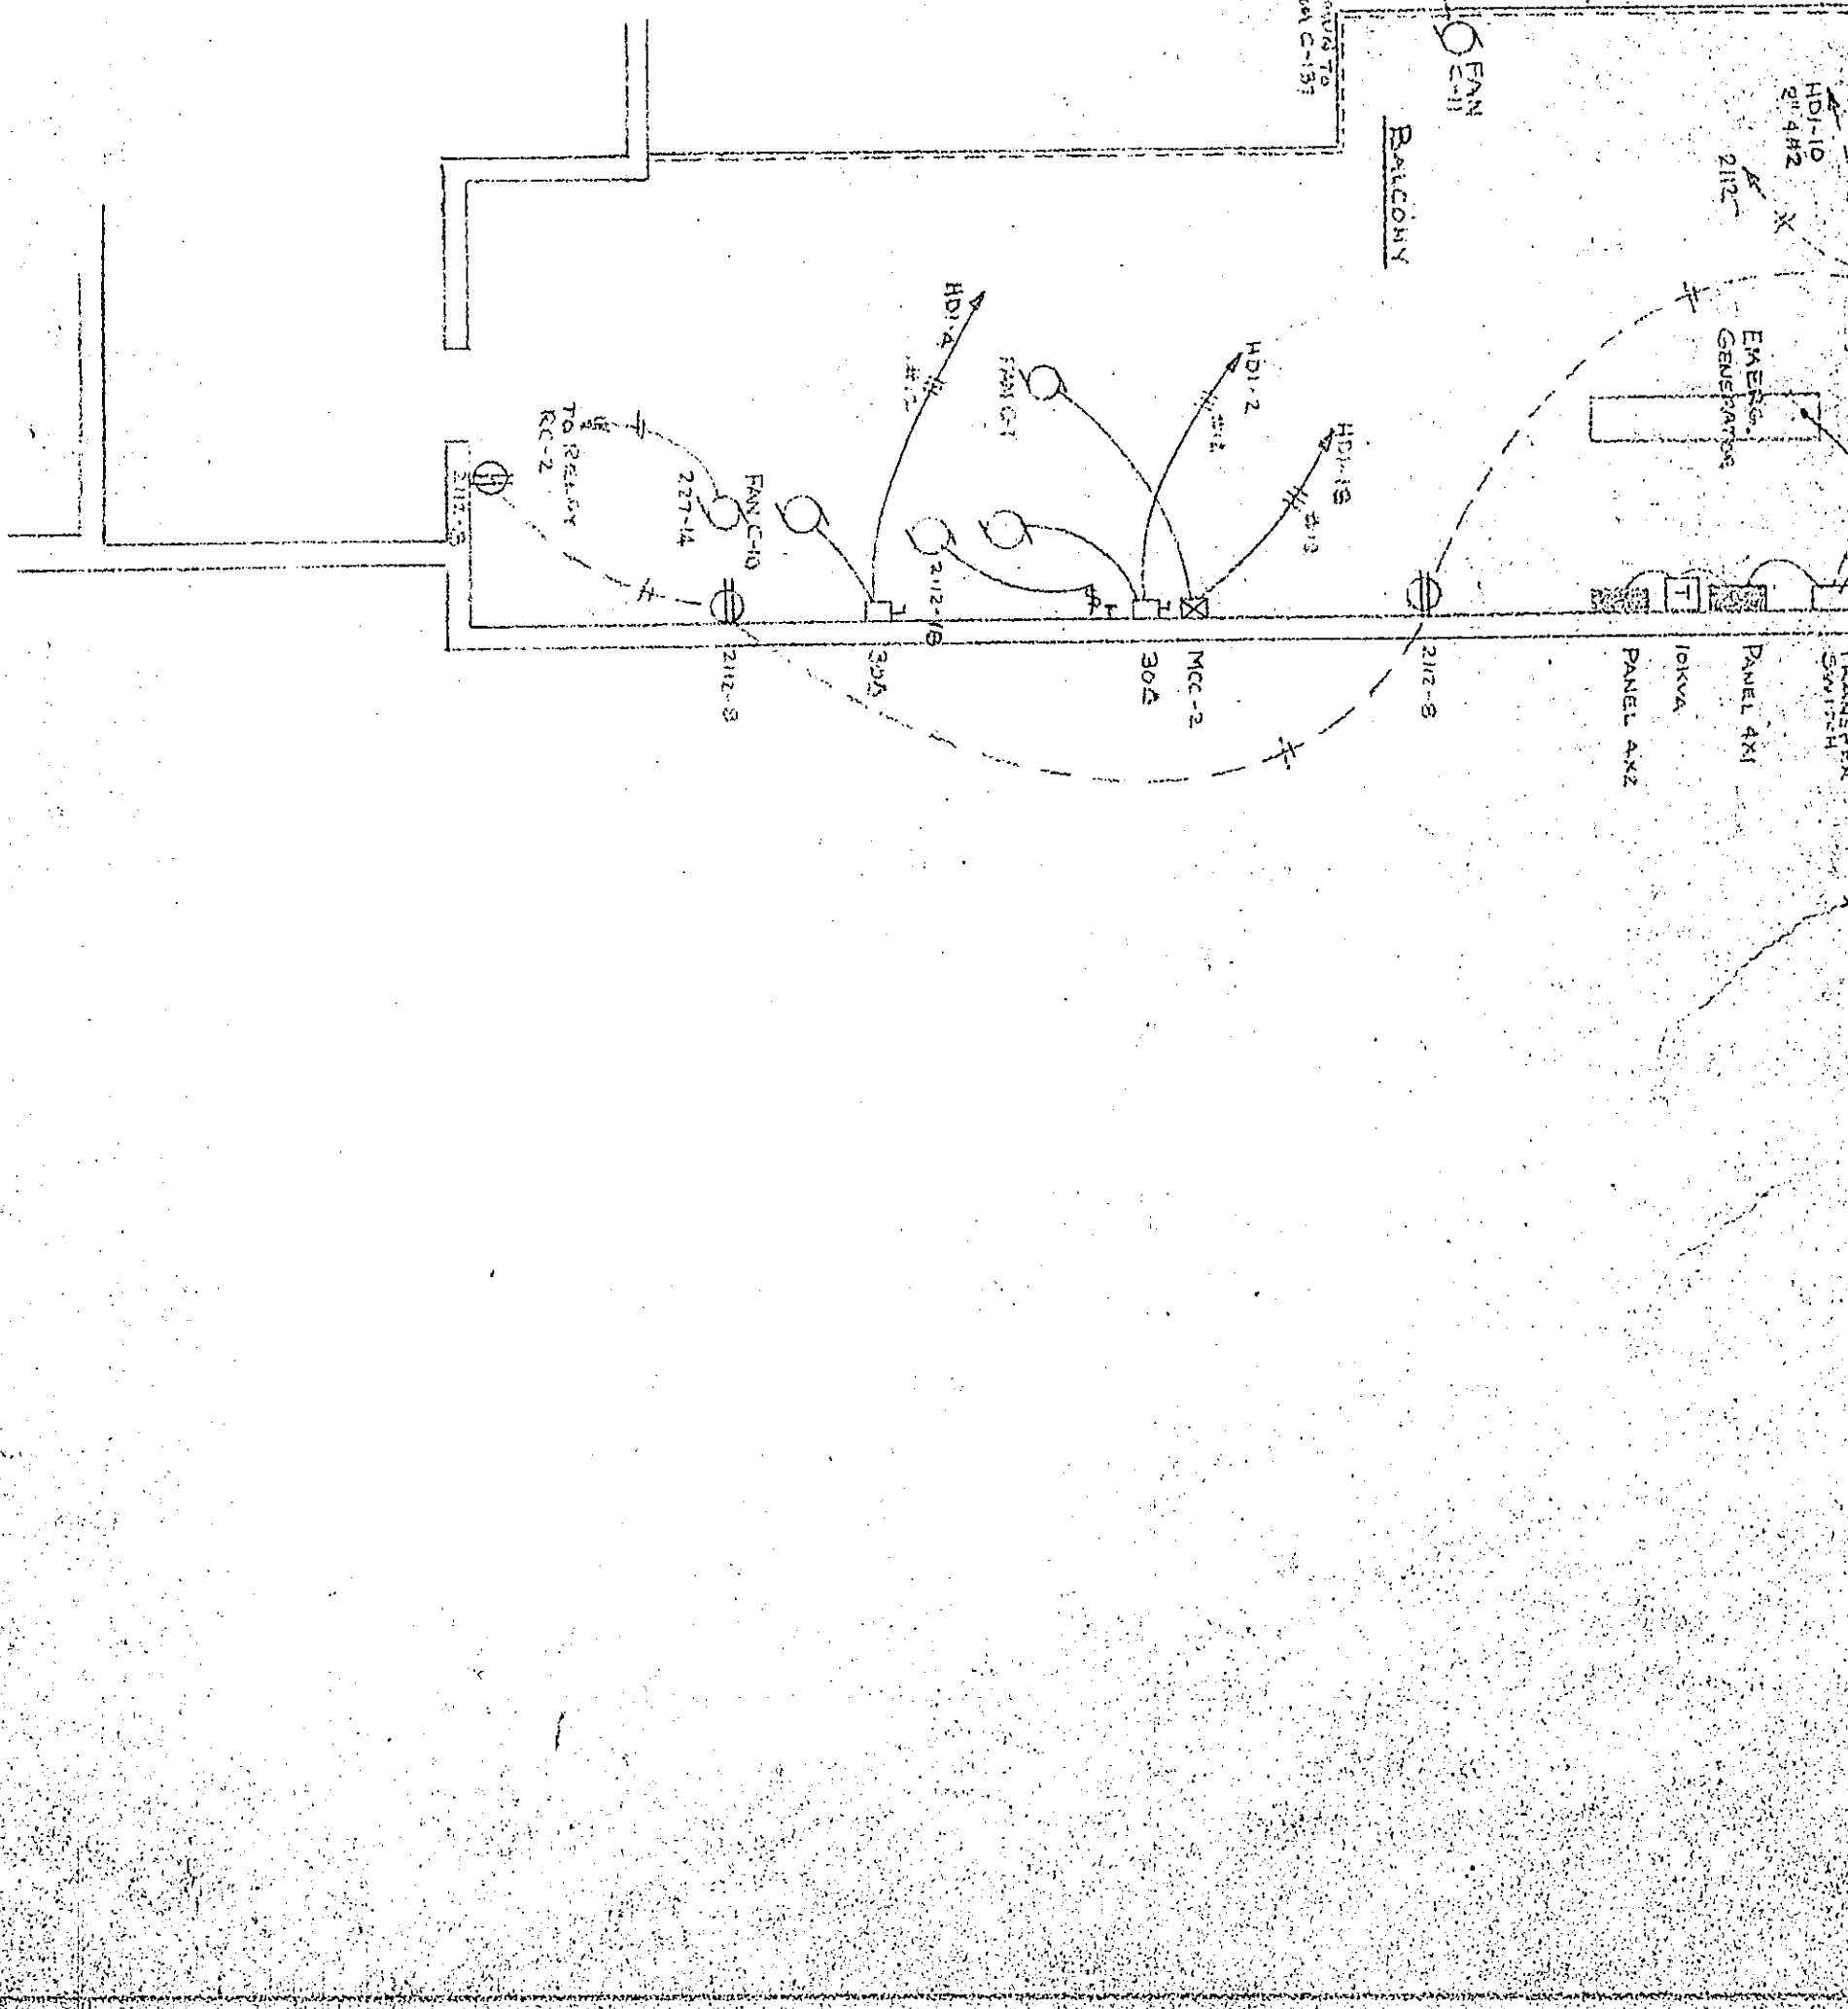


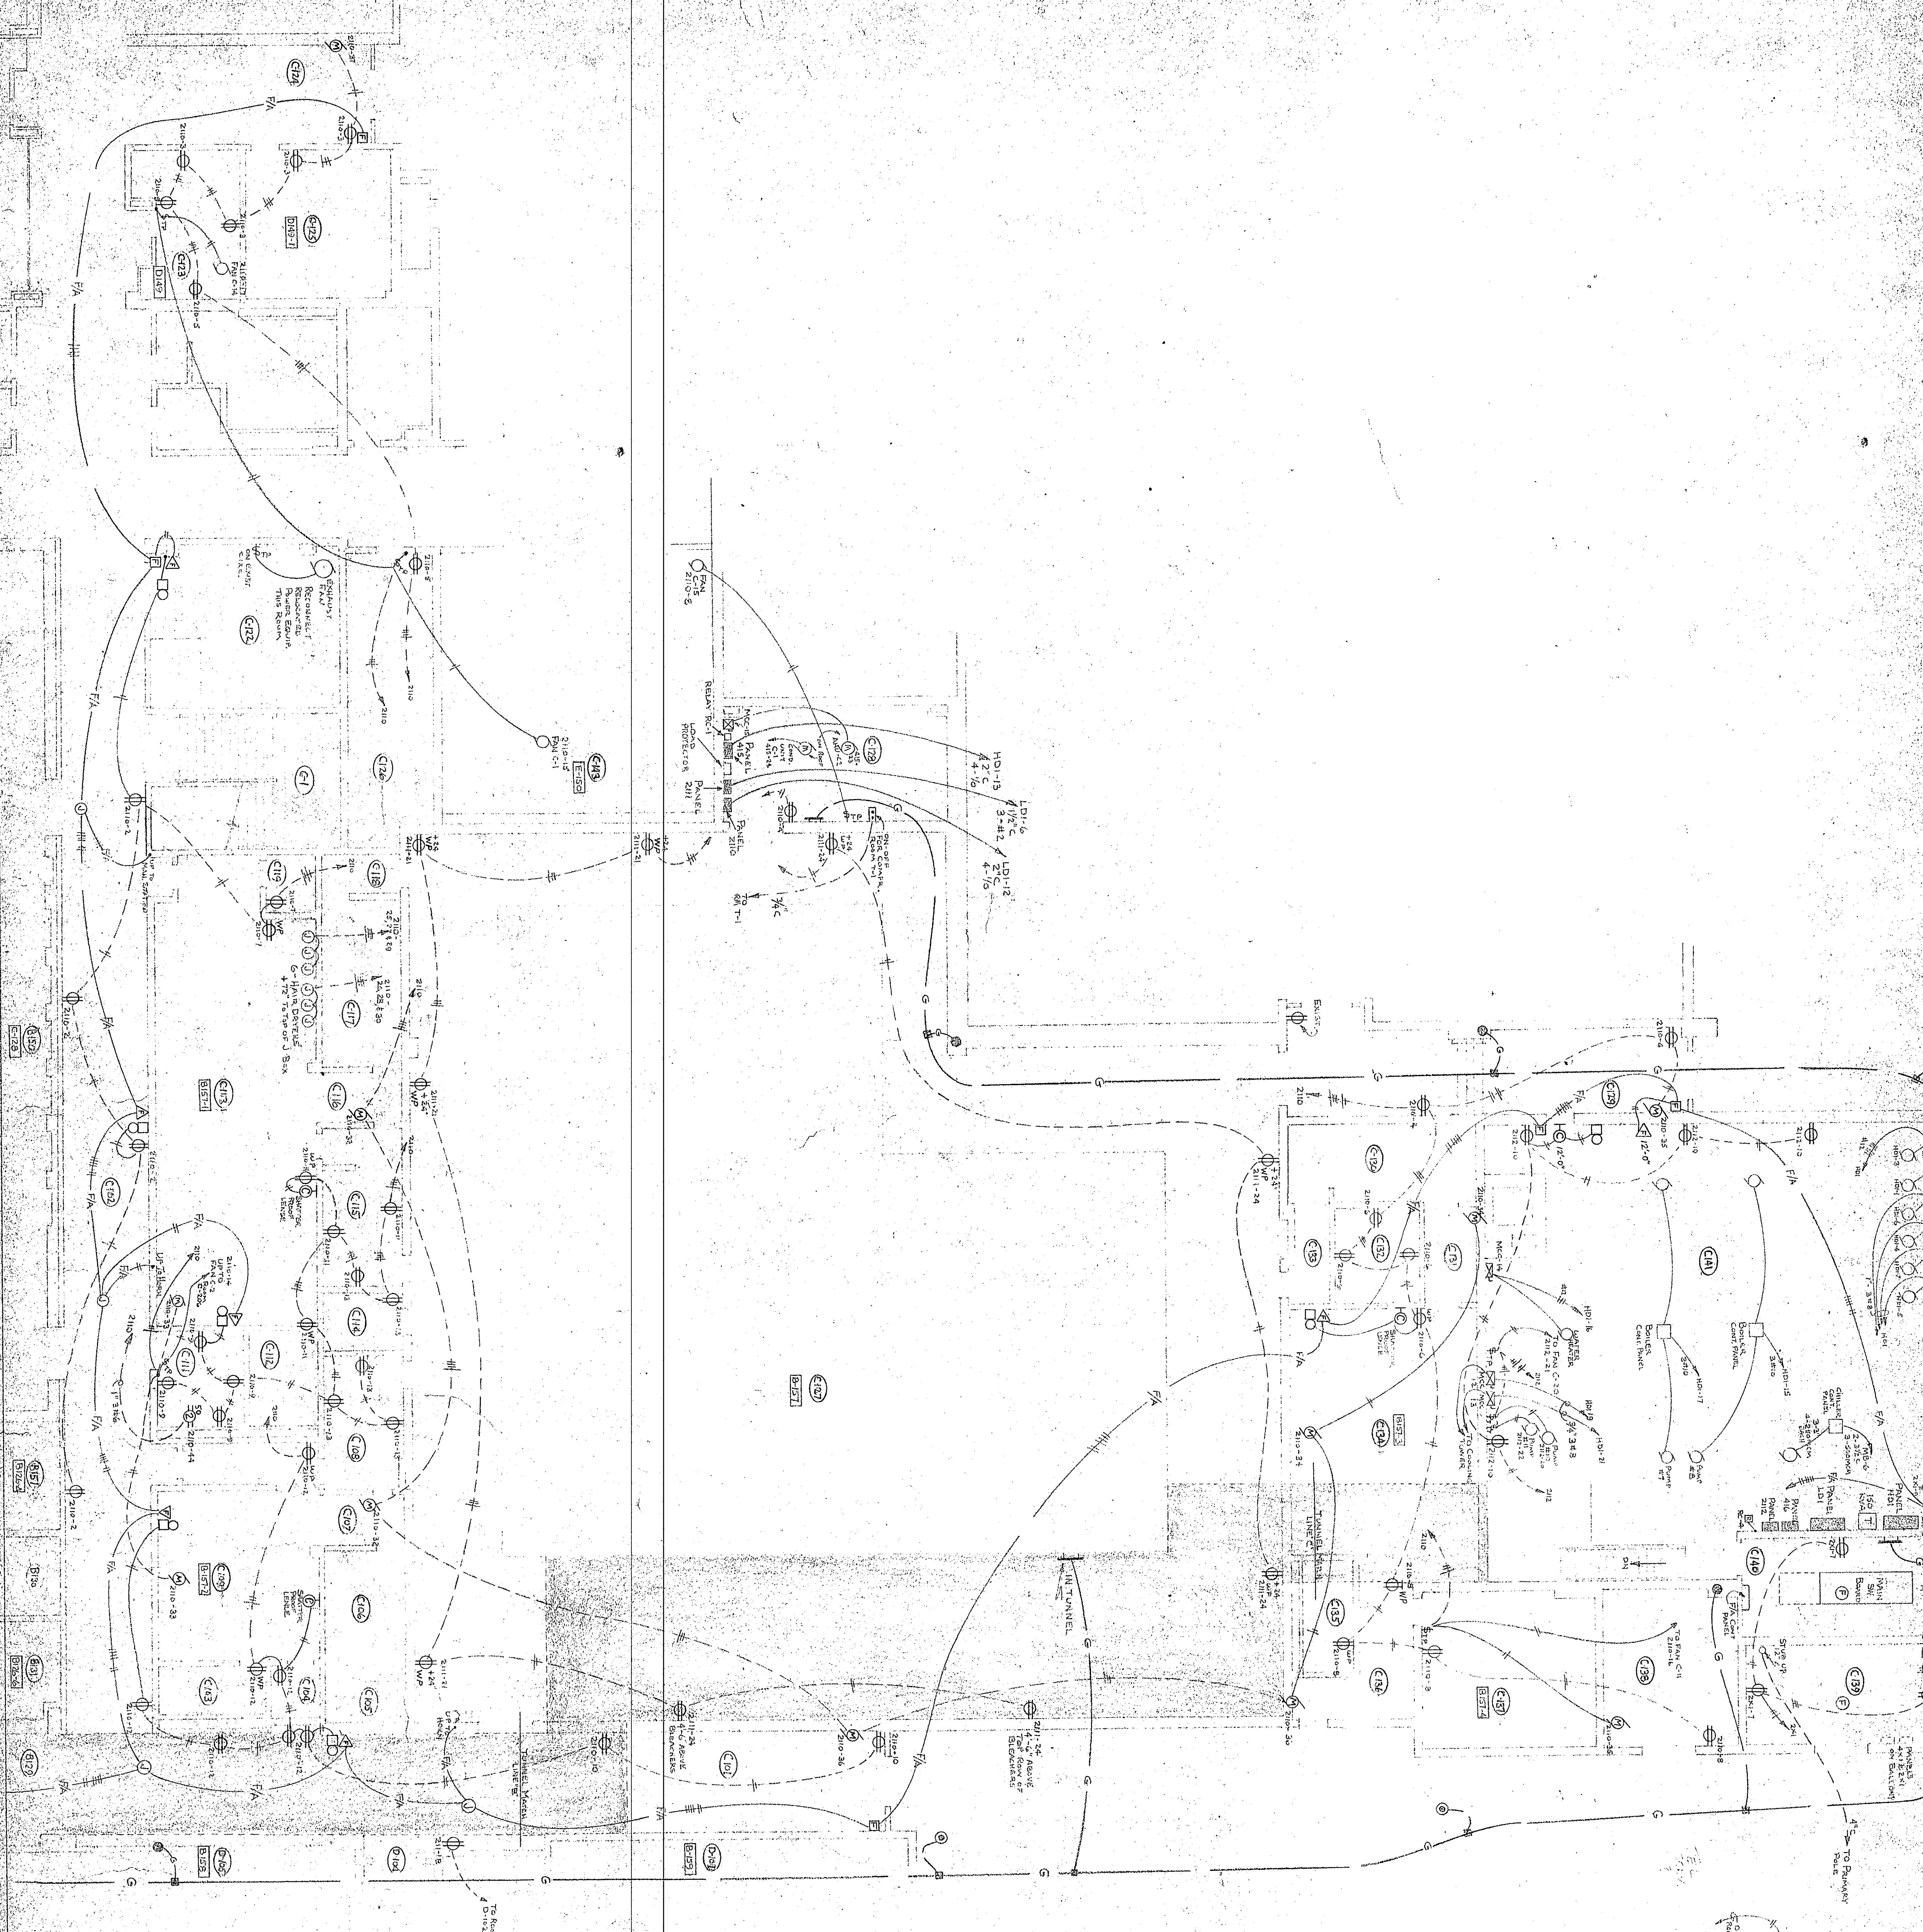

AS-BUILT 6/16/72 VM

EVERETT I. BROWN CO. ARCH. & ENG.

SHIP DRAWING

1ST FLOOR KEY PLAN

CIRCLE P ELECTRIC, INC.
CONTRACTOR
P.O. BOX 130
PORTAGE, IN

E-7-SDB