
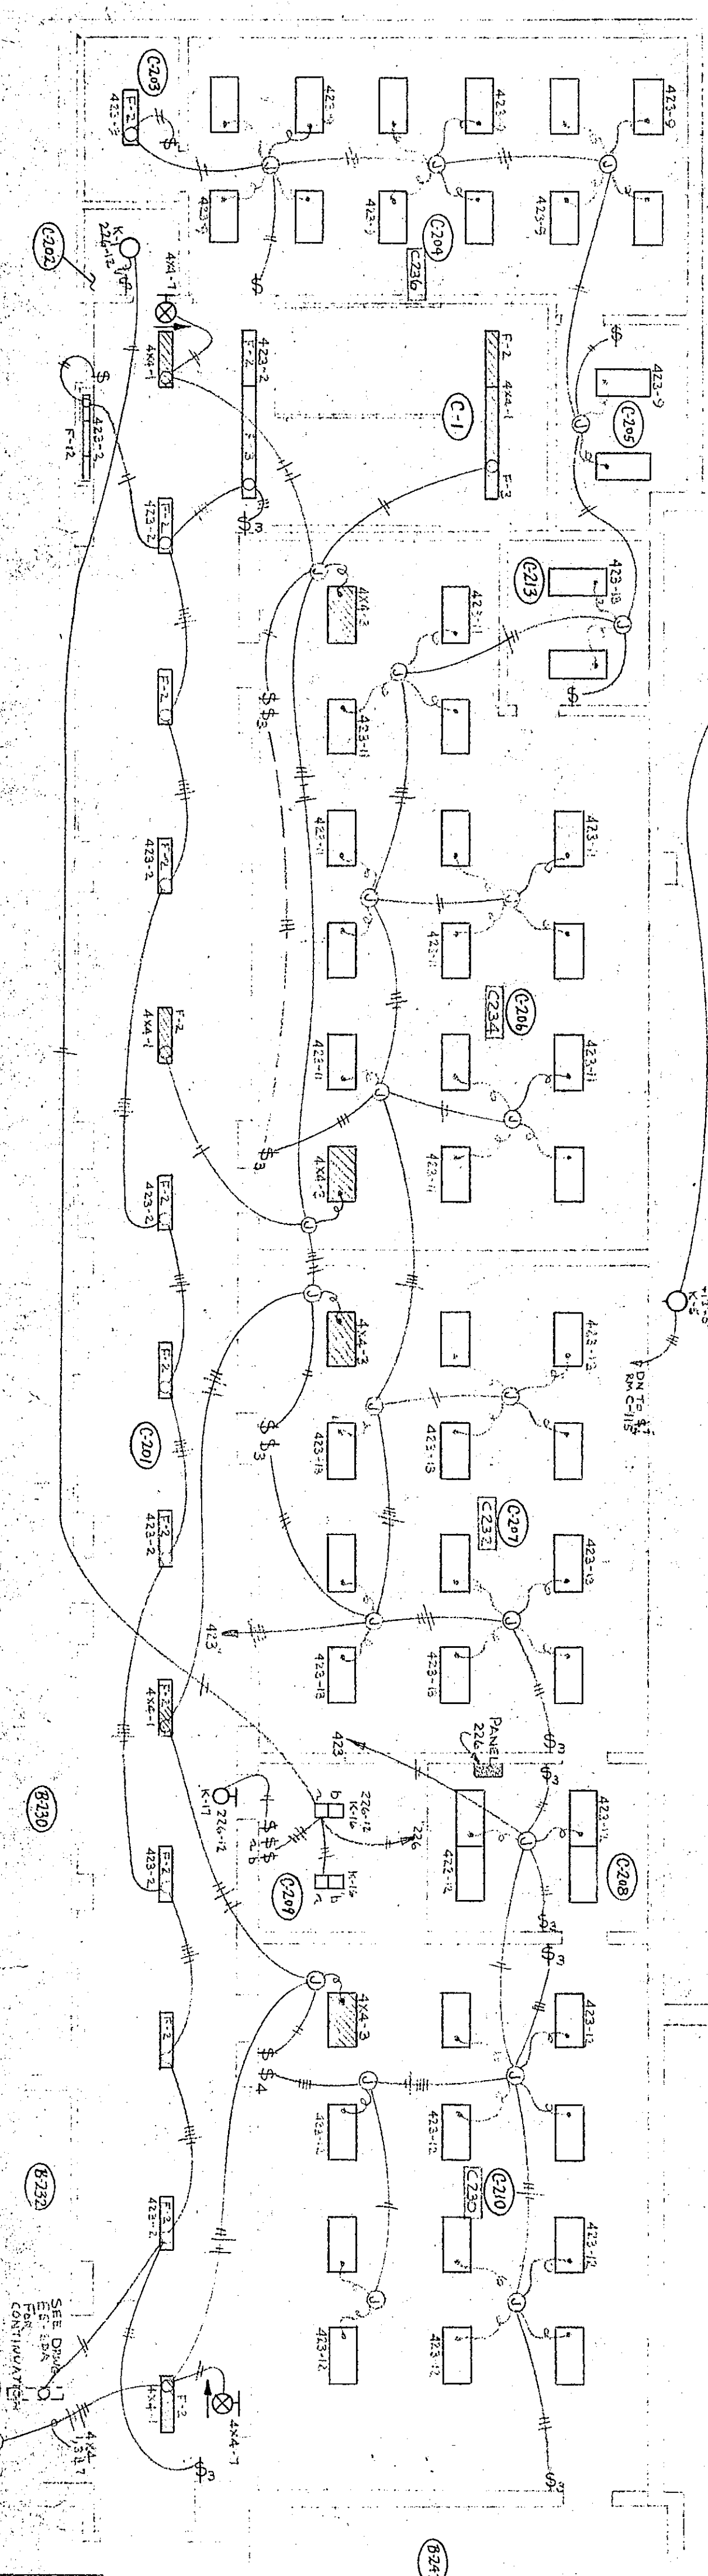
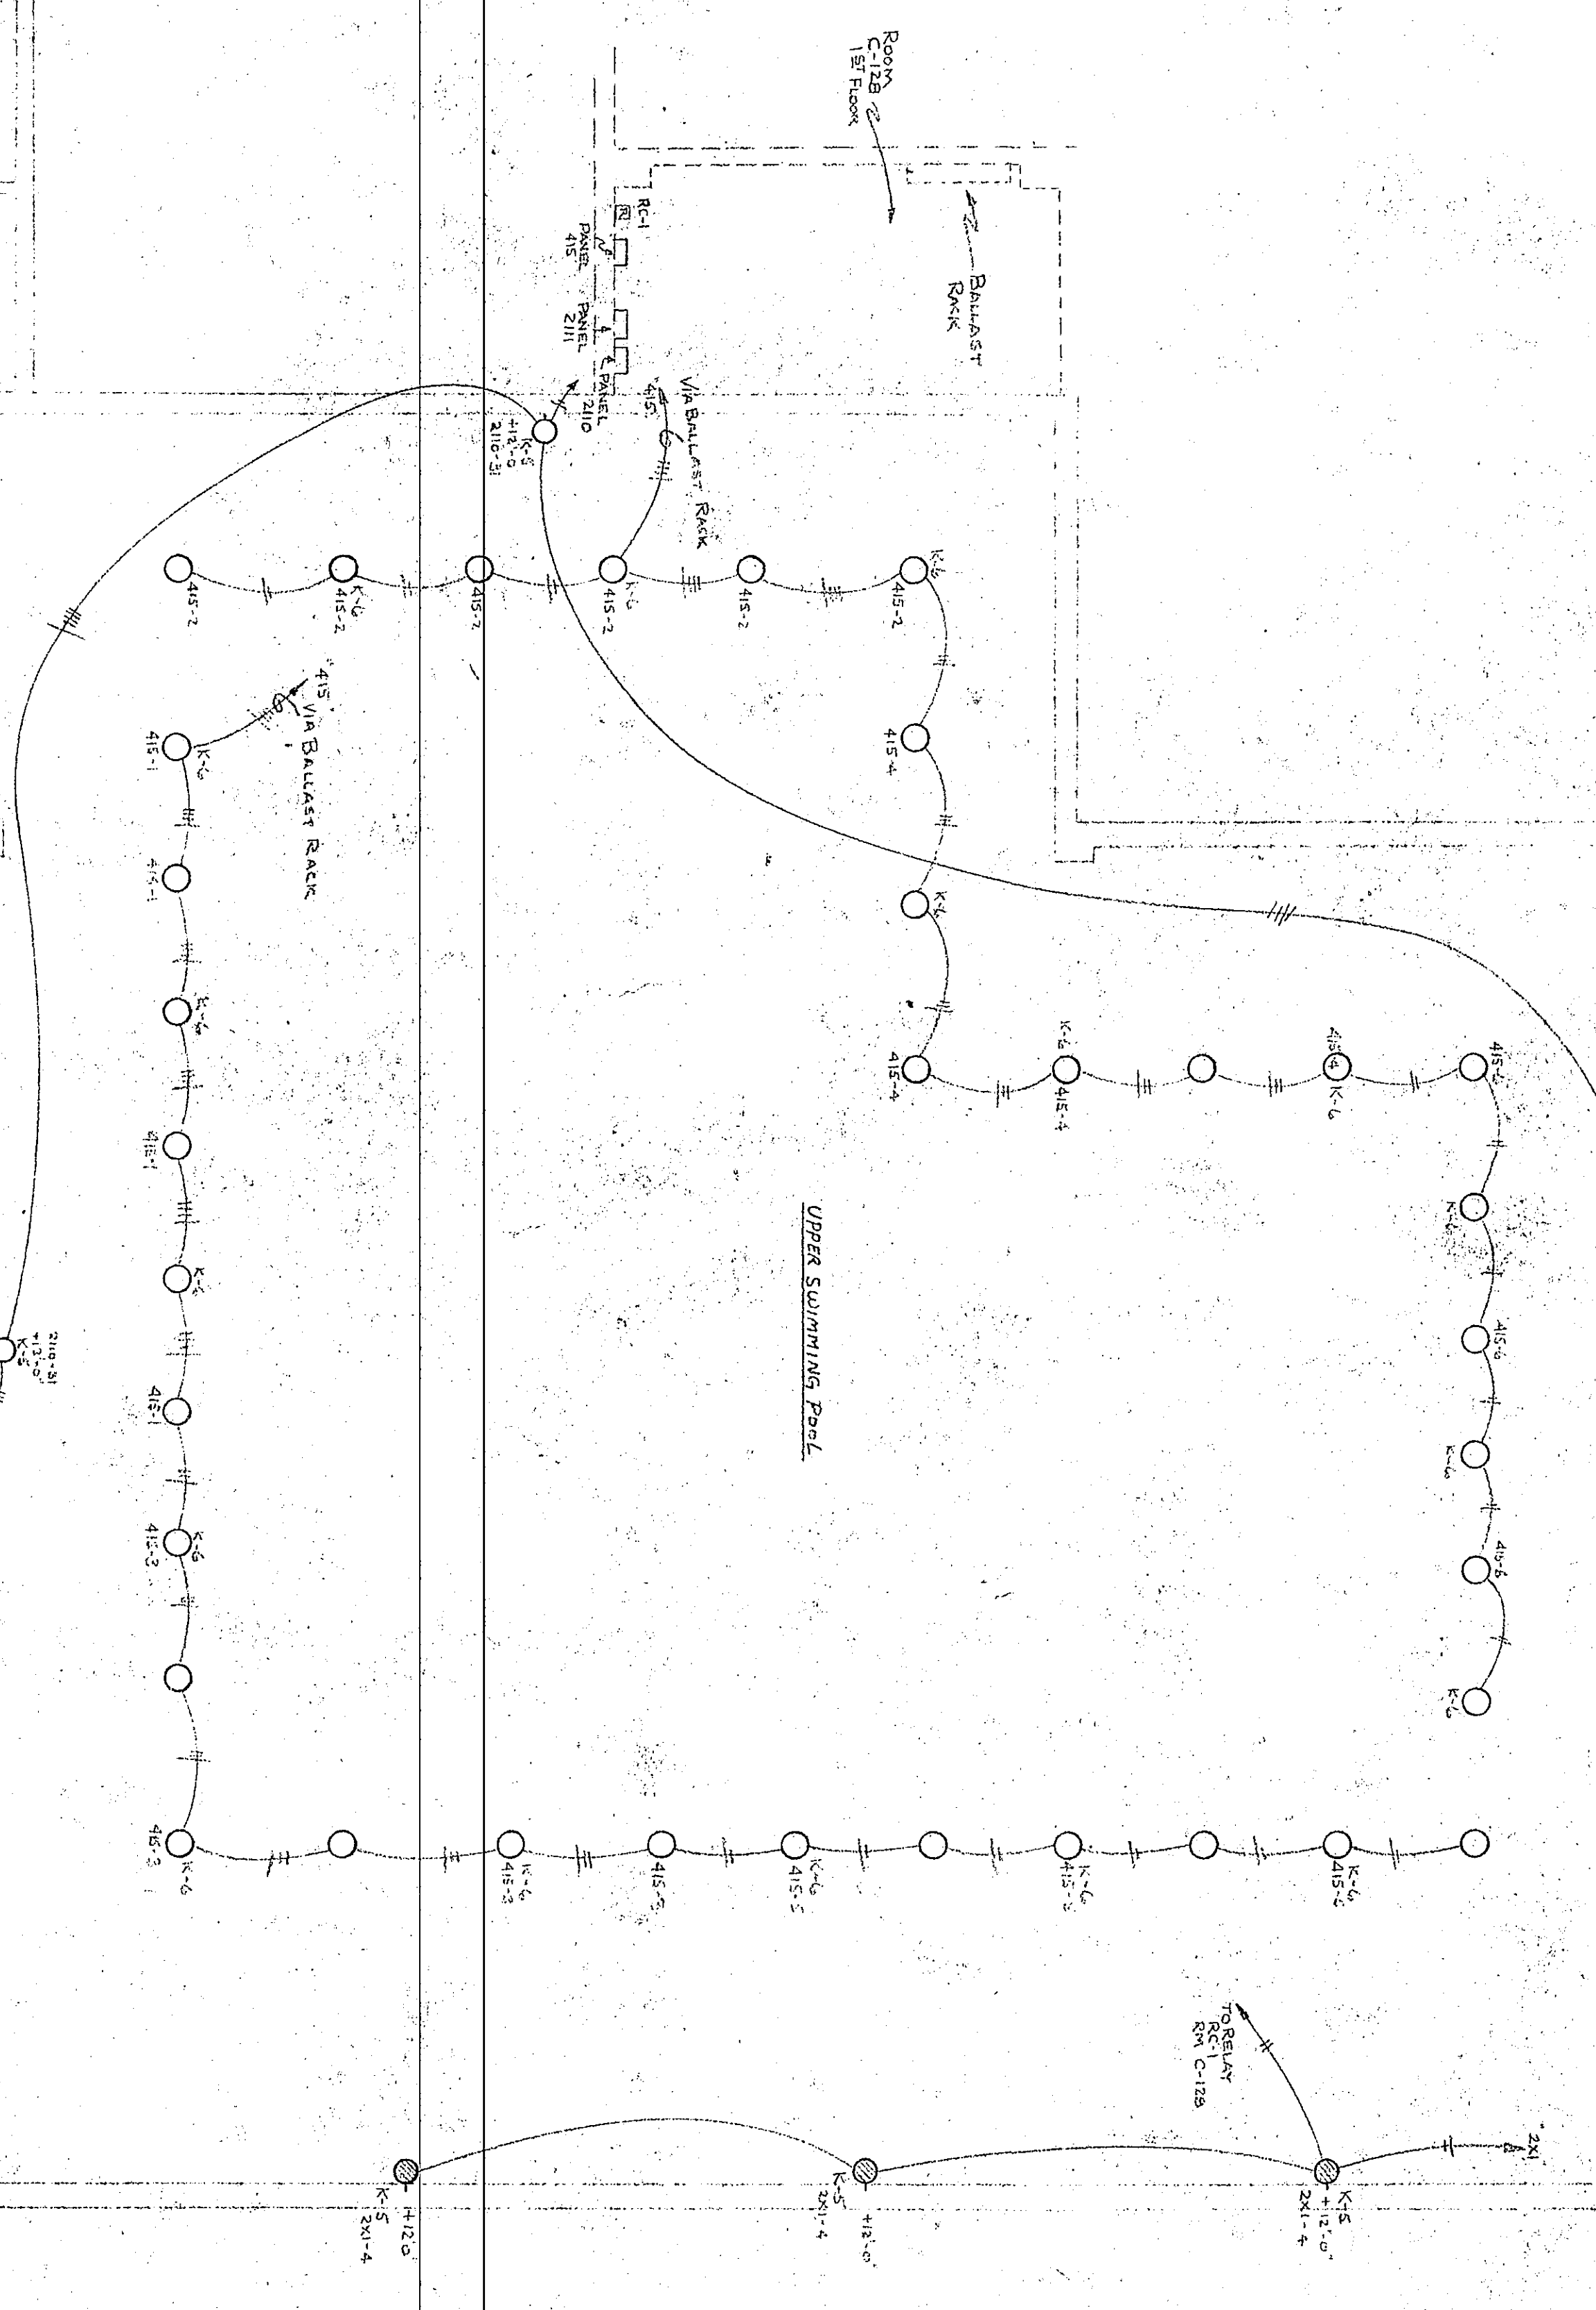


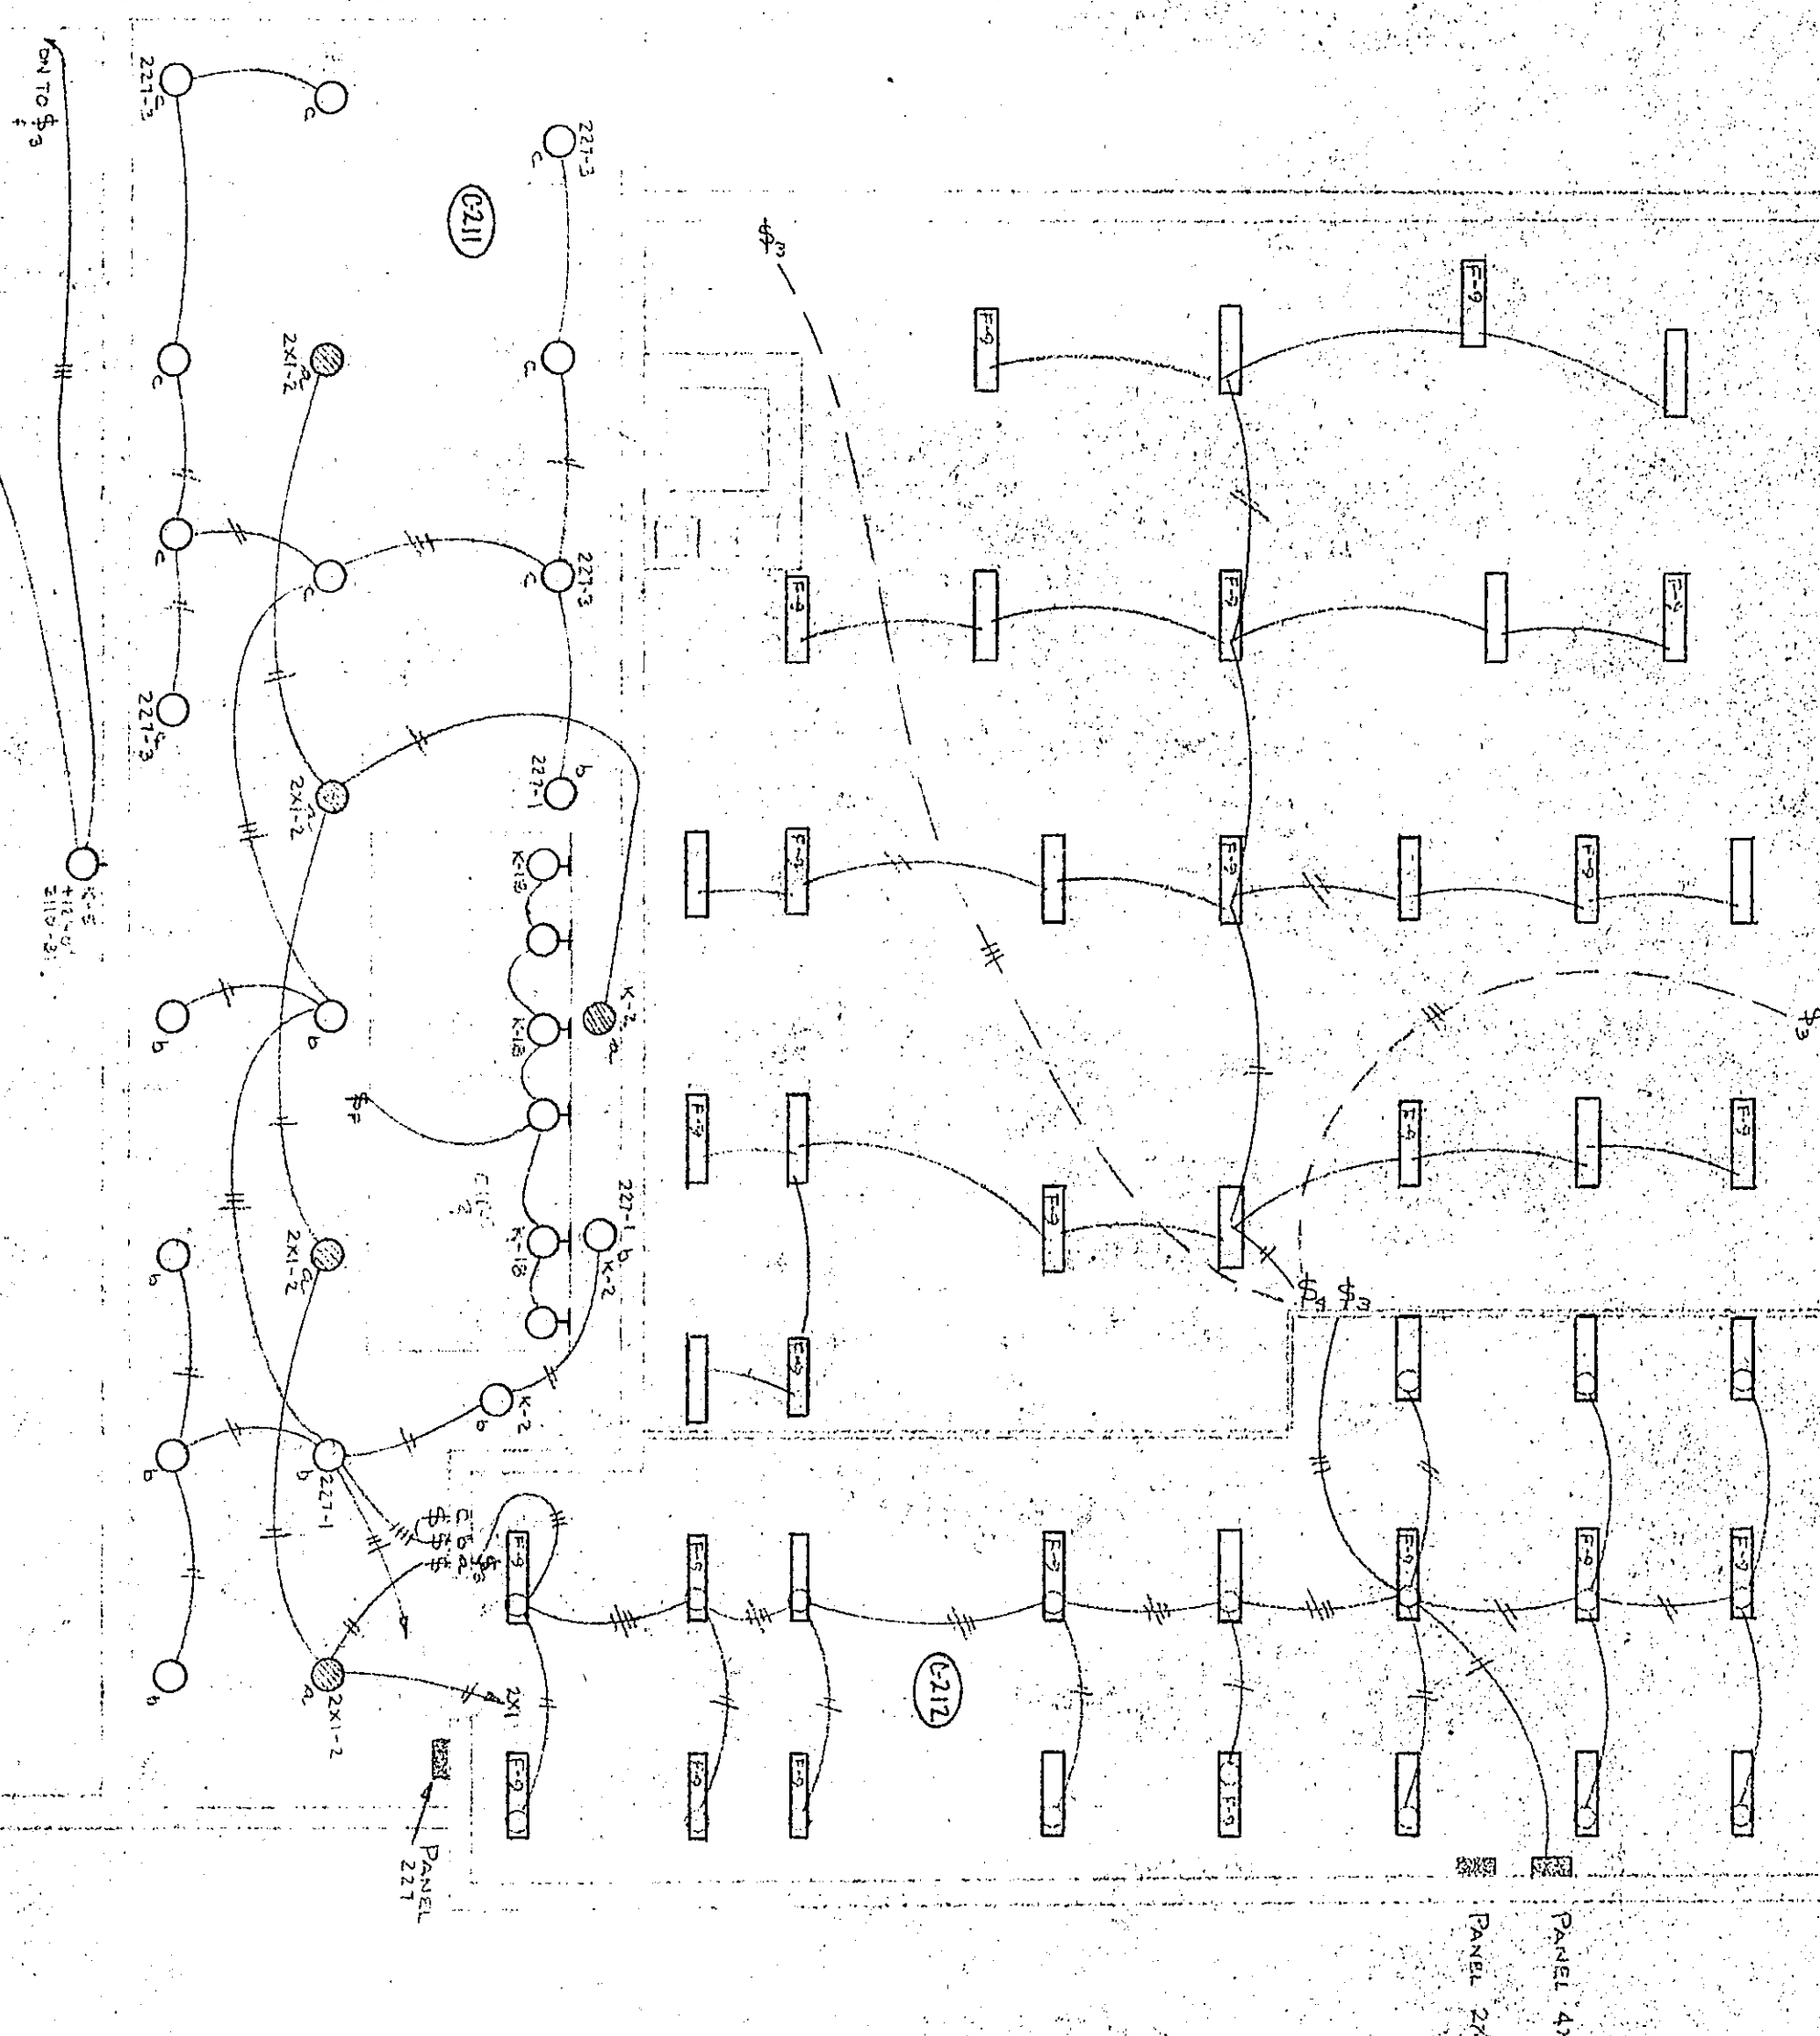

AS BUILT 5/17/77

EVERETT I. BROWN CO. ARCH. & ENG.

CHESTERTON SENIOR HIGH SCHOOL

SHOP DRAWING

CIRCLE R ELECTRIC INC.

CONTRACTOR

PO BOX 30

PORTLAND, IND.