


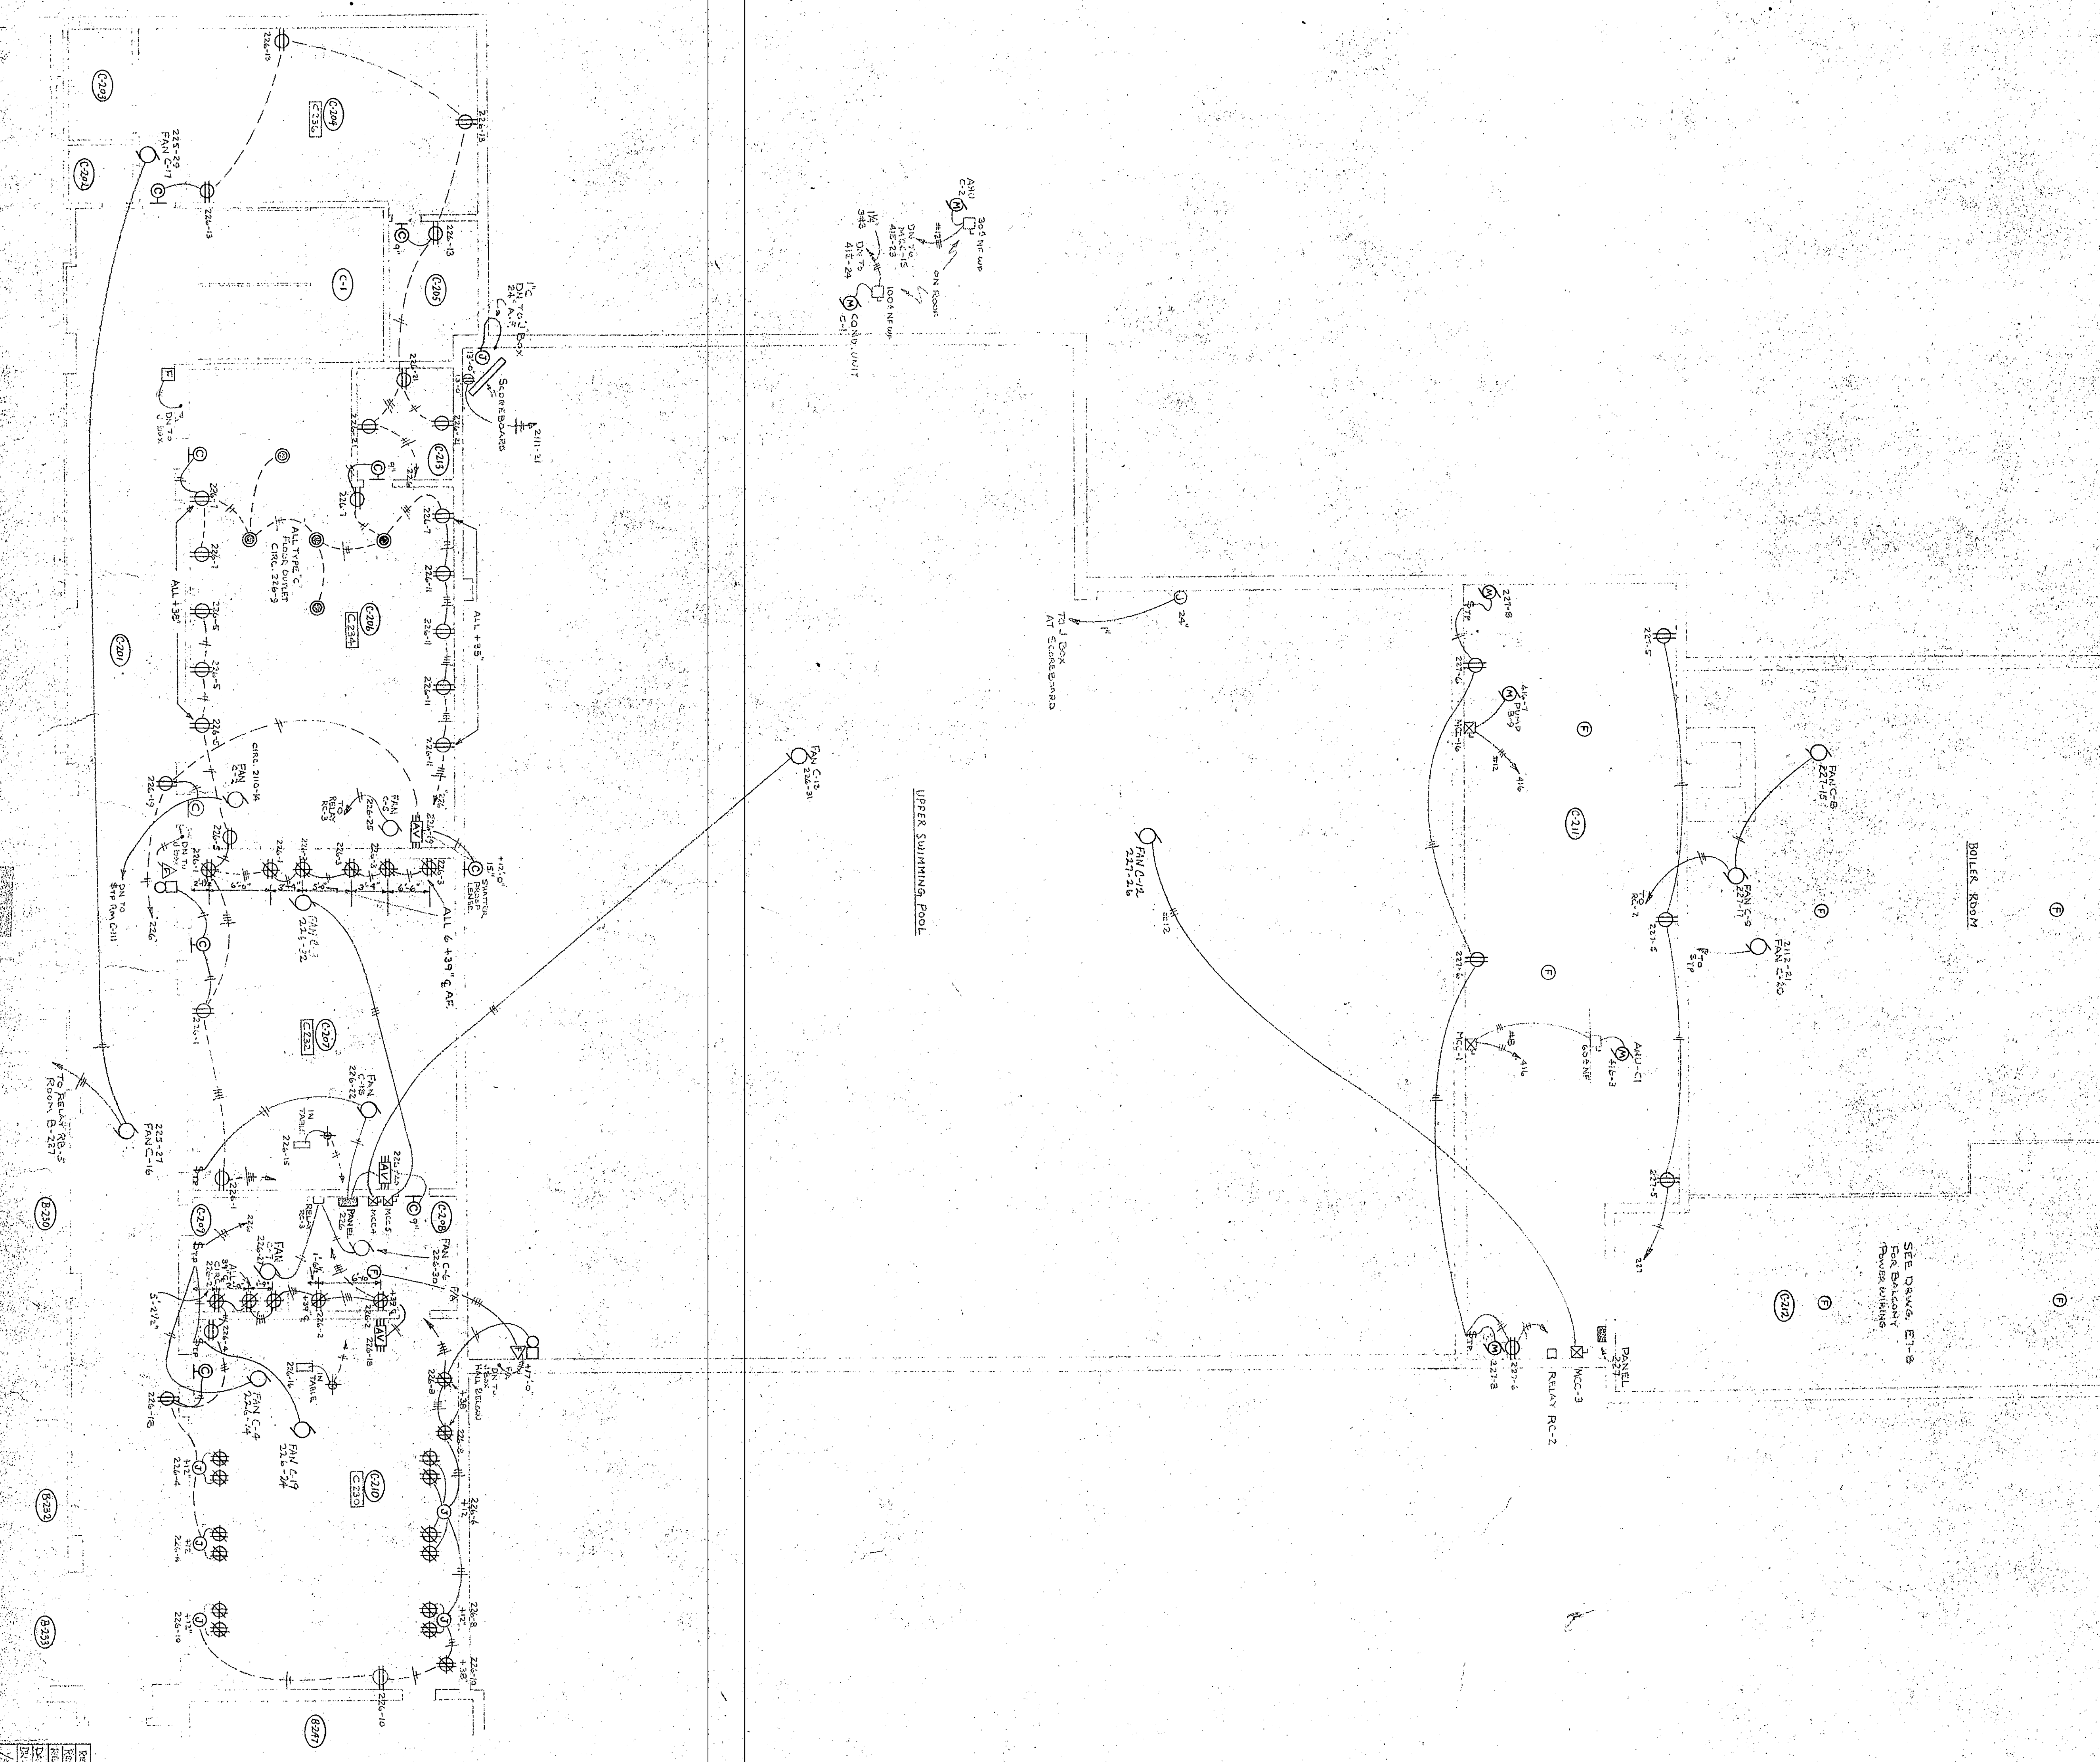

AS BUILT 5/15/72 1/4"

CIRCLE B ELECTRIC, INC.

CONTRACTOR

PORTAGE, IND.

EVERETT I. BROWN CO. ARCH. & ENG.

SHO-P-DRAWG, INC.

CHESTERTON SENIOR HIGH SCHOOL

E-8-SDB

7-1-72