


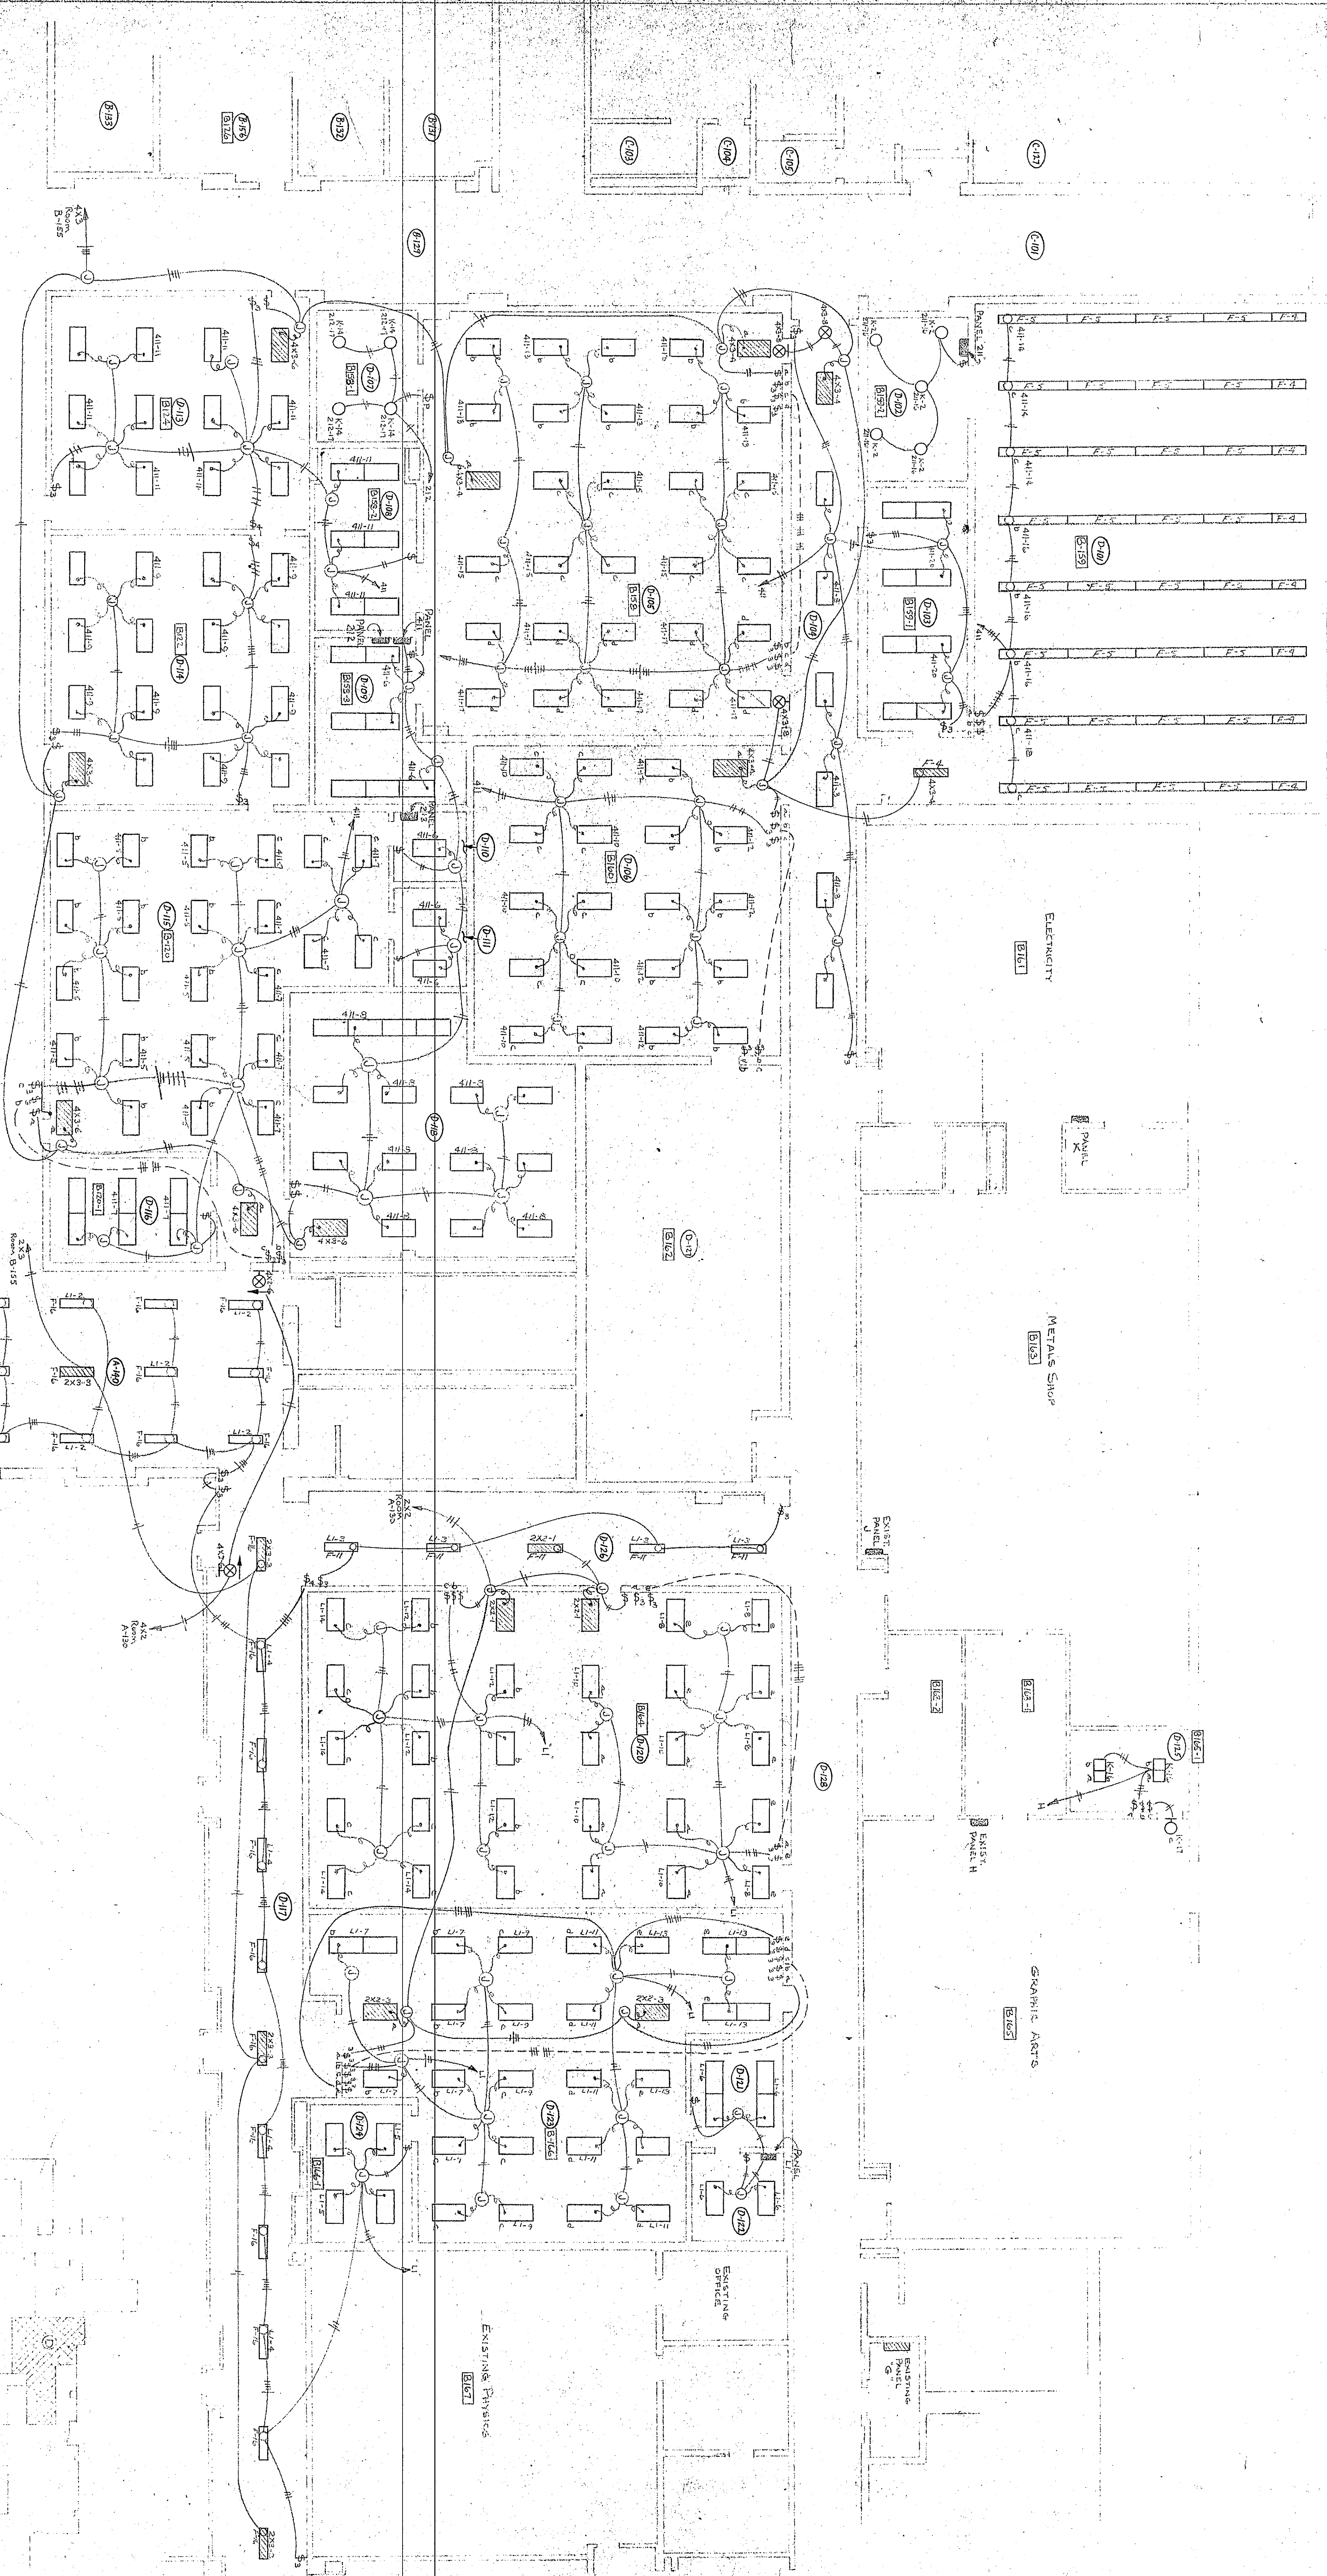

AS BUILT 5/12/12 VHF

CIRCLE B ELECTRIC, INC.		EVERETT J. BROWN CO. ARCH & ENG.	
CONTRACTOR		ARCHITECT	
PO BOX 7150 PORTLAND, OR 97207		PO BOX 7150 PORTLAND, OR 97207	
F-9810-SDA		SHOP DRAWING	