
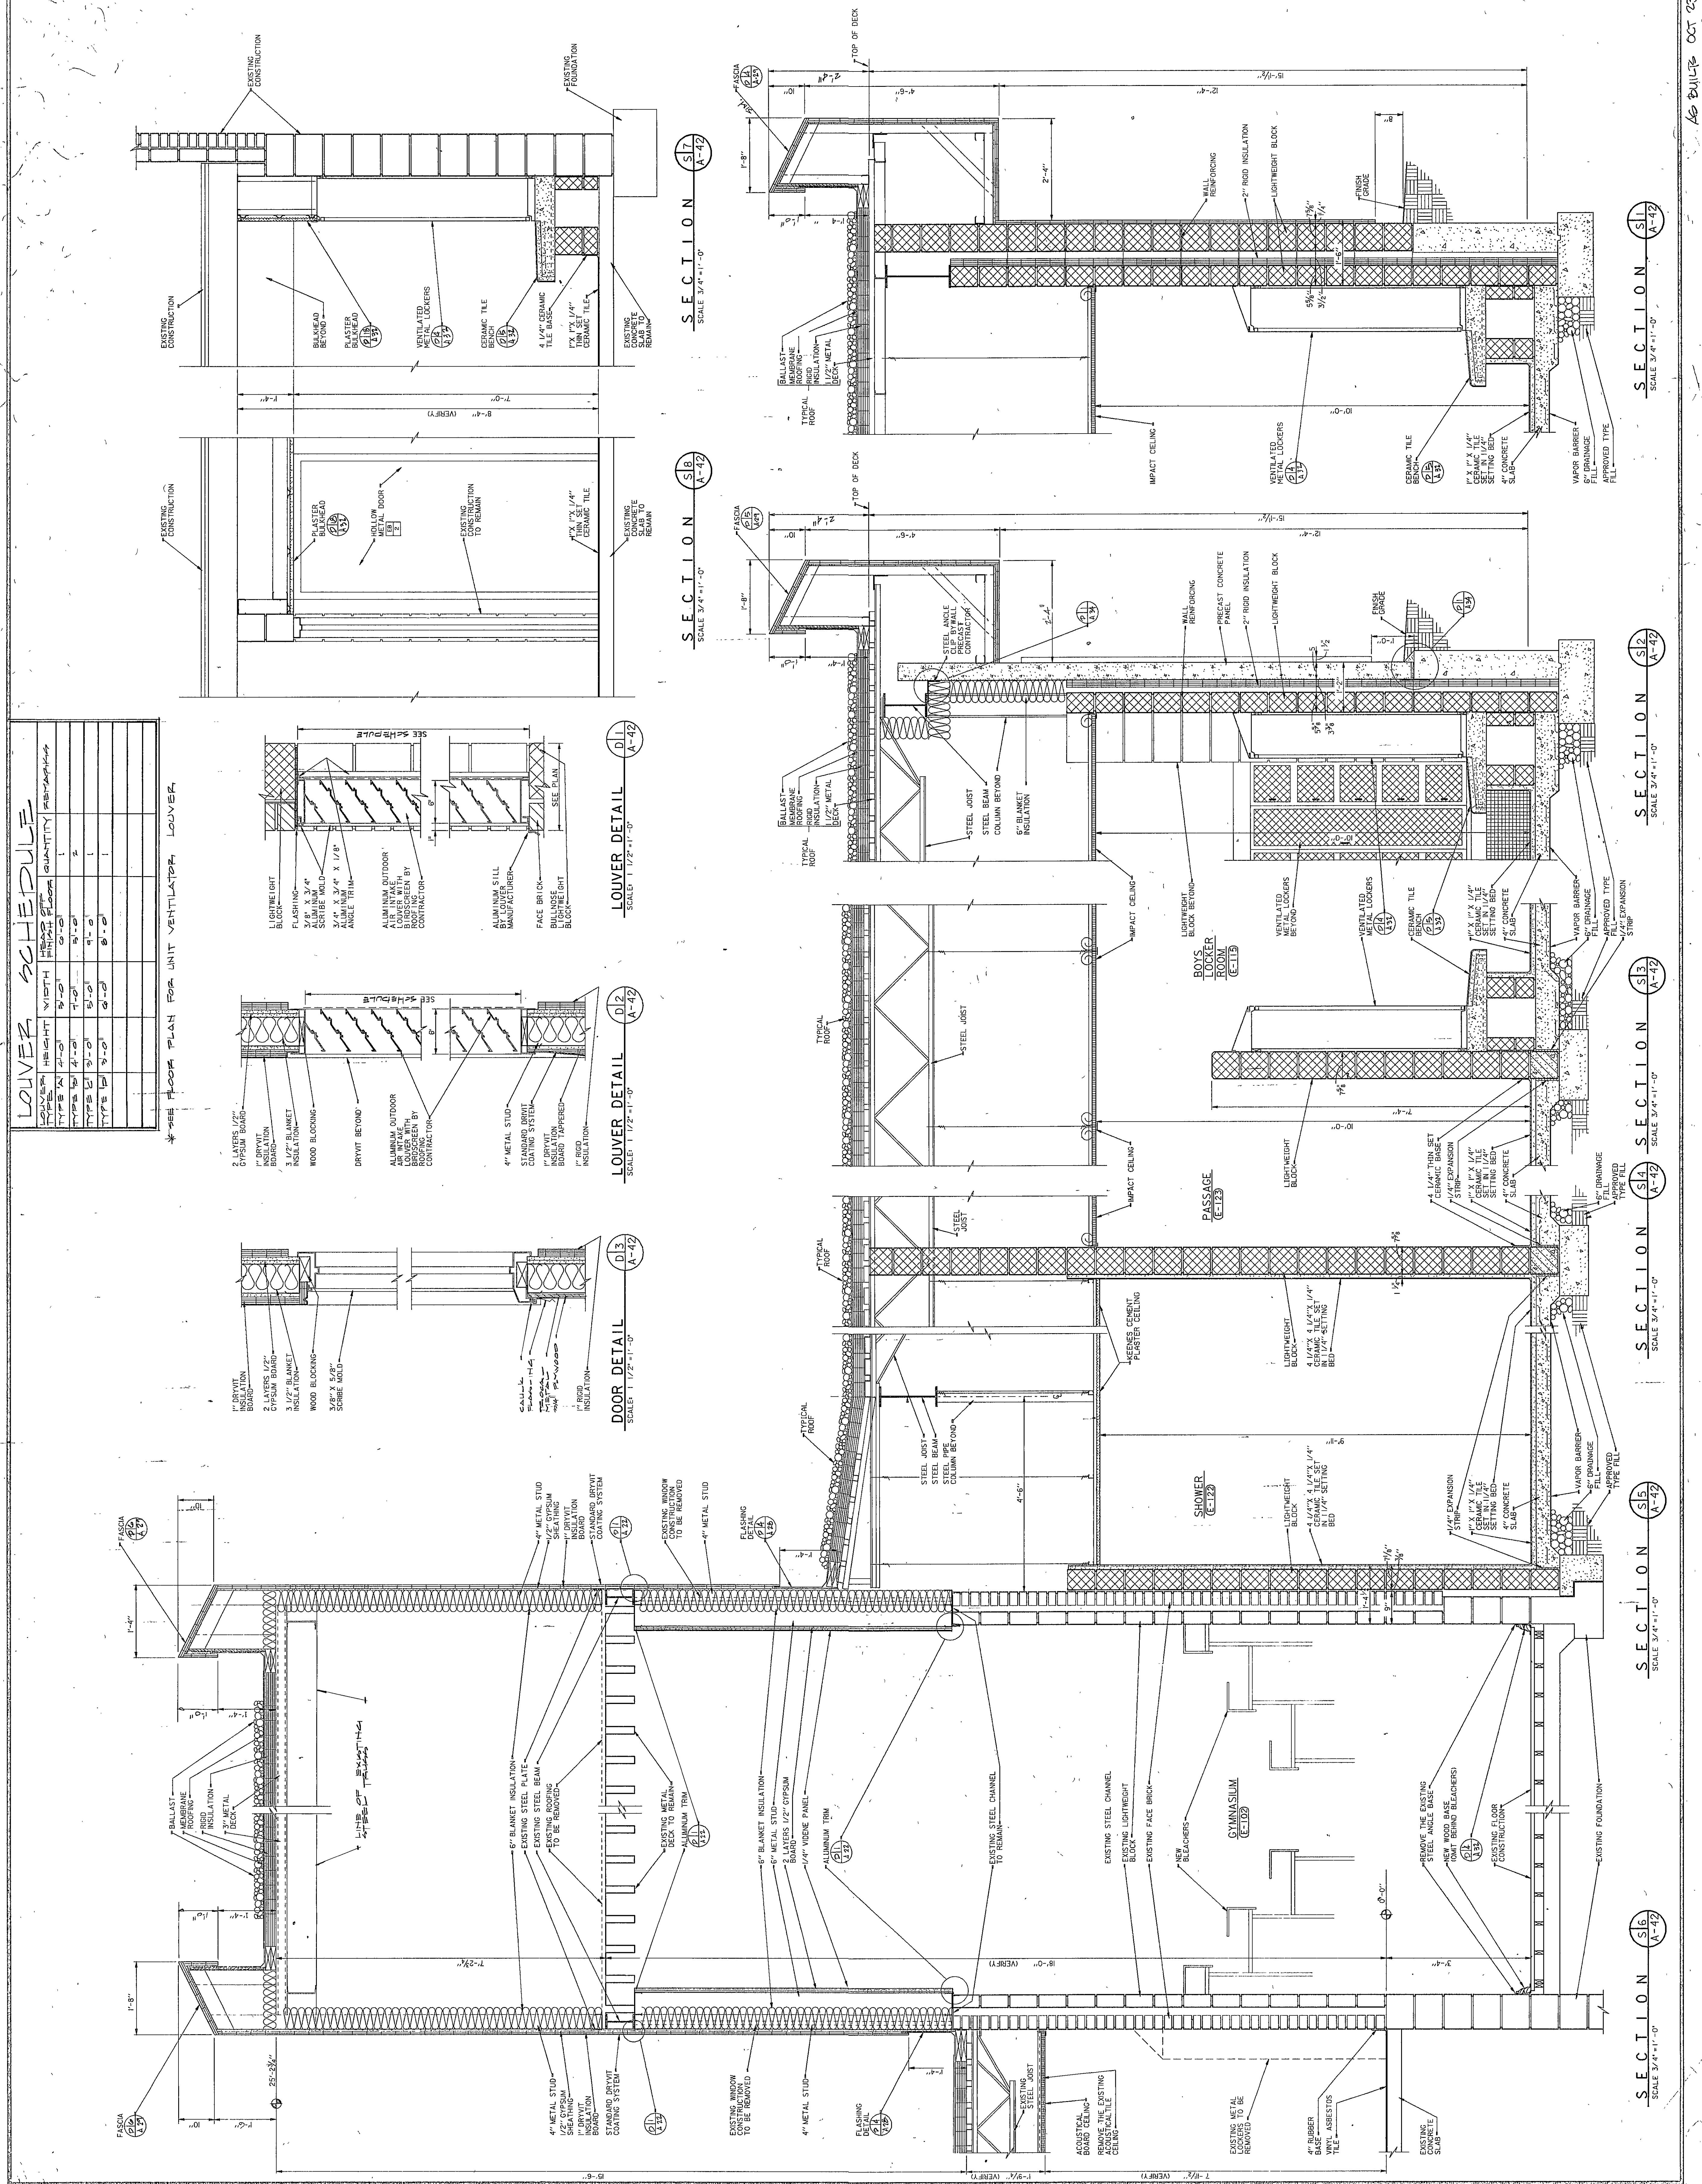


LOUVER	HEIGHT	WIDTH	HEAD SET	QUANTITY	REMARKS
TYPE A	4'-0"	8'-0"	0'-0"	1	
TYPE B	4'-0"	4'-0"	0'-0"	2	
TYPE C	3'-0"	5'-0"	0'-0"	1	
TYPE D	3'-0"	8'-0"	0'-0"	1	

*SEE FLOOR PLAN FOR UNIT VENTILATOR LOUVER

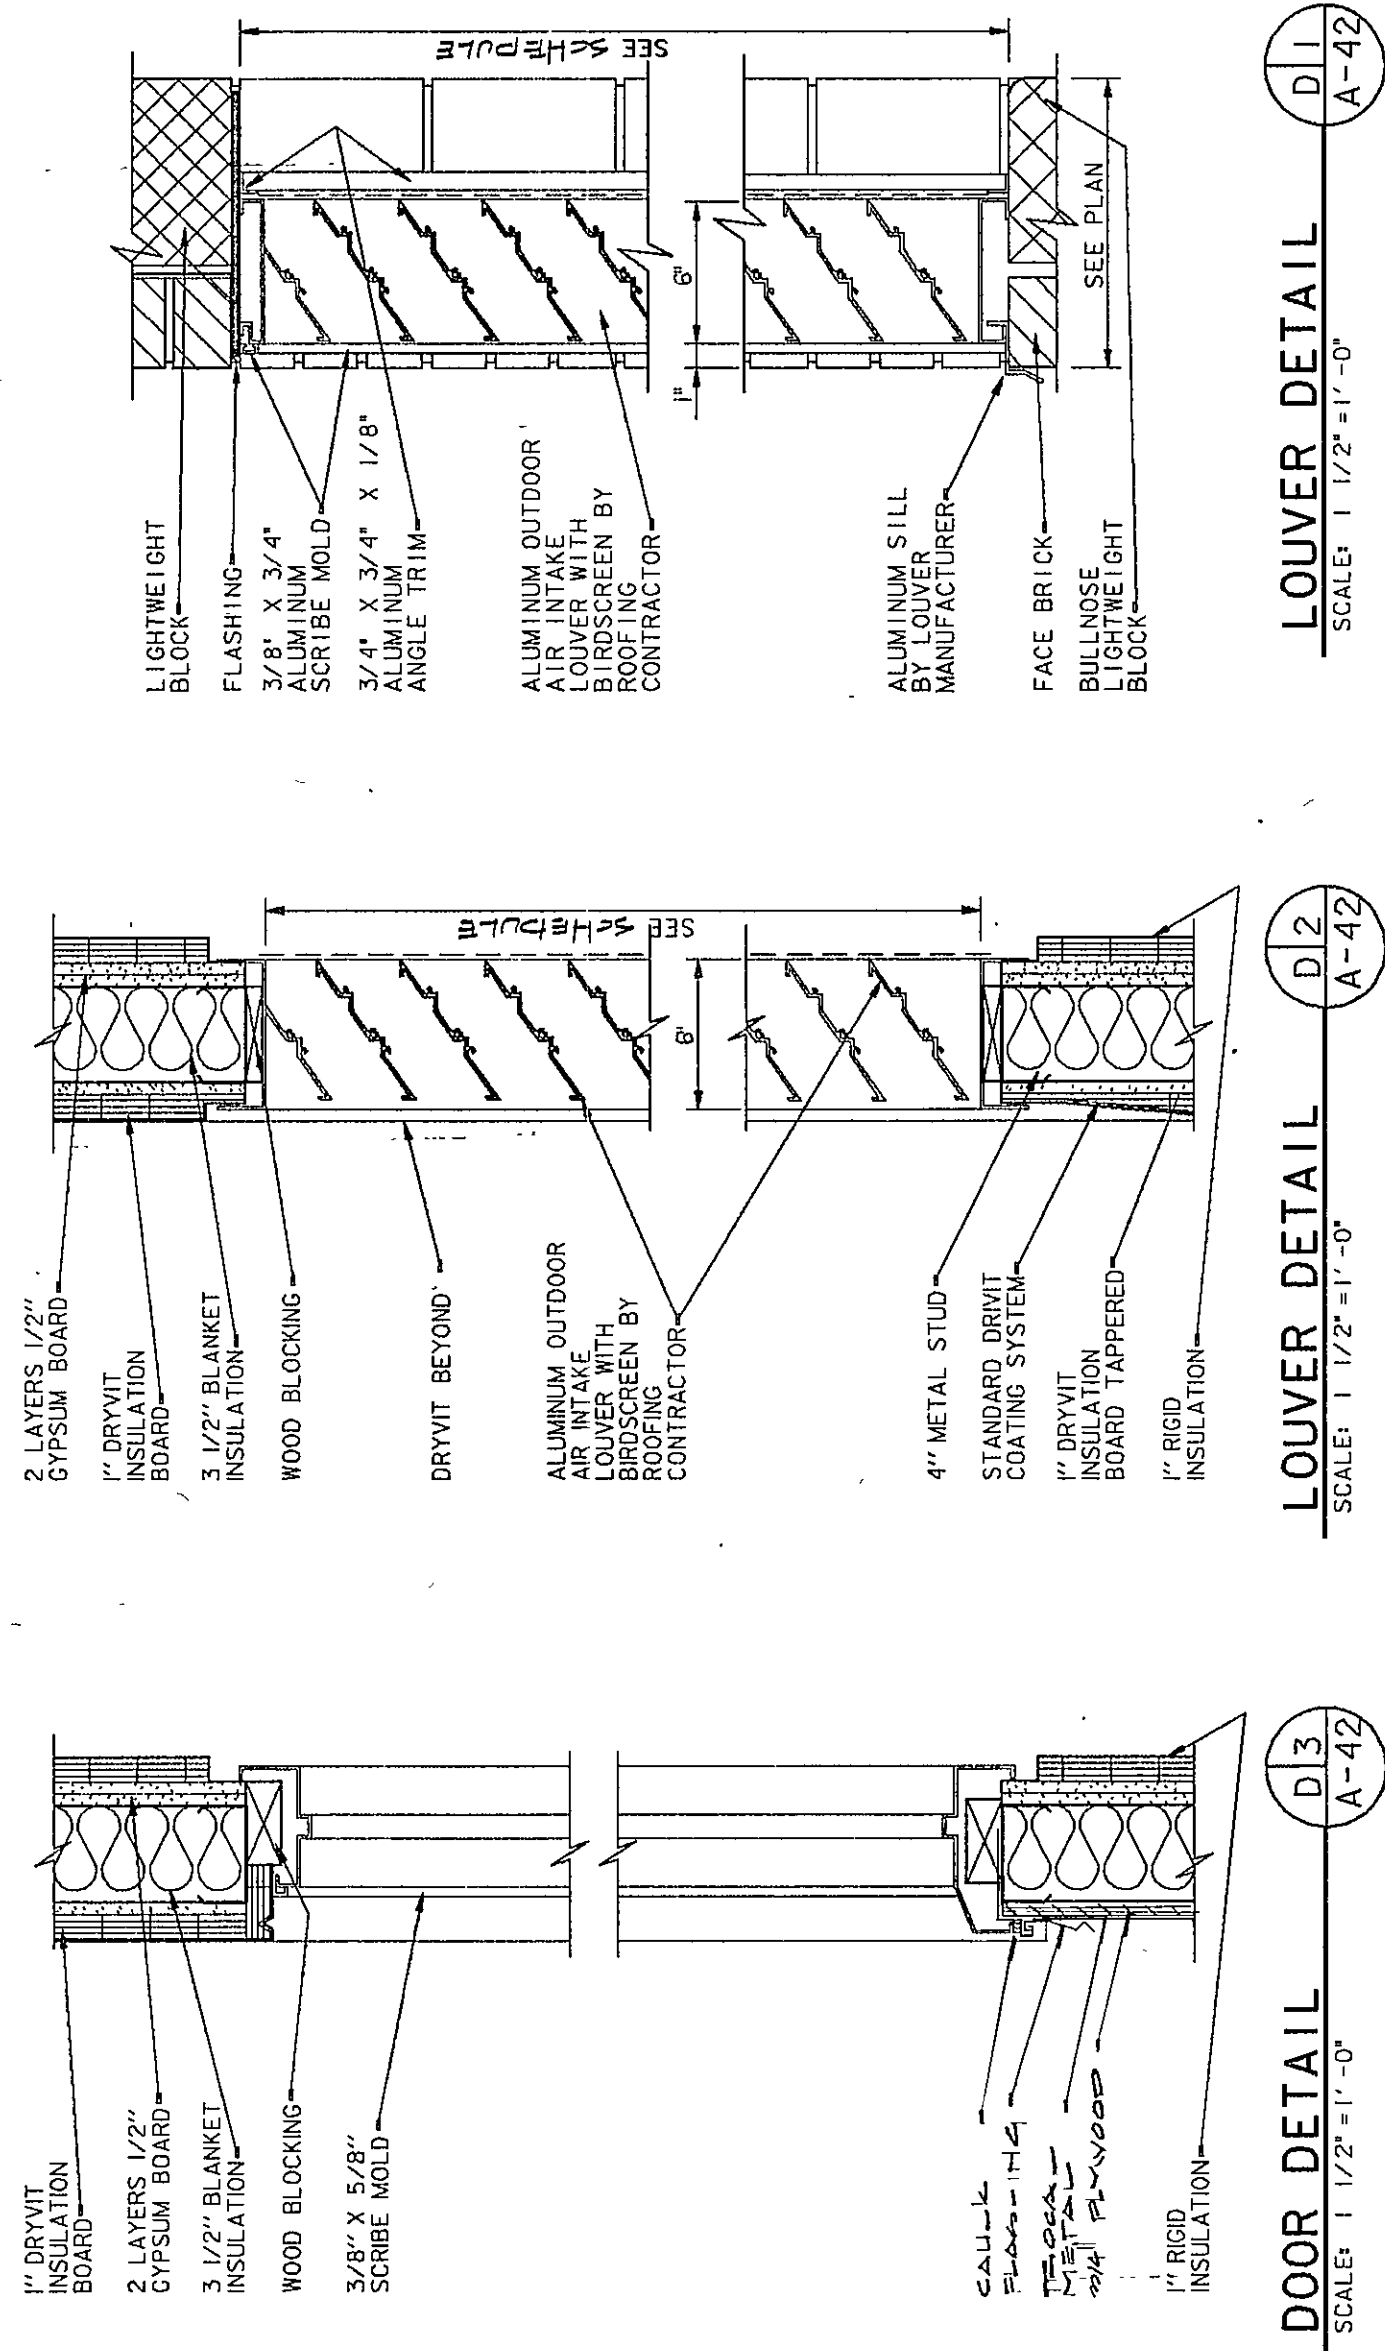

R-25
S-12

AS BUILT OCT 23 1984