



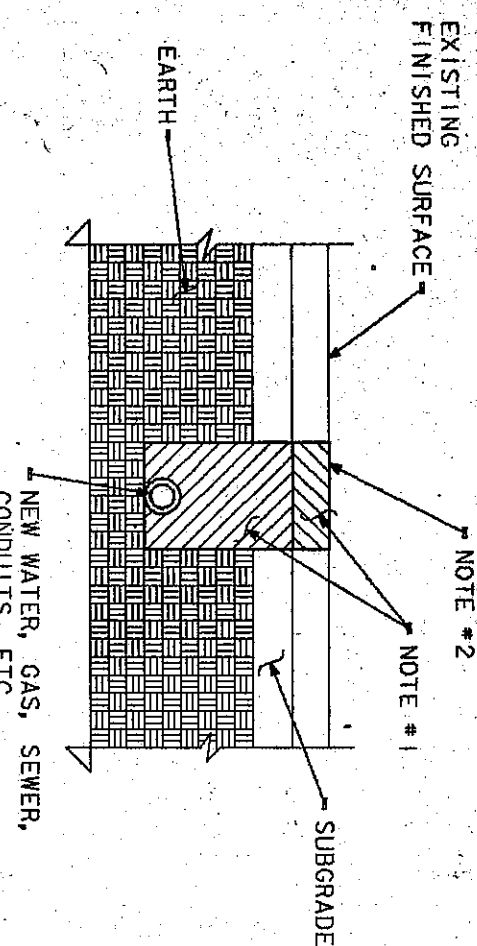


DETAIL SHOWING CUTS IN EXISTING FINISHED SURFACES NO SCALE


1. THE CONTRACTOR INSTALLING THE NEW UTILITY SERVICE SHALL MAKE THE CUT, EXCAVATE, INSTALL NEW SERVICE, INSTALL AND MAKE GOOD EXISTING WATER, BACKFILL TO TOP OF SUBGRADE, AND MAKE GOOD EXISTING FINISHED SURFACE.
2. THE FINISHED SURFACE SHALL BE PROVIDED BY OTHERS. WHERE SHOWN ON THE ARCHITECTURAL OR STRUCTURAL DRAWINGS, FINISHED SURFACES FOR CUTS NOT NOTED ON THE ARCHITECTURAL DRAWINGS SHALL BE THE RESPONSIBILITY OF THE CONTRACTOR MAKING THE CUTS.

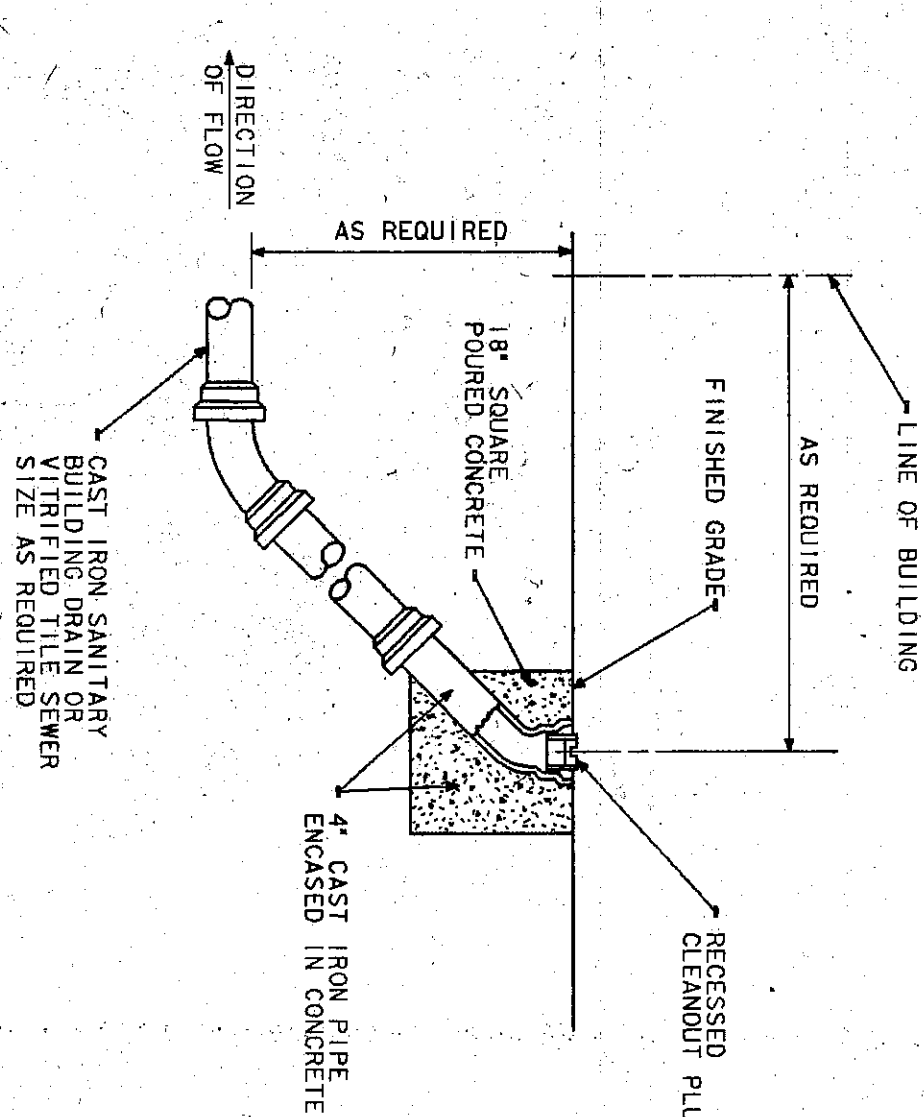


DETAIL OF TYPICAL OUTSIDE CLEANOUT NO SCALE

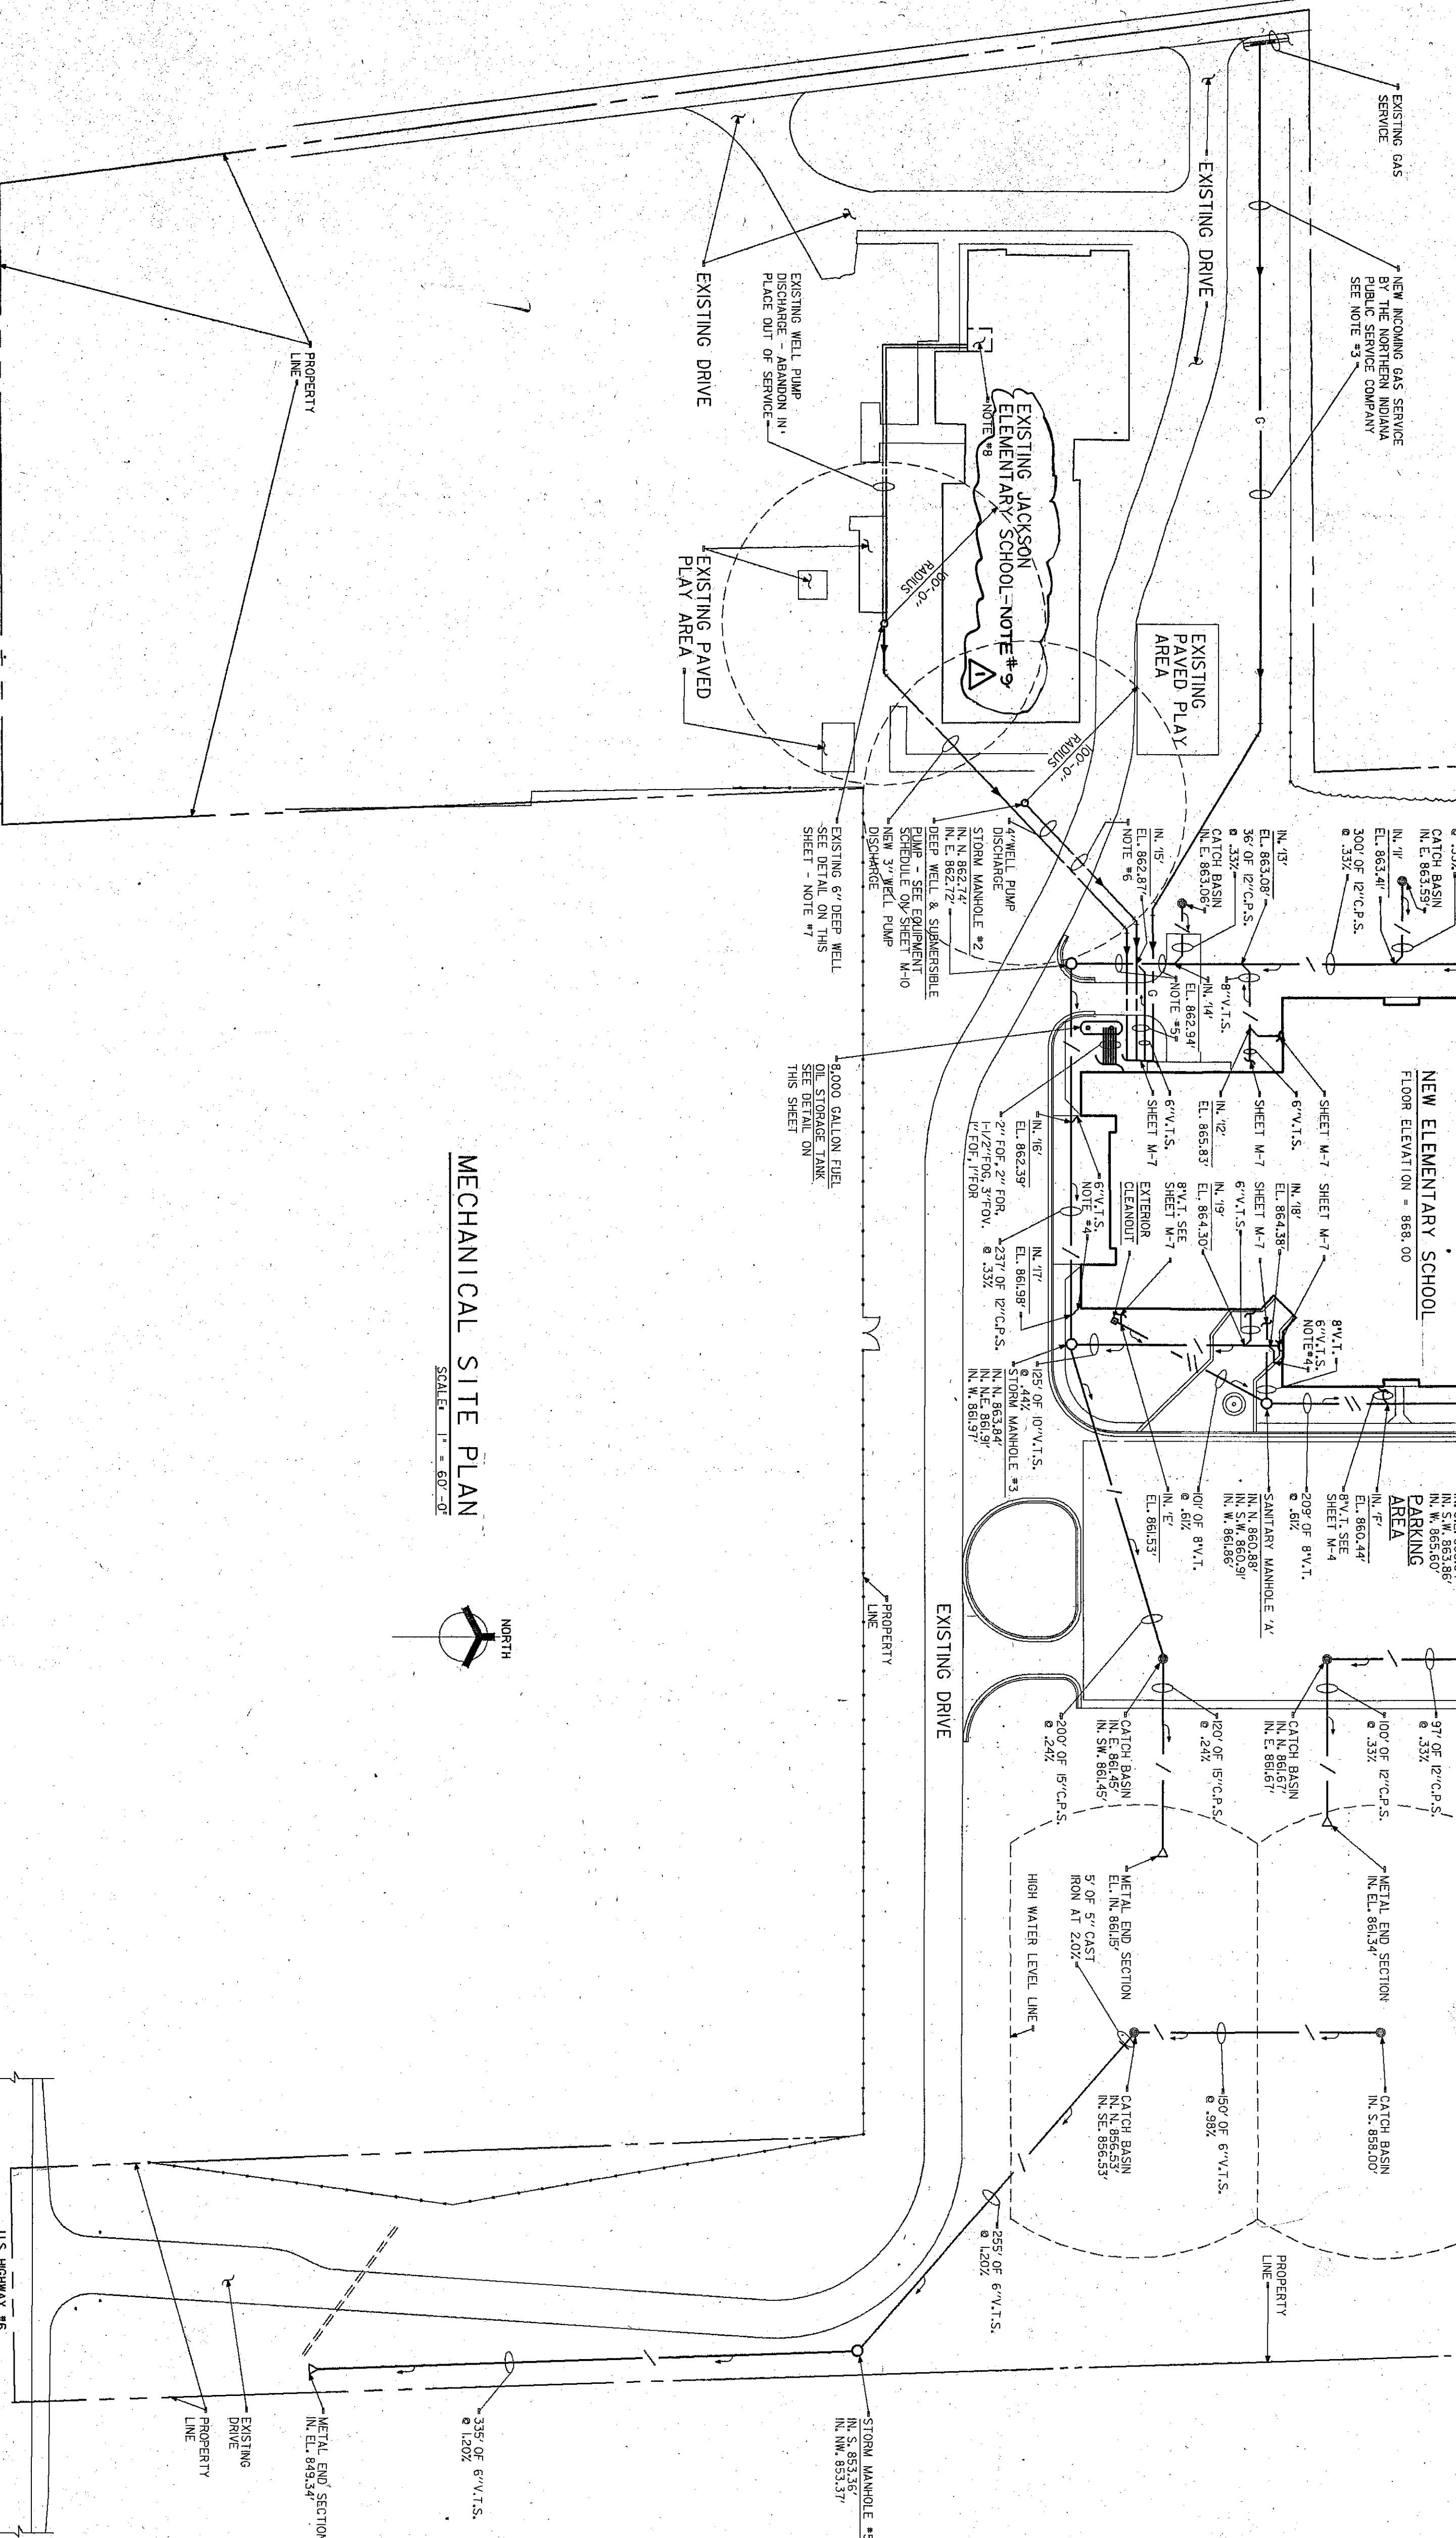


MECHANICAL SITE PLAN SCALE: 1" = 60'-0"

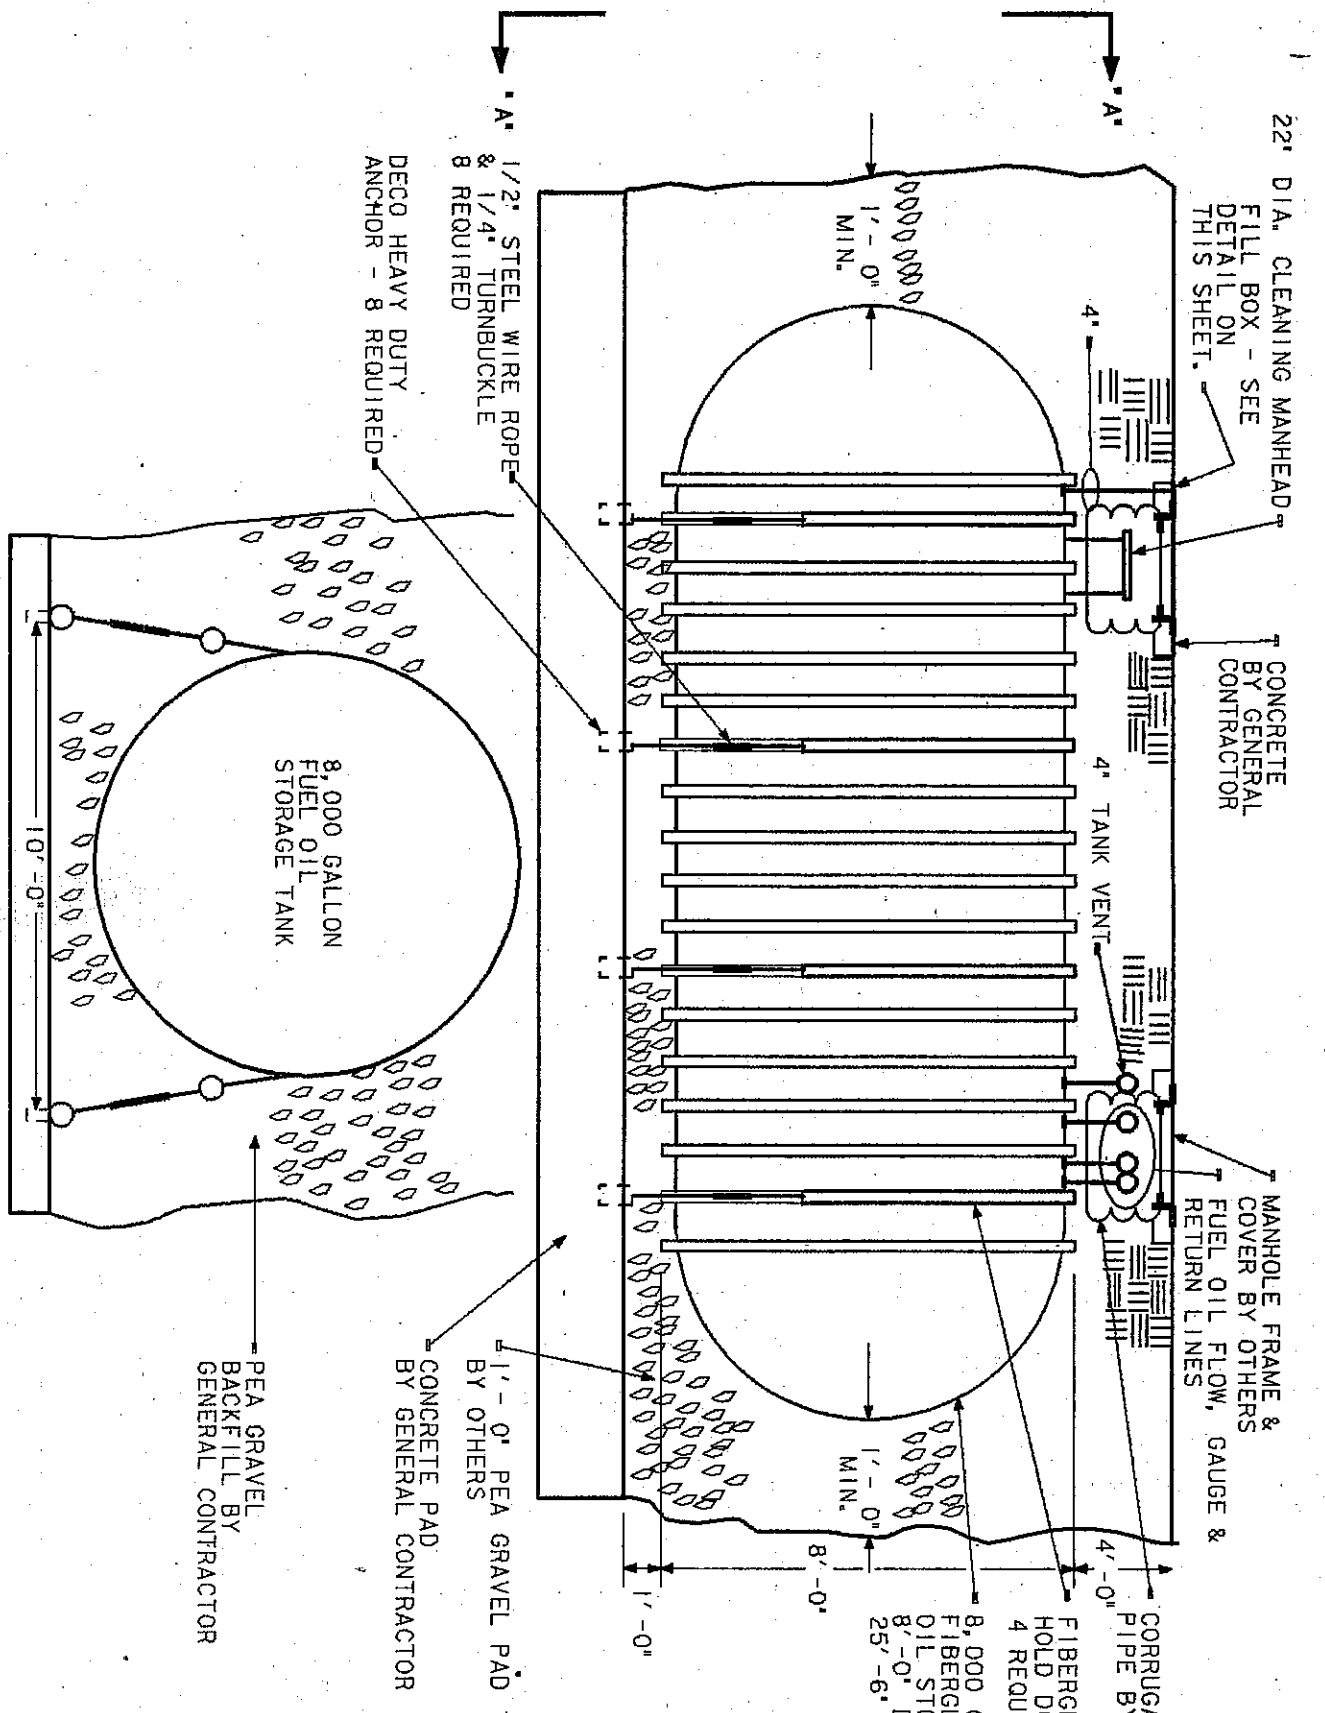


SECTION A-A' FIBERGLASS FUEL OIL STORAGE TANK DETAIL NO SCALE

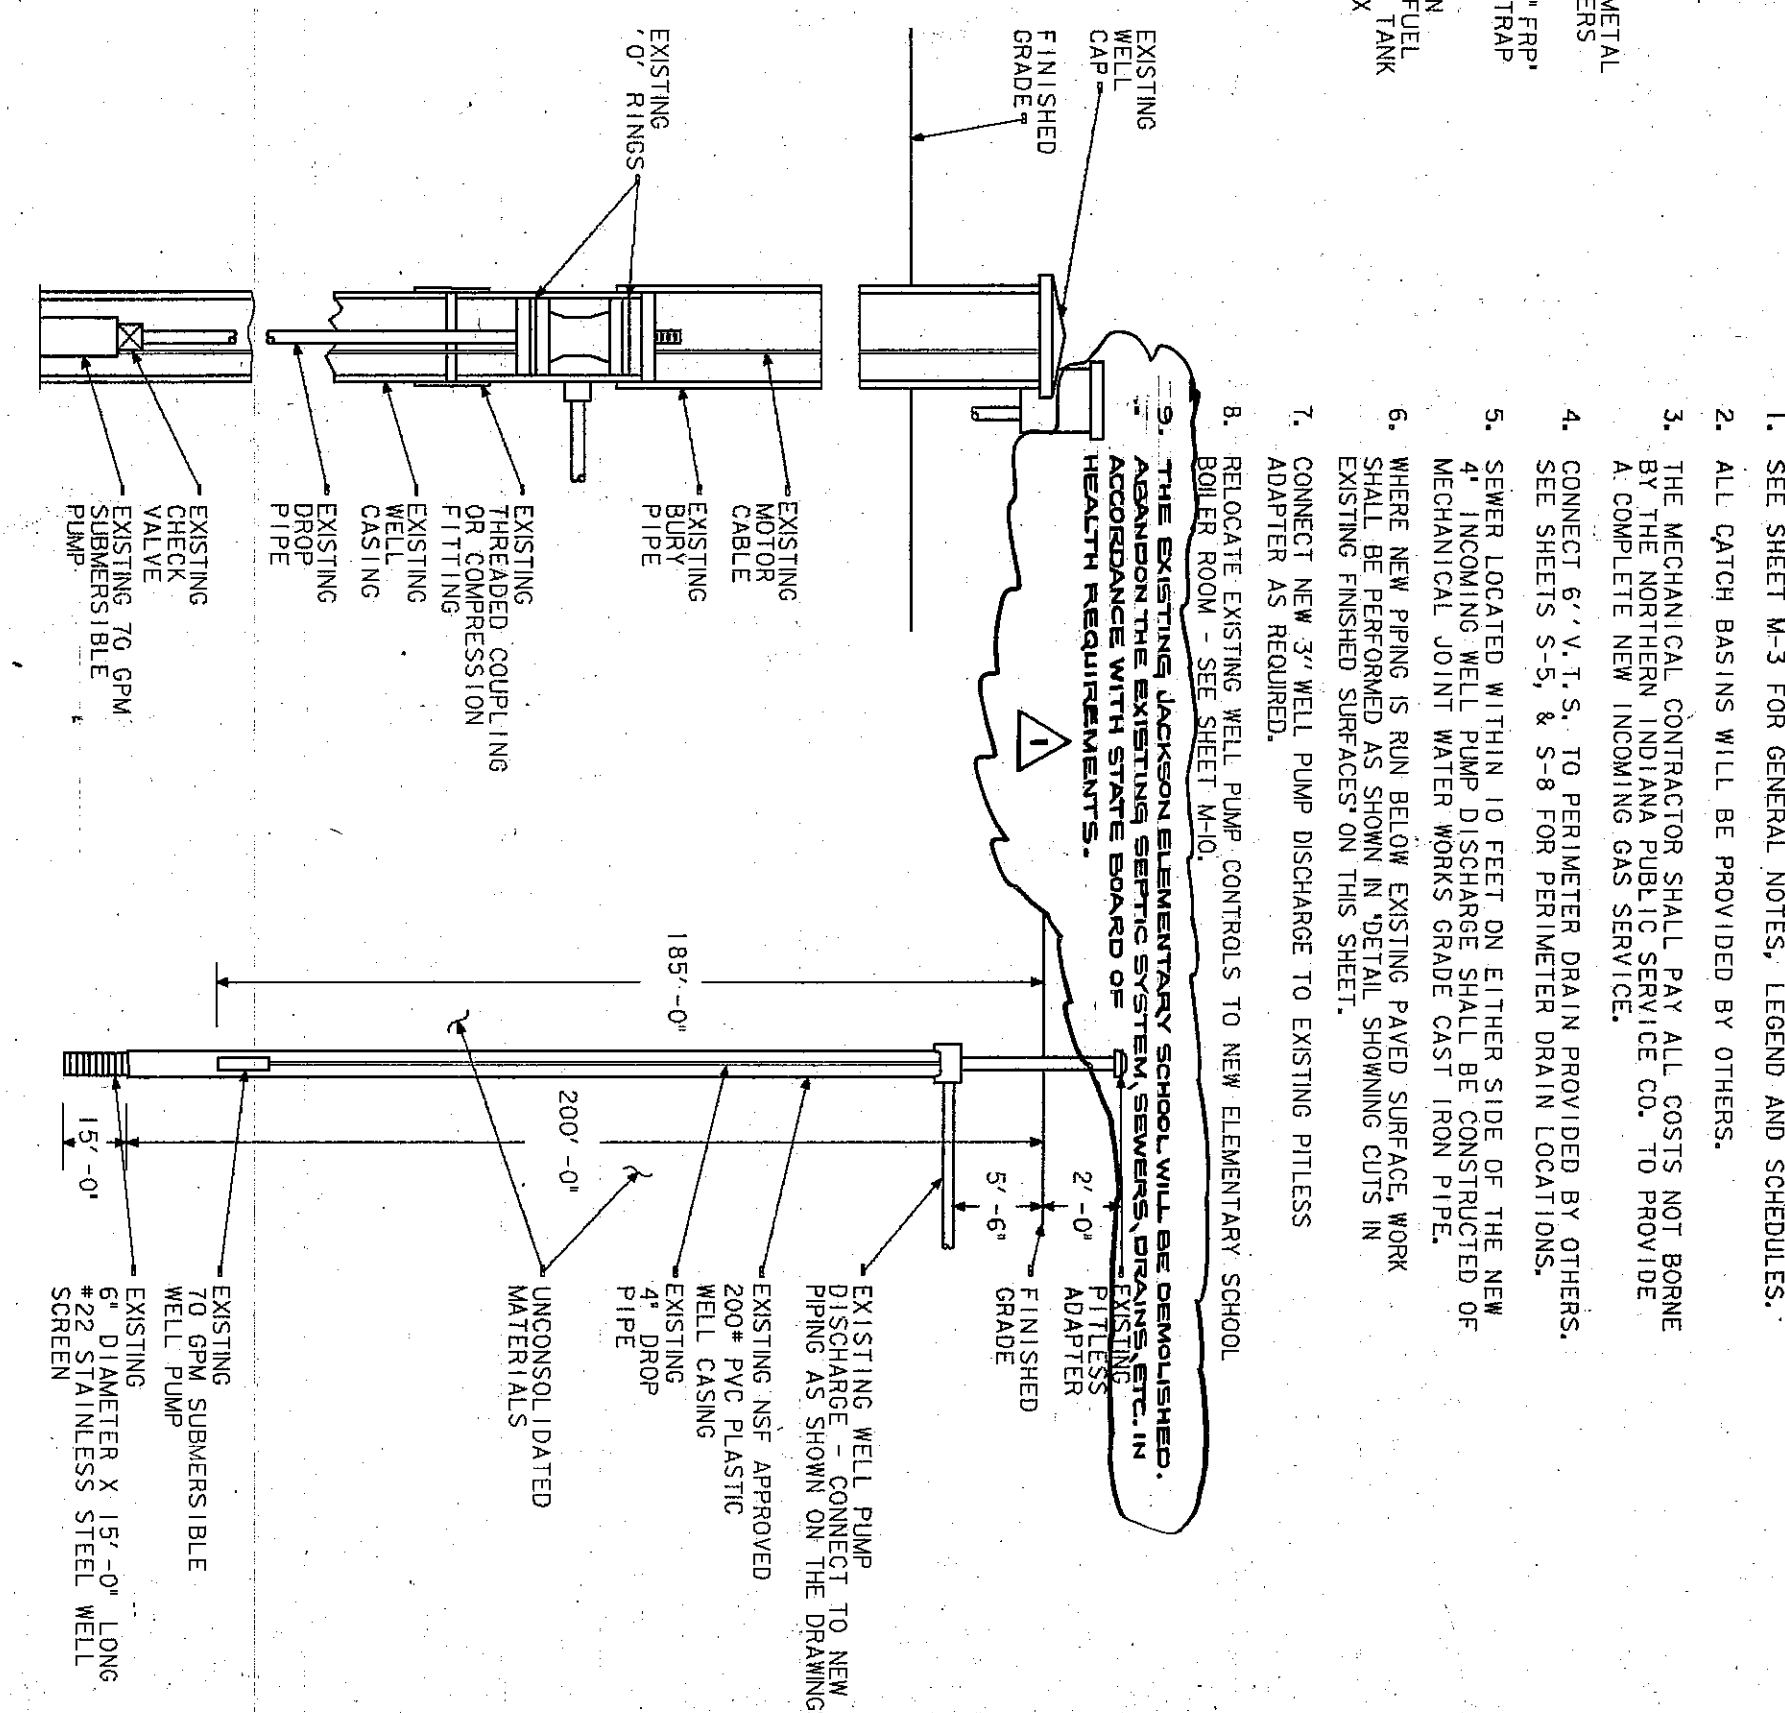


SECTION THRU EXISTING PITLESS ADAPTER AND EXISTING WATER WELL NO SCALE

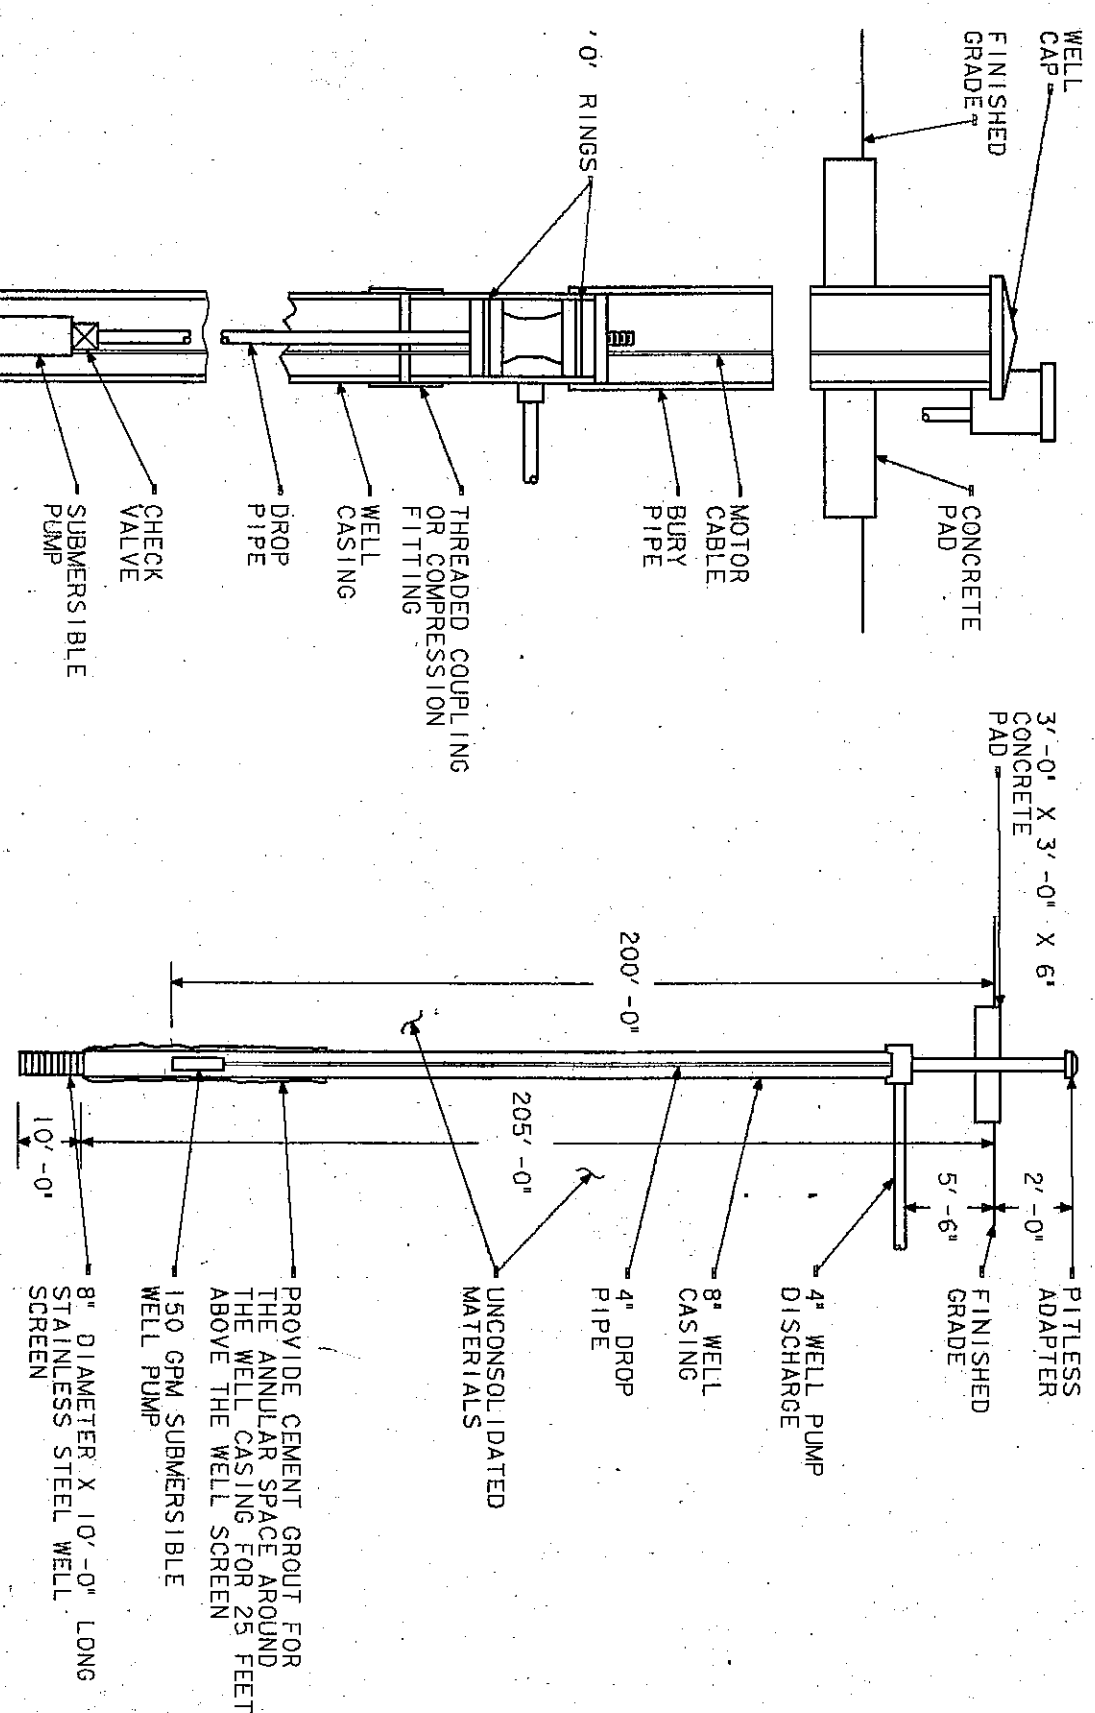

SECTION THRU PITLESS ADAPTER AND WATER WELL NO SCALE

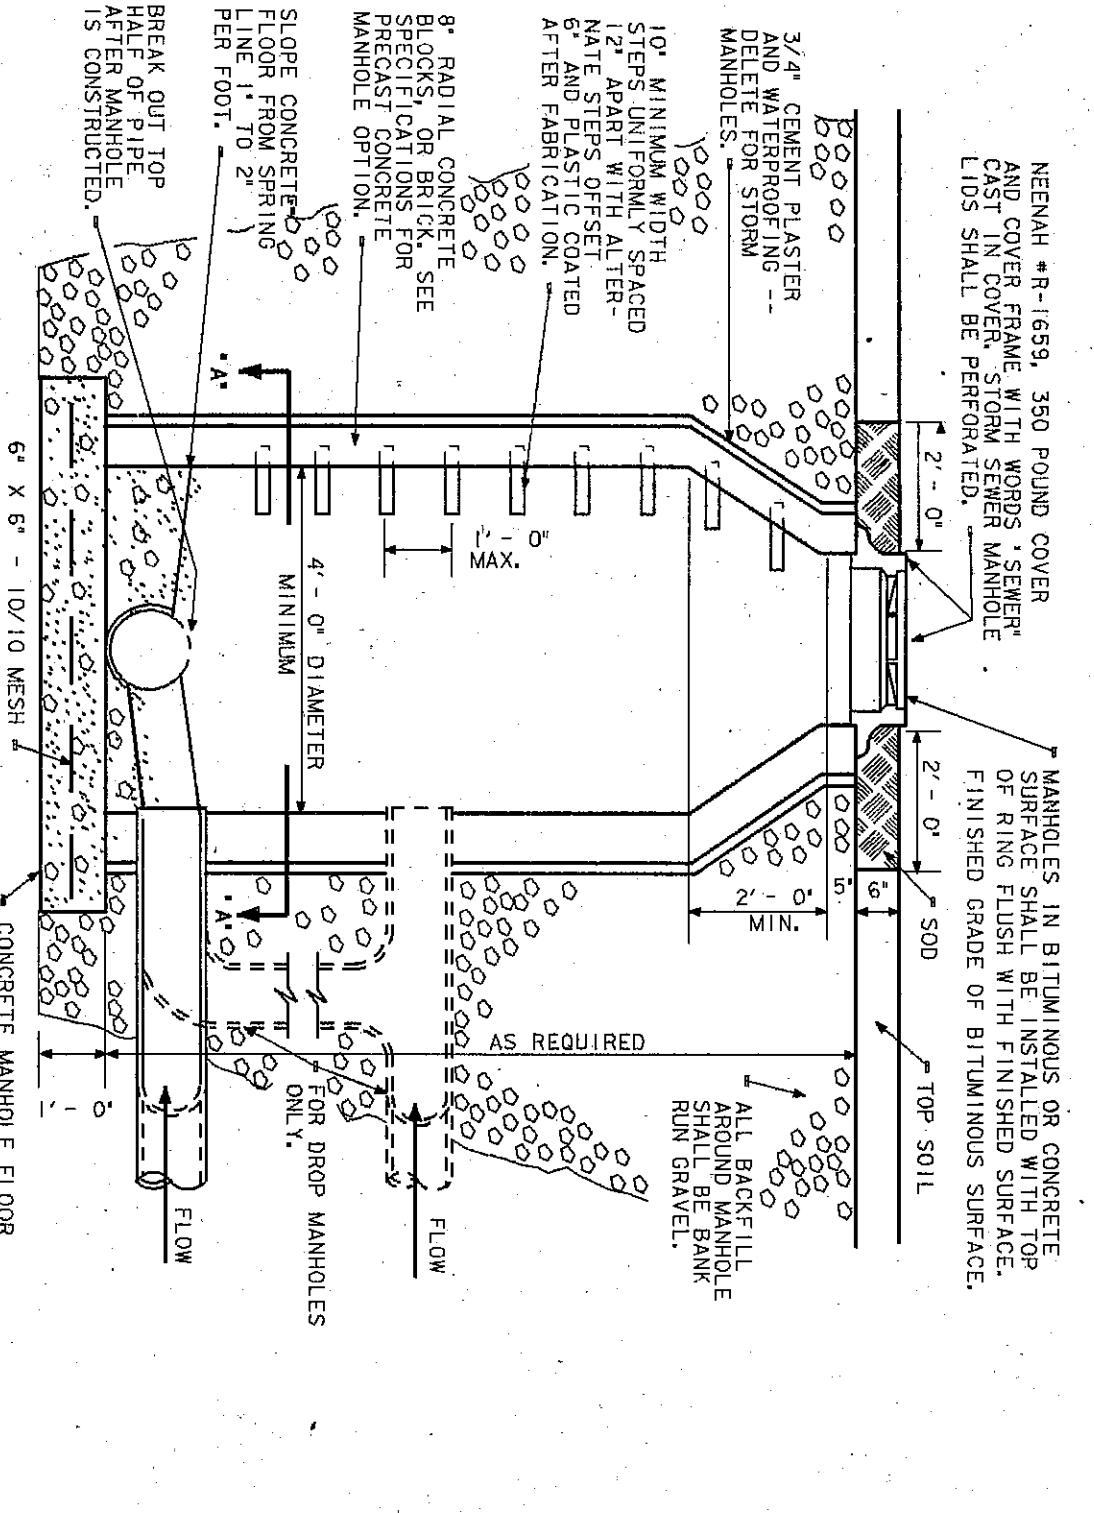

TYPICAL MANHOLE DETAIL NO SCALE

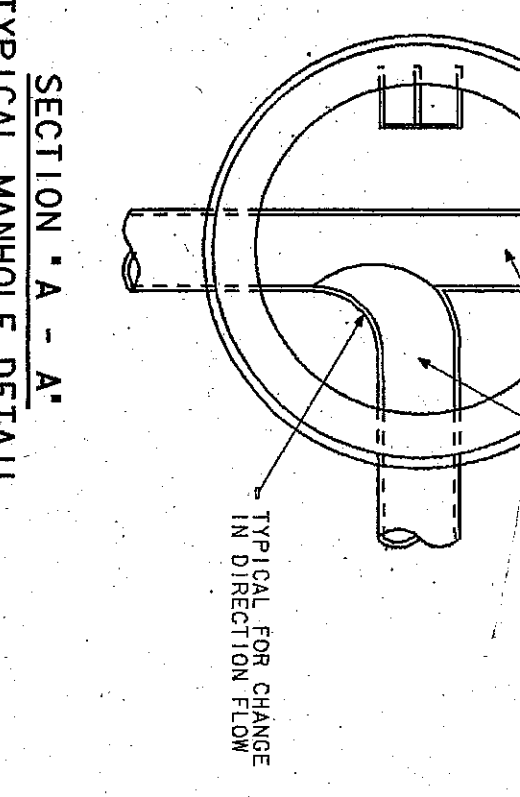

AS-BUILT
25 SEPT. 1984
REVISION RM-1

NO. M-1
OF 36

PROJECT 12579.00
DATE MAY 3, 1982
REVISED JULY 23, 1982

JAMES A. PARTIDGE
PROFESSIONAL ENGINEER
12545
STATE OF INDIANA

EVERETT · I · BROWN COMPANY ARCHITECTS ENGINEERS
5500 WEST BRADBURY AVENUE · PARK FLETCHER · INDIANAPOLIS, INDIANA · 46241

82-6014