




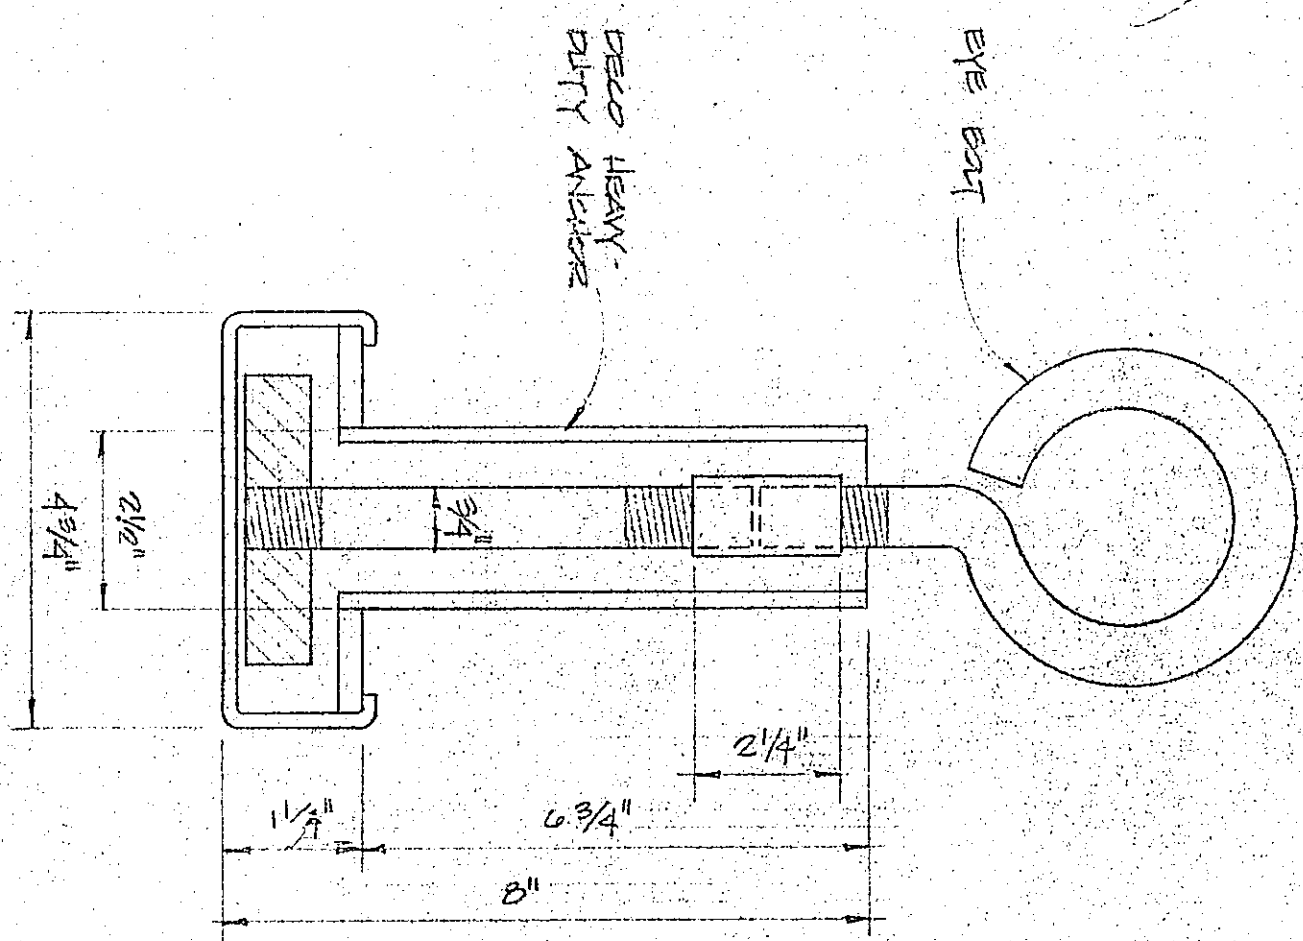


ANCHOR DETAIL
NO SCALE

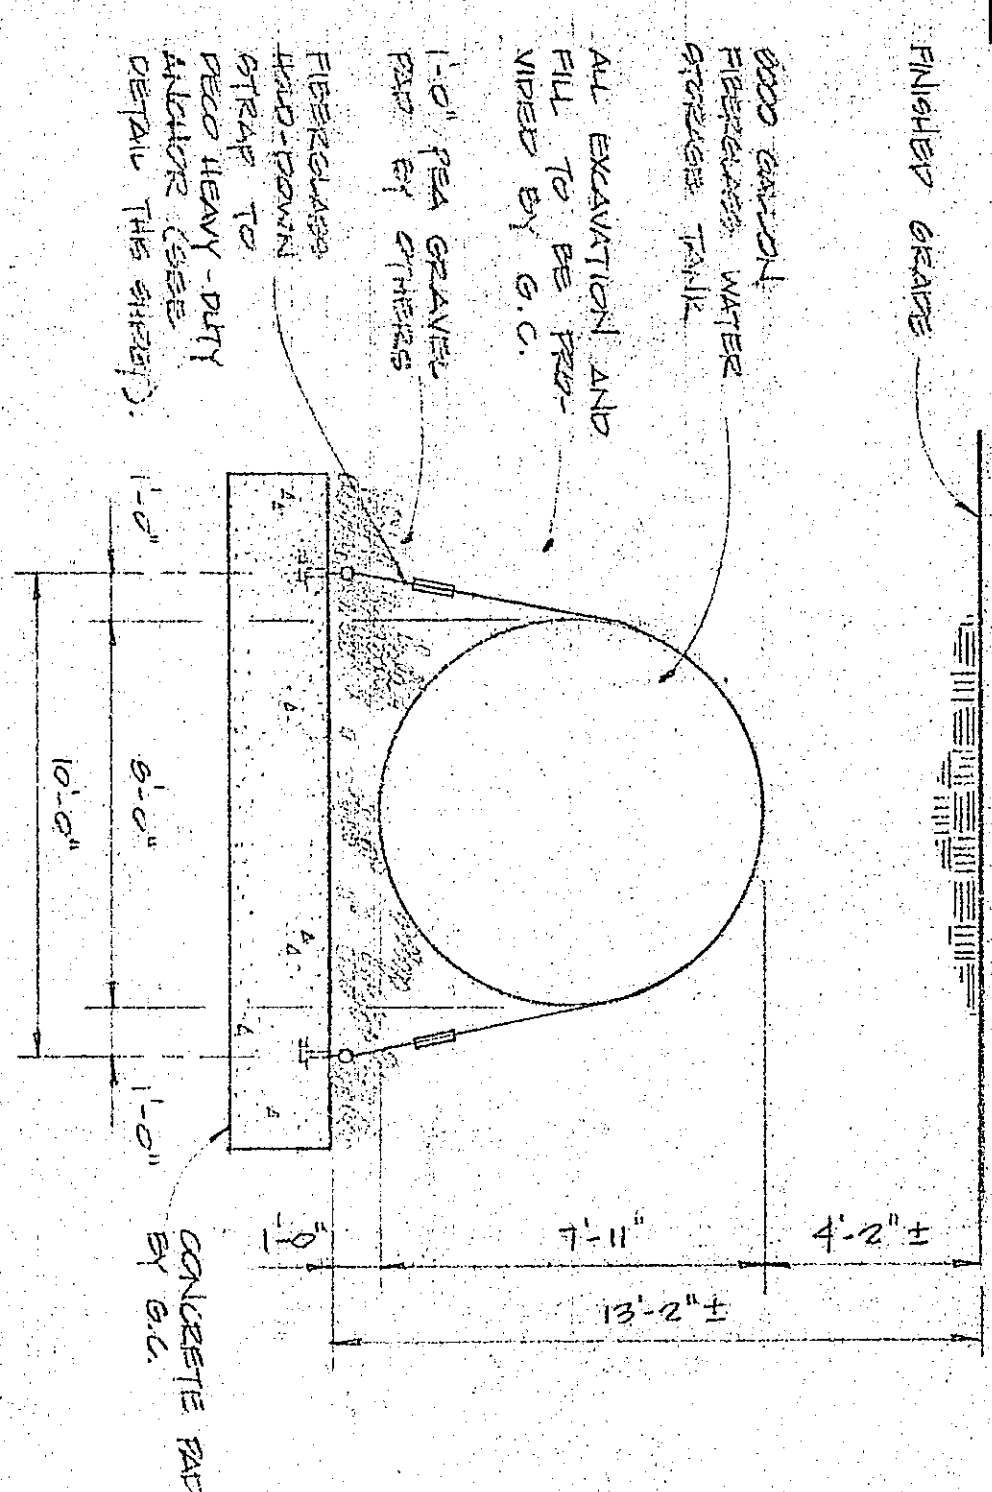

SECTION 'A-A'
SCALE: 1/4" = 1'-0"

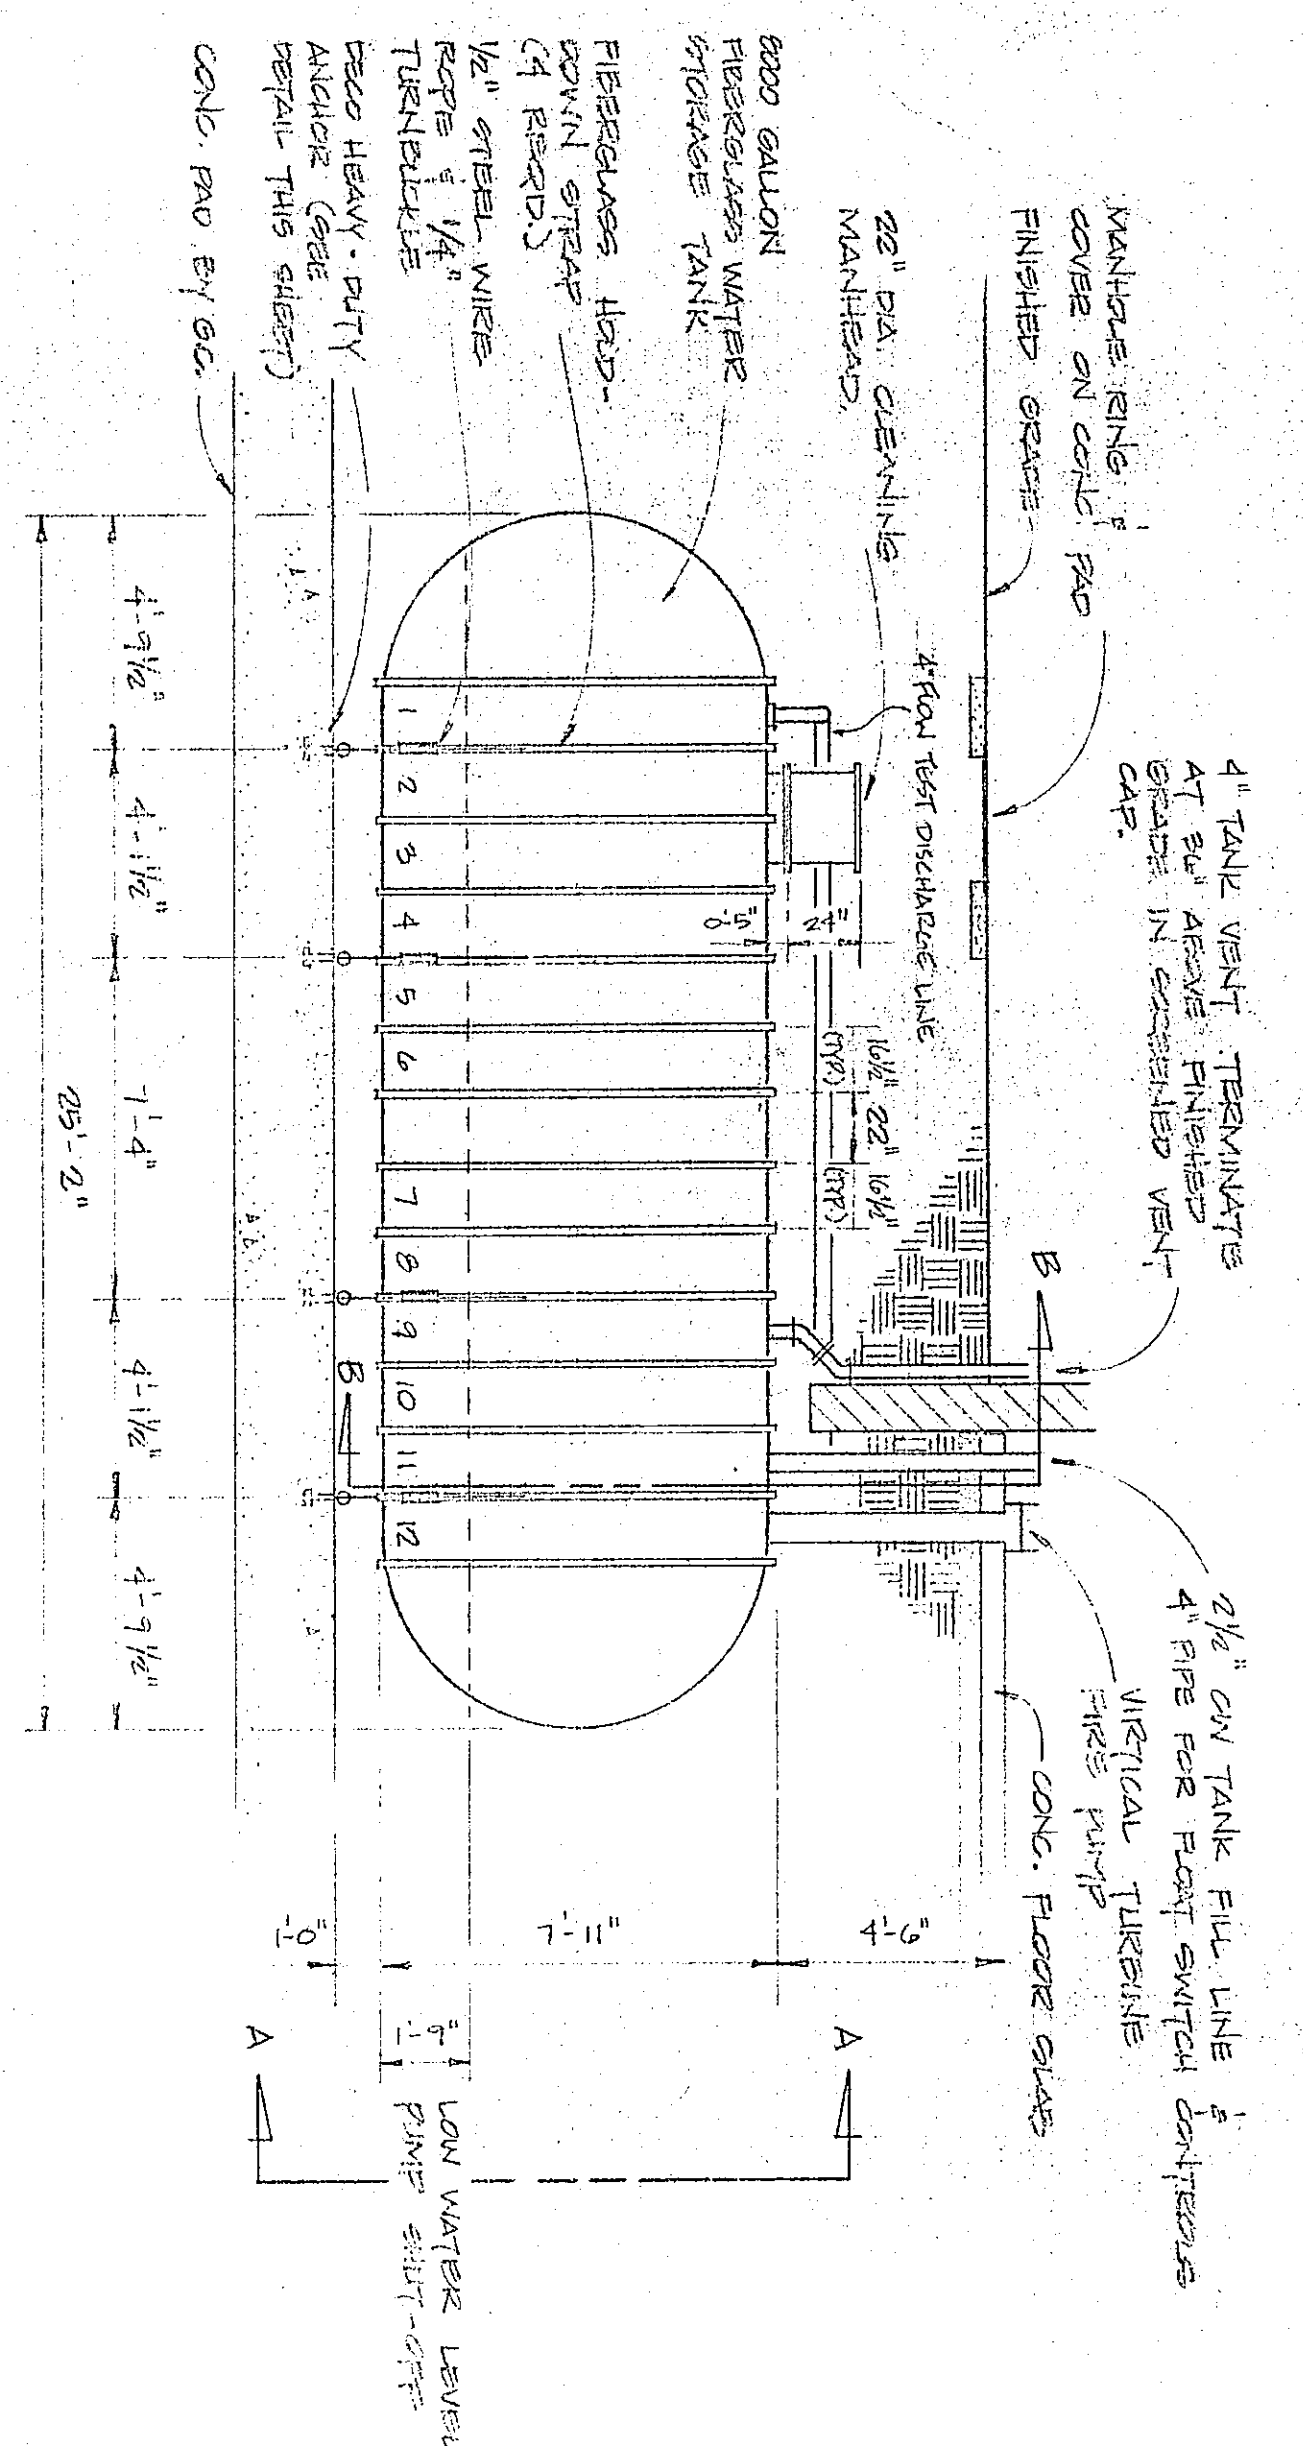

WATER STORAGE TANK DETAIL
SCALE: 1/4" = 1'-0"

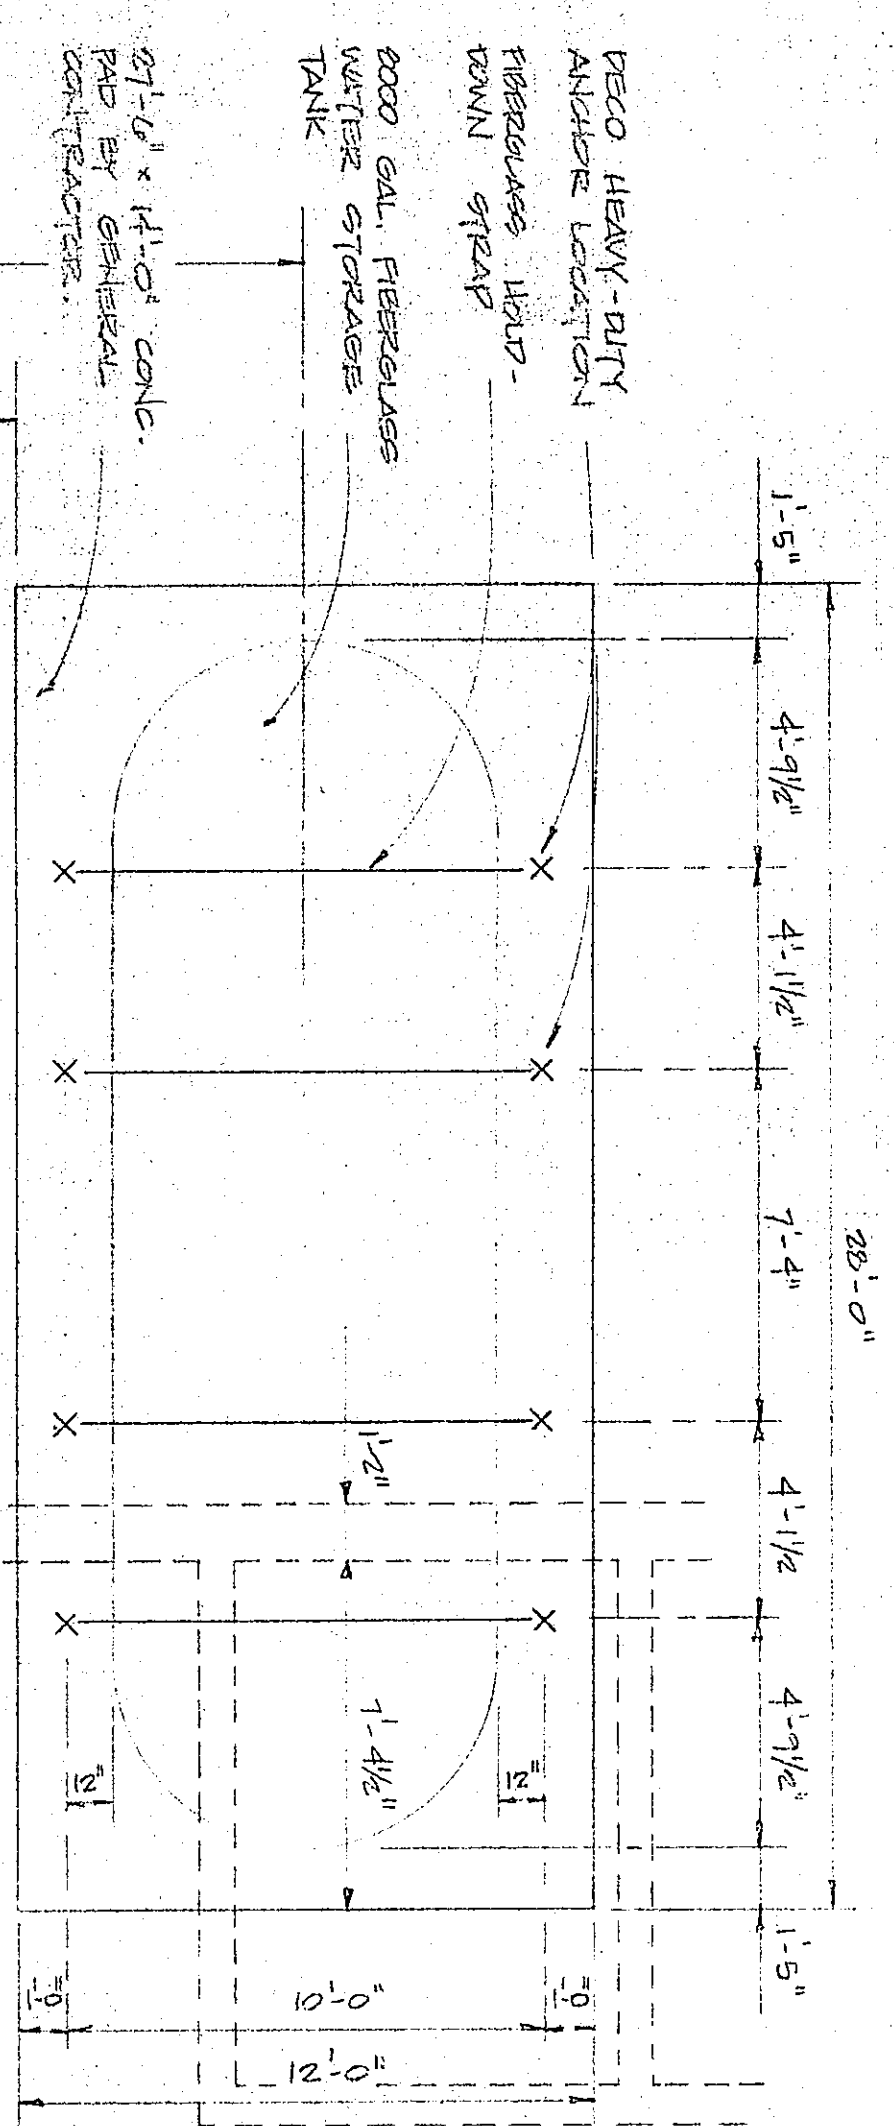

PUMP ROOM (B.142) LAYOUT
SCALE: 1/8" = 1'-0"


AS-BUILT

*NOTE:
SEE SHEET B.144 FOR
PUMP ROOM DETAILS


ITEM	REVISION	DATE
1	AS-BUILT	11/15/02

JACKSON ELEM. SCHOOL 1100 NORTH 400 EAST CHESTERTON, INDIANA 46501	DATE 11/15/02	BY AS-BUILT	DATE 11/15/02
--	------------------	----------------	------------------

SHAMBAUGH & SON, INC.

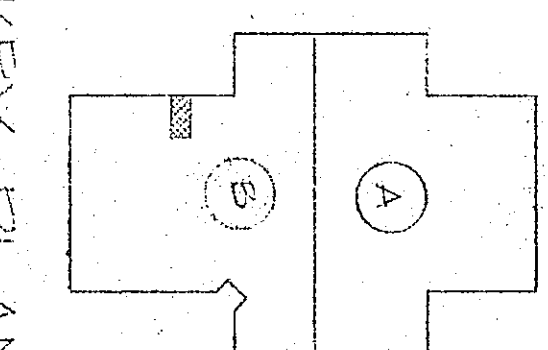


KEY PLAN
NO SCALE

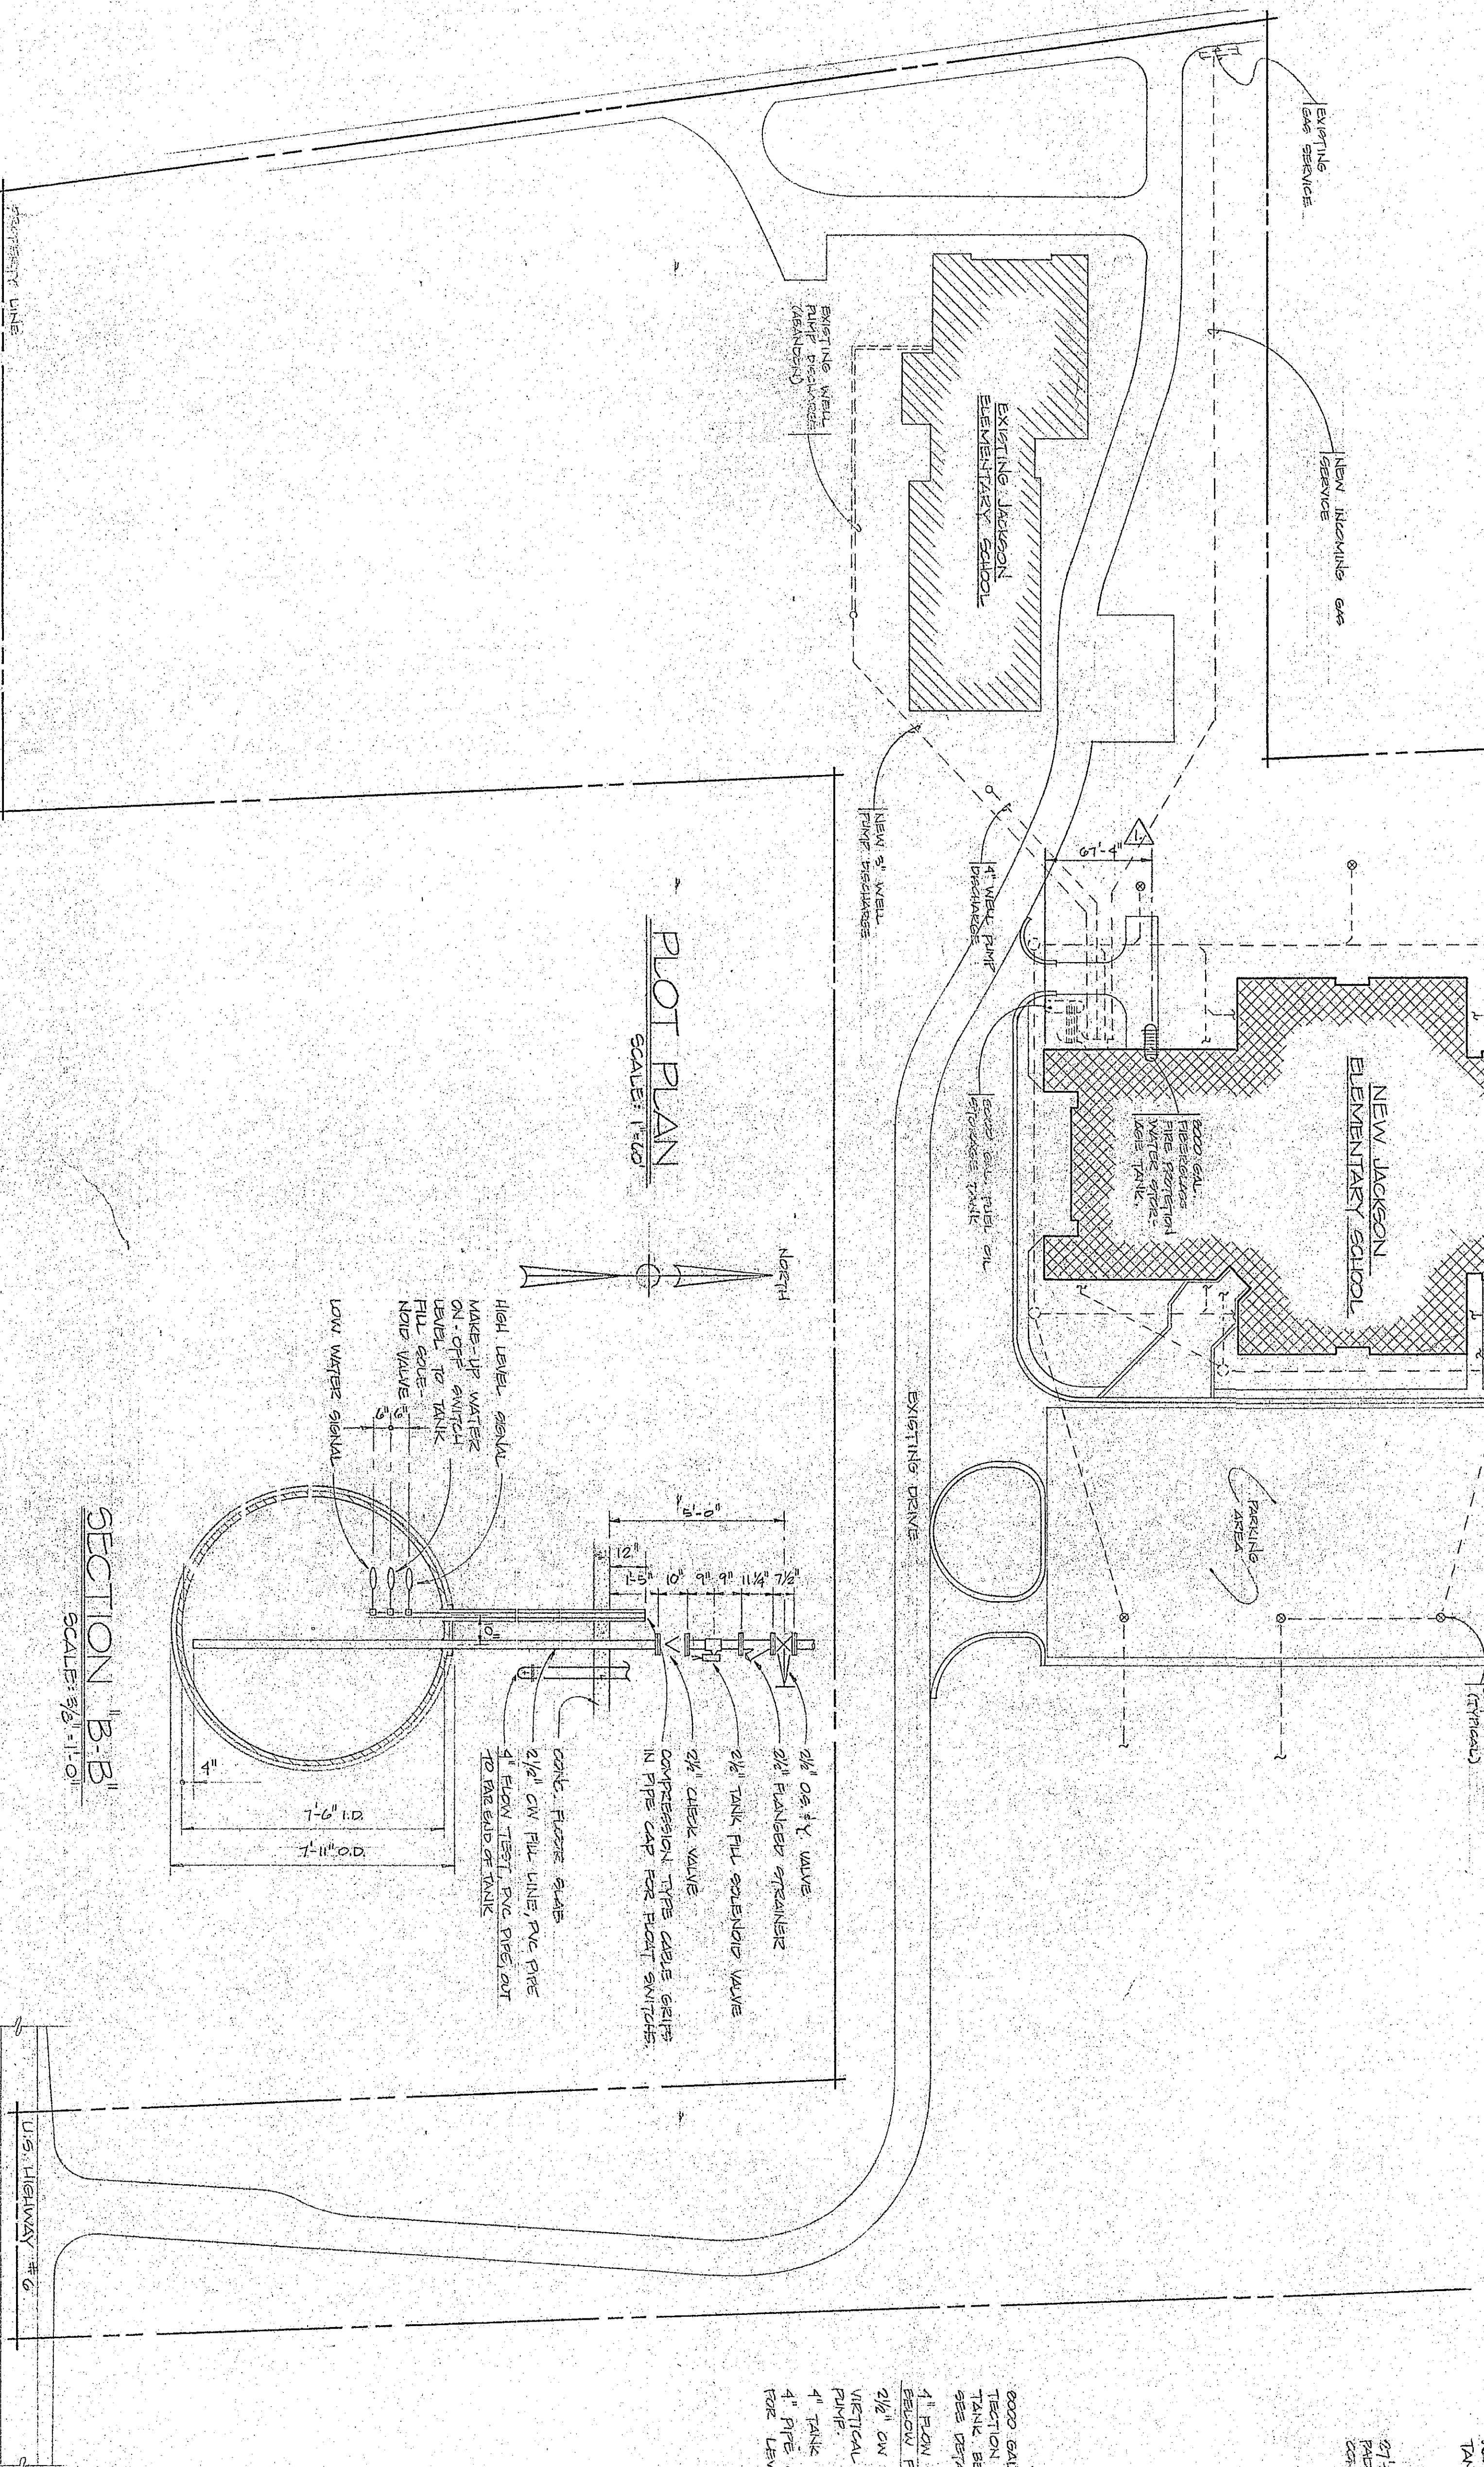

PLOT PLAN
SCALE: 1/8" = 1'-0"

SECTION 'B-B'
SCALE: 3/8" = 1'-0"

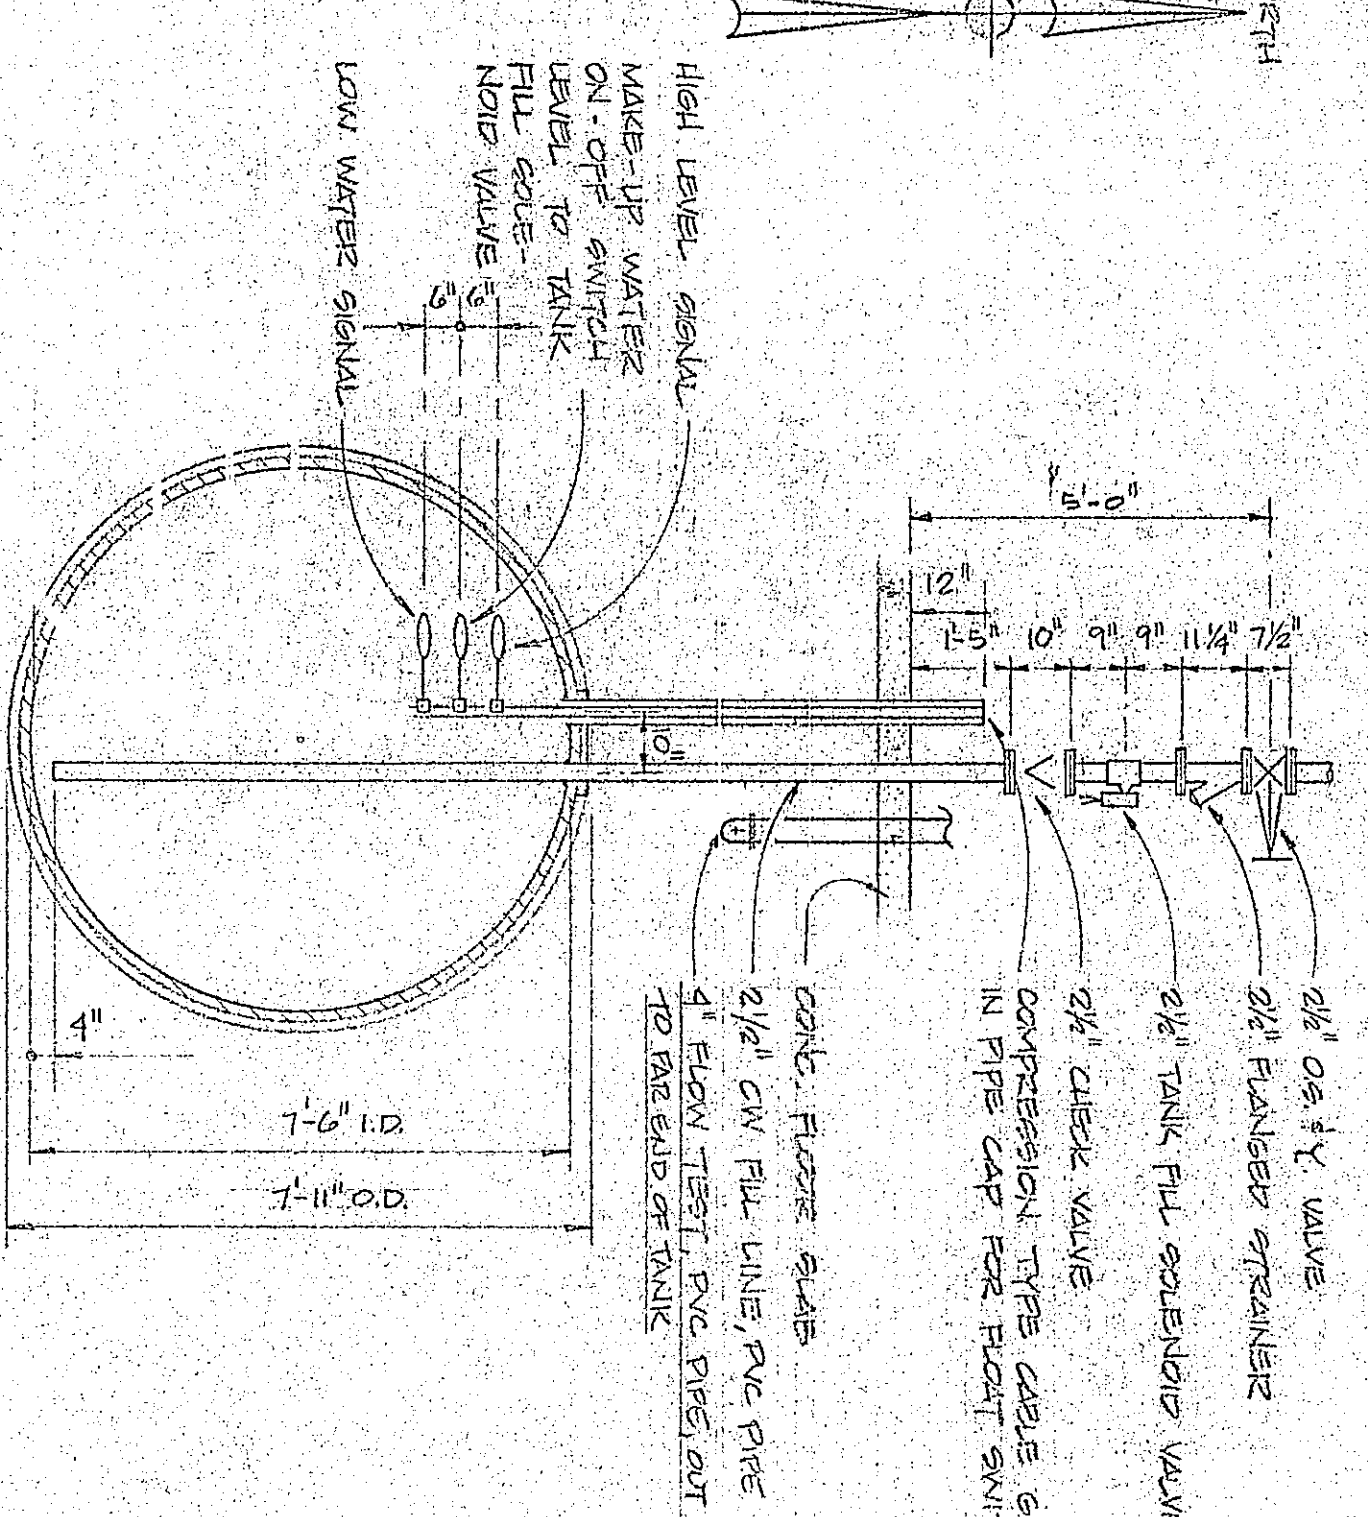

APPROVAL AGENCY	DATE	SCALE	FIGS.	DATE	FIGS.	DATE	FIGS.
1791	11/15/02	AS-BUILT	1	11/15/02	1	11/15/02	1