
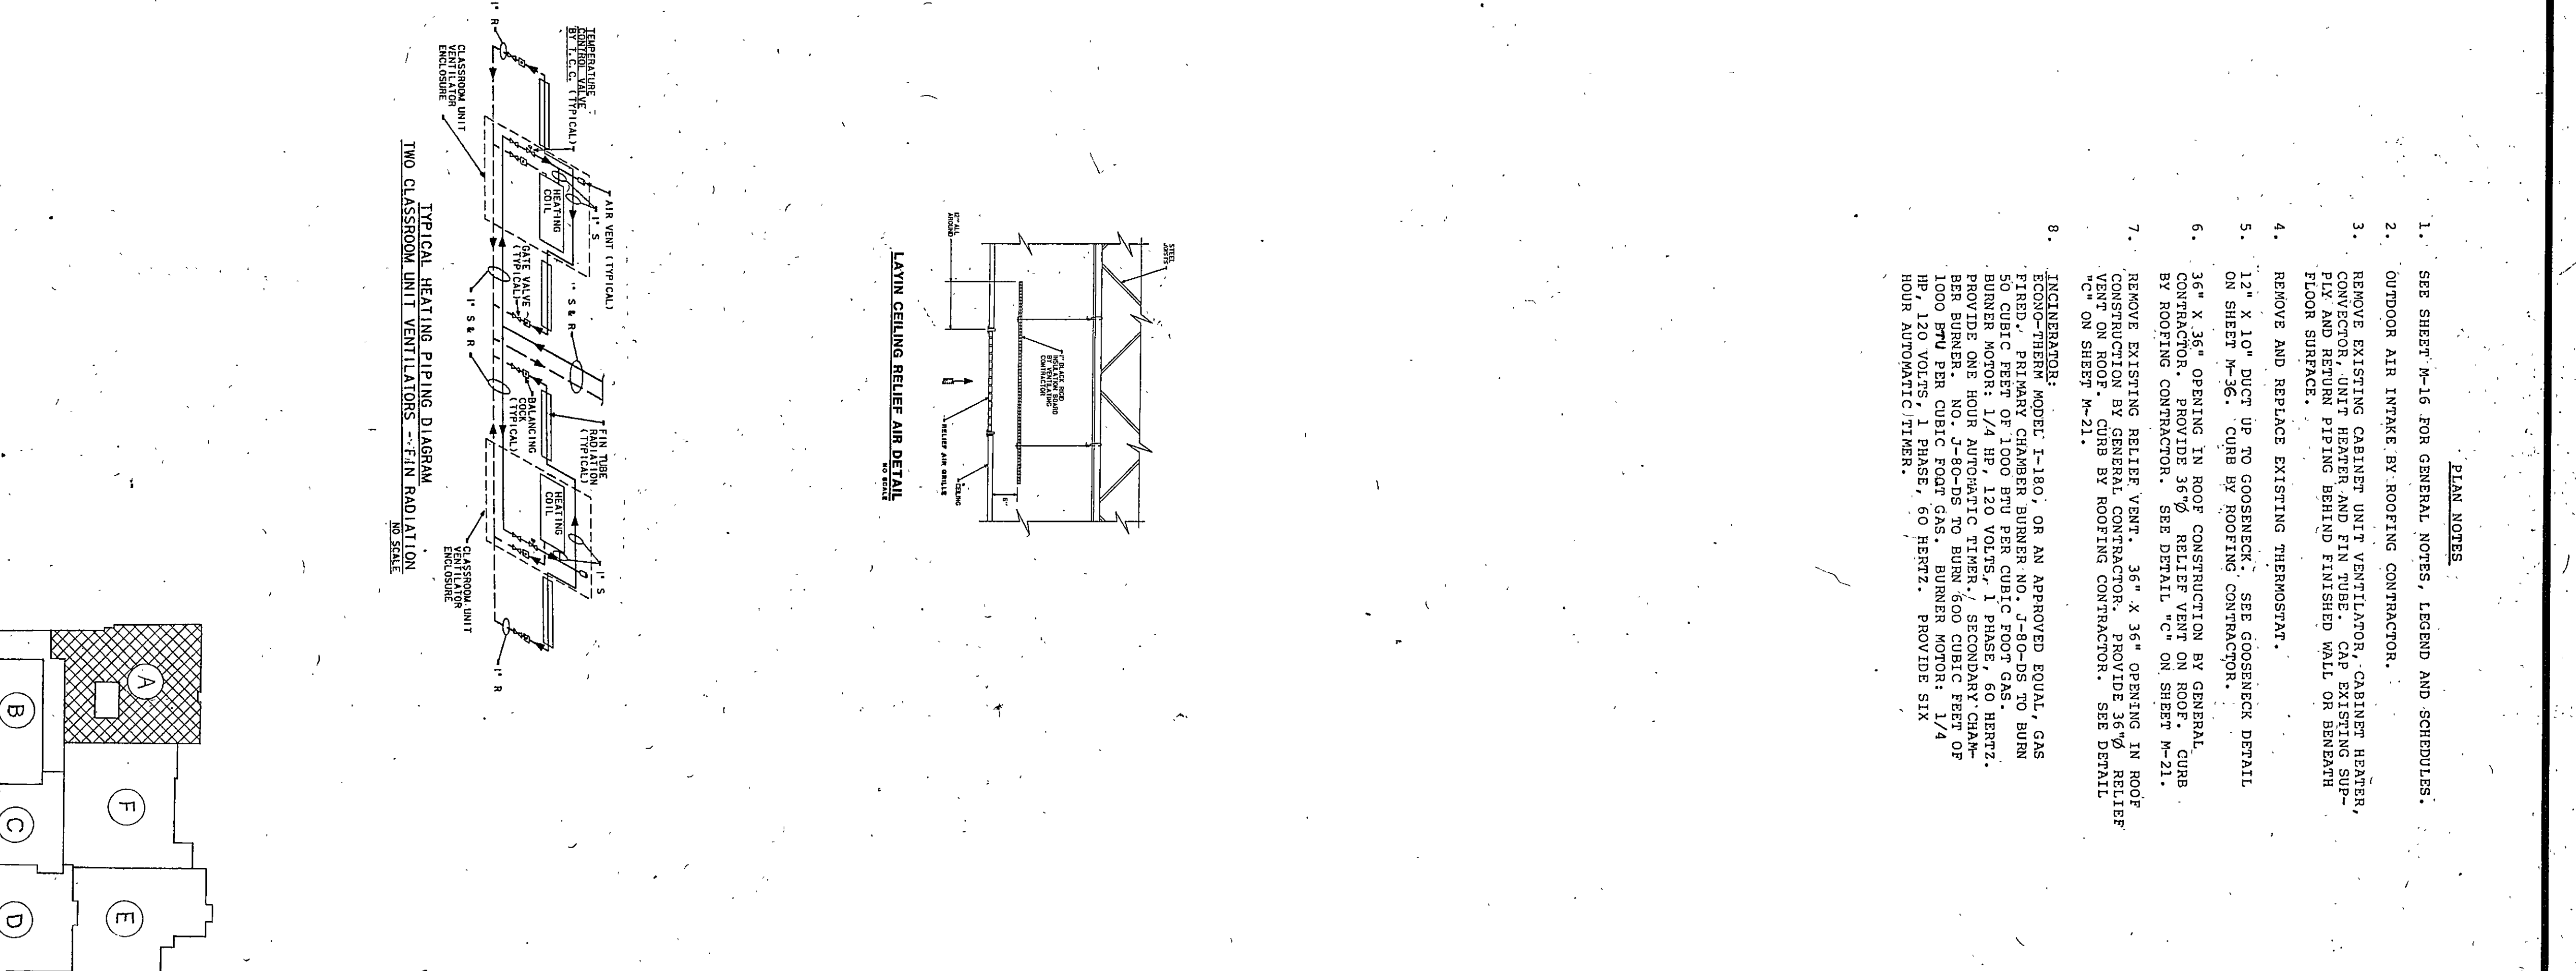


25

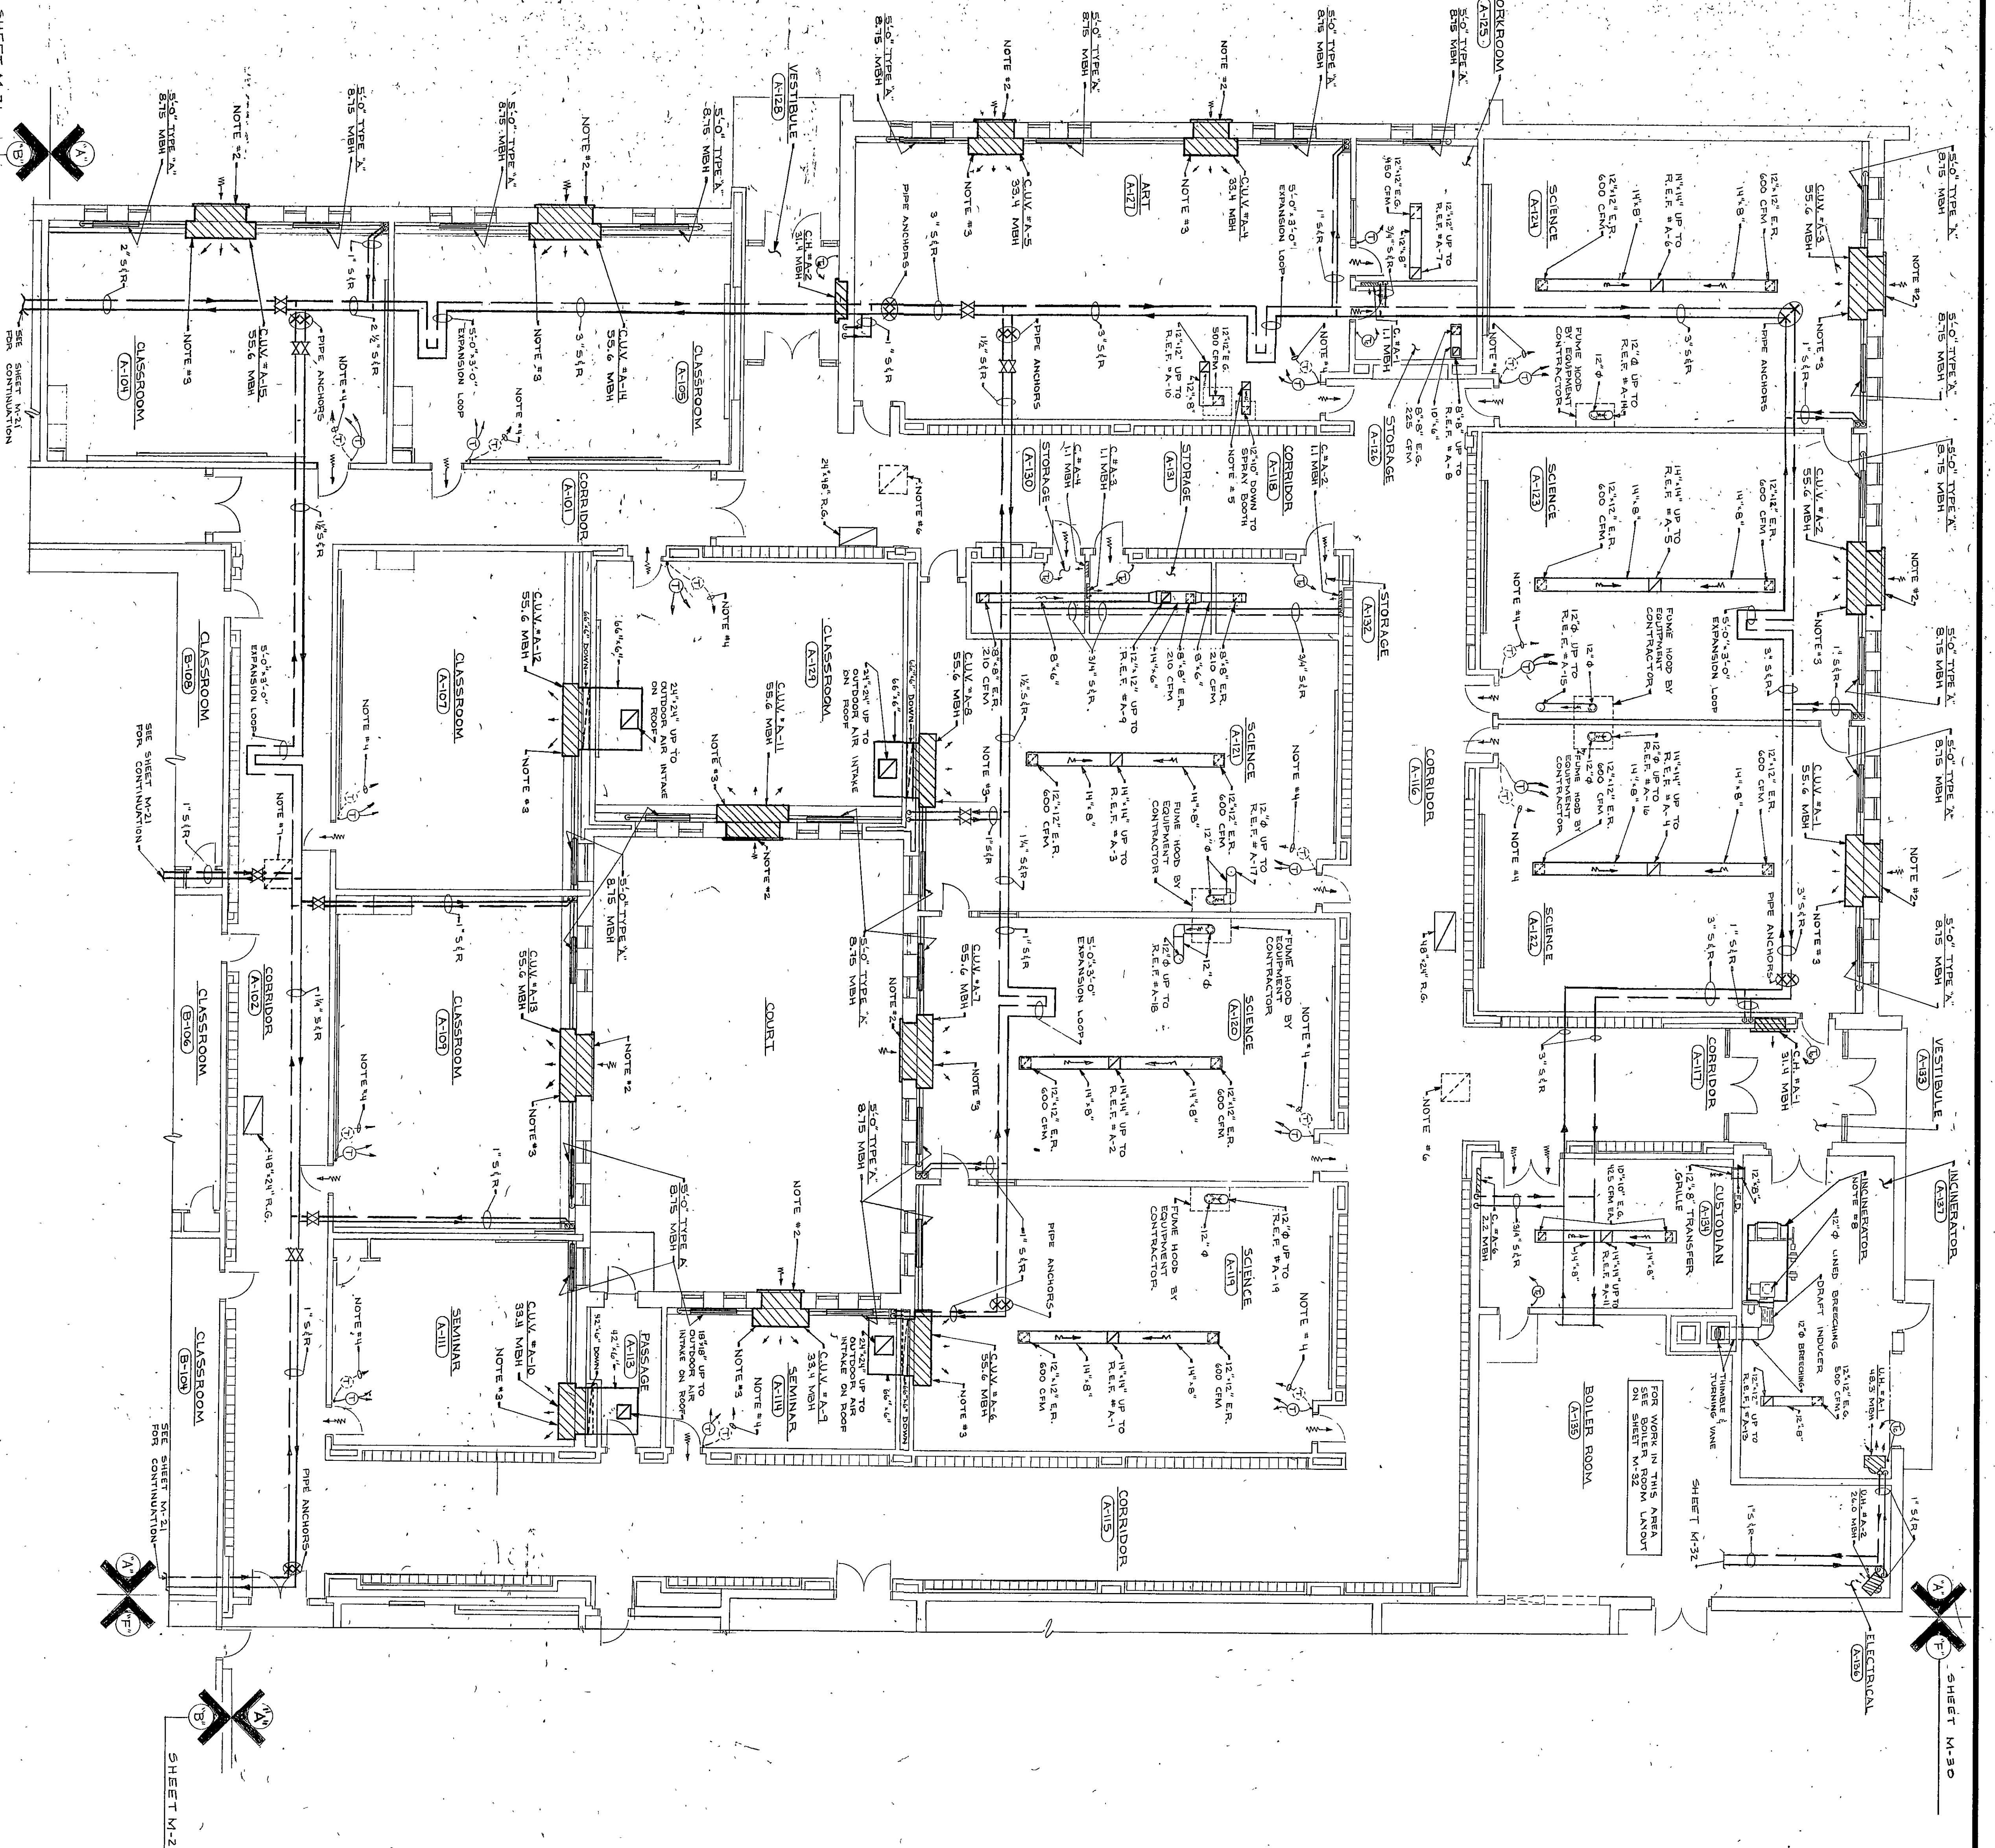

AS-BUILT
25 SEP 1984

NO. M-18
OF 36

PROJECT
12579.00
DATE
MAY 3, 1982
REVISED

James A. Partridge

EVERETT · I · BROWN COMPANY
5500 WEST BRADBURY AVENUE ·
· PARK FLETCHER ·
ADDITION TO AND RENOVATION OF LIBERTY MIDDLE SCHOOL

ARCHITECTS
ENGINEERS
· INDIANAPOLIS, INDIANA · 46241
© EVERETT · I · BROWN COMPANY