


1. SEE SHEET M-3 FOR GENERAL NOTES, LEGEND, AND SCHEDULES.
2. SANITARY AND VENTILATION SYSTEMS SHALL BE CONSTRUCTED OF UNGLAZED, JANT WATER WORKS GRADE CAST IRON PIPE.

PLAN NOTES

EVERETT I. BROWN COMPANY
ARCHITECTS
ENGINEERS
INDIANAPOLIS, INDIANA • 46241

5500 WEST BRADBURY AVENUE • PARK FLETCHER • JACKSON ELEMENTARY SCHOOL

James A. Fletcher

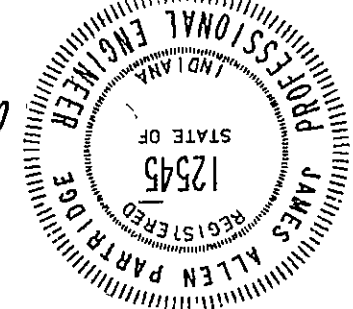



PROJECT
12579.00
DATE
MAY 3, 1982
REVISED

NO. M-7
OF 36

82M07

AS-BUILT
25 SEP 1984

KEY PLAN
NO SCALE

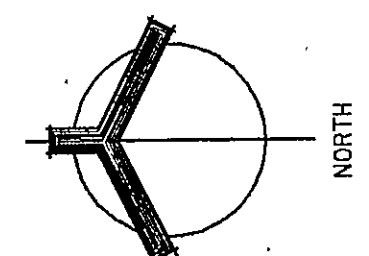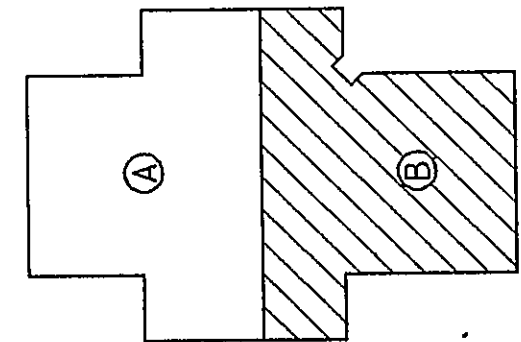

UNIT "B" PLUMBING FOUNDATION PLAN
SCALE: 1/8" = 1'-0"

