




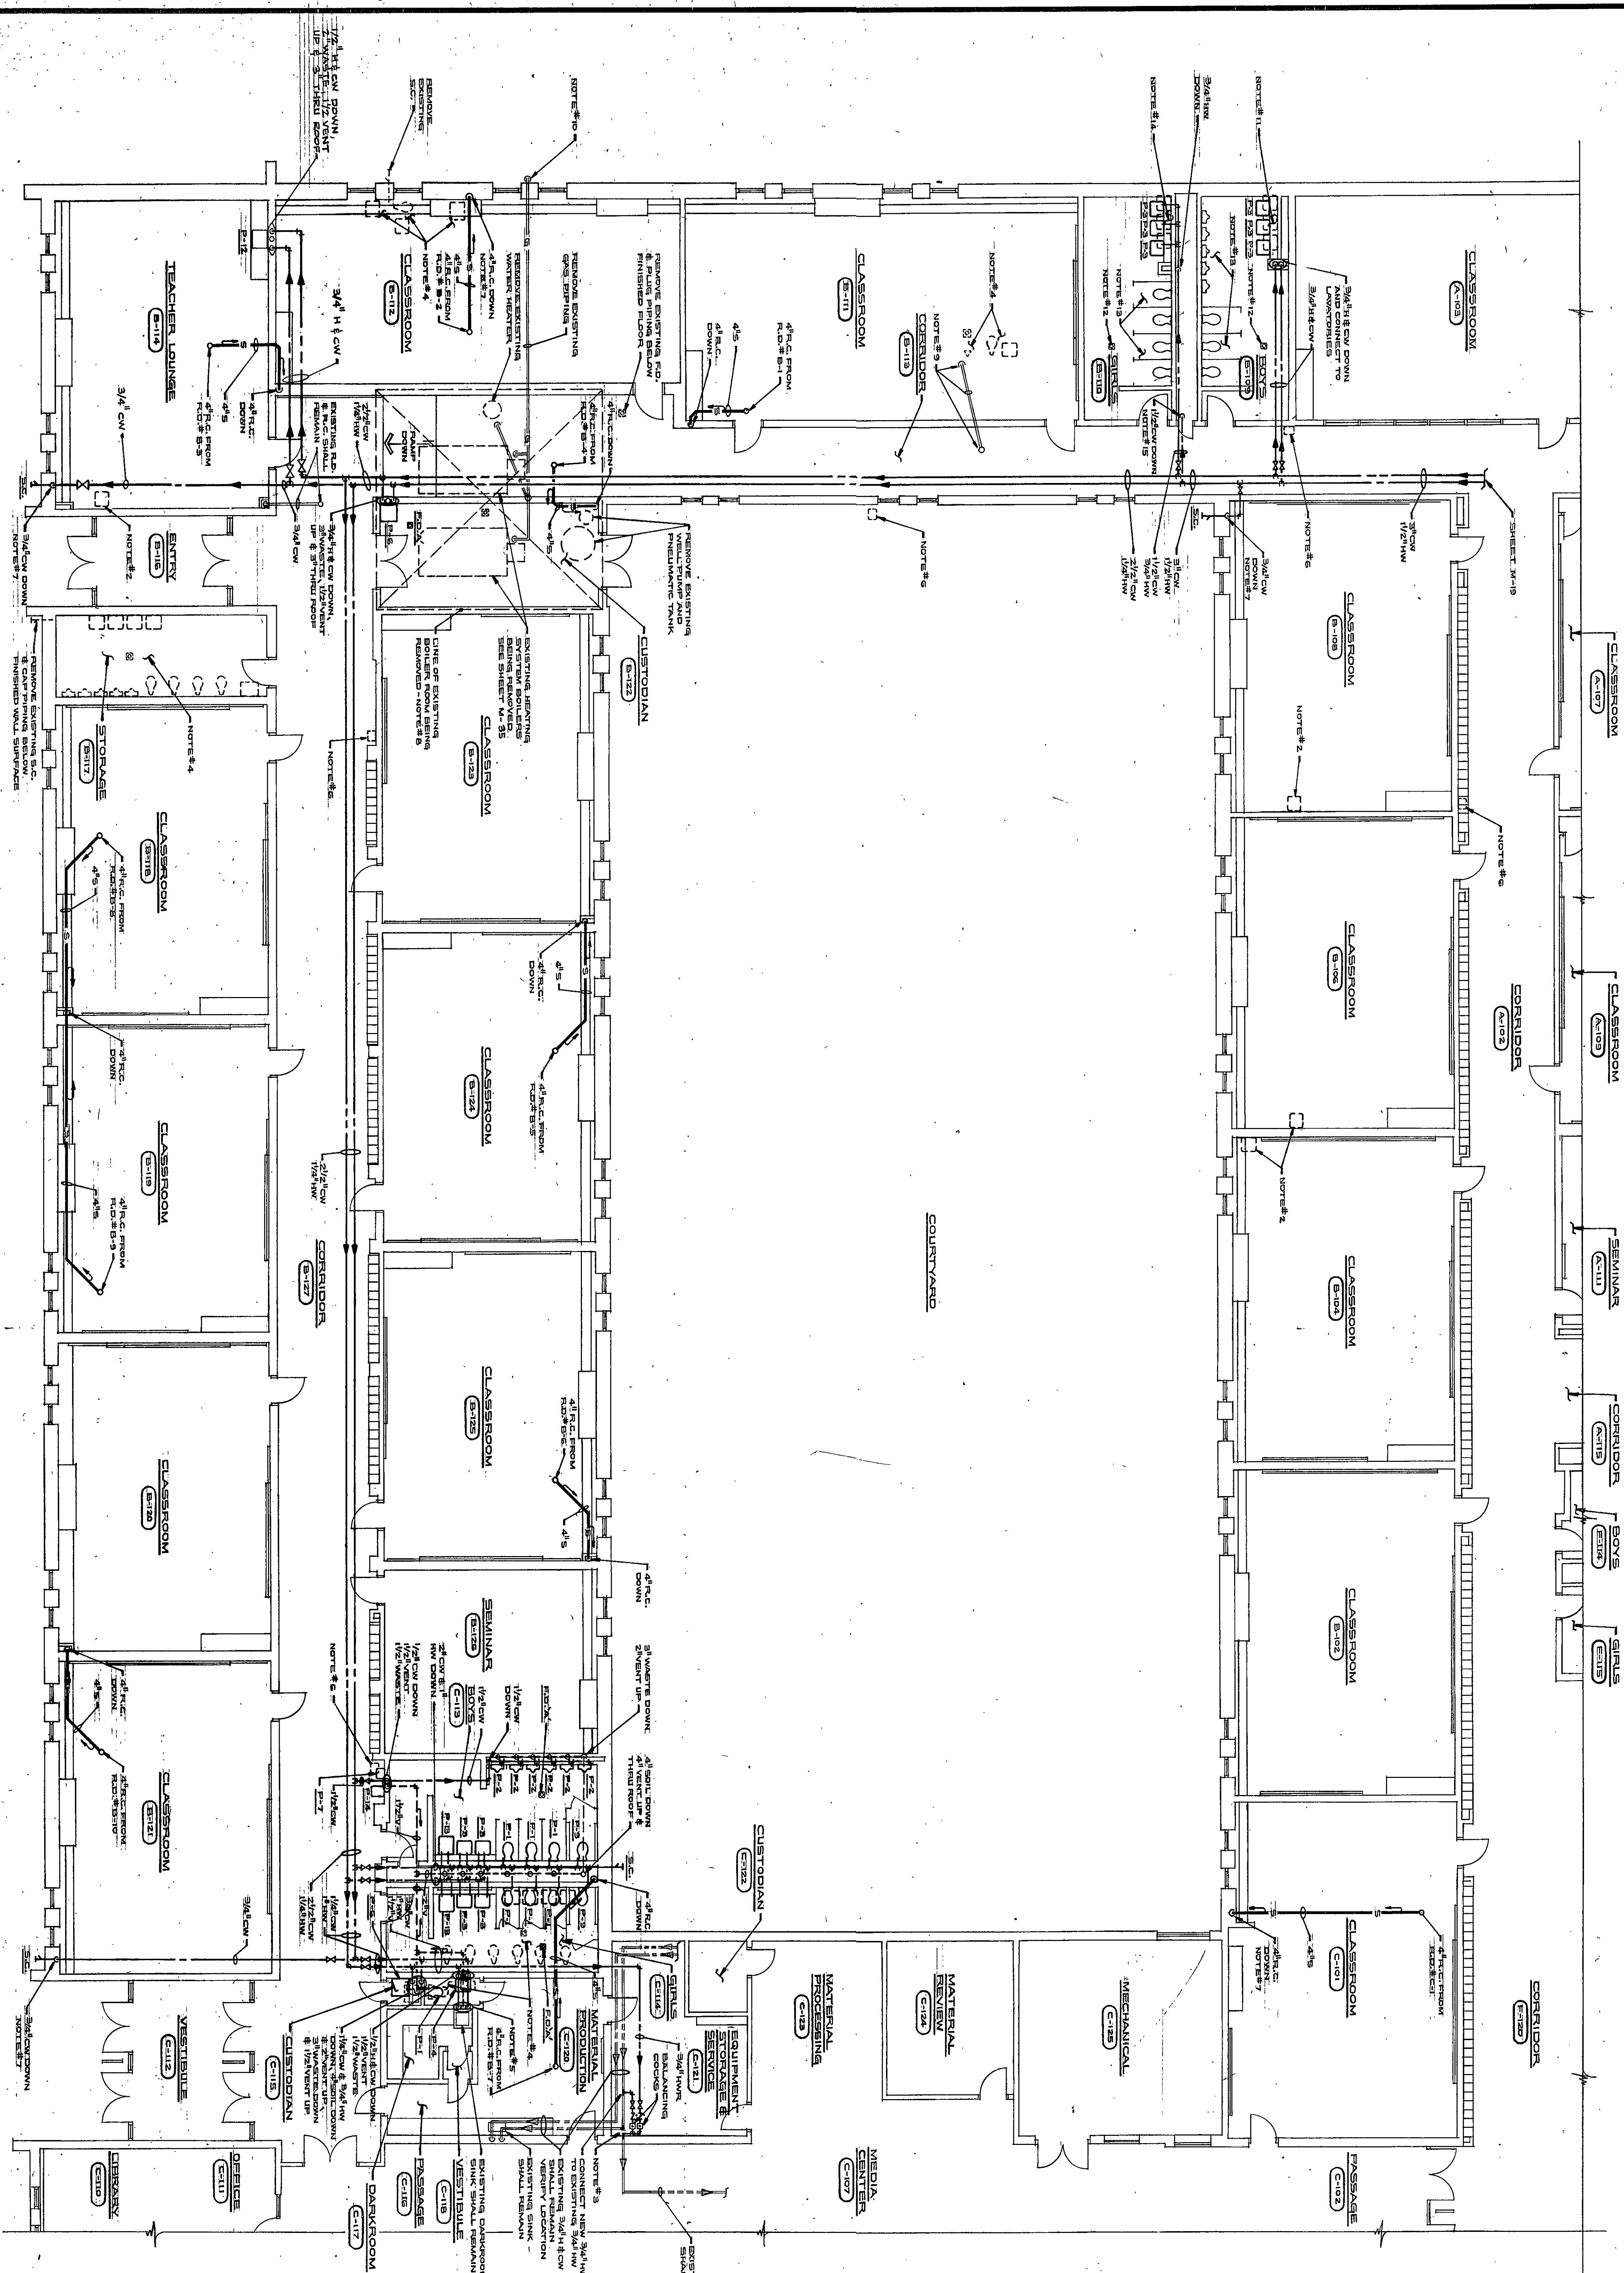

UNIT "B" PLUMBING FIRST FLOOR PLAN AND PARTIAL UNIT "C" PLUMBING FIRST FLOOR PLAN

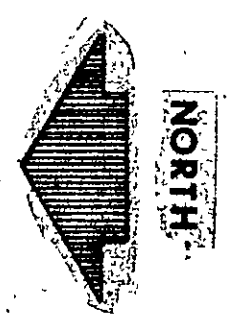

AS-BUILT
25 SEPT 1984

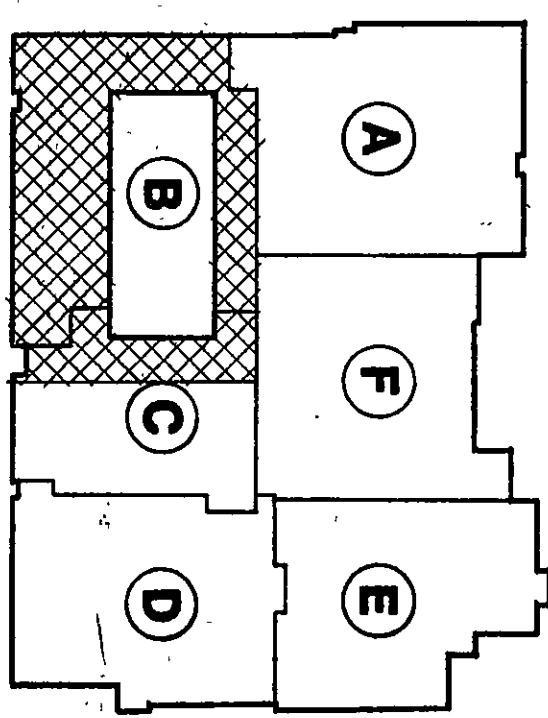

- PLAN NOTES
1. SEE SHEET #3 FOR GENERAL MECHANICAL NOTES, LEGEND AND SCHEDULES.
 2. DISCONNECT AND REMOVE EXISTING LAVATORY, REMOVE WASTE, VENT AND WATER PIPING SERVING LAVATORY, THEN PLUMB, FINISH FLOOR, WALL AND CEILING SURFACES, THEN FLOOR AND CAP.
 3. CUT EXISTING 3/4" INR AND CONNECT TO NEW 1/4" BS SHOWN.
 4. DISCONNECT AND REMOVE EXISTING WATER CLOSET LAVATORY, THEN PLUMB, FINISH FLOOR, WALL, CEILING, DRAIN, ETC. IN THIS AREA. REMOVE WASTE, VENT AND WATER PIPING SERVING EXISTING WATER CLOSET, THEN PLUMB, FINISH FLOOR, WALL, CEILING SURFACES, THEN FLOOR, WALL AND CEILING SURFACES, THEN FLOOR AND CAP.
 5. RUN NEW 1/2" HW, 1/2" CW, 1-1/2" VENT AND 2" WASTE TO PIPING DOWN EXISTING WALL AND CONNECT TO EXISTING DRAINROOM SINK. REMOVE EXISTING SINK AND WATER PIPING SERVING EXISTING SINK AND WATER PIPING SERVING FINISHED FLOOR, WALL AND CEILING SURFACES, THEN PLUMB AND CAP.
 6. REMOVE EXISTING DRAINING PUMP/RAIN AND CAP EXISTING PUMPING PIPING BELOW FINISHED FLOOR, WALL AND CEILING SURFACES.
 7. WHEN NEW PIPING IS RUN DOWN EXTERIOR WALLS PIPING SHALL BE RUN ON ROOF SIDE OF WALL INSULATION.
 8. REMOVE ALL EXISTING DOLLER ROOM EQUIPMENT AND FLOOR DRAIN IN THIS AREA. REMOVE ALL EXISTING GAS, WATER, WASTE AND VENT PIPING, AND CEILING SURFACES, THEN PLUMB, WALL AND CEILING SURFACES, THEN PLUMB AND CAP.
 9. REMOVE EXISTING ROOF DRAIN AND ROOF CON-DUCTOR SURFACE. PIPING BELOW FINISHED FLOOR SURFACE.
 10. REMOVE EXISTING GAS RISER AND CAP PIPING BELOW FINISHED GRADE.
 11. REMOVE EXISTING LAVATORIES AND INSTALL NEW LAVATORIES AS SHOWN. CONNECT NEW LAVATORY WASTE TO WASTE AND VENT PIPING SERVING THE EXISTING LAVATORIES BEING REMOVED.
 12. RAISE SPRINKLER OF EXISTING FLOOR DRAIN TO MATCH NEW FINISHED FLOOR SURFACE.
 13. DISCONNECT AND REMOVE EXISTING WATER CLOSET LAVATORY, THEN PLUMB, FINISH FLOOR, WALL, CEILING, TILE WALL SURFACE HAS BEEN INSTALLED. THEN INSTALL AND RECONNECT EXISTING WATER CLOSET LAVATORY AFTER NEW CERAMIC TILE WALL SURFACE HAS BEEN INSTALLED.
 14. REMOVE EXISTING LAVATORY AND INSTALL NEW LAVATORY AS SHOWN. CONNECT NEW LAVATORY WASTE TO EXISTING CON-WASTE AND VENT PIPING LOCATED IN PIPE CHASE. CONNECT NEW LAVATORY TO NEW HOT WATER LINE AS SHOWN.
 15. CONNECT NEW 1-1/2" CW PIPE TO THE EXISTING 1-1/4" SHUT-OFF VALVE IN THE CW PIPING REMOVED SERVING THE EXISTING PUMPING PIPING IN PIPE CHASE WHICH IS NOT BEING RAISED.