





EXISTING

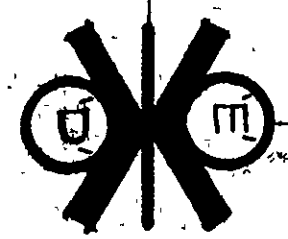


SHEET M-18


PLAN NOTES
1. SEE SHEET M-3 FOR GENERAL MECHANICAL NOTES, LEGEND AND SCHEDULES.

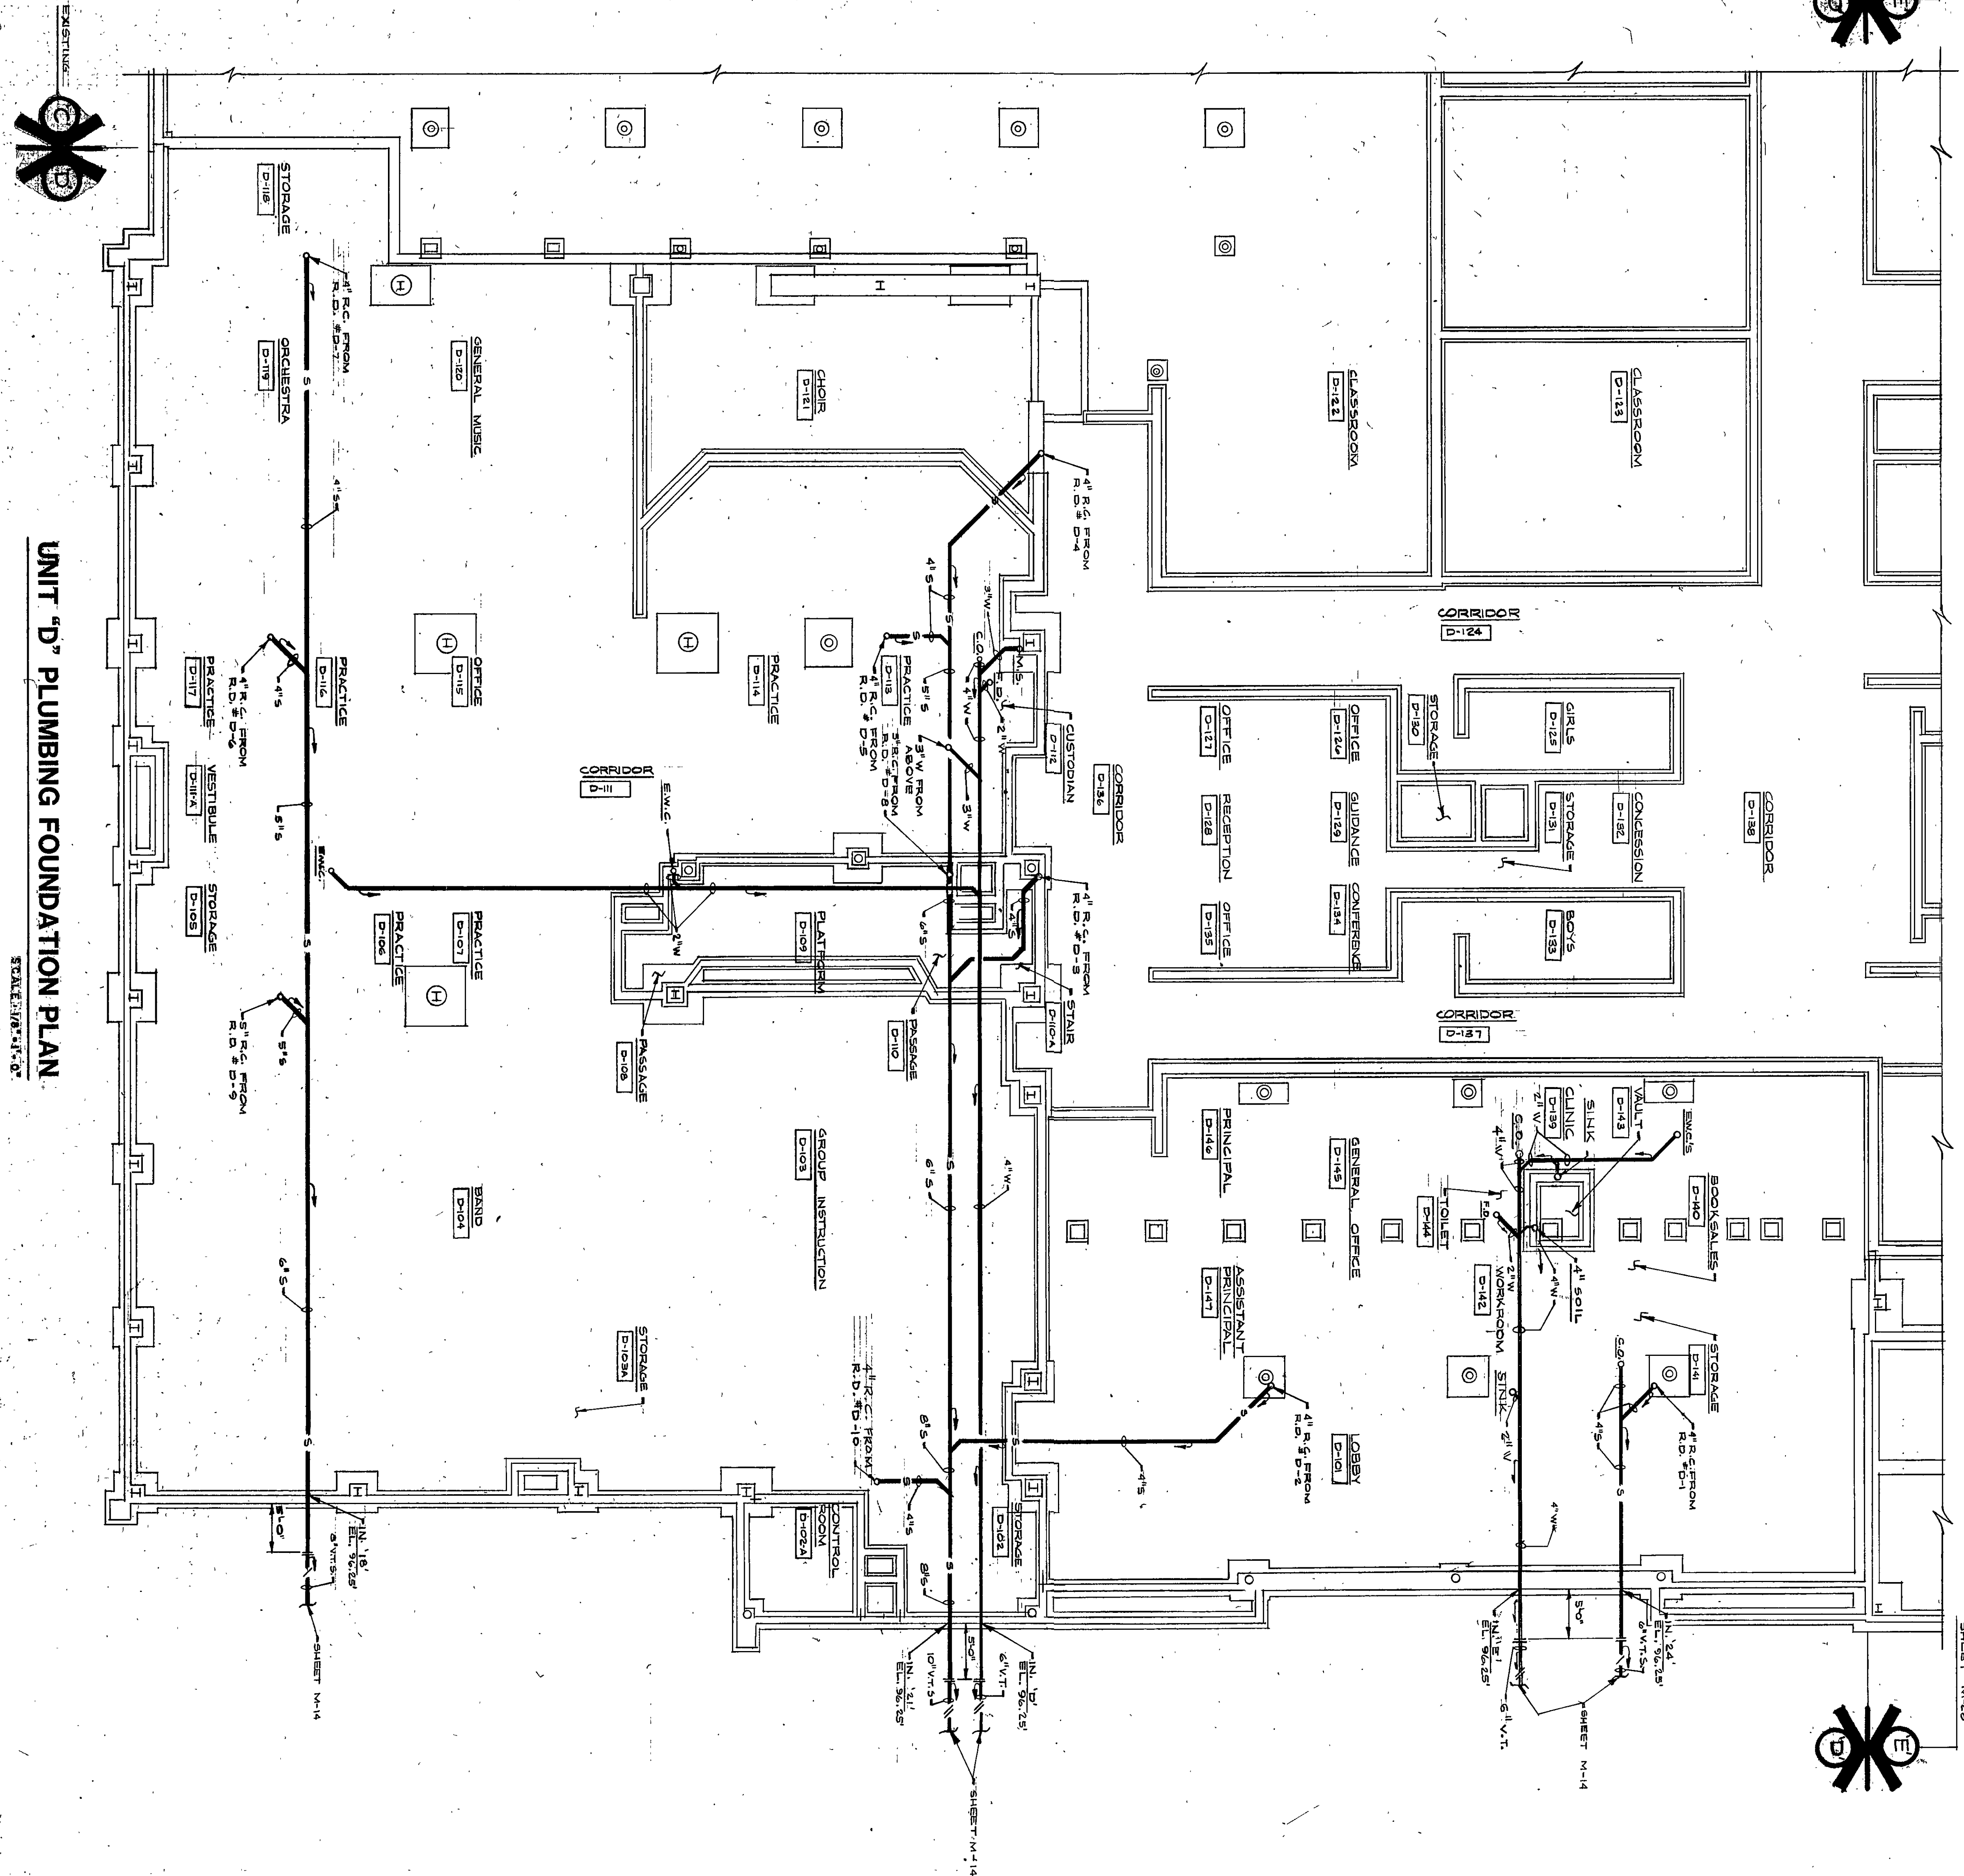

UNIT 'D' PLUMBING FOUNDATION PLAN

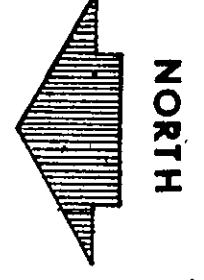

SCALE: 1/4" = 1'-0"

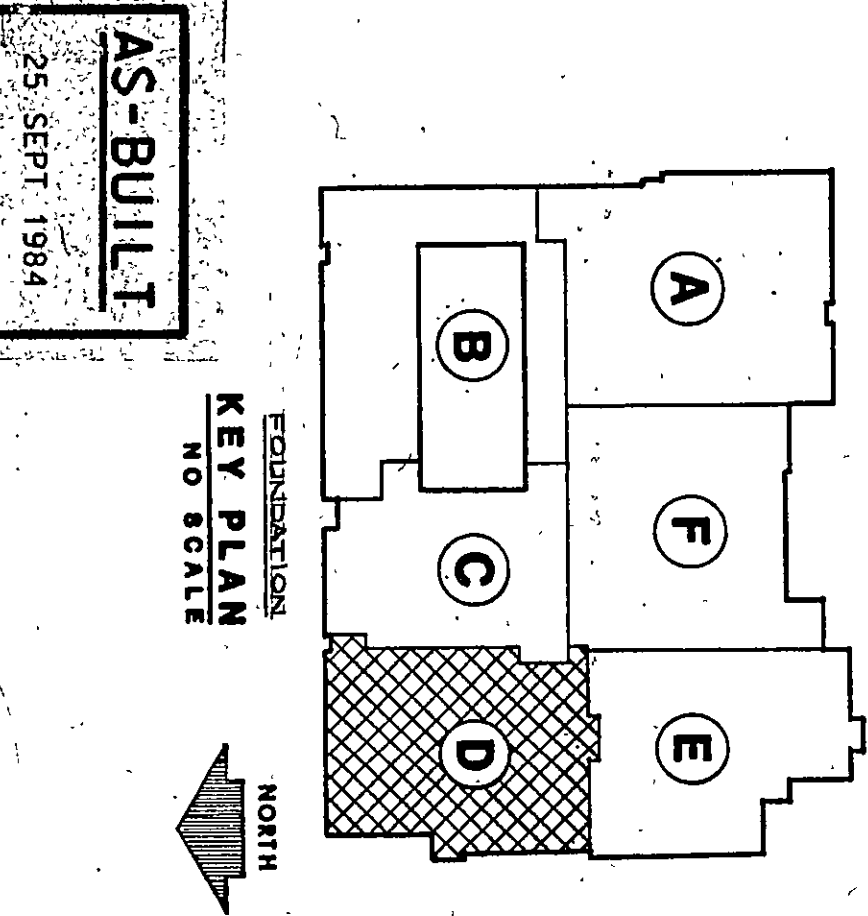

AS-BUILT
25 SEPT 1984

NO. M-24
OF 36

PROJECT
12579.00
DATE
MAY 3, 1982
REVISED

EVERETT · I · BROWN COMPANY
5500 WEST BRADBURY AVENUE · PARK FLETCHER · INDIANAPOLIS, INDIANA · 46241

ARCHITECTS
ENGINEERS

ADDITION TO AND RENOVATION OF LIBERTY MIDDLE SCHOOL

© EVERETT I. BROWN COMPANY