

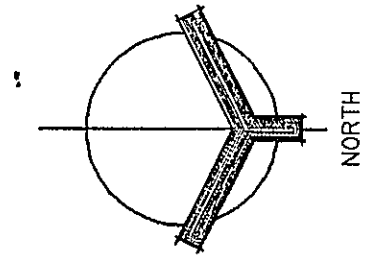
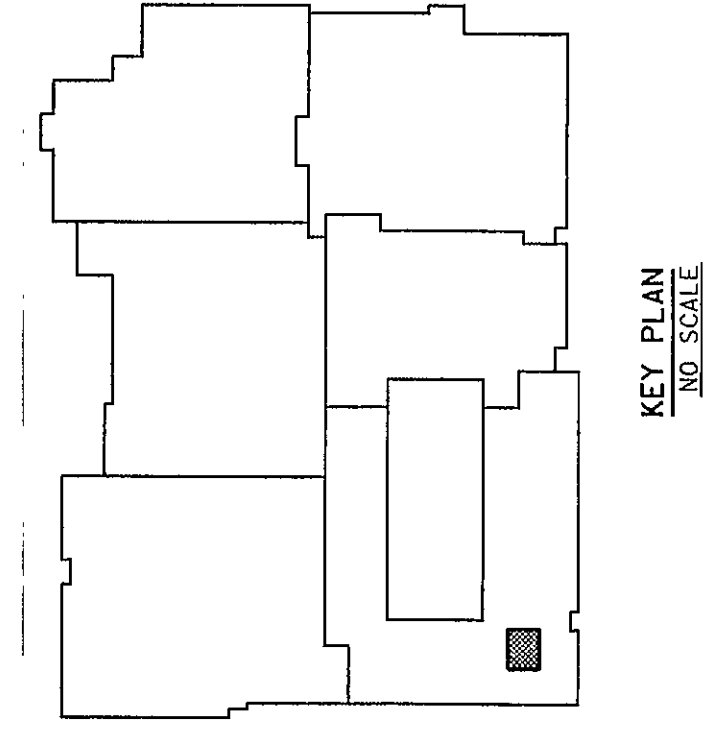
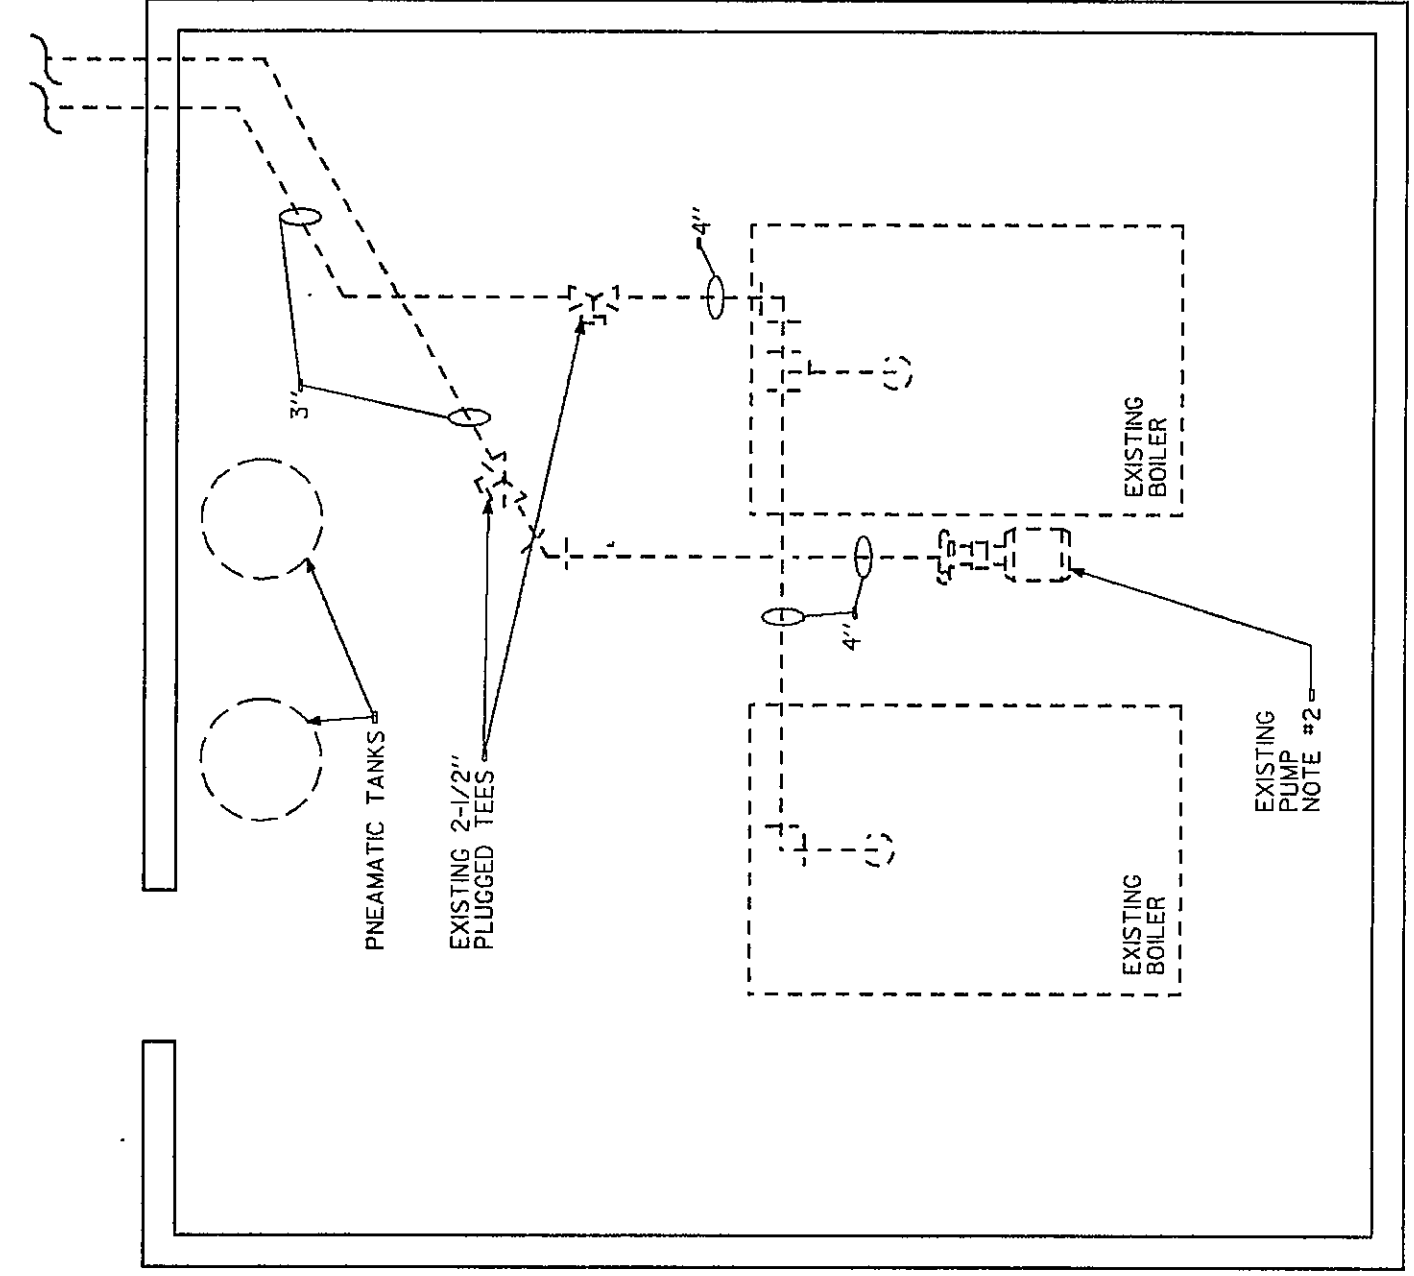





PLAN NOTES
1. SEE SHEET M-3 FOR GENERAL NOTES, LEGEND AND SCHEDULES.
2. REMOVE EXISTING EQUIPMENT NOTED AND TURN OVER TO OWNER.

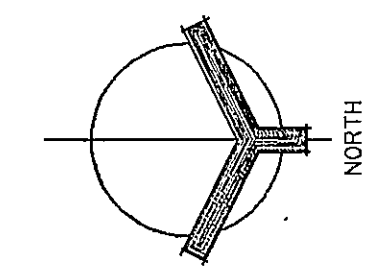


EXISTING BOILER ROOM PLAN (UNIT 'B')
SCALE: 1/4" = 1'-0"

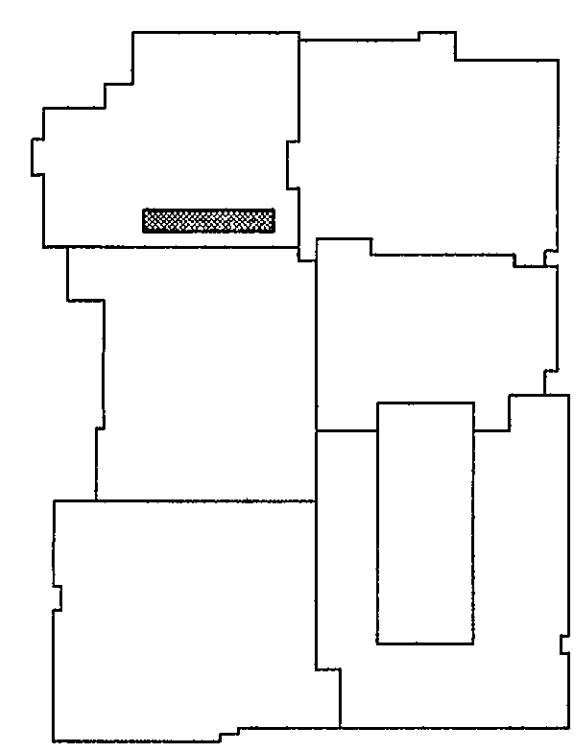

EXISTING MECHANICAL EQUIPMENT ROOM (DEMOLITION)
SCALE: 1/4" = 1'-0"

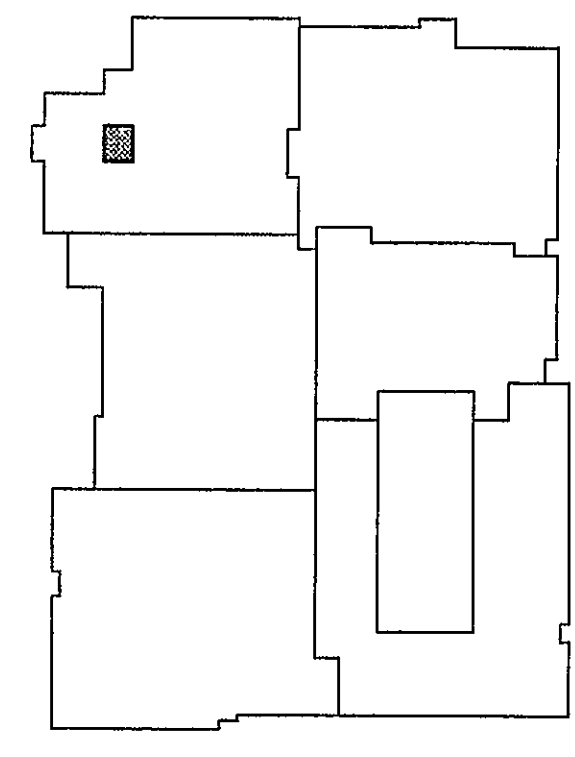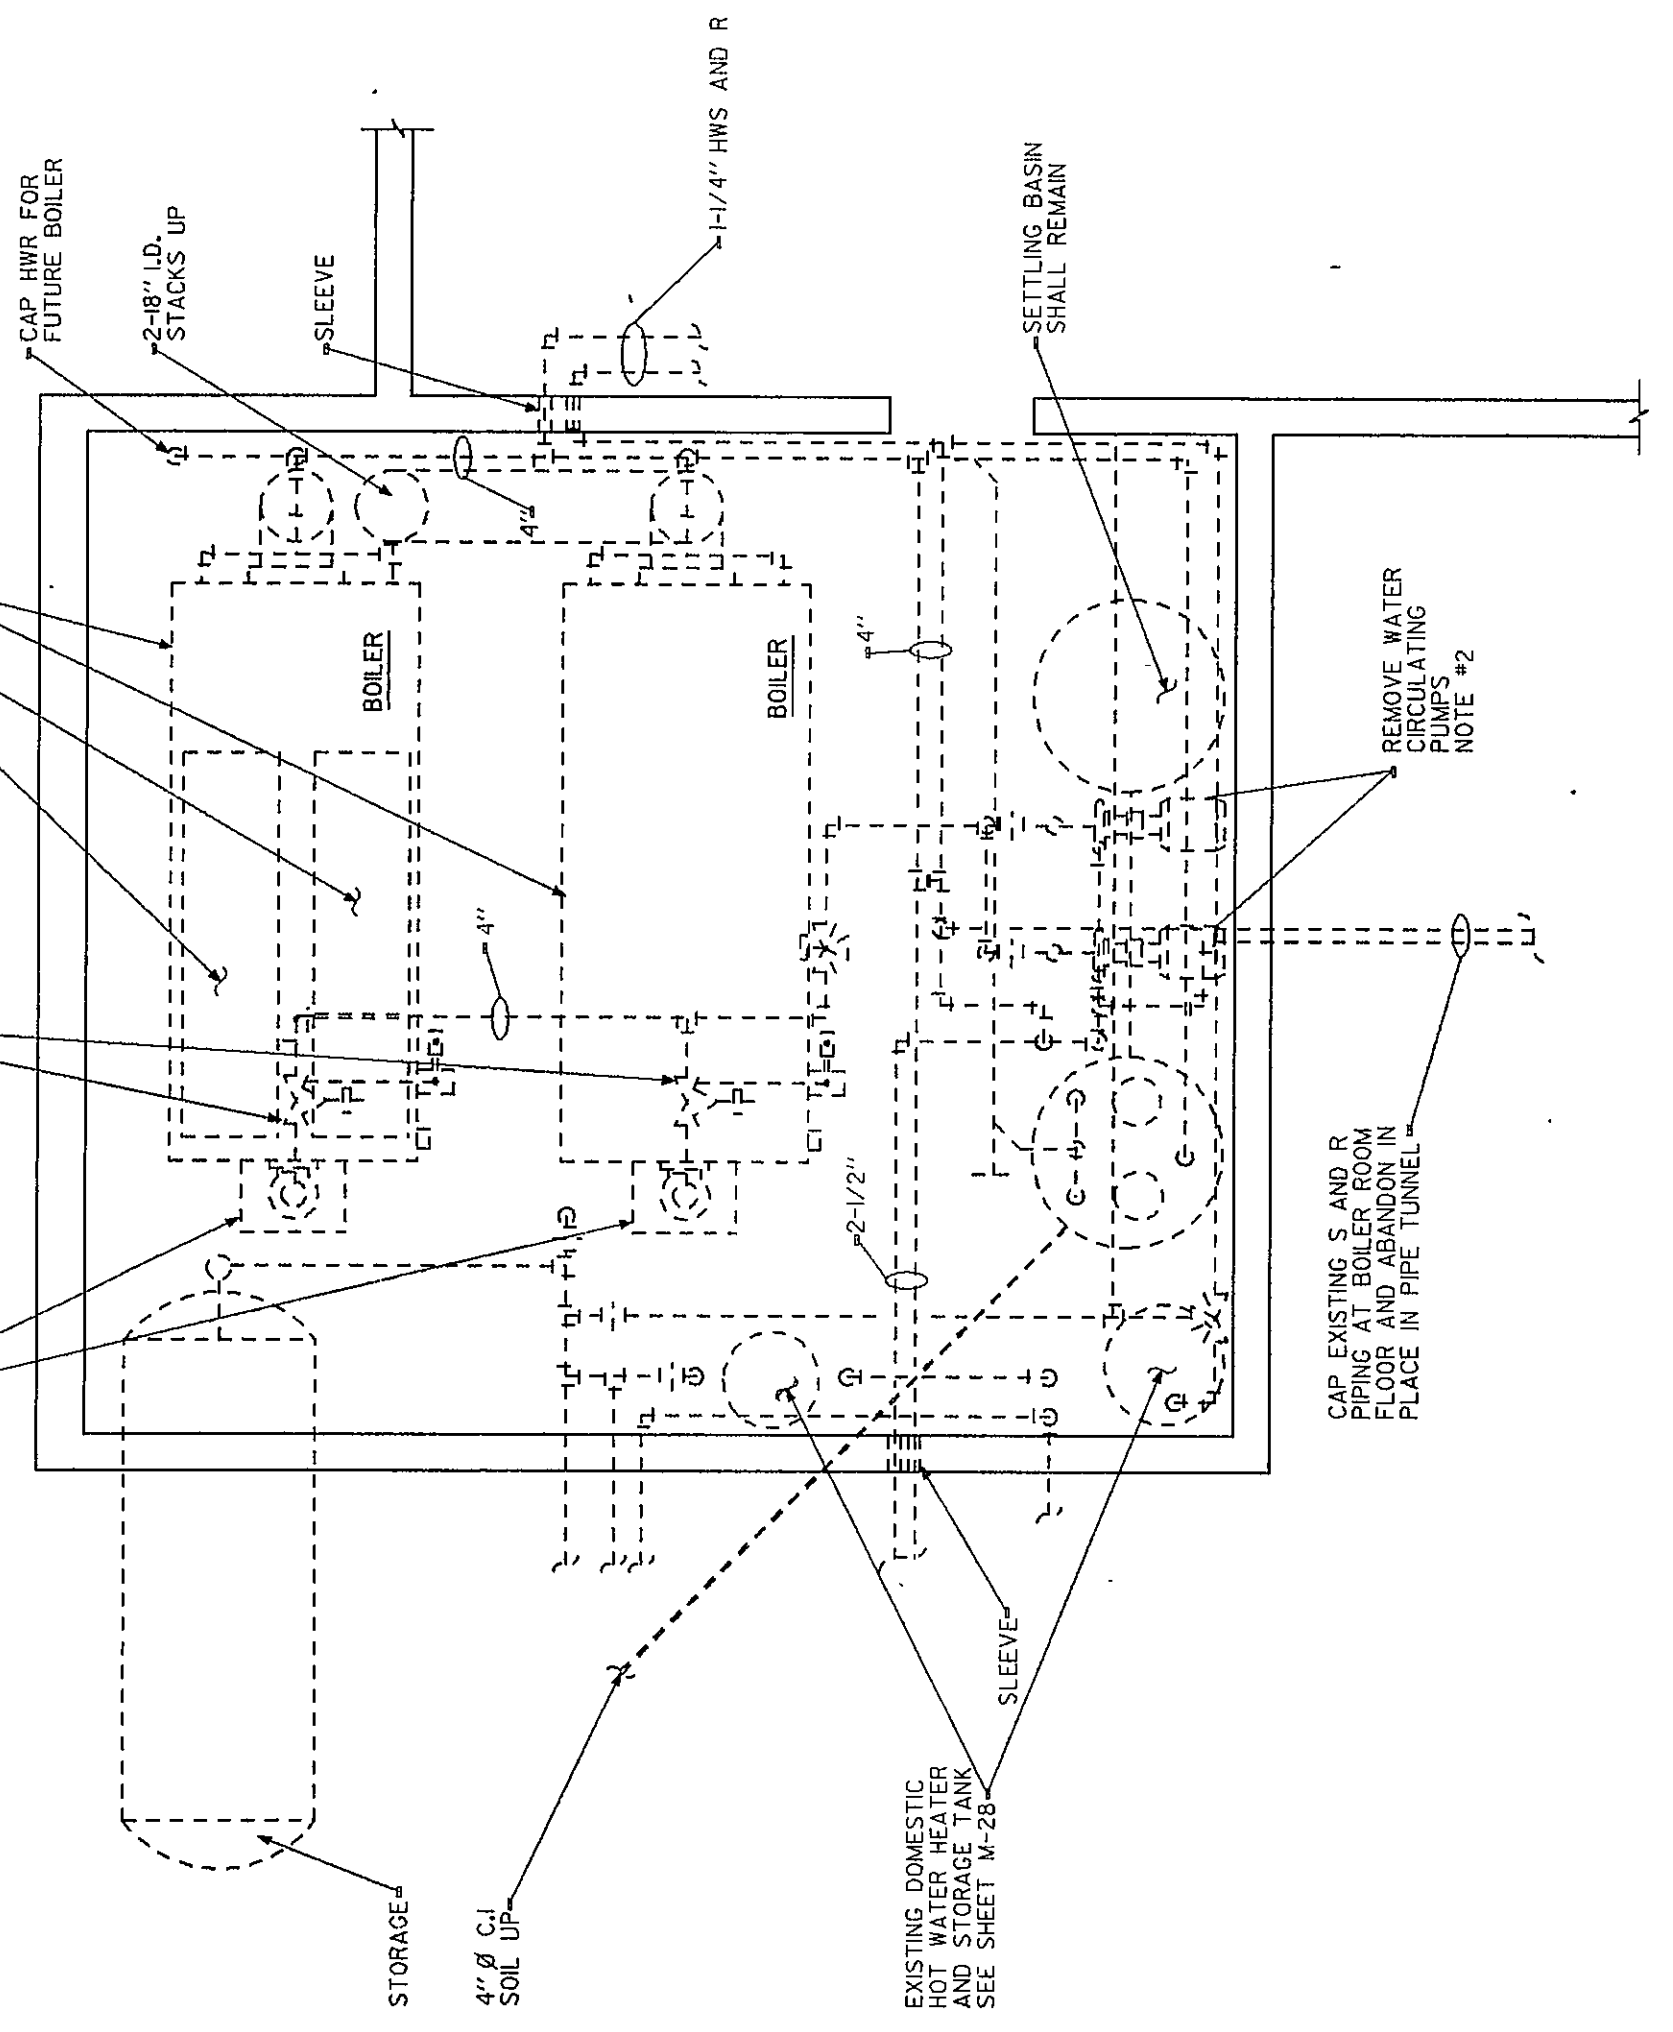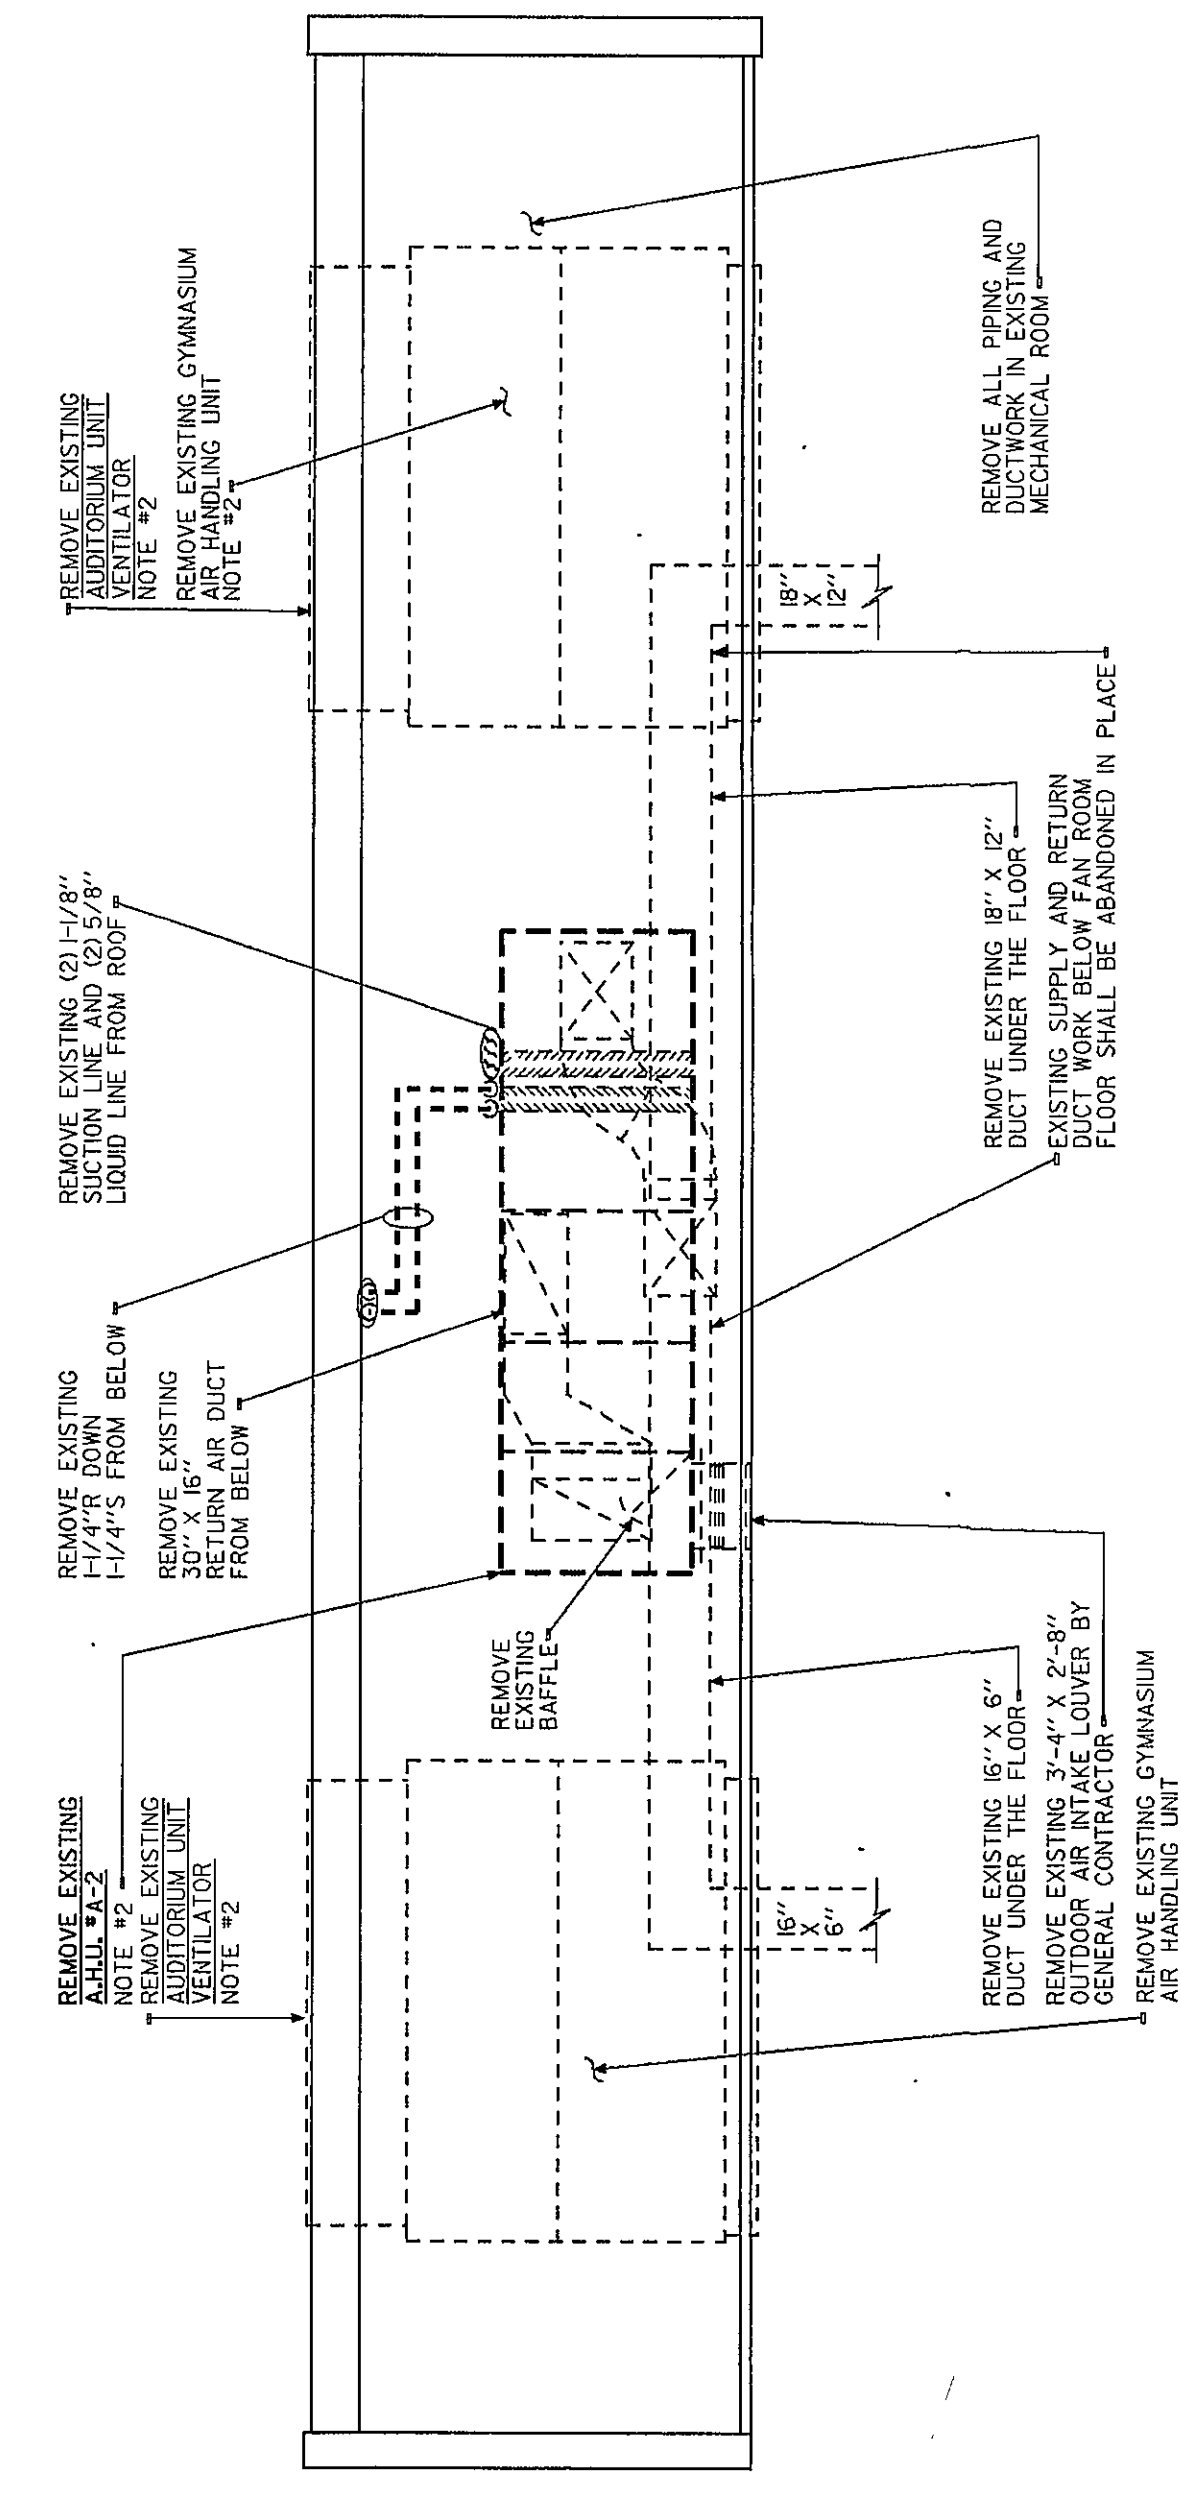

EXISTING BOILER ROOM PLAN (UNIT 'E')
SCALE: 1/4" = 1'-0"

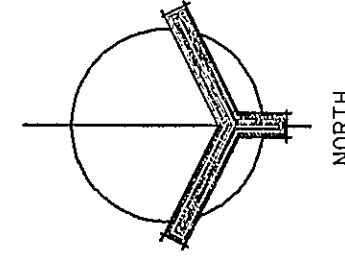

AS-BUILT
25 SEPT 1984

KEY PLAN
NO. SCALE