
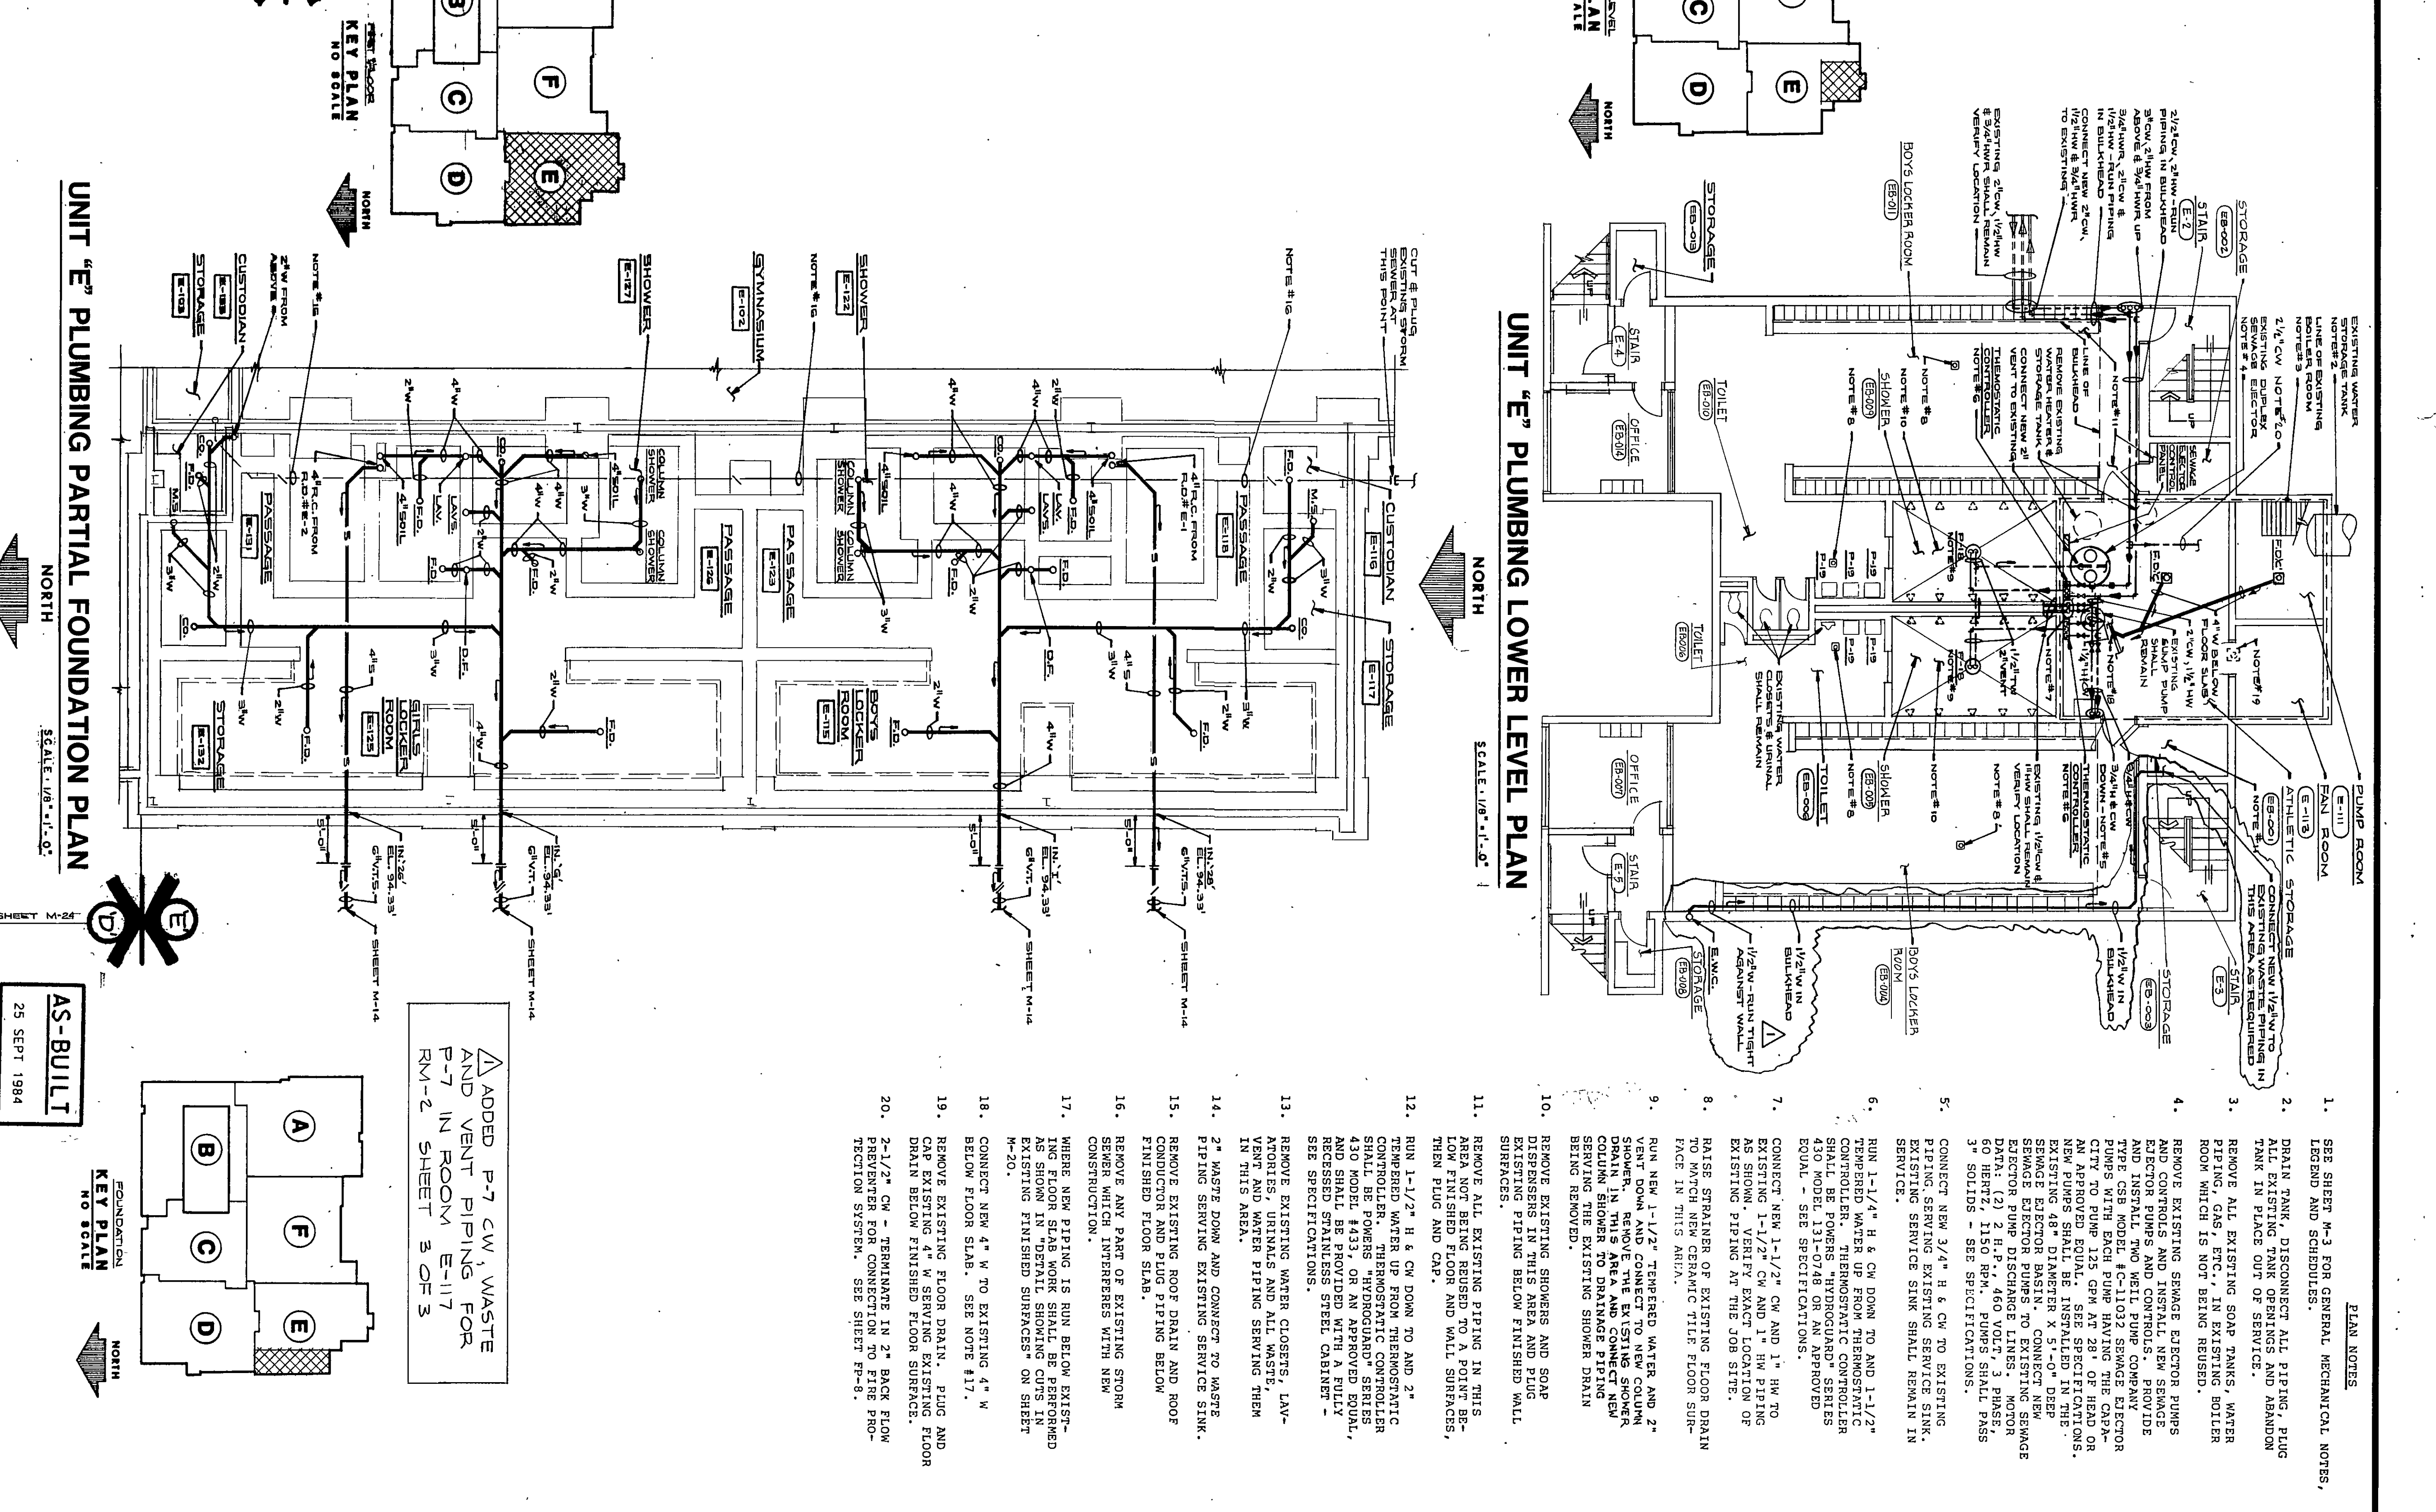


R-27

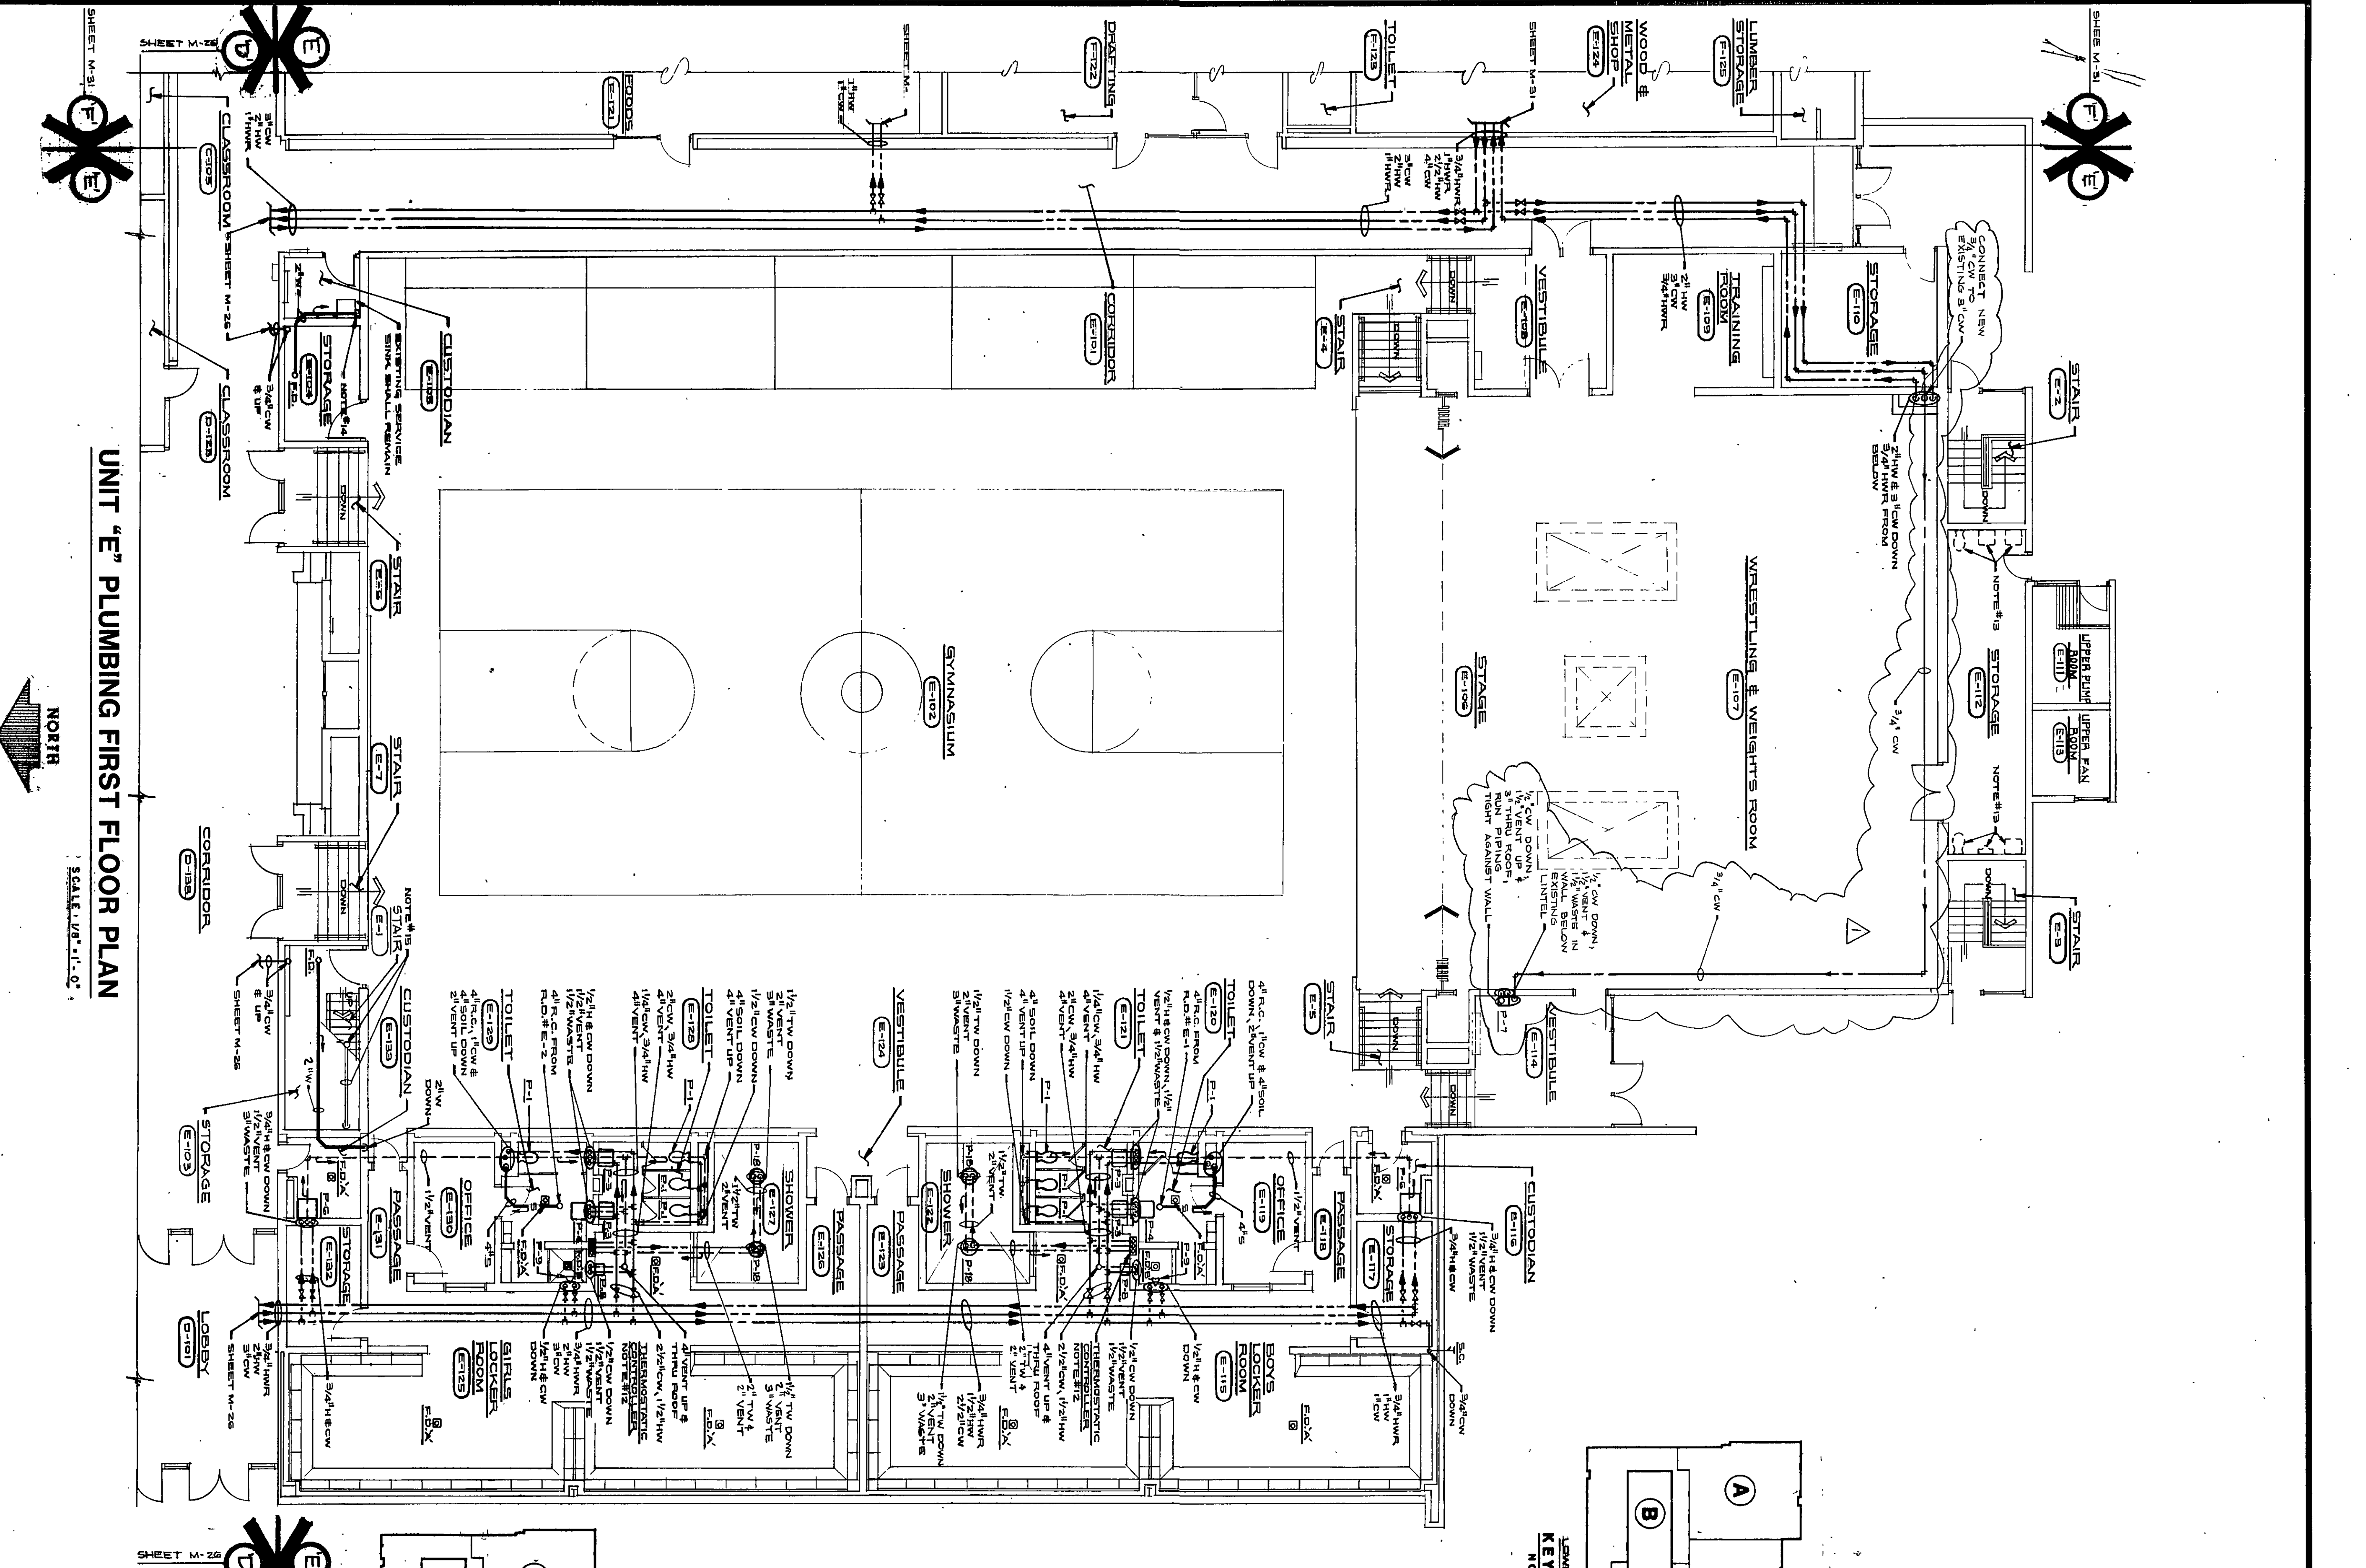

PROJECT
12579.00
DATE
MAY 3, 1982
REVISED
JAN. 14, 1983

NO. N-28
OF 36

8-2-11-15

AS-BUILT
25 SEPT 1984

FOUNDATION
KEY PLAN
NO SCALE

NO. N-28
OF 36

12545
JAMES A. PARTRIDGE
REGISTERED PROFESSIONAL ENGINEER
STATE OF INDIANA
1980

JAMES A. PARTRIDGE

EVERETT · I · BROWN COMPANY
5500 WEST BRADBURY AVENUE ·
ADDITION TO AND RENOVATION OF LIBERTY MIDDLE SCHOOL

PARK FLETCHER ·
ARCHITECTS
ENGINEERS
INDIANAPOLIS, INDIANA · 46241

© EVERETT · I · BROWN COMPANY