




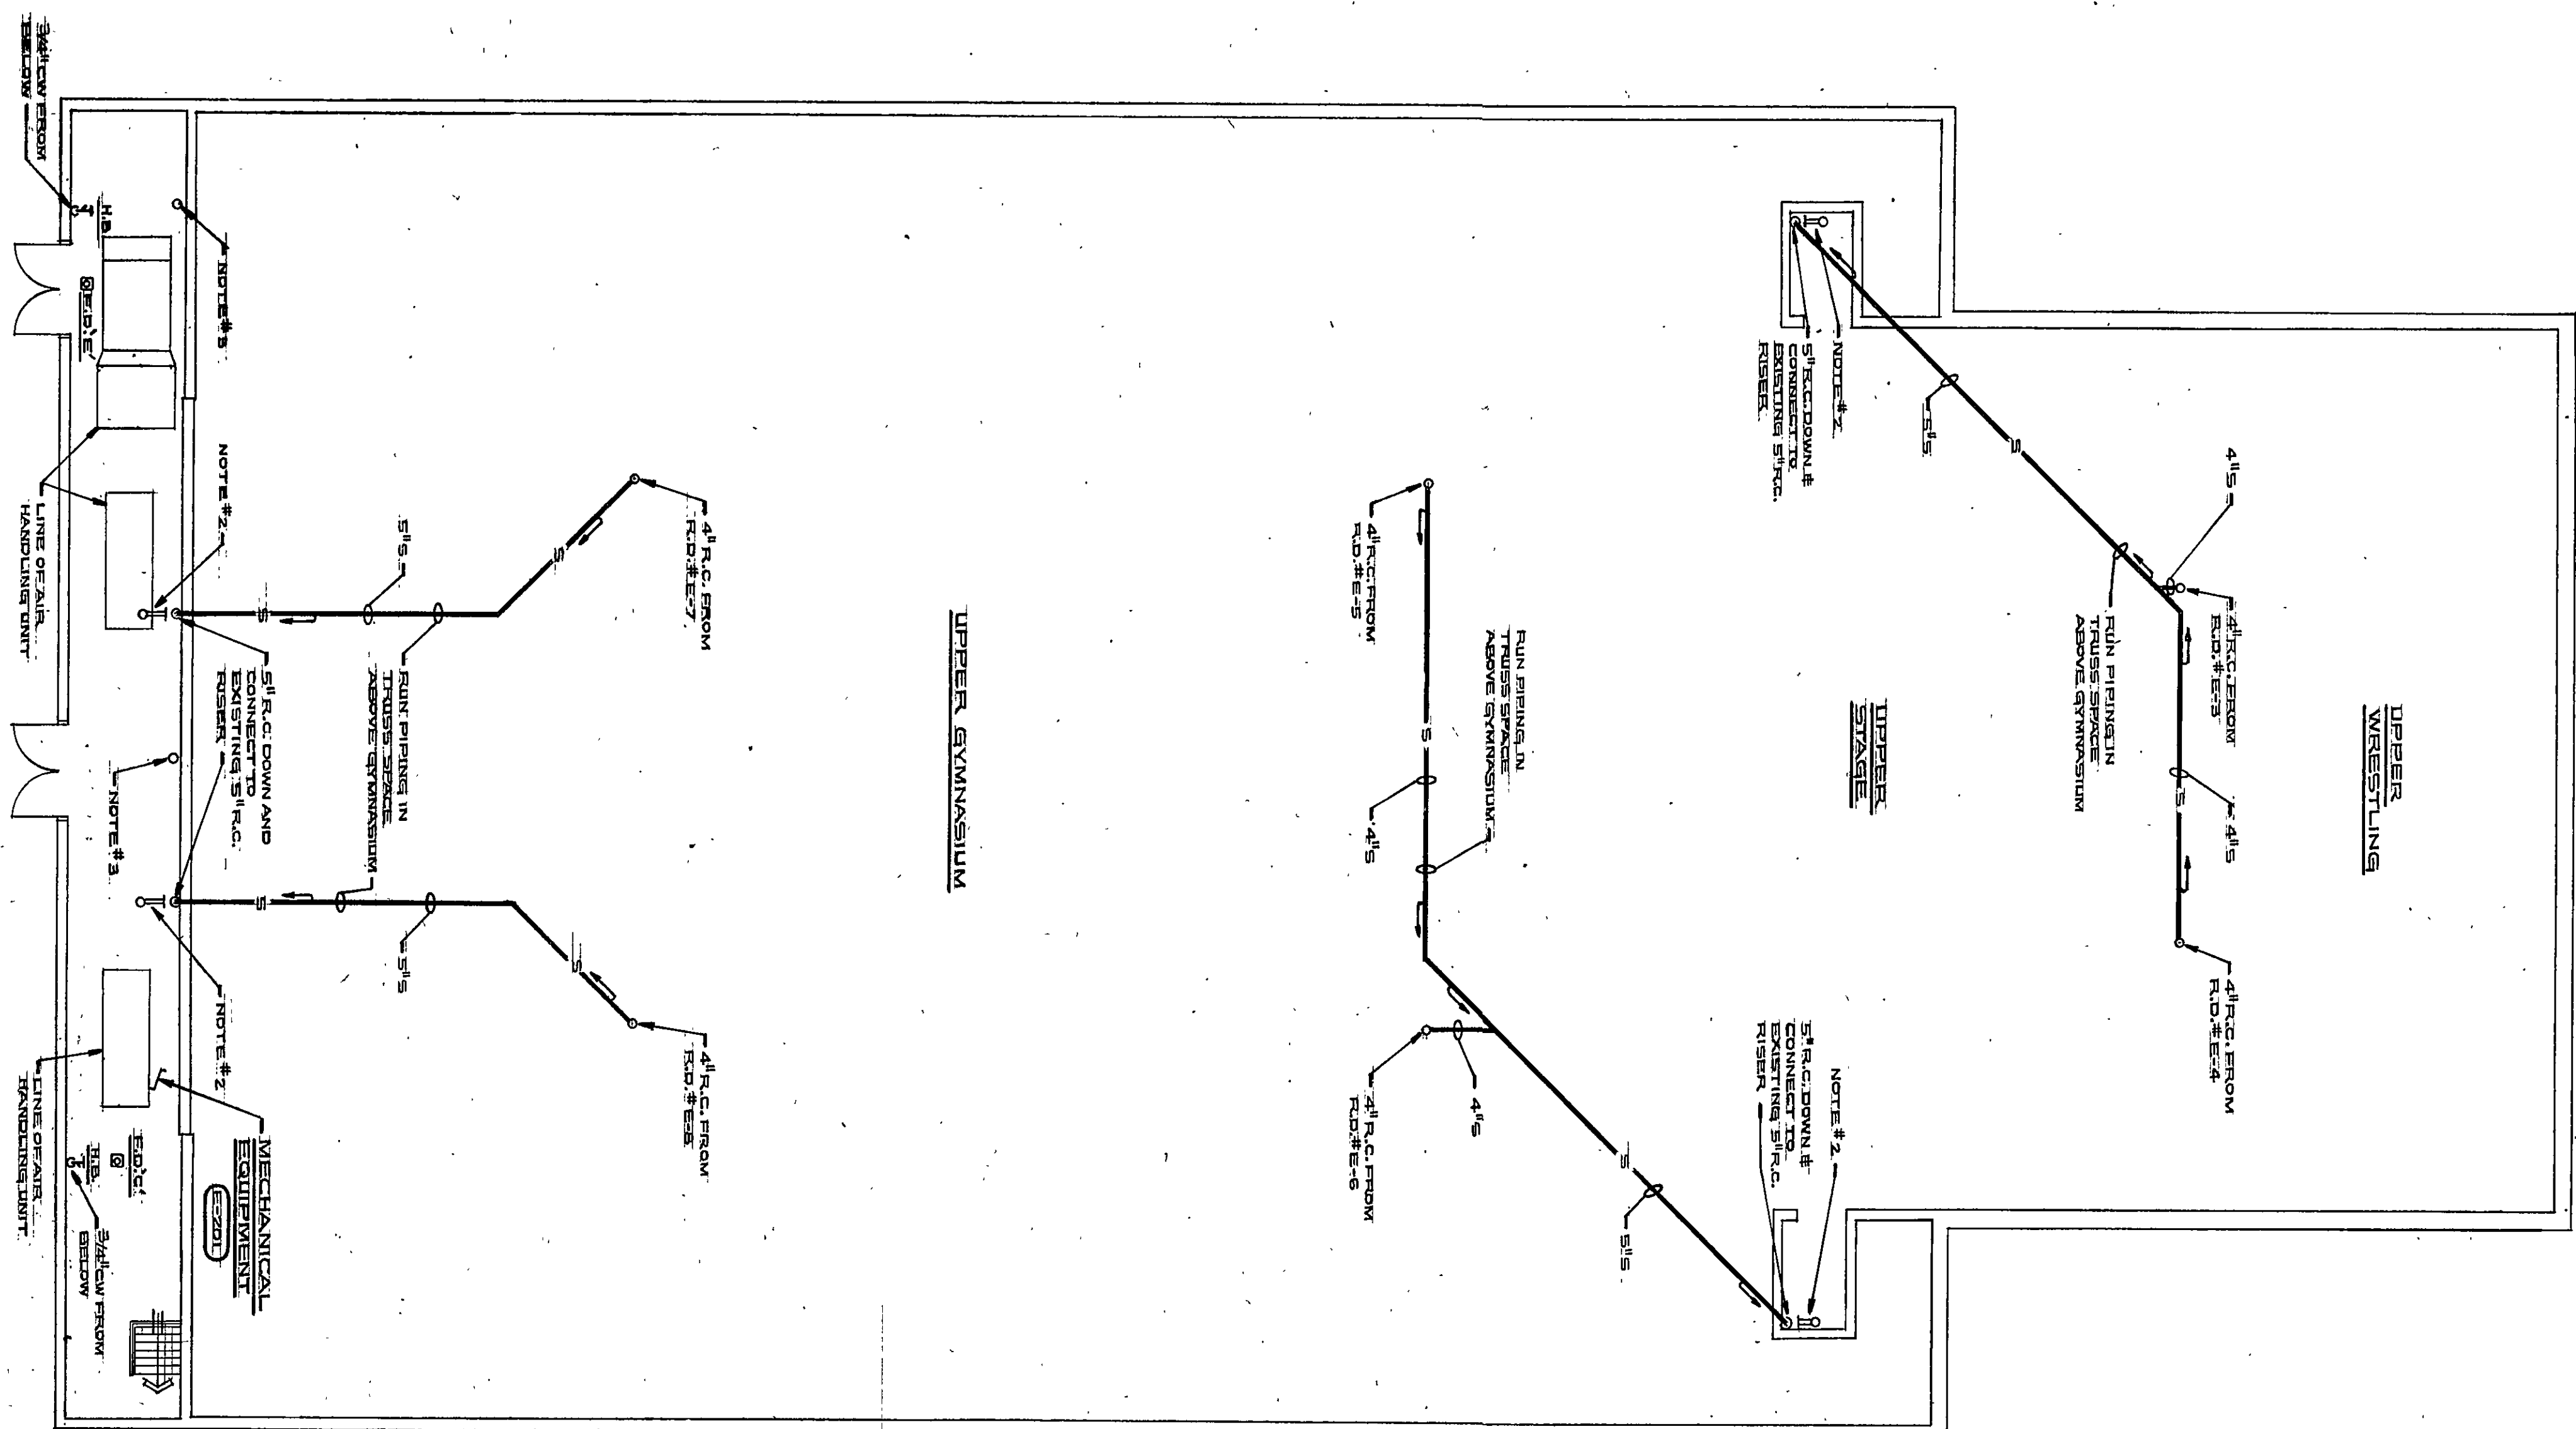

UNIT "E" PLUMBING UPPER LEVEL PLAN
SCALE: 1/8" = 1'-0"

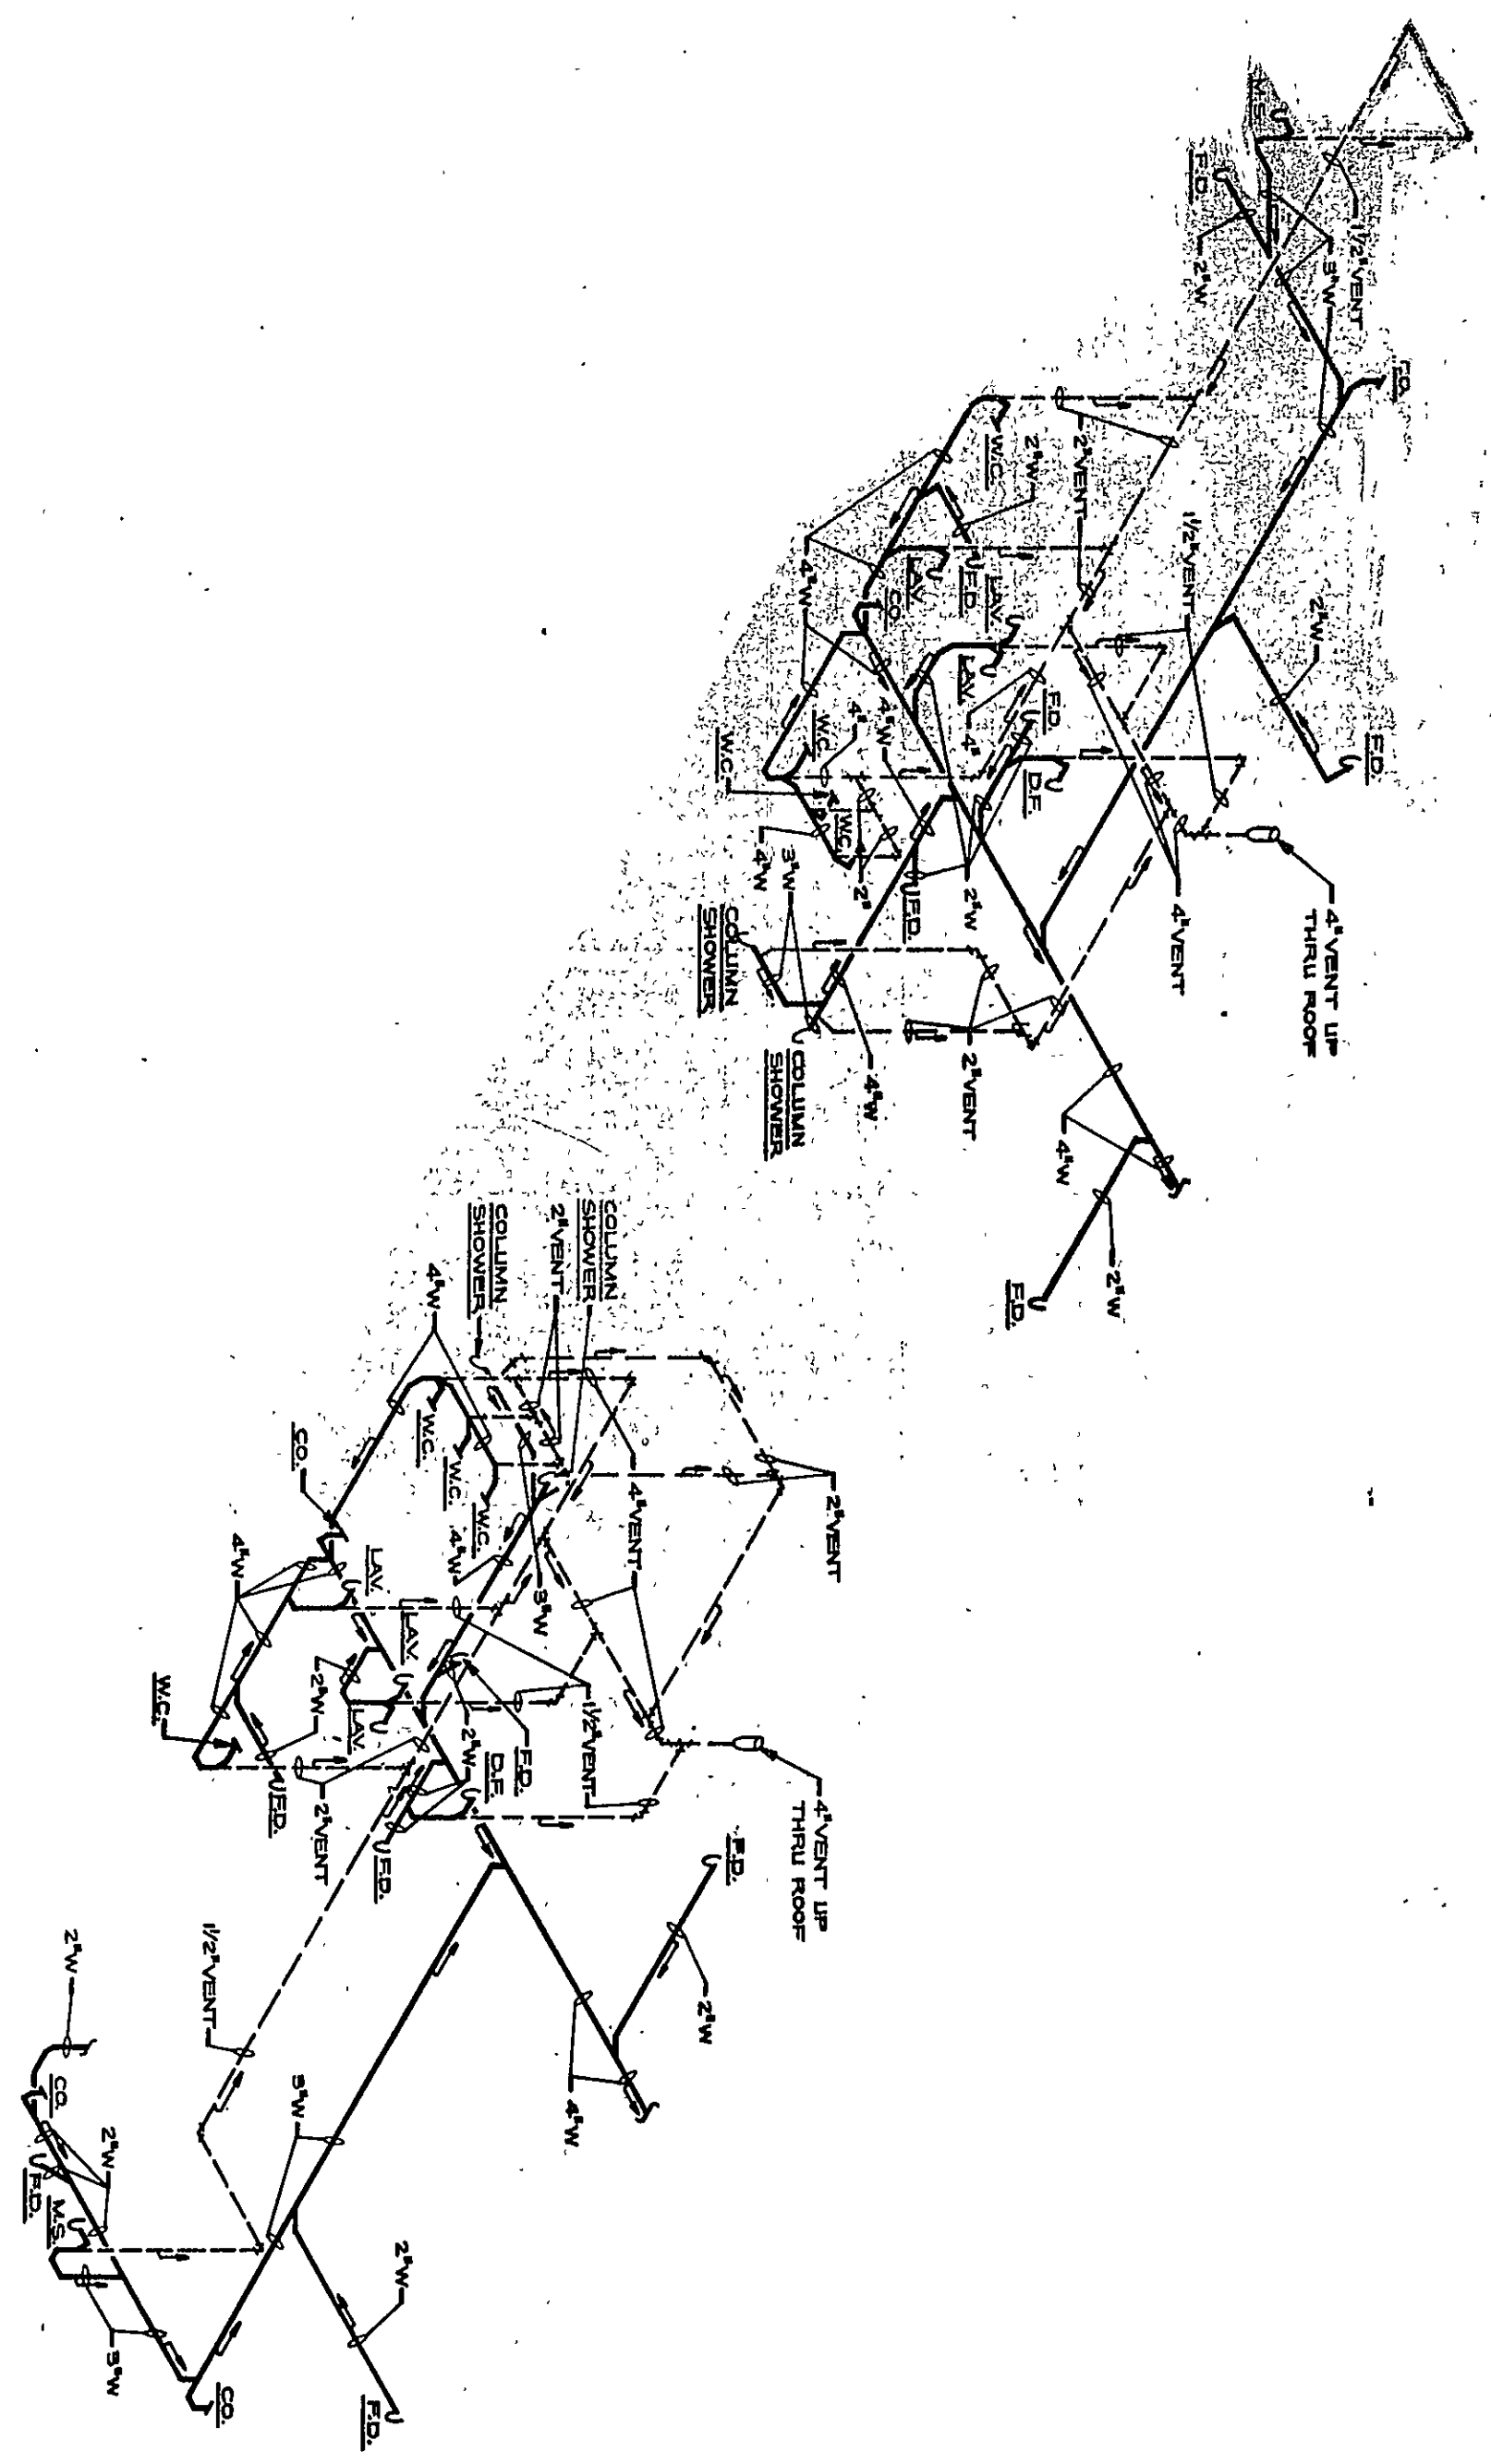

WASTE AND VENT PIPING ISOMETRIC FOR UNIT "E" FIRST FLOOR LOCKER AREA
NO SCALE

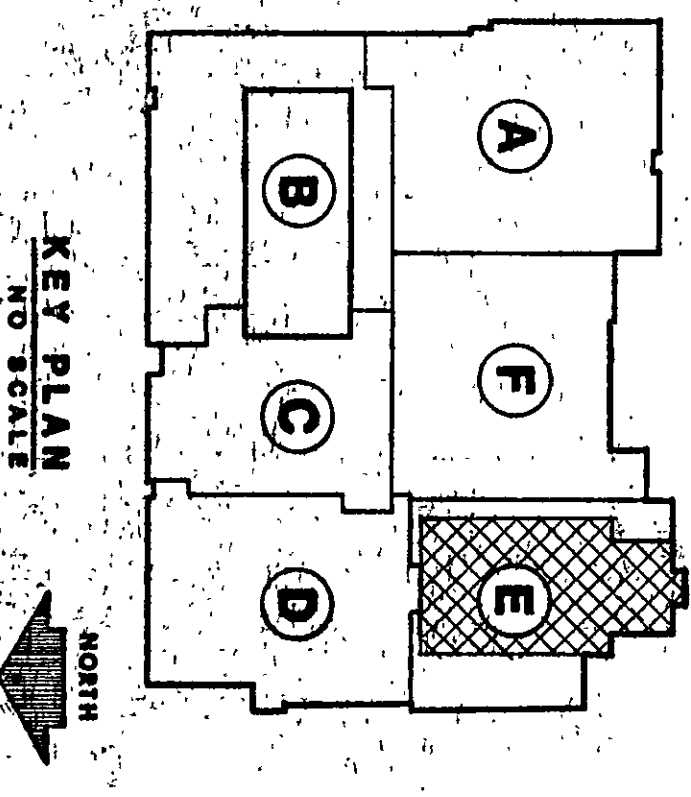

KEY PLAN
NO SCALE

- PLAN NOTES
1. SEE SHEET M-3 FOR GENERAL MECHANICAL NOTES, LEGEND AND SCHEDULES.
 2. CUT EXISTING ROOF CONDUCTOR AND REMOVE EXISTING ROOF DRAIN AS SHOWN.
 3. EXTEND EXISTING PLUMBING VENT UP THRU NEW ROOF.

AS-BUILT
25 SEP 1984

NO. M-29
OF 36

PROJECT
12579.00
DATE
MAY 3, 1982
REVISED

James A. Partidge

EVERETT · I · BROWN COMPANY
5500 WEST BRADBURY AVENUE · PARK FLETCHER · INDIANAPOLIS, INDIANA • 46241

ARCHITECTS
ENGINEERS

ADDITION TO AND RENOVATION OF LIBERTY MIDDLE SCHOOL