

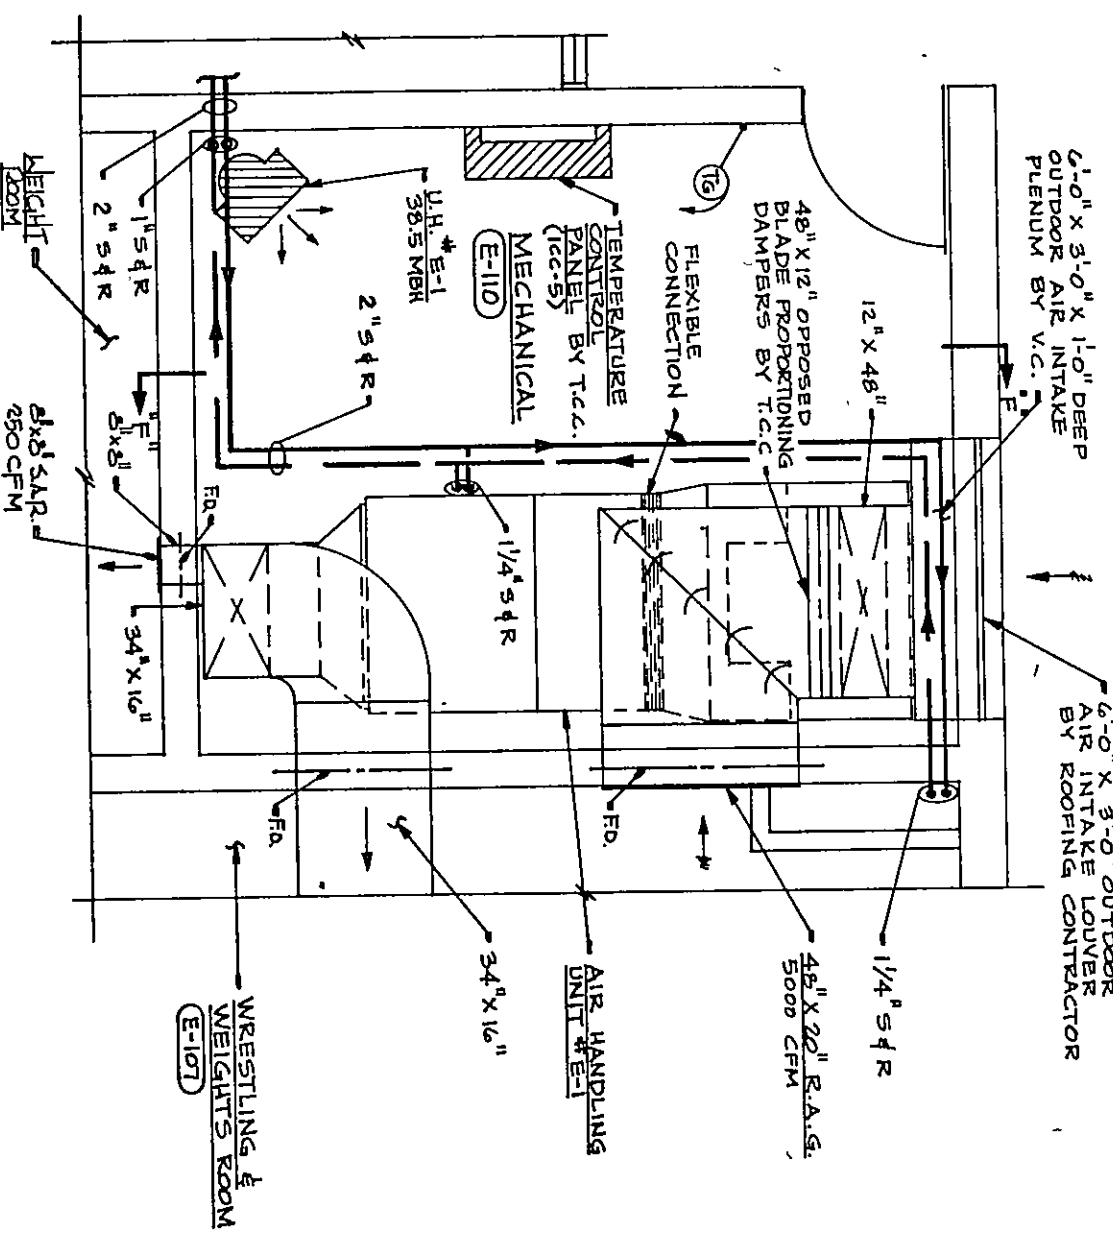
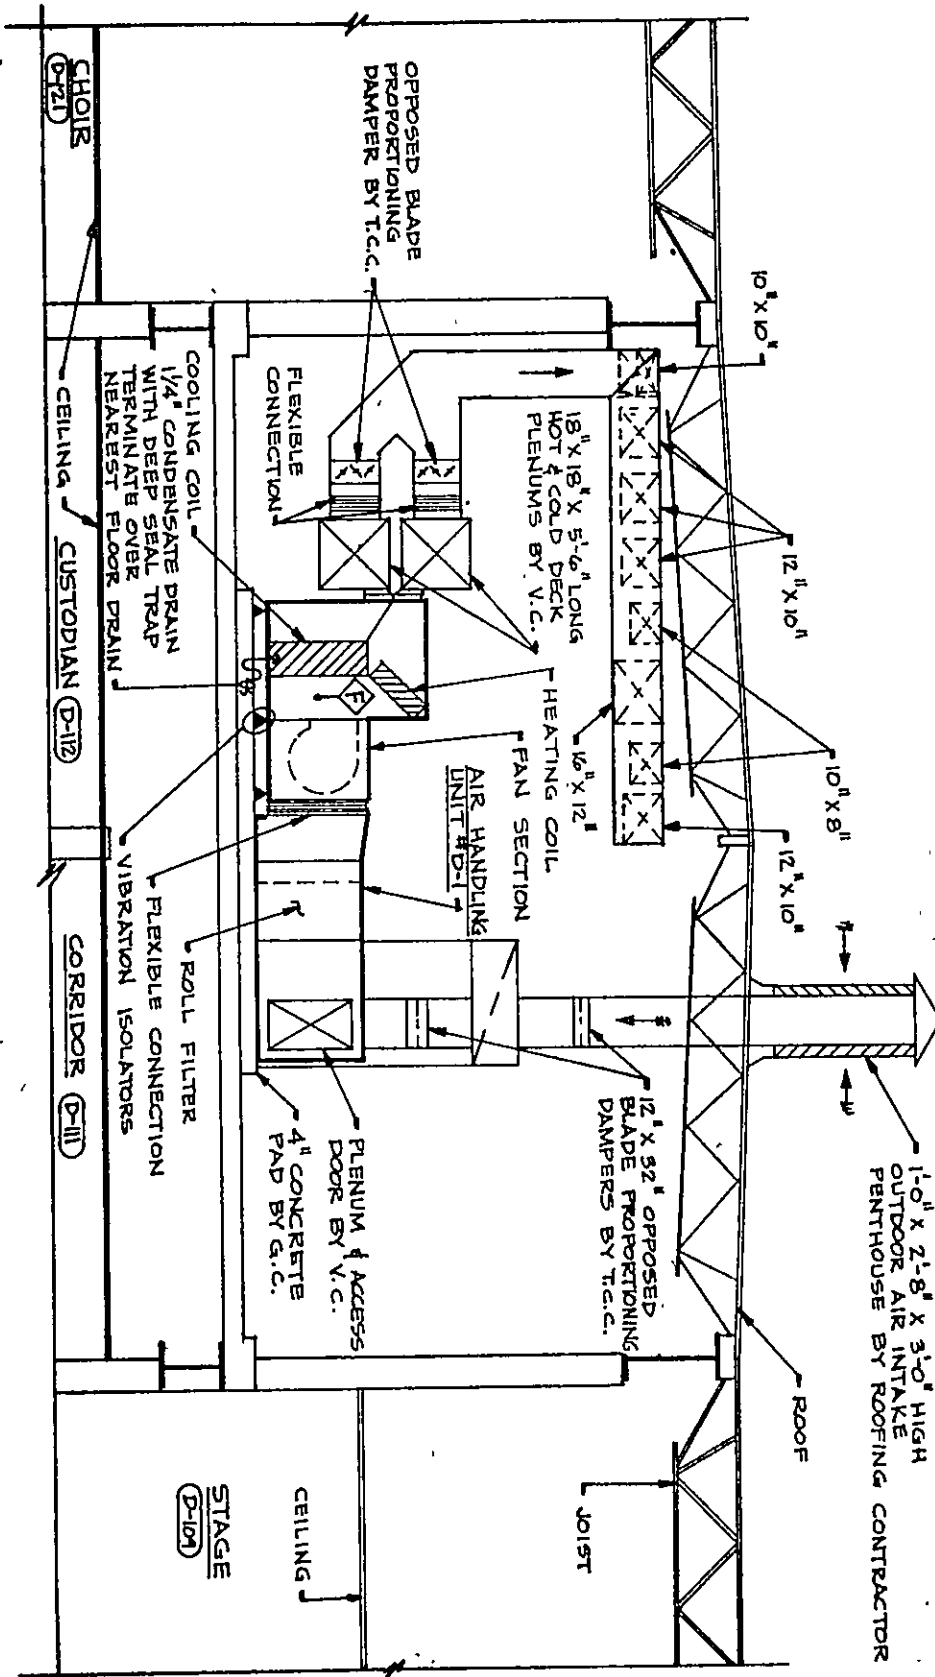


1. SEE SHEET M-16 FOR GENERAL NOTES, LEGEND AND SCHEDULES.
2. 48" X 48" OPENING IN ROOF CONSTRUCTION BY GENERAL CONTRACTOR. PROVIDE 48" RELIEF VENT. CURB BY GENERAL CONTRACTOR.

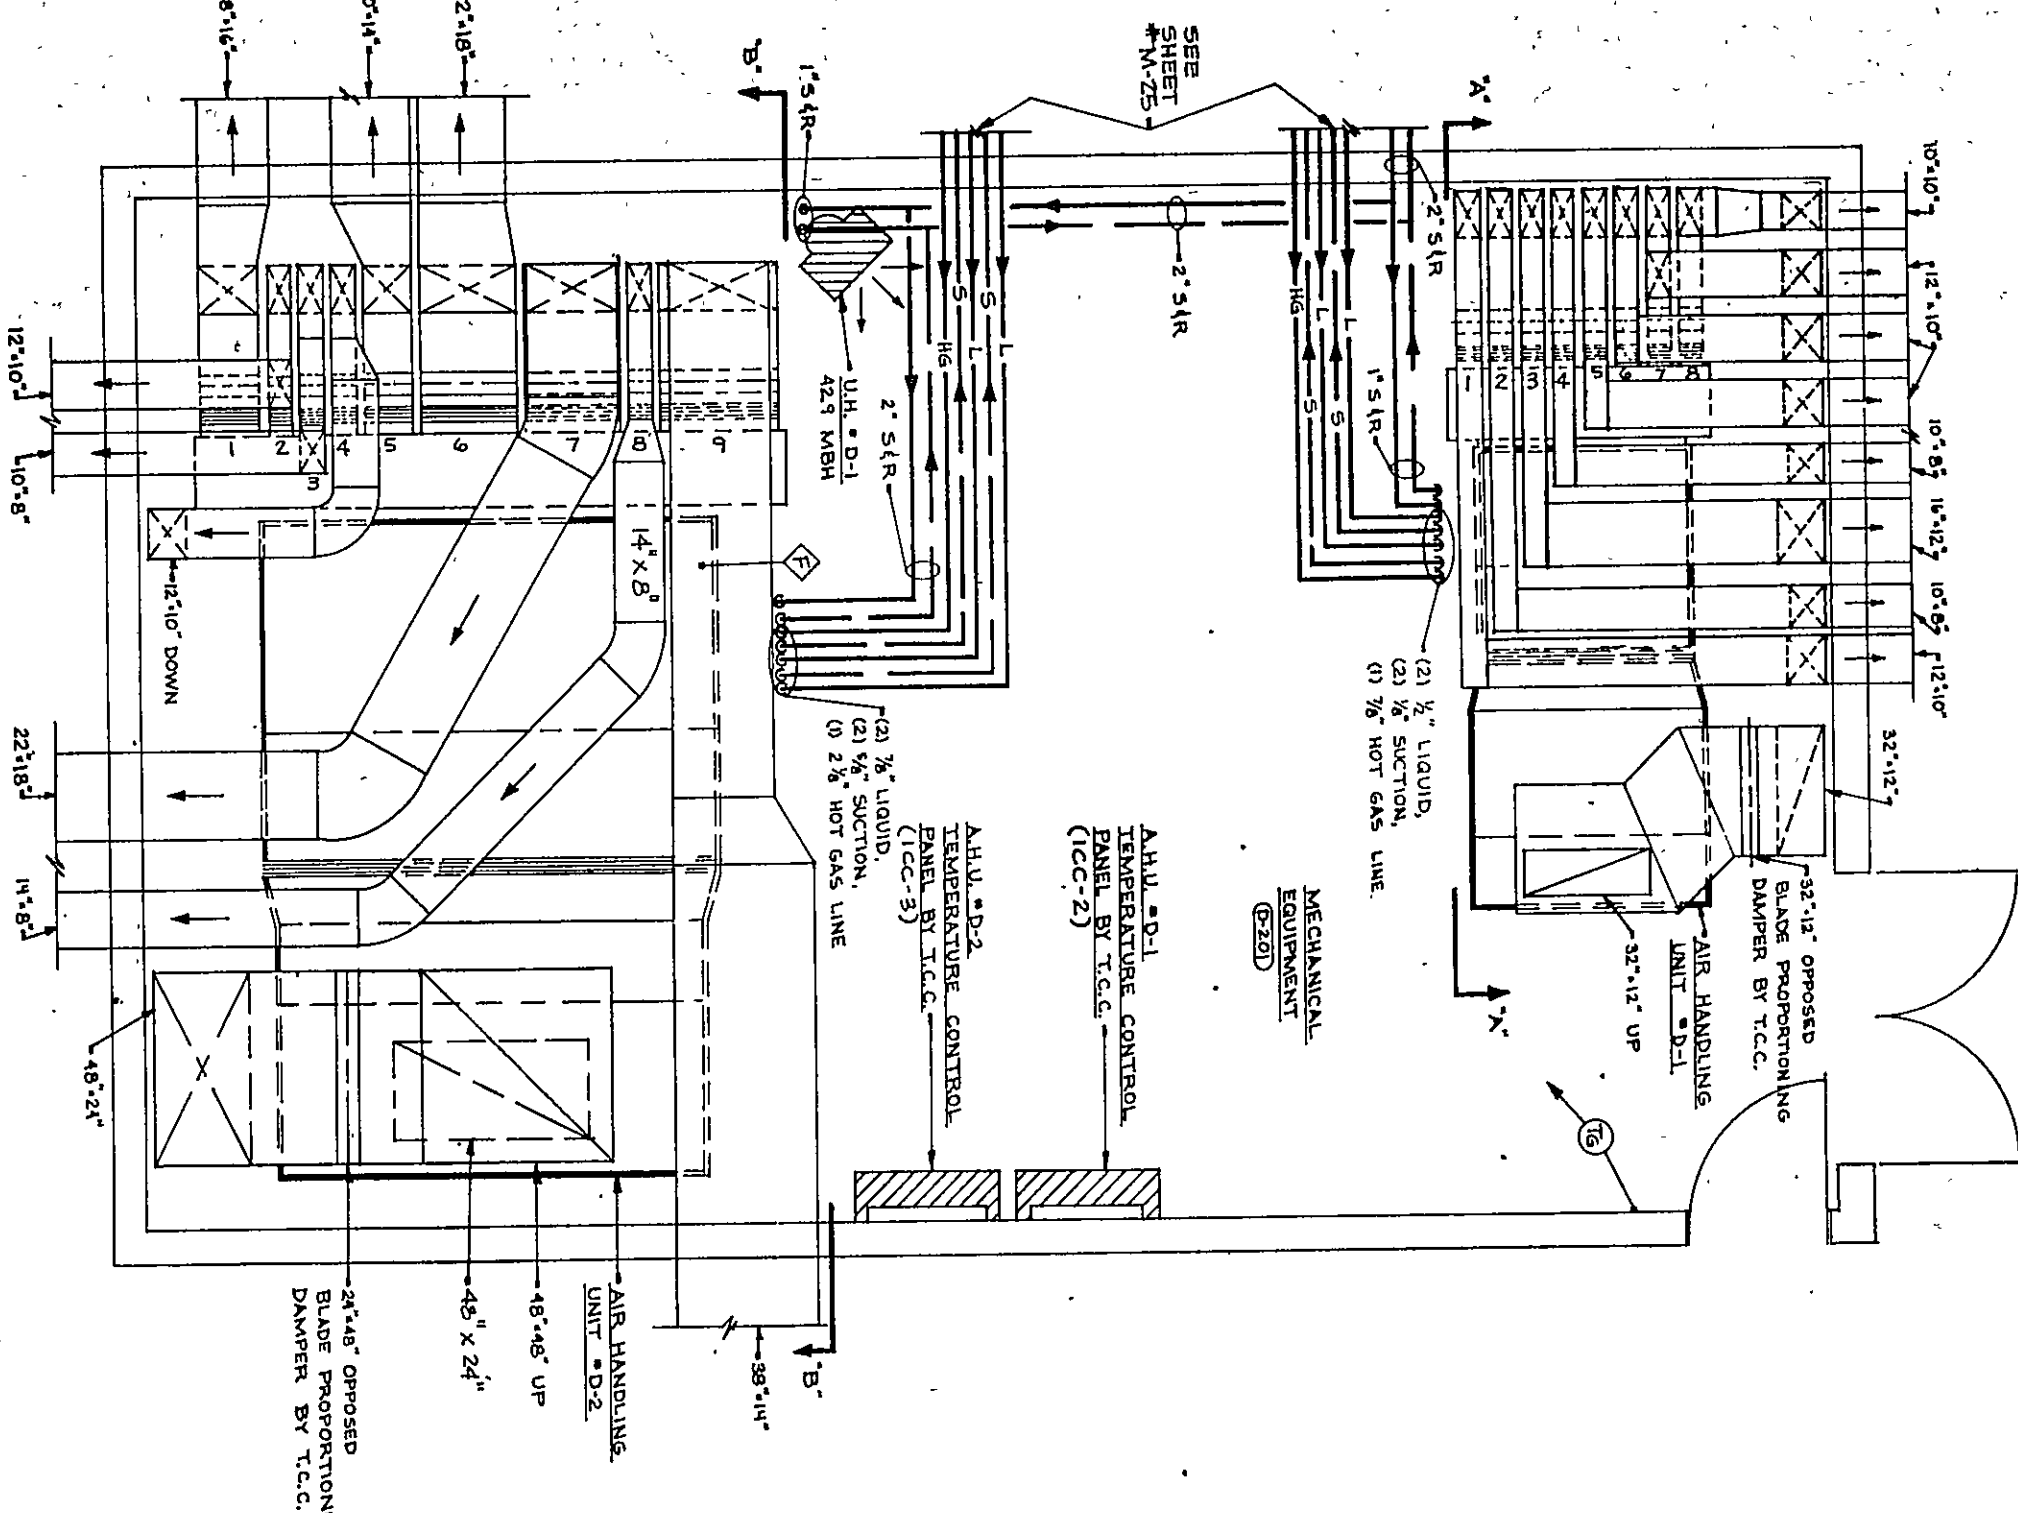


SECTION "F-F"

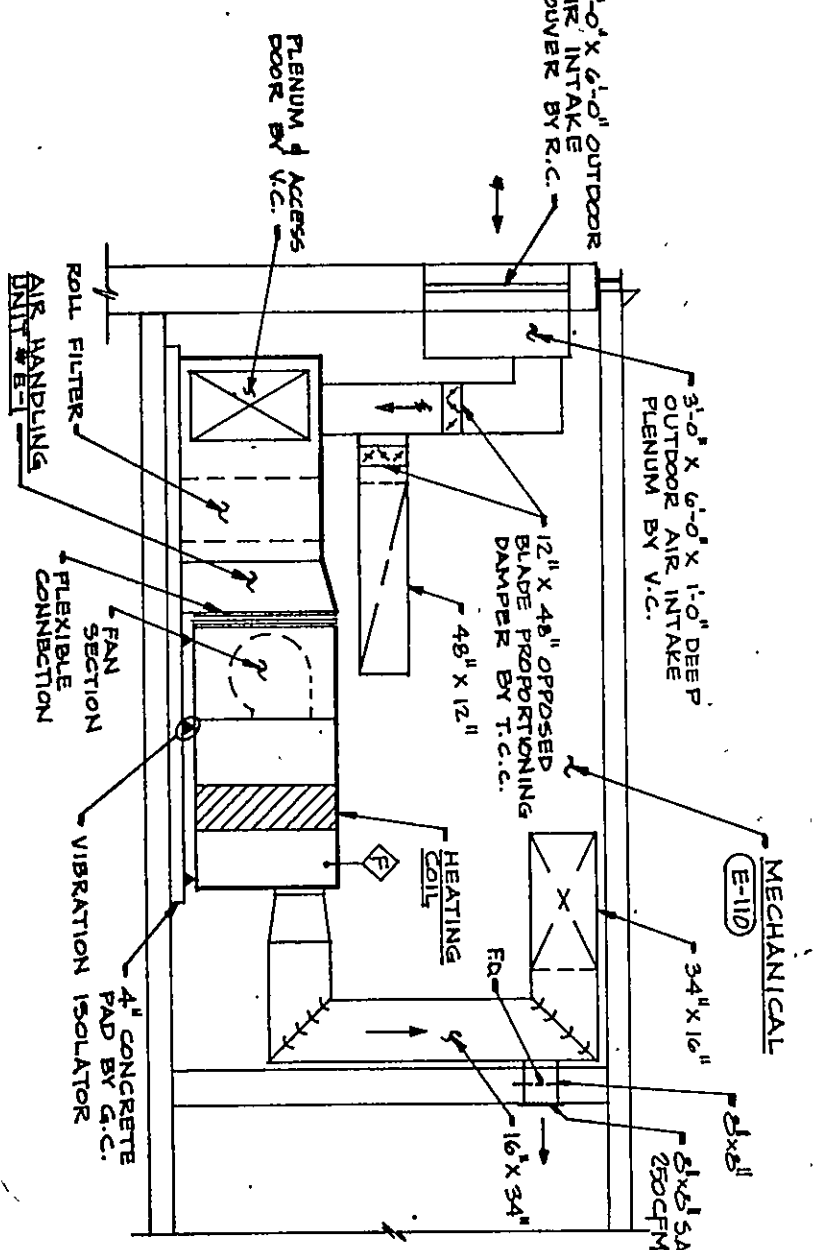

MECHANICAL ROOM D - 201


NO SCALE

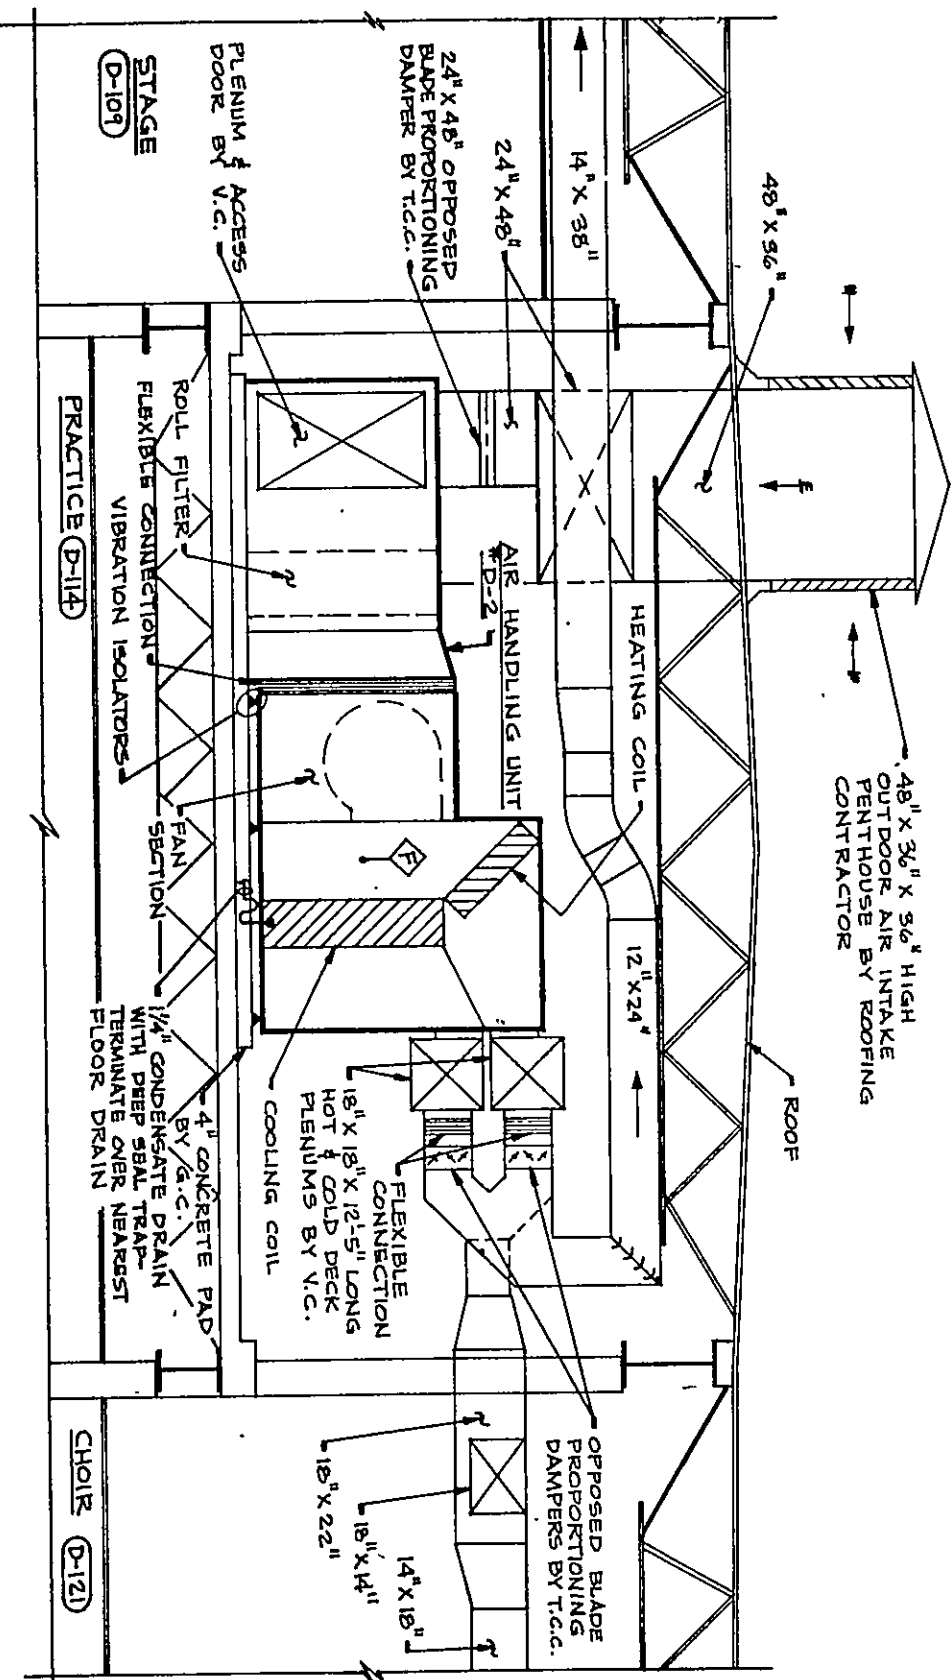



SECTION "B-B"

MECHANICAL ROOM F - 105

NO SCALE



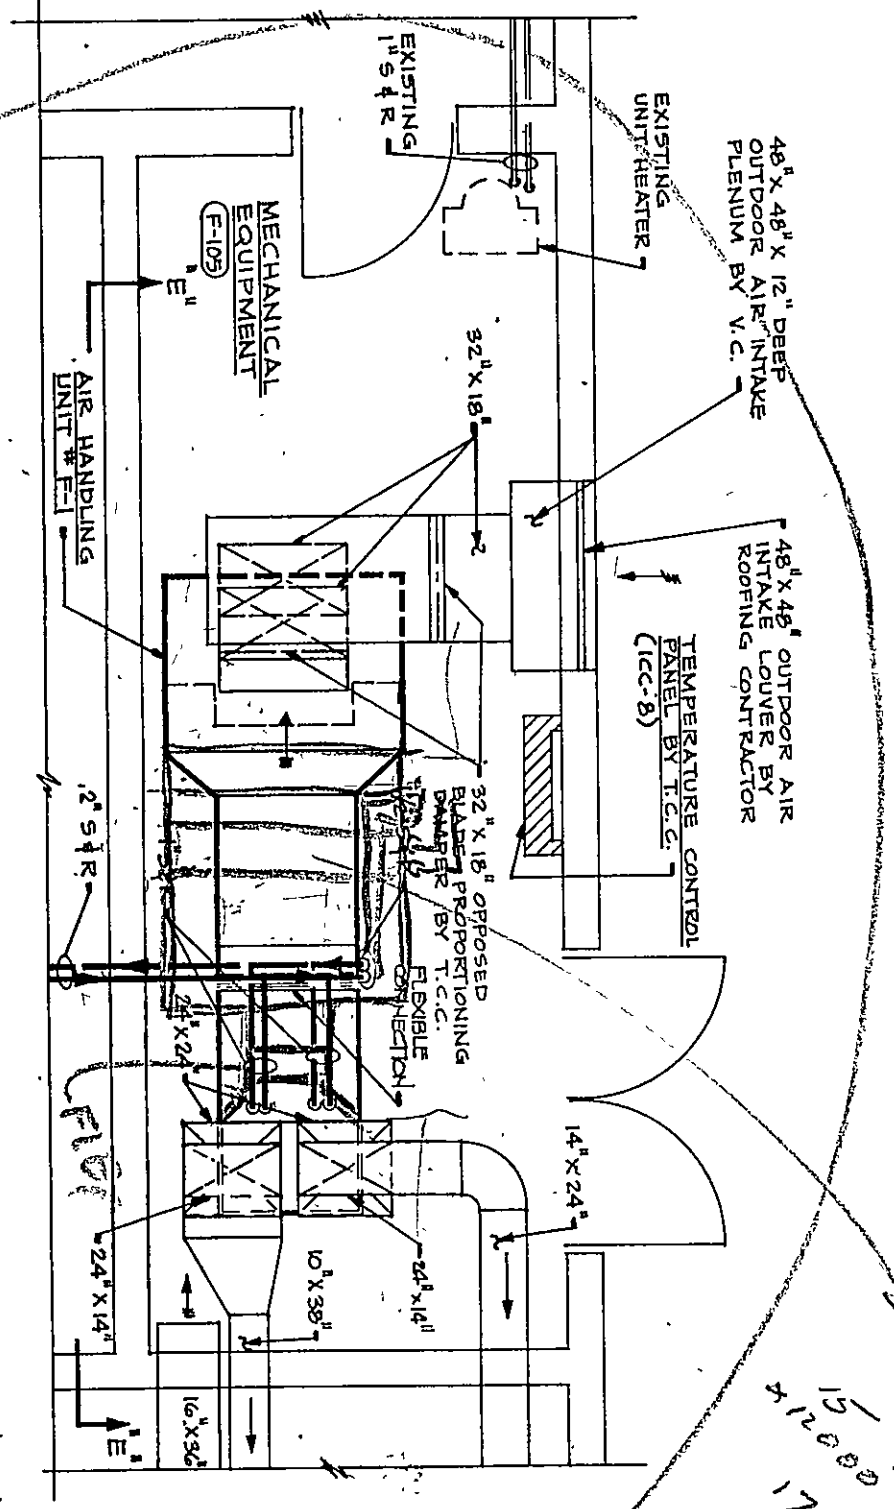


SECTION "E-E"

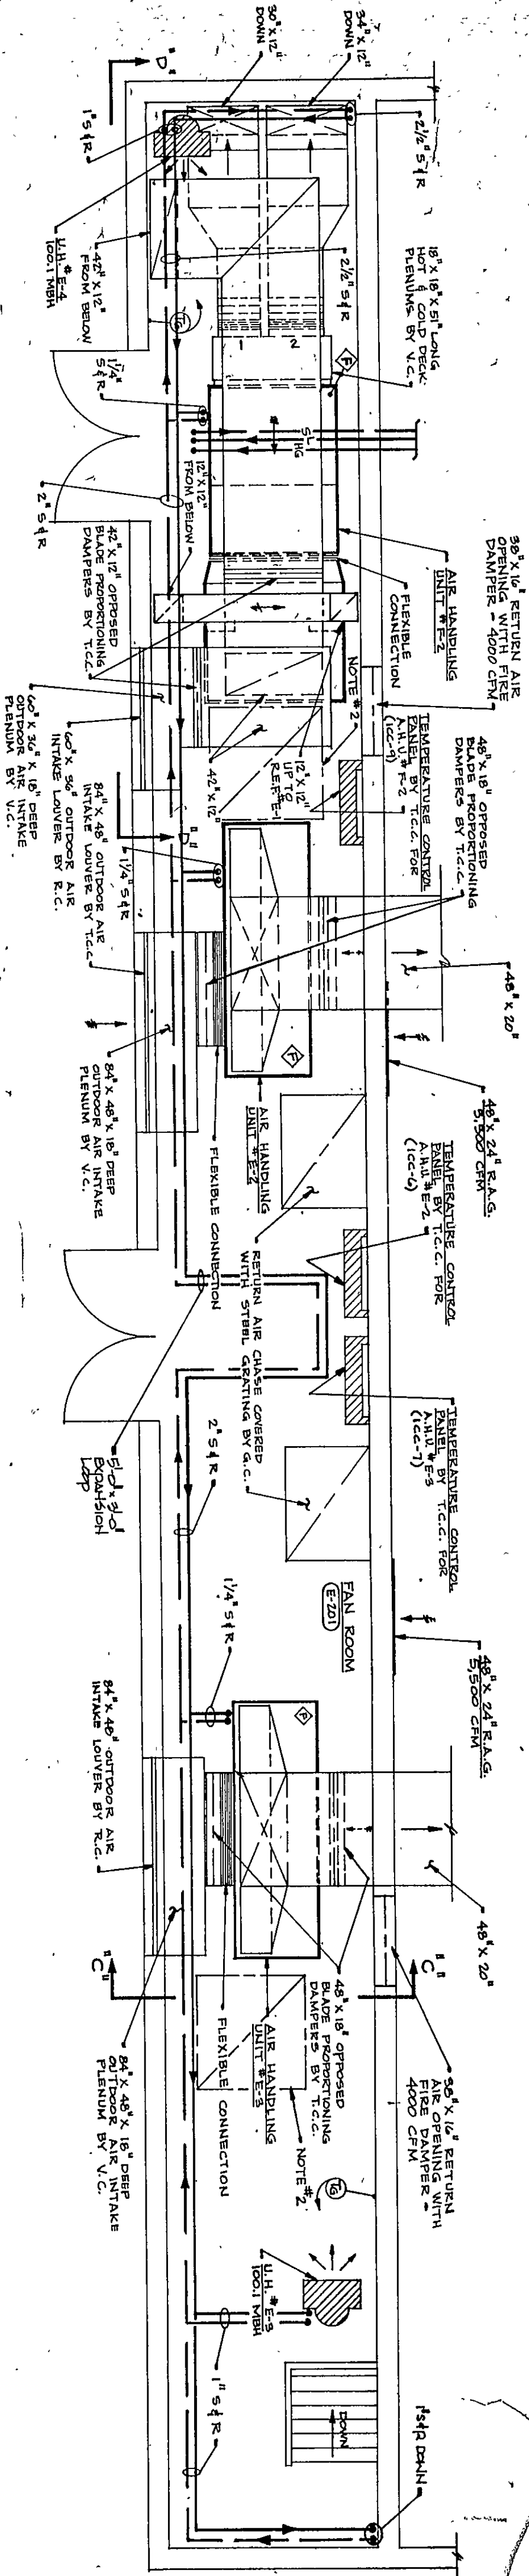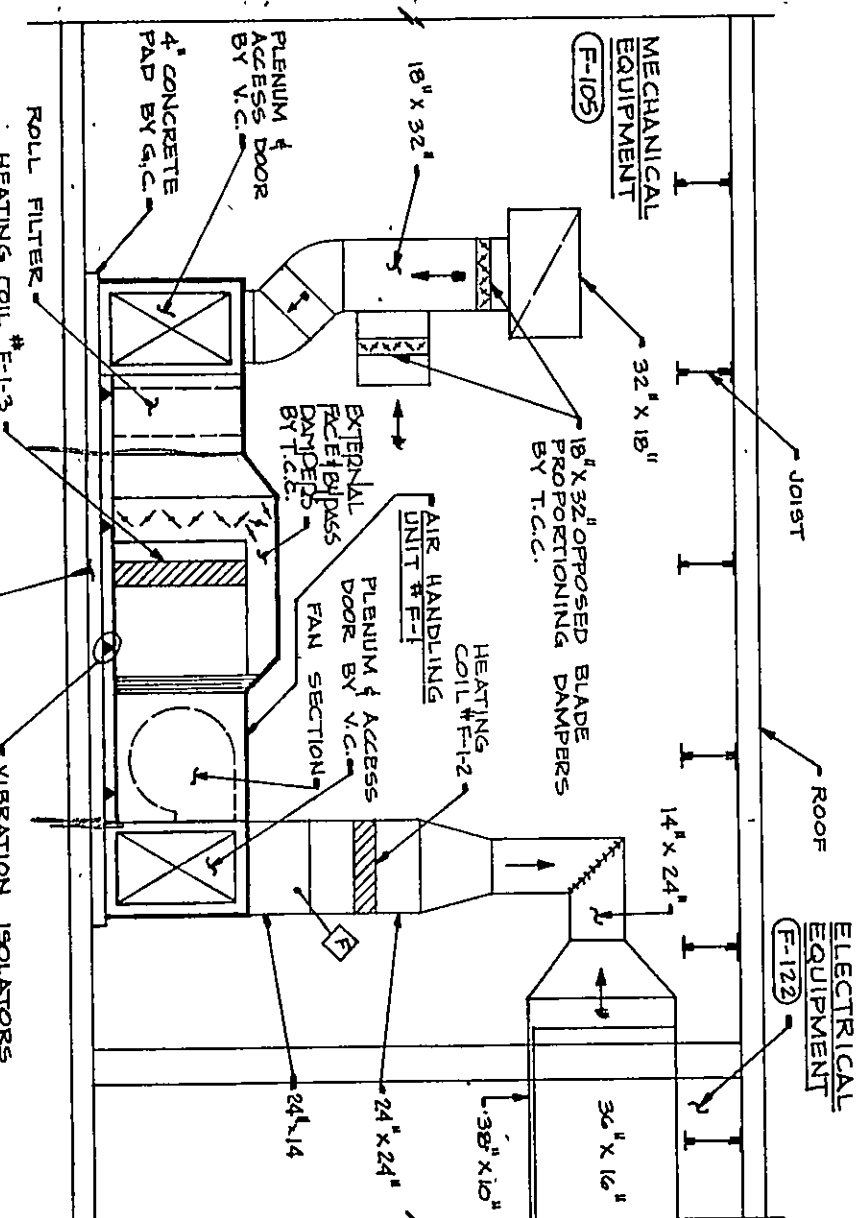


MECHANICAL ROOM E - 201

NO SCALE

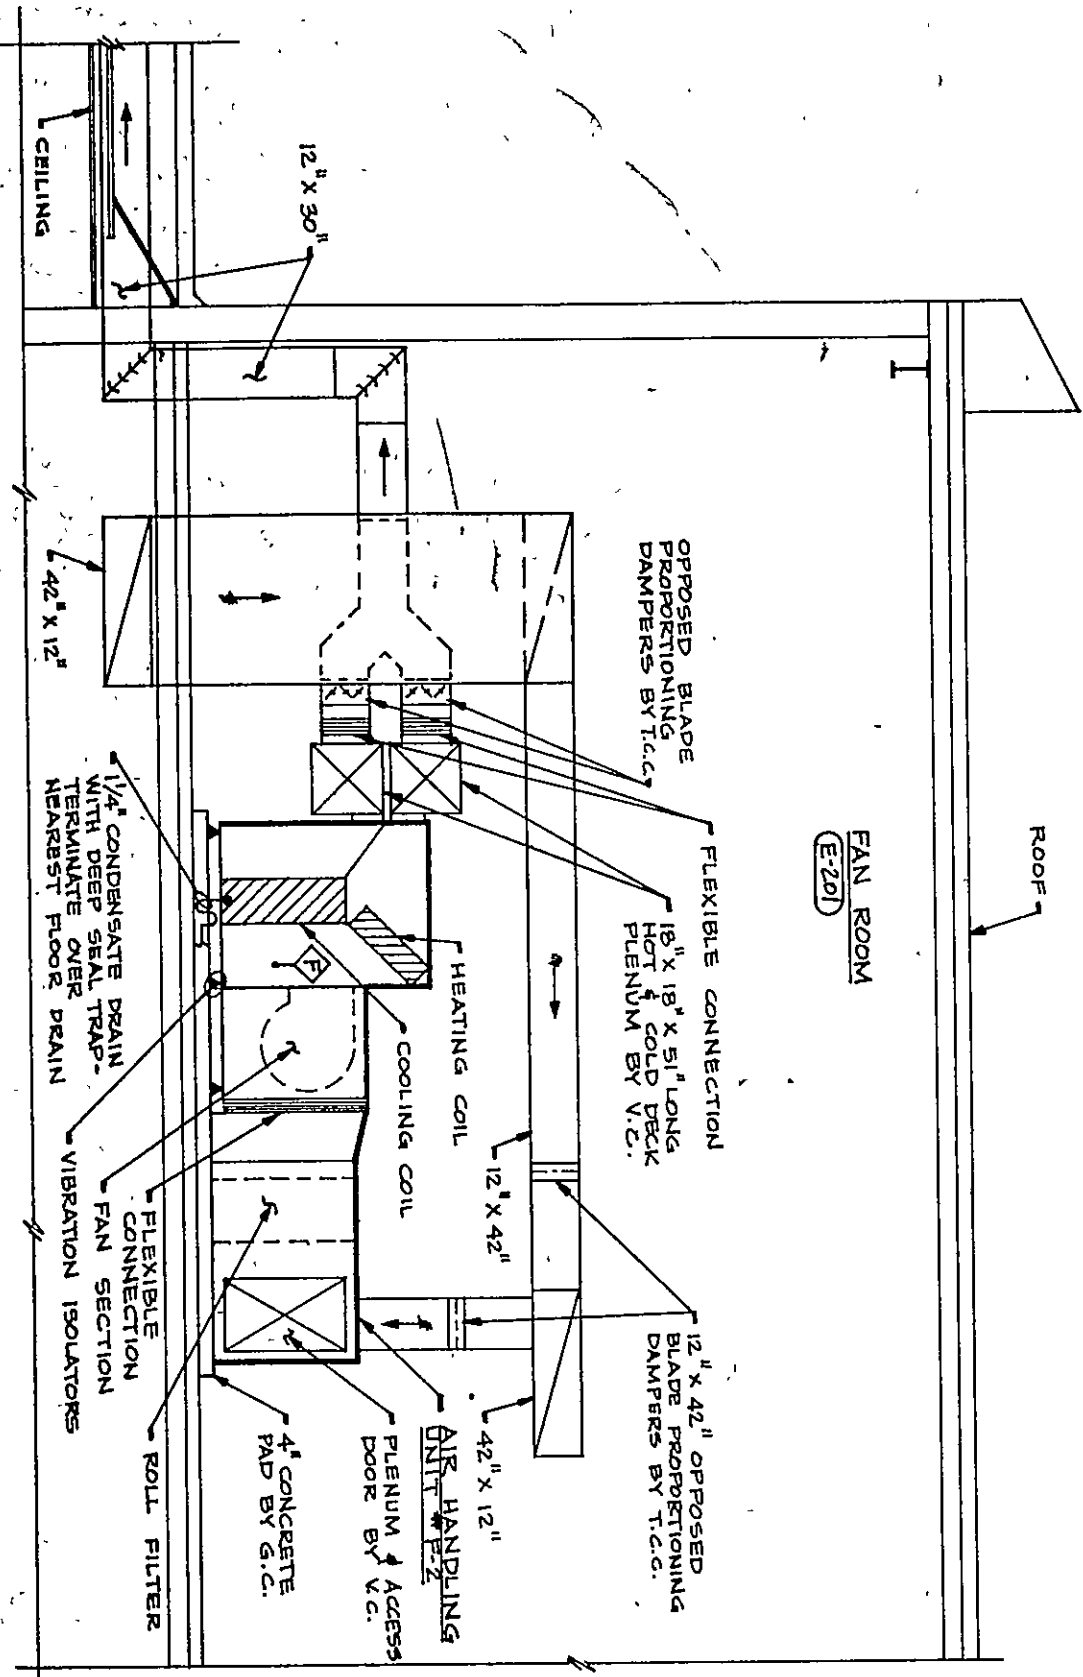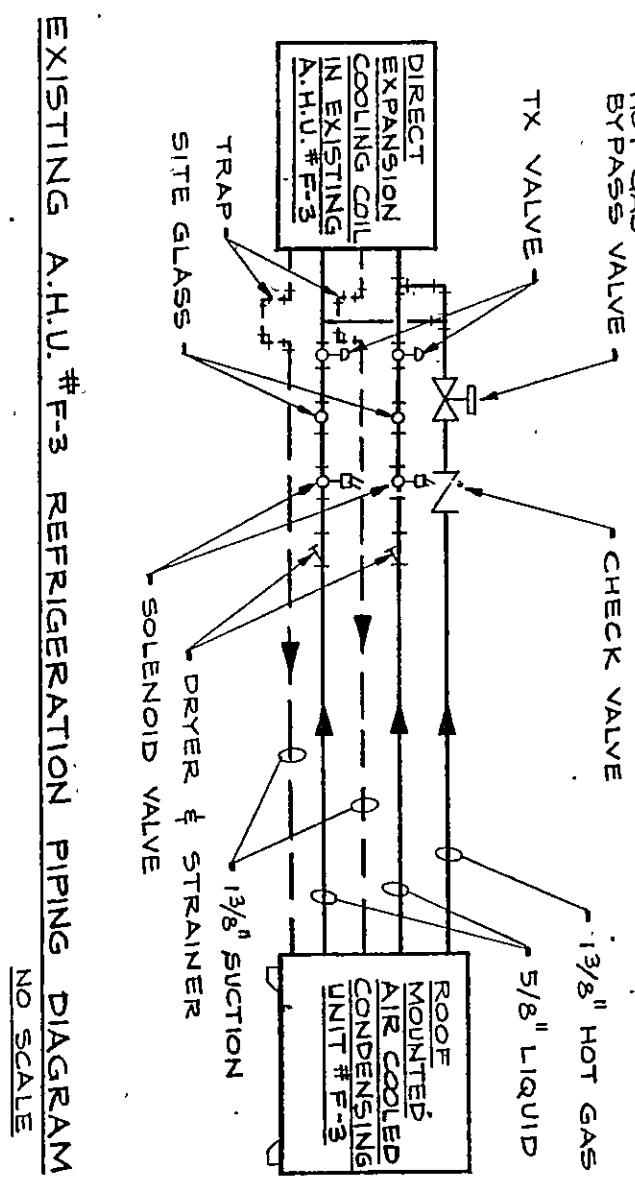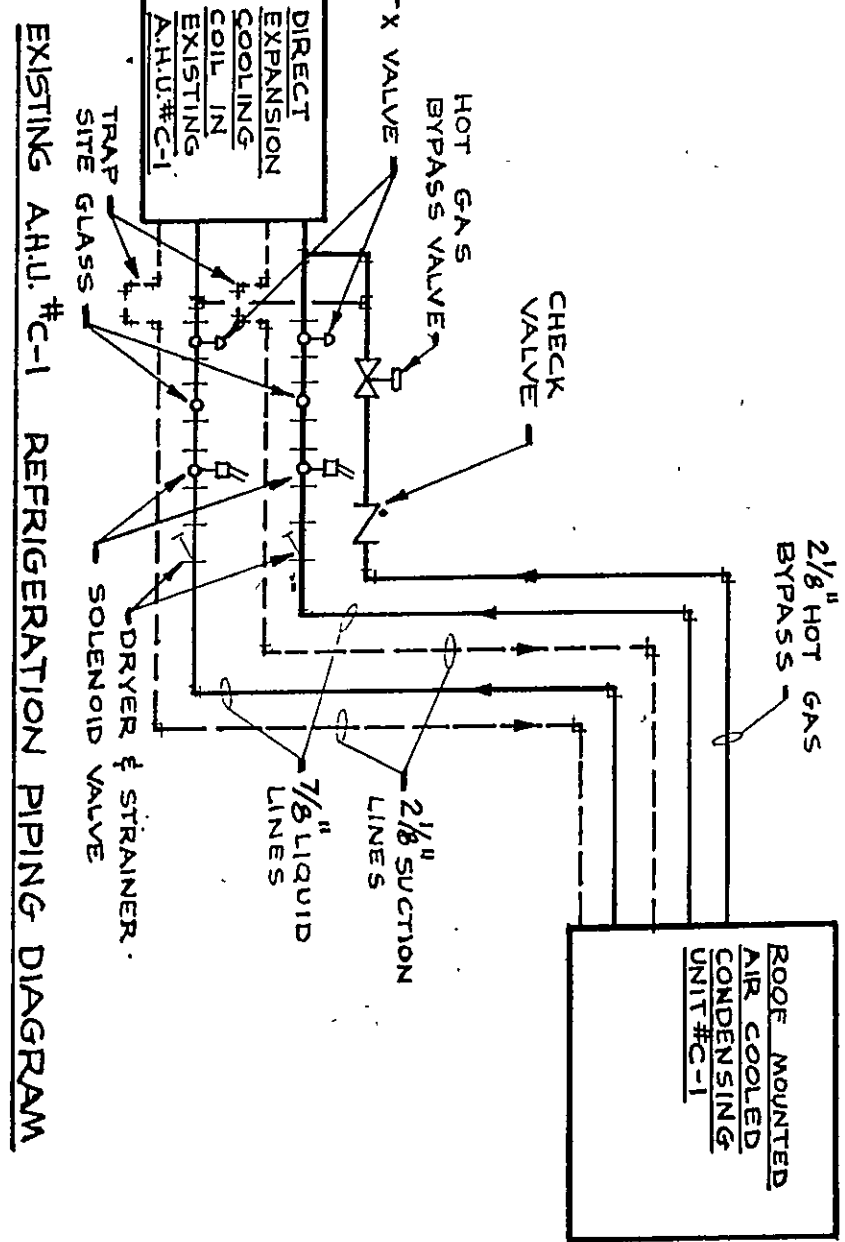

SECTION "D-D"

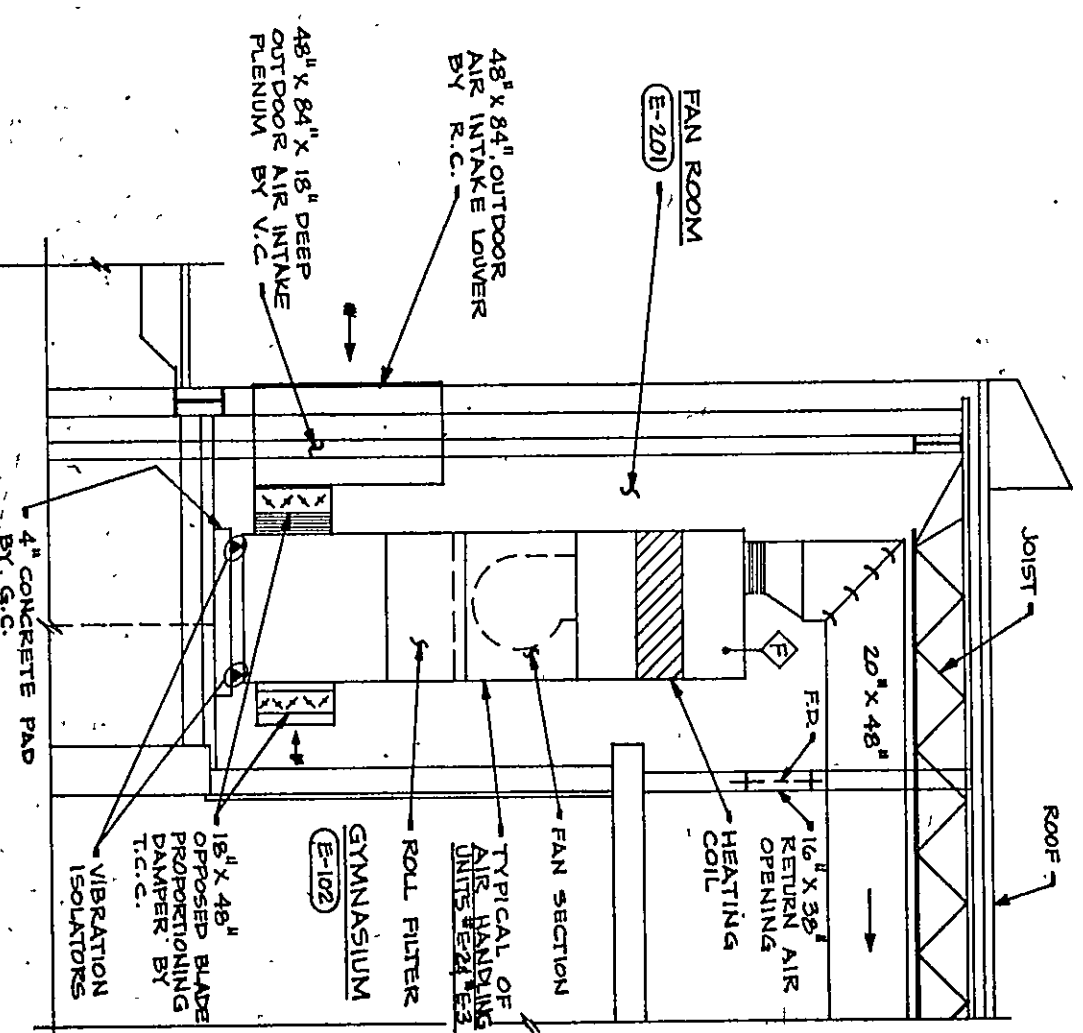

SECTION "C-C"

AS-BUILT
23 SEPT. 1984

KEY PLAN
NO SCALE

North

62-M-21

PROJECT
12579.00
DATE
MAY 3, 1982
REVISED

NO. M-34
OF 36

James A. Rutledge

EVERETT · I · BROWN COMPANY
5500 WEST BRADBURY AVENUE · PARK FLETCHER ·

ADDITION TO AND RENOVATION OF LIBERTY MIDDLE SCHOOL

ARCHITECTS
ENGINEERS
INDIANAPOLIS, INDIANA • 46241