



TYPICAL UNIT VENTILATOR
COLL HIM & CUI PIPING DETAIL
NTS

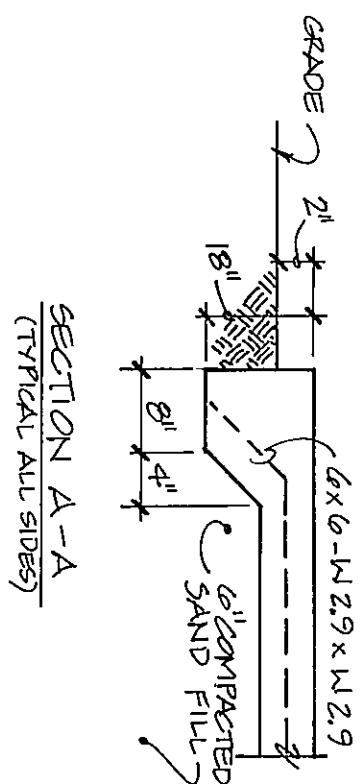


NOTE:
CONCRETE PAD
BY MC

ACC UNIT CONCRETE BASE DETAIL
N.T.S.


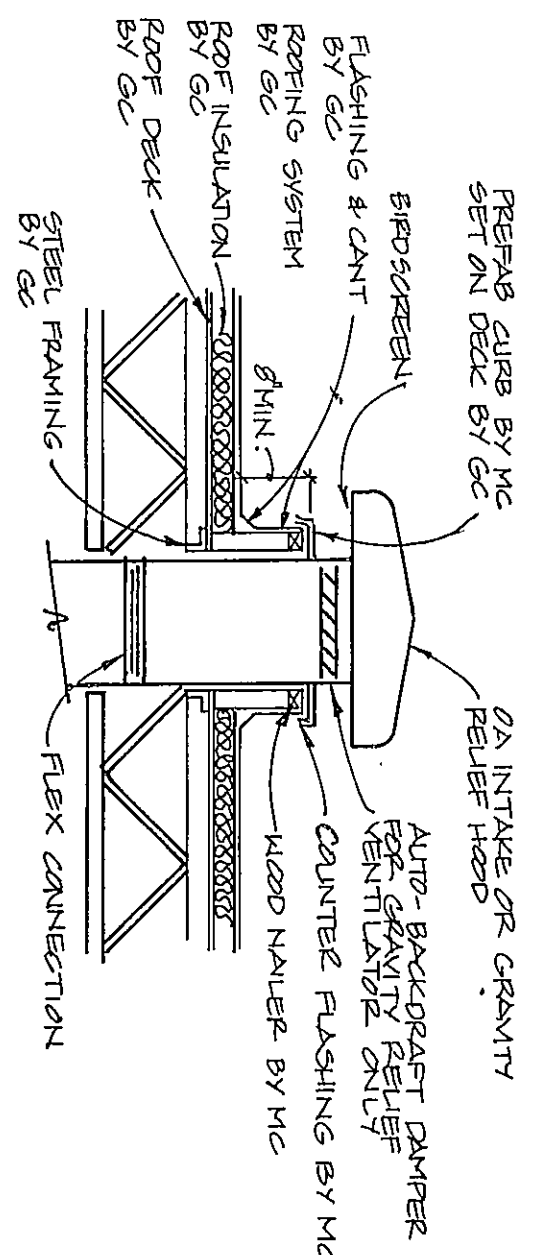


TYPICAL ROOF OA INTAKE OR GRAVITY
RELIEF VENTILATOR DETAIL
N.T.S.

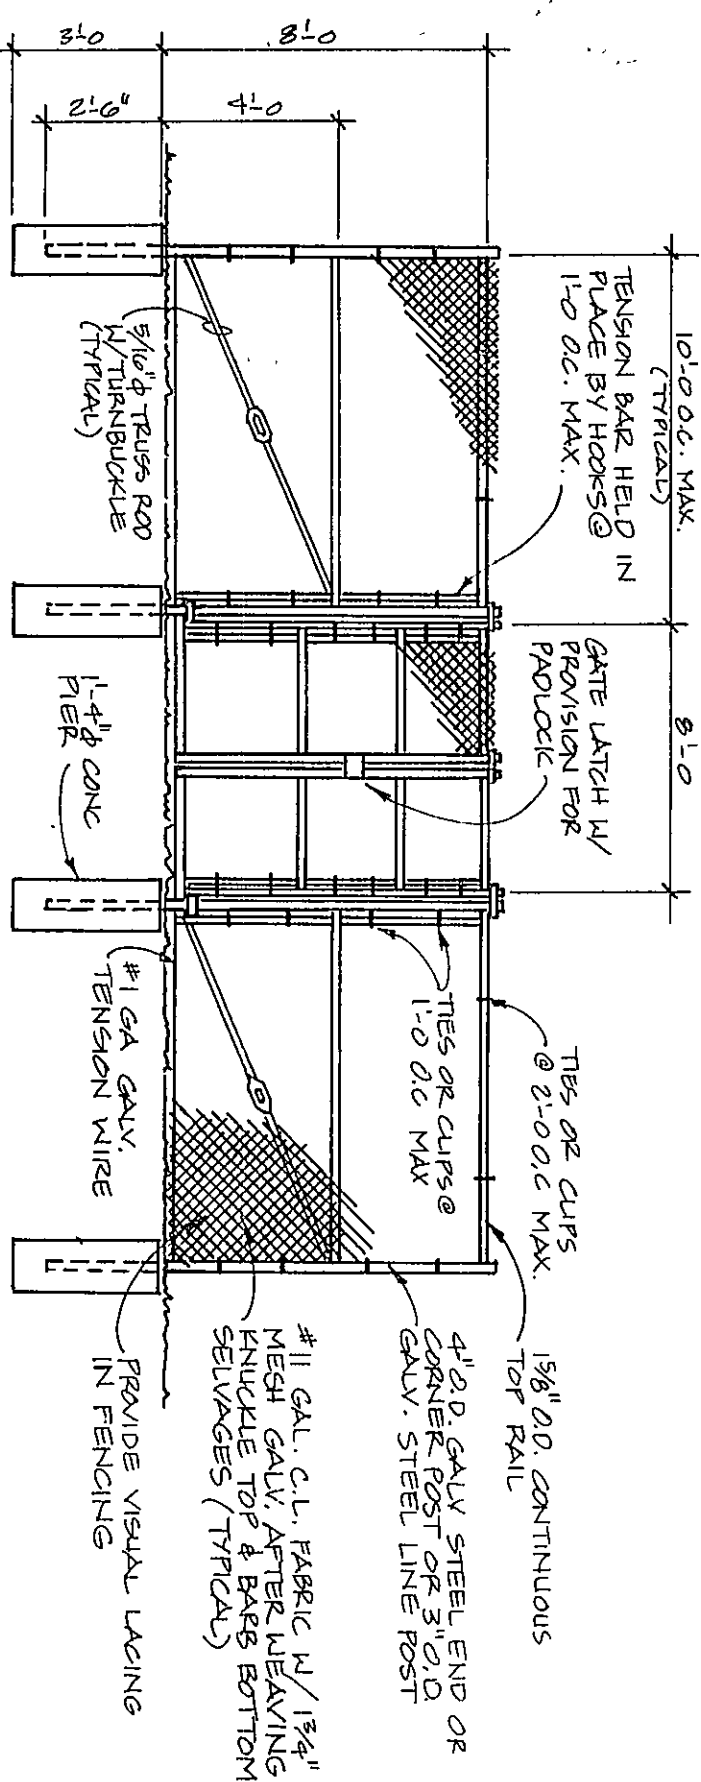


FENCE DETAIL
N.T.S.

NOTE:
FENCE BY MC

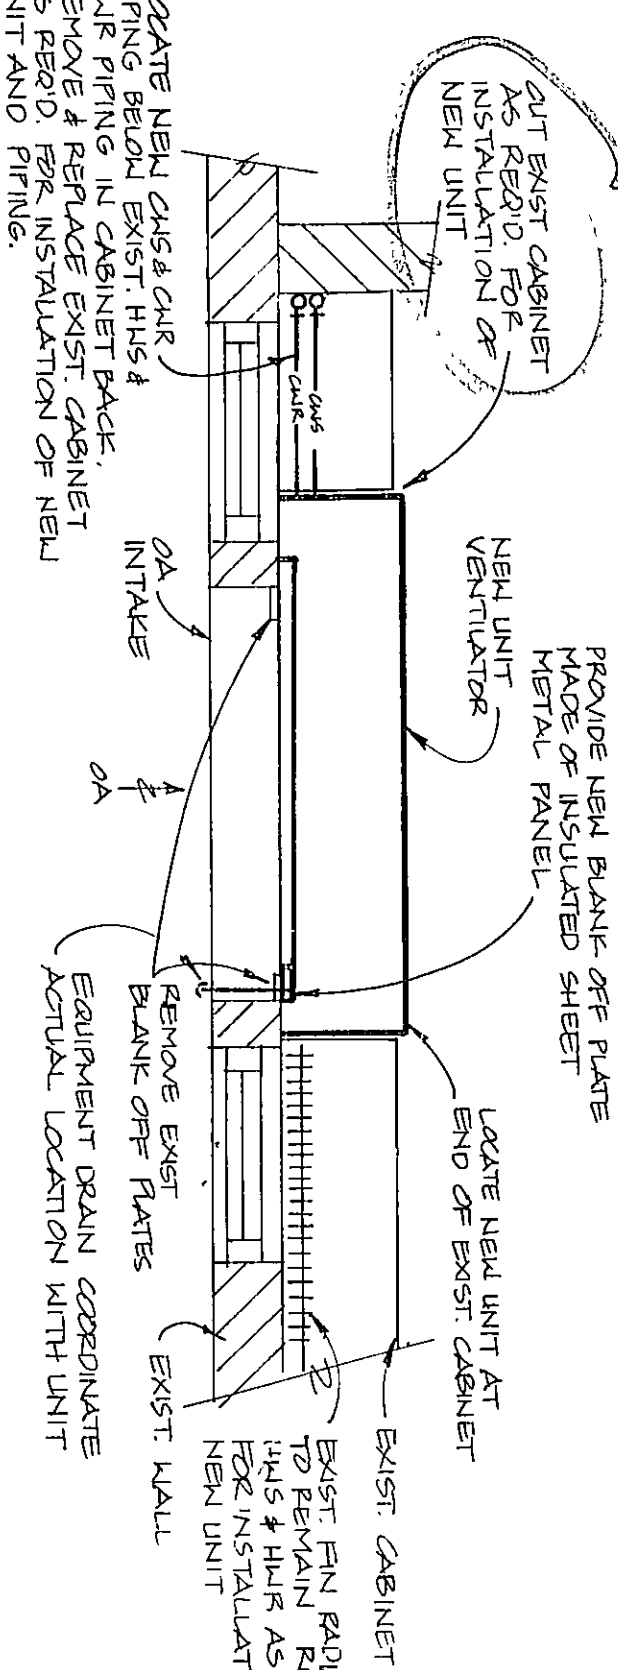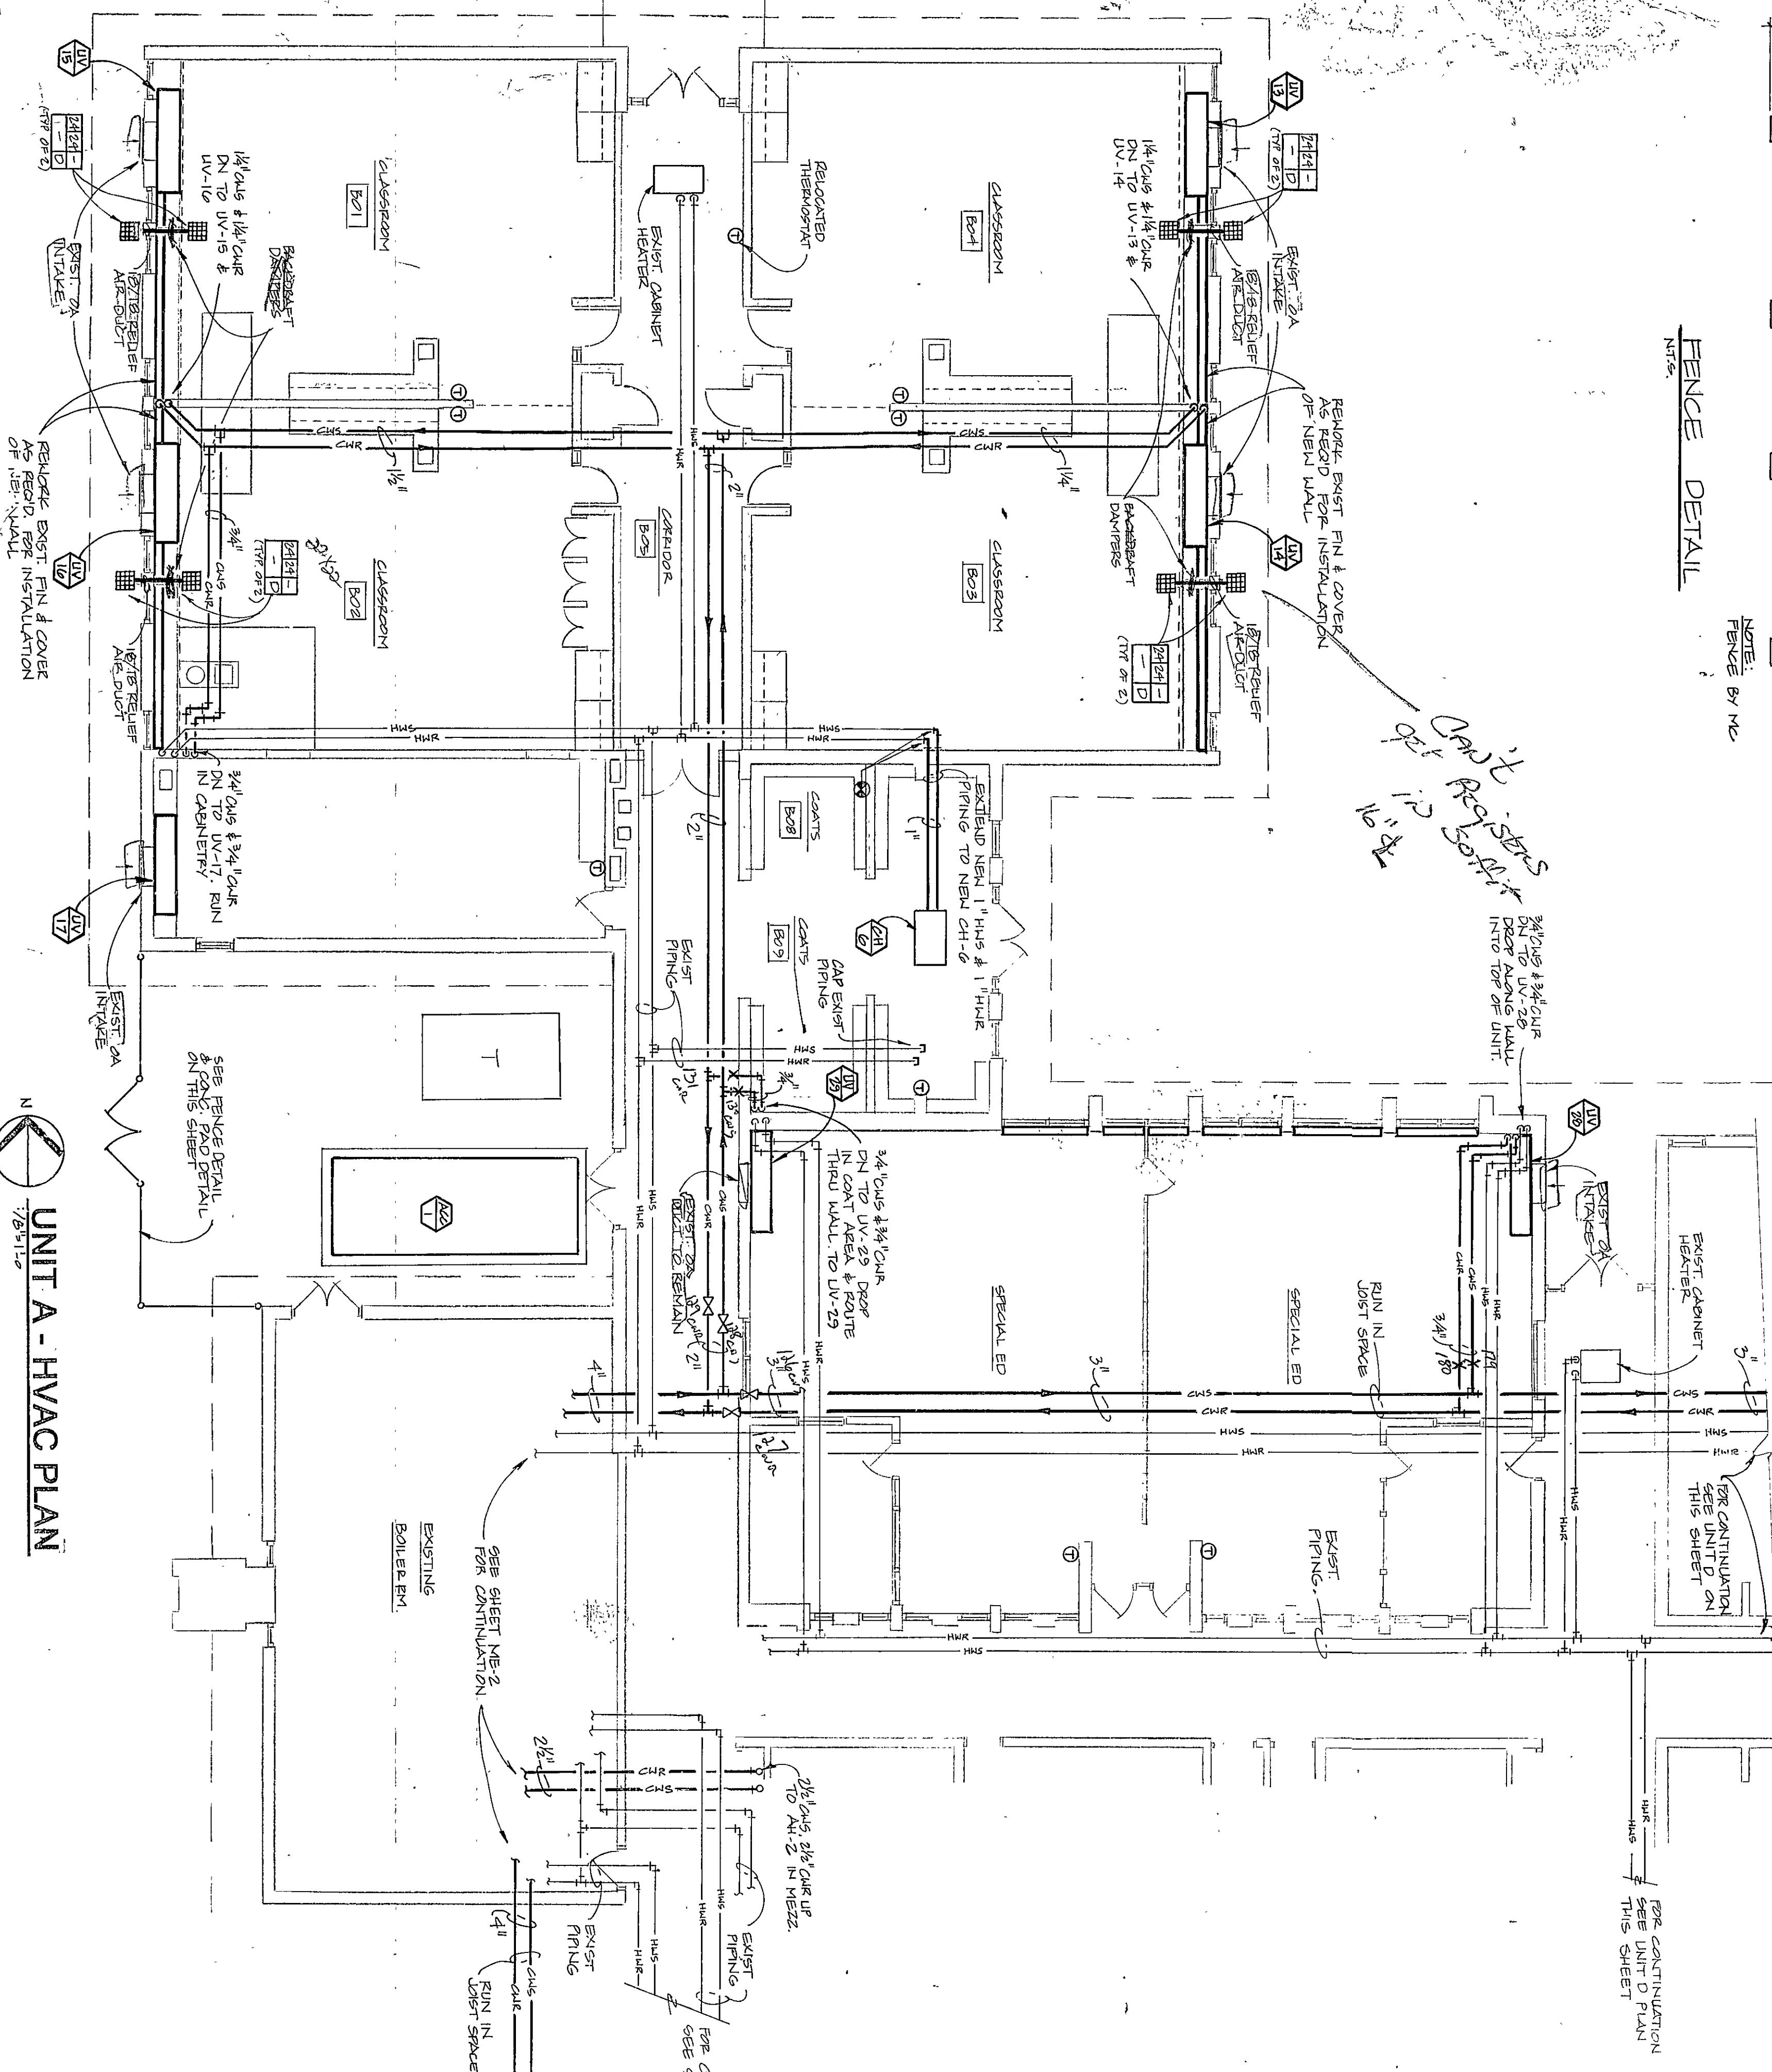UNIT VENTILATOR DETAIL FOR UV-1 THRU 4 & UV-7 THRU 10
N.T.S.

UNIT A - HVAC PLAN

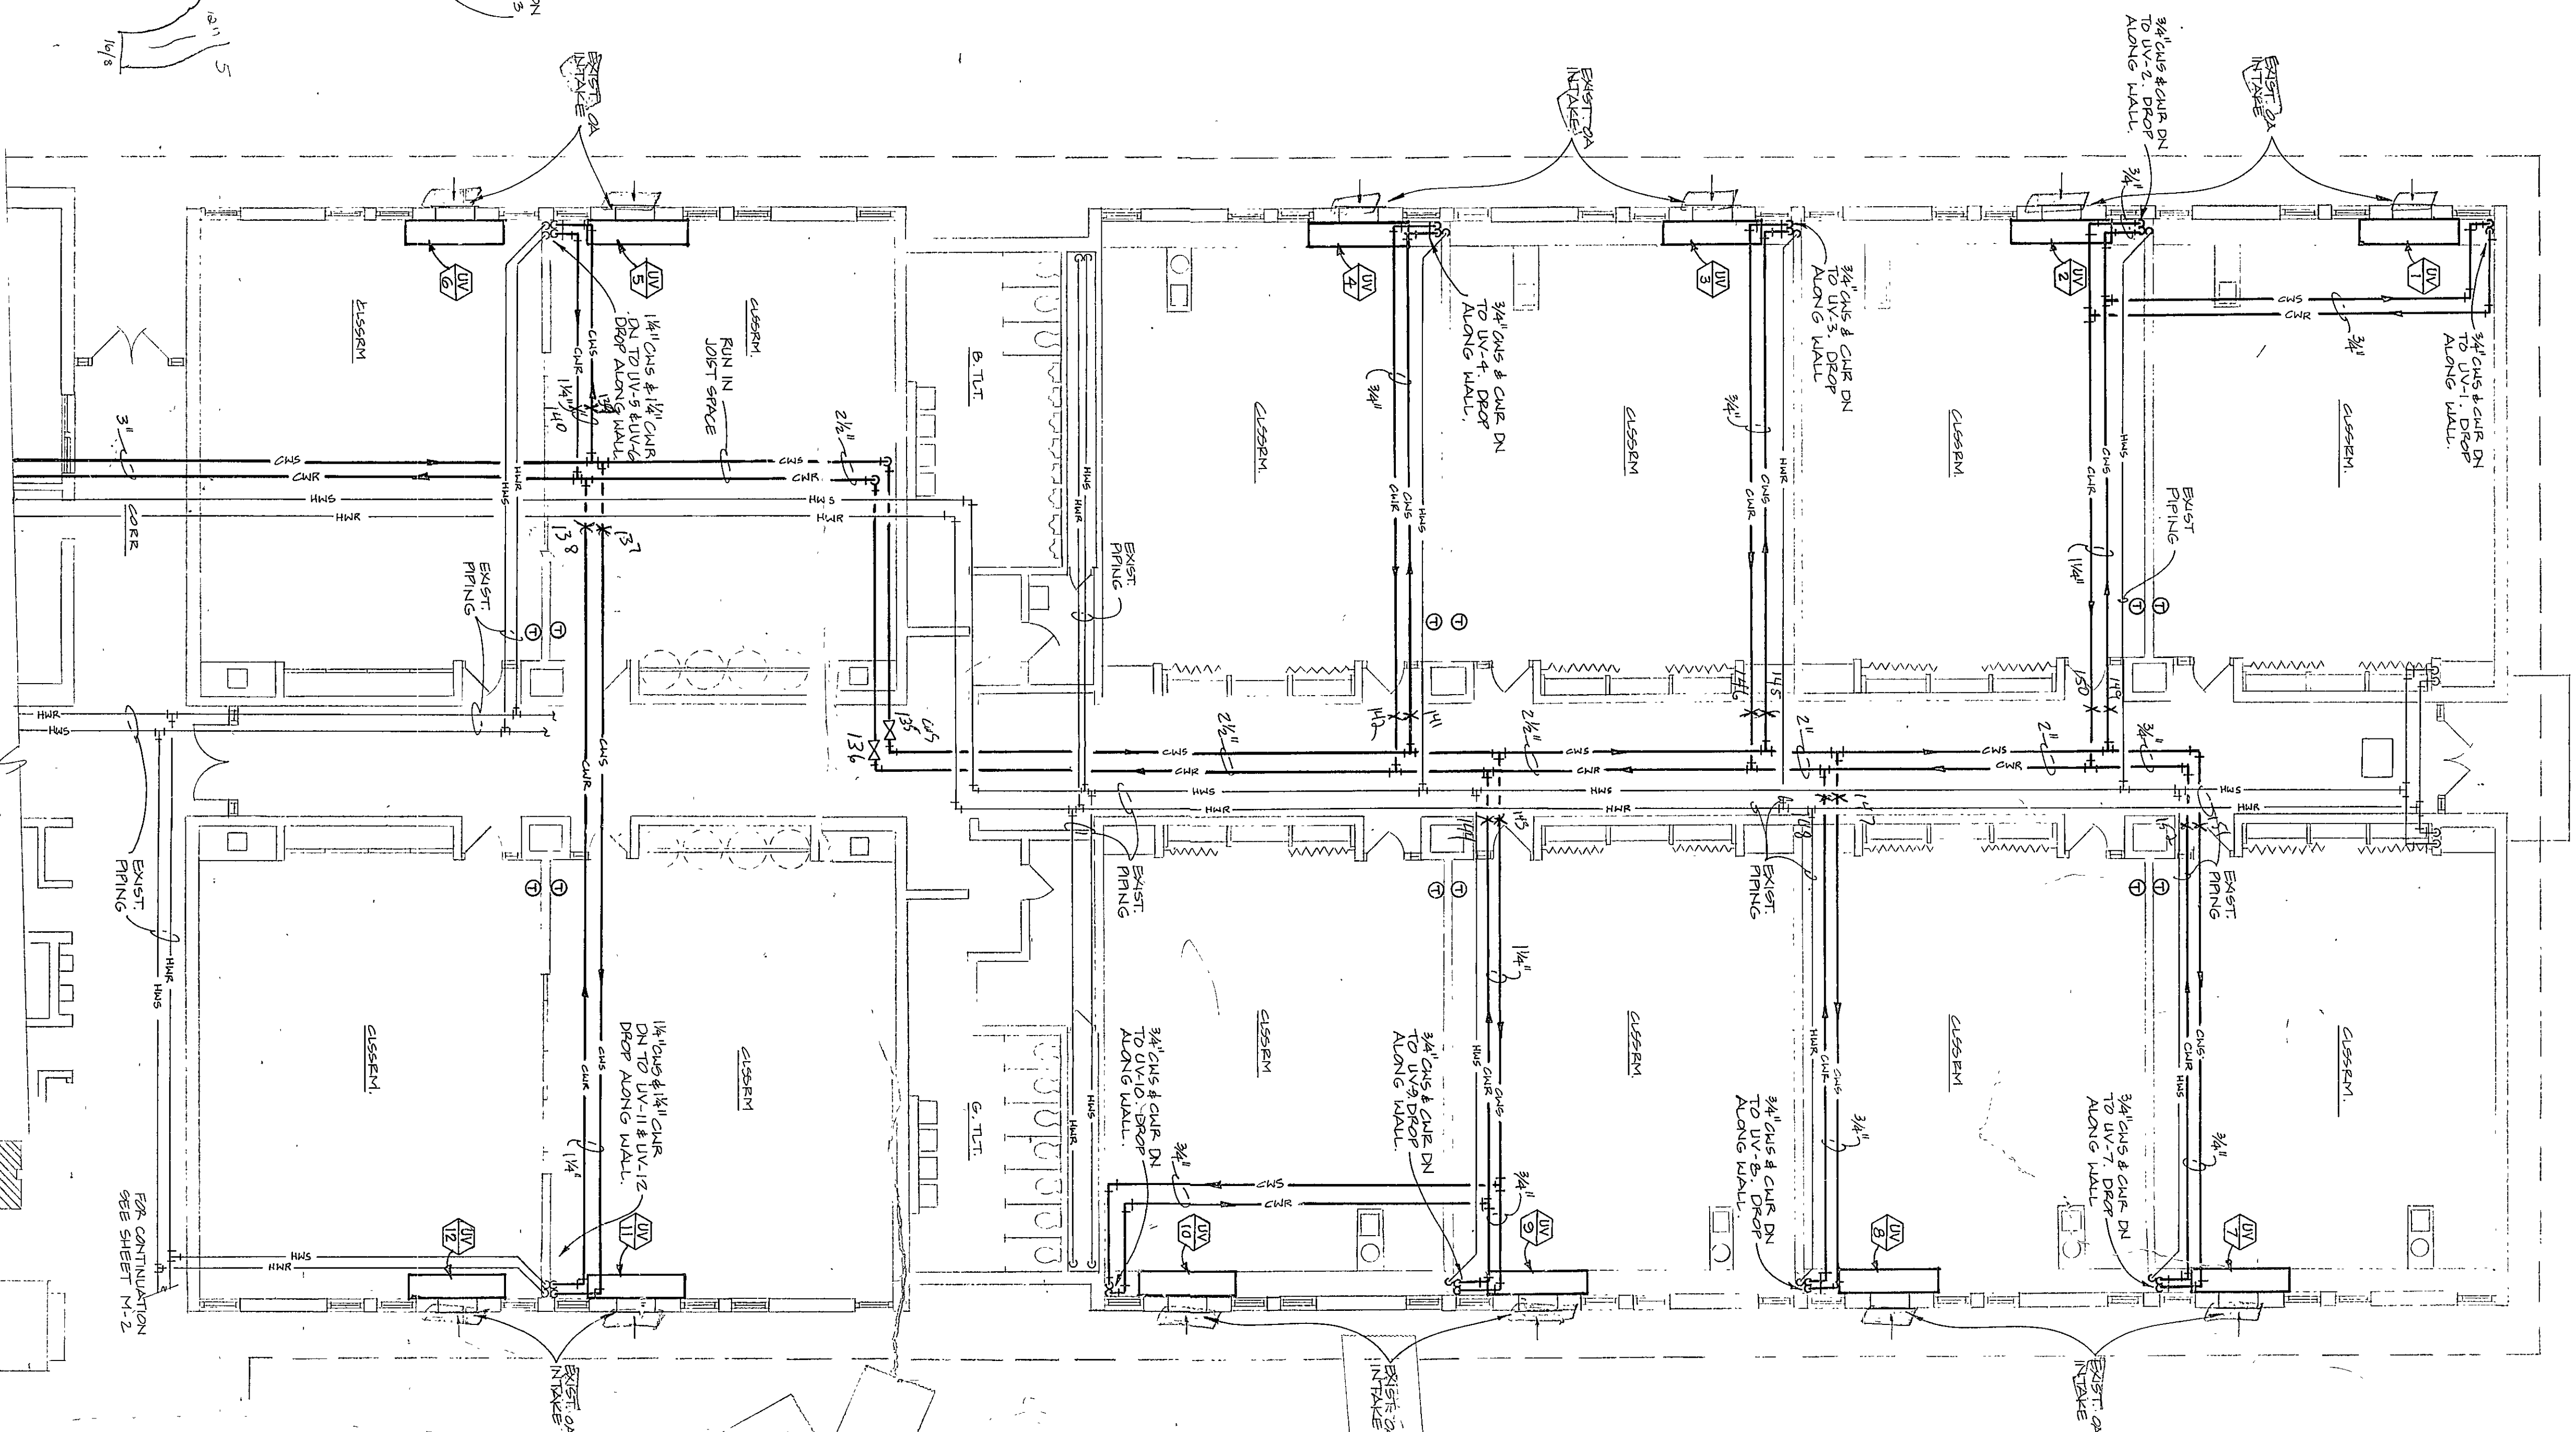

UNIT D - HVAC PLAN

AS BUILT 3166
DATE 12/6/95

FOR CONTINUATION
SEE UNIT A, THIS
SHEET

UNIT A & D H.V.A.C. PLANS

1994 BUILDING ADDITIONS & RENOVATION PROJECTS
DUNELAND SCHOOL CORPORATION CHESTERTON, INDIANA
cerometta & kinkel architects, inc. chesterton, indiana

CHESTERTON, INDIANA
Chesterton, Indiana

REVISION: