


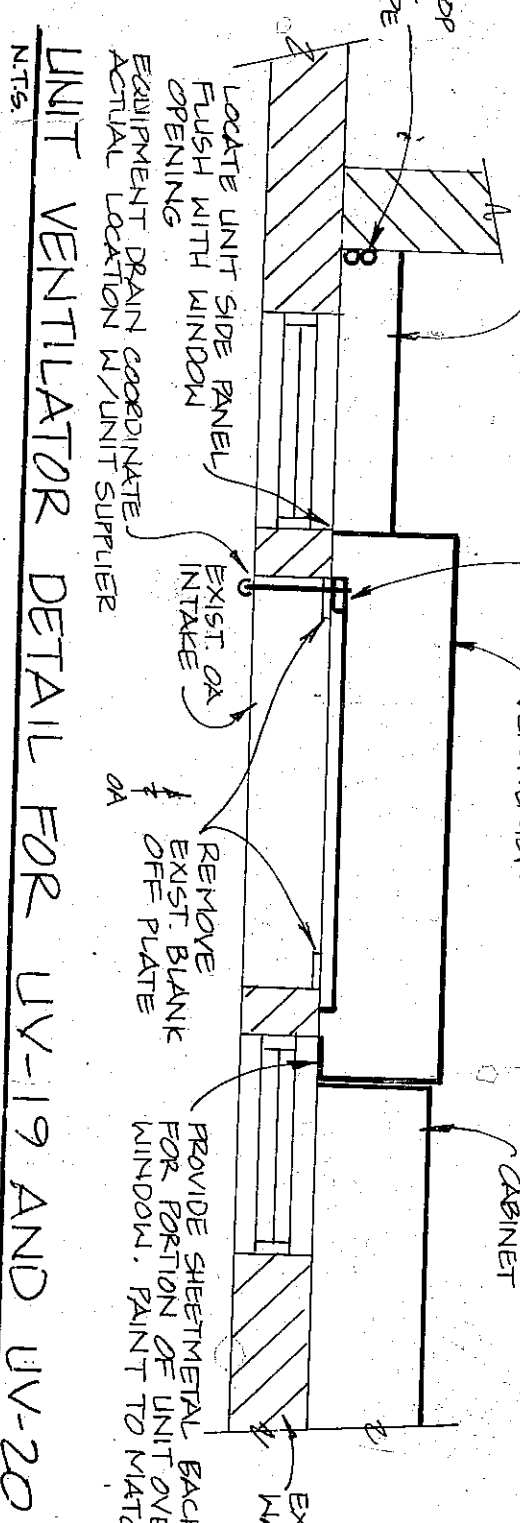

AS BUILT 3/66
DATE ~~12/6/75~~