


Chesterton High School

Section A2

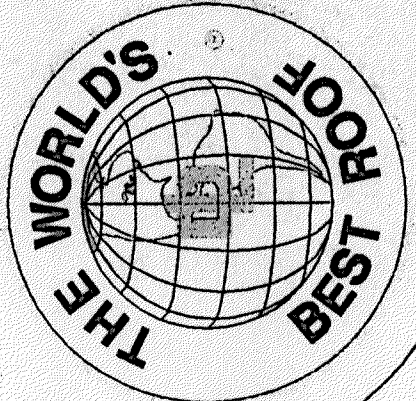

DURO-LAST, INC.
525 MORLEY DRIVE
SAGINAW, MICHIGAN 48601


CHESTERTON HIGH SCHOOL
SECTION A2
W.R. KELSO

DWG NAME: chesterton
DRAWN BY: KNOX
REV. BY:

SCALE: 1/8"=1'-0"
DATE: 9/19/97
REV.:

LEGEND
FACTORY WELD
FIELD WELD

Q7-A-08

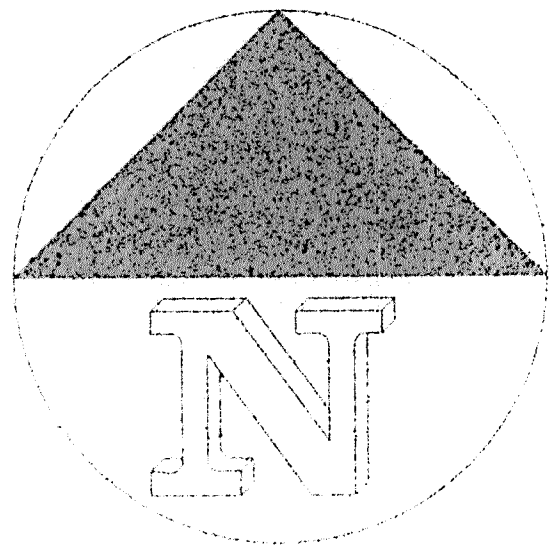

ROOF DECK PANEL SCHEDULE

PC	STD/ ROLLS	27"TAB SHTS	WIDTH (FEET)	LGTH (FEET)	TAB	NOTES
A2	-	X	9	9	9	24"REV 21" TABS
B2	-	X	9	9	9	24"REV 21" TABS
C2	-	X	9	9	9	24"REV 21" TABS
D2	-	X	9	9	9	24"REV 21" TABS
E2	-	X	9	61	61	30"REV
F2	-	X	9	60.5	60.5	30"REV
G2	-	X	9	60	60	30"REV
H2	-	X	9	61	61	30"REV
I2	-	X	9	60	60	30"REV
J2	-	X	9	60.5	60.5	30"REV
K2	X		31	61	61	FULL REV
L2	X		31	61	61	FULL REV
M2	X		31	61	61	FULL REV
N2	X		28.5	61	61	FULL REV

☒ CHECKED AND FORWARDED TO A/E
☐ REVISE AND RESUBMIT
☐ INSUFFICIENT INFORMATION
Checked for conformity and compliance with the
contract documents. Contractor is
responsible for the accuracy and correlation
of the information that pertains solely to the
fabrication, erection, or techniques of construction and
for coordination of the work of all trades.
BY: WRK
DATE: 9/19/97
CONSTRUCTION CONTROL
FORT WAYNE, INDIANA

