


Chesterton High Schools

Details

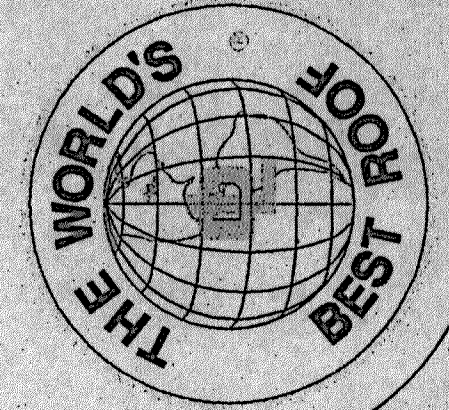


DURO-LAST, INC.
525 MORLEY DRIVE
SAGINAW, MICHIGAN 48601

CHESTERTON HIGH SCHOOLS
DETAILS
WR KELSO ROOFING


DWG NAME: CHESTERTON
DRAWN BY: KNOX
REV. BY:

SCALE: not to scale
DATE: 9/24/97
REV:

LEGEND
FACTORY WELD
FIELD WELD

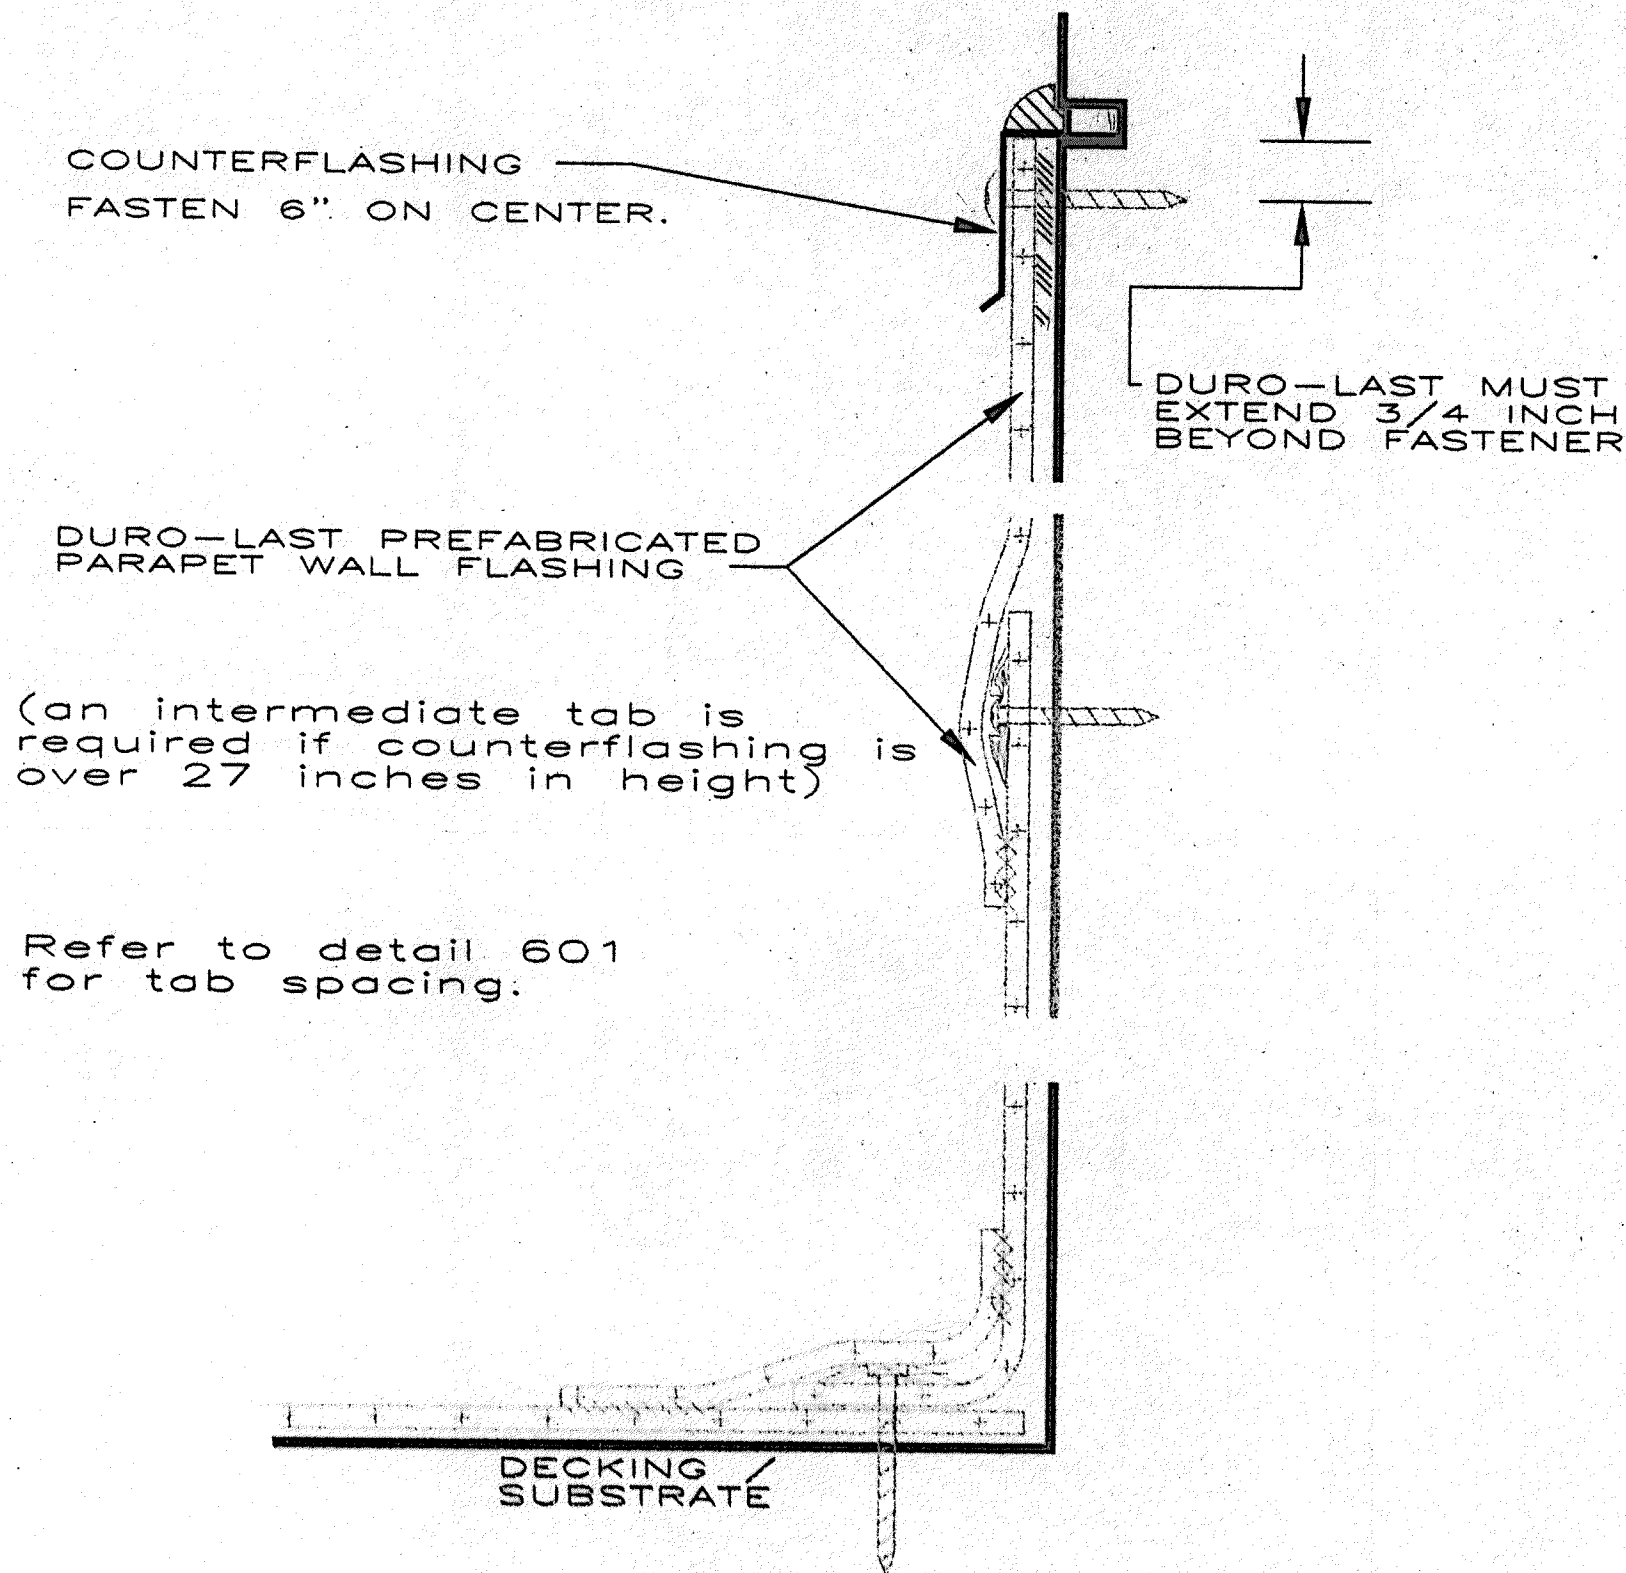


604 PARAPET WALL
not to scale

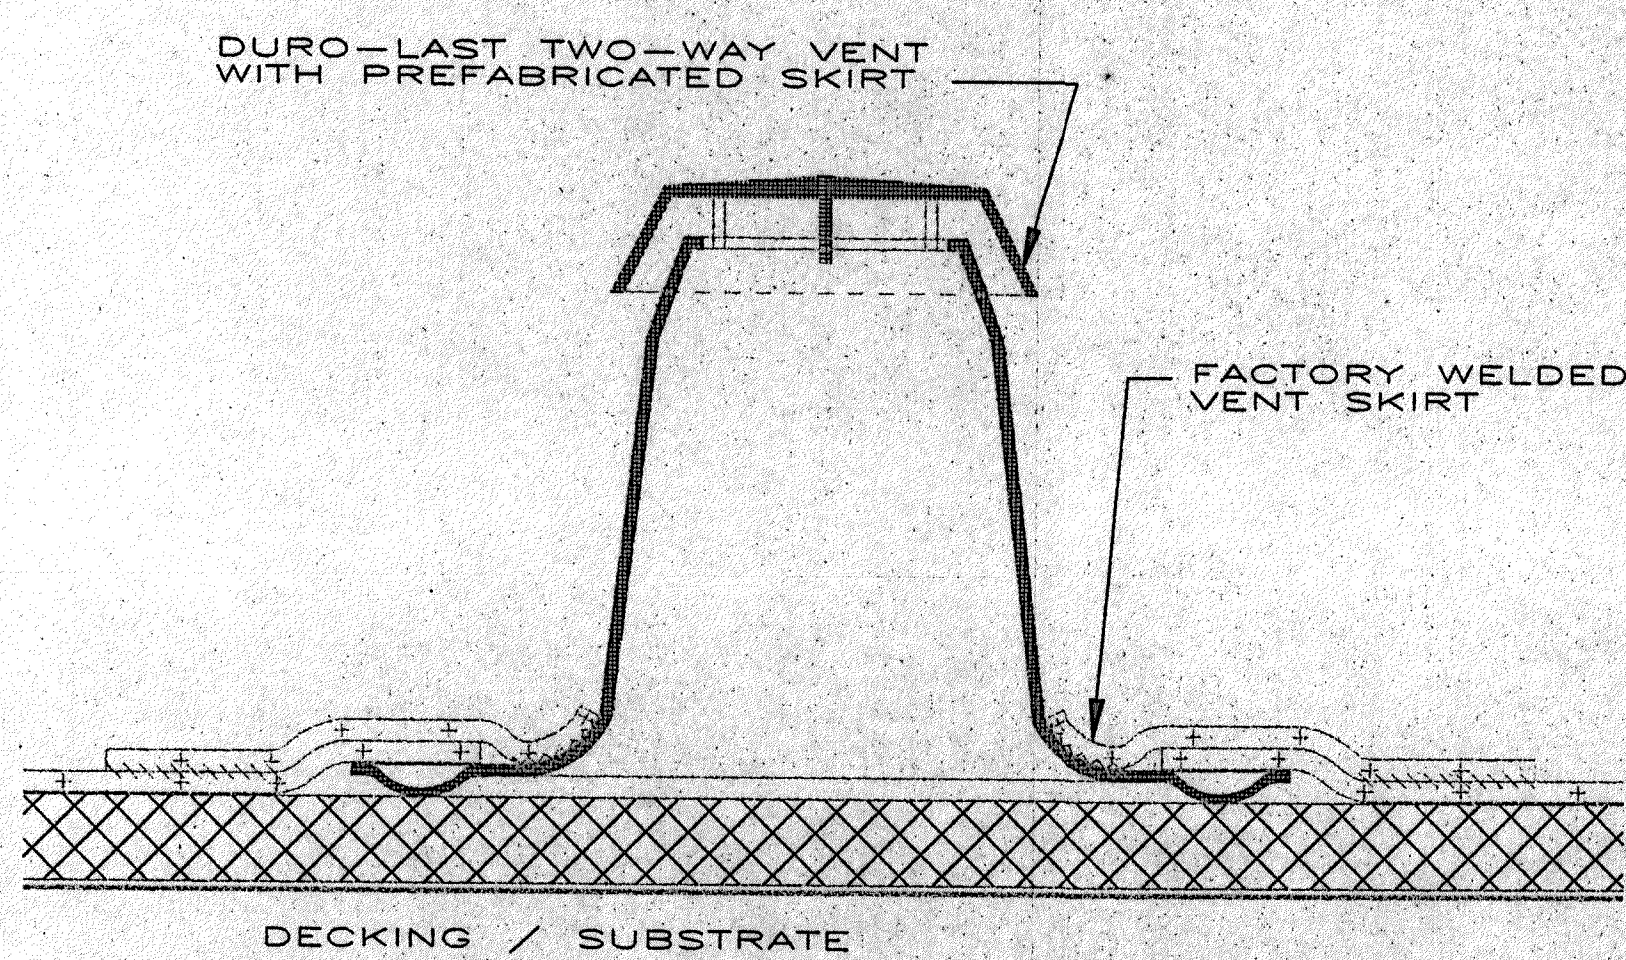


NOTE:
On new construction or tear off and replace,
cut through Duro-Last membrane only.


501 BREATHER VENT
not to scale

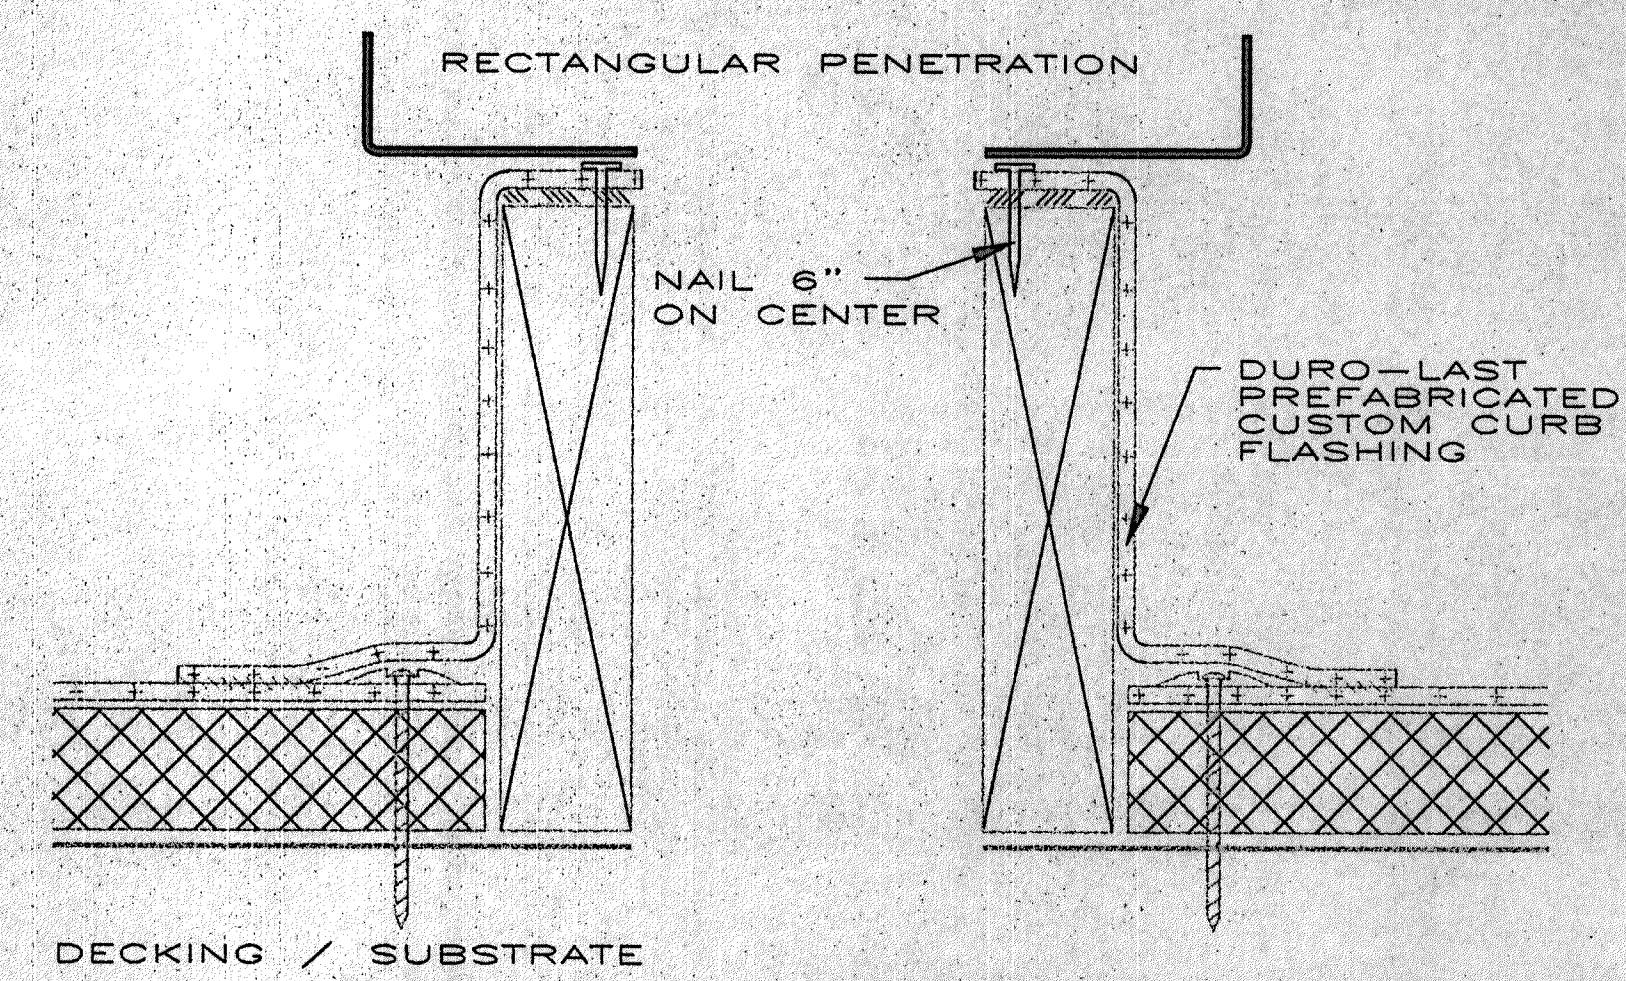

402 RECTANGULAR PENETRATION
not to scale

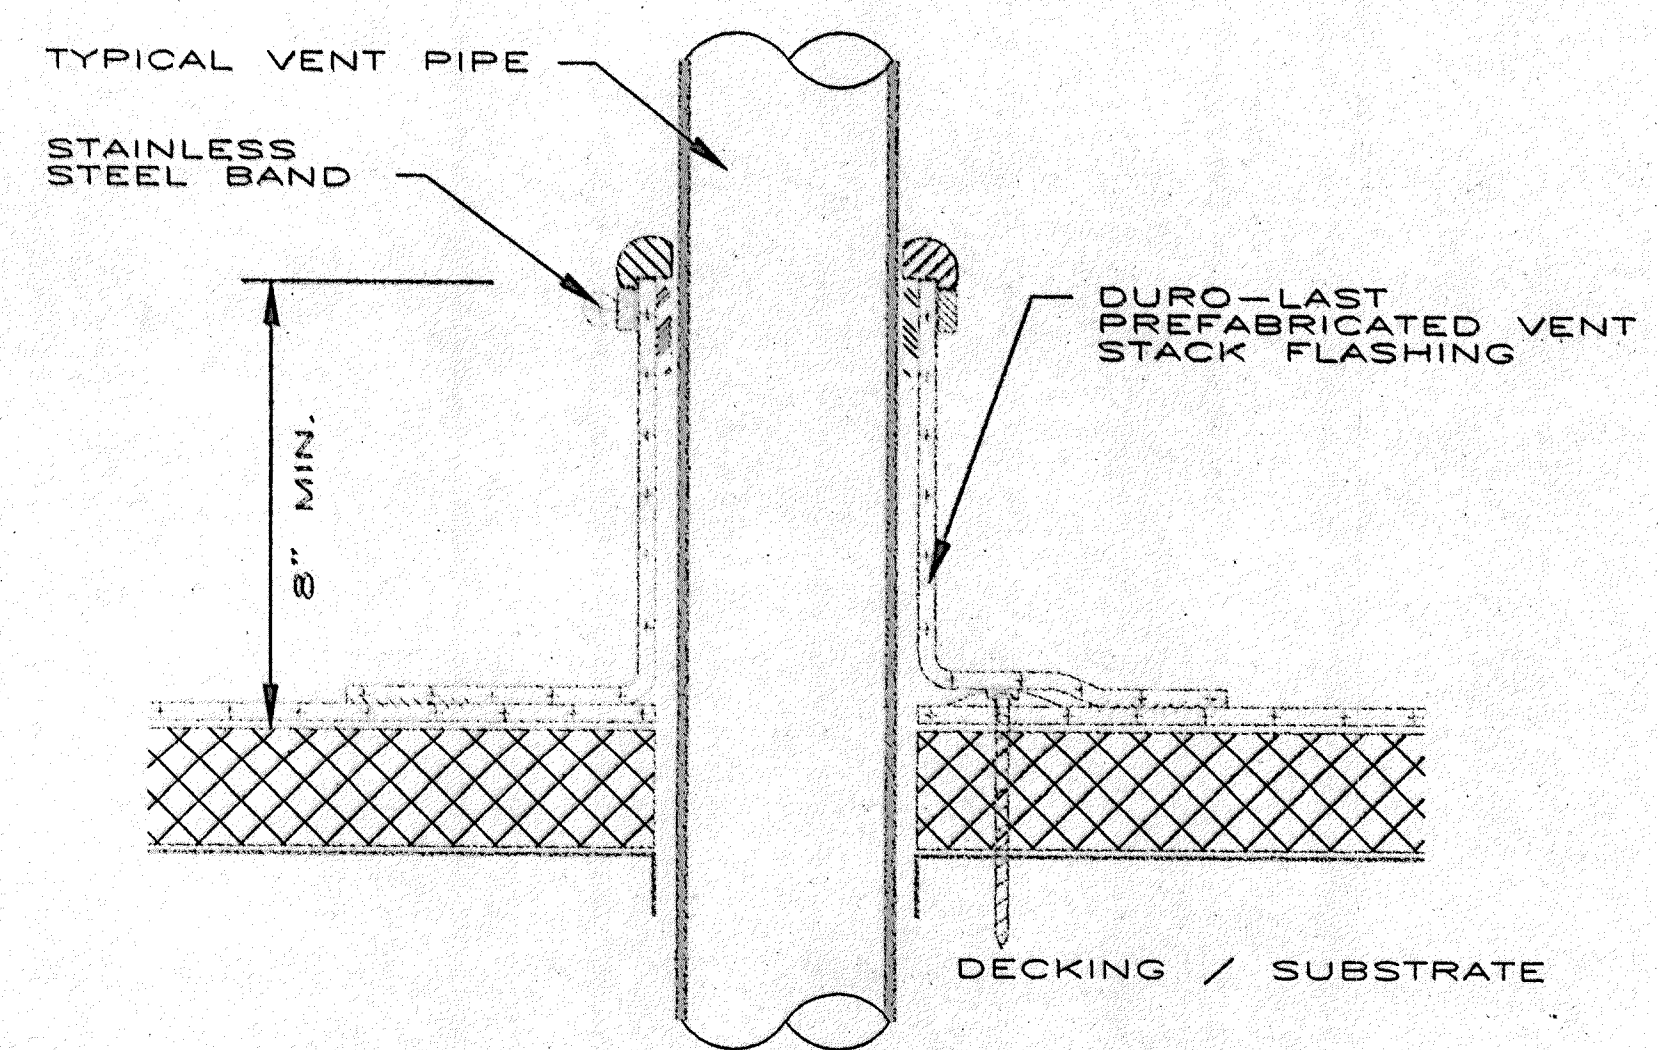


407 ROUND PENETRATION
not to scale

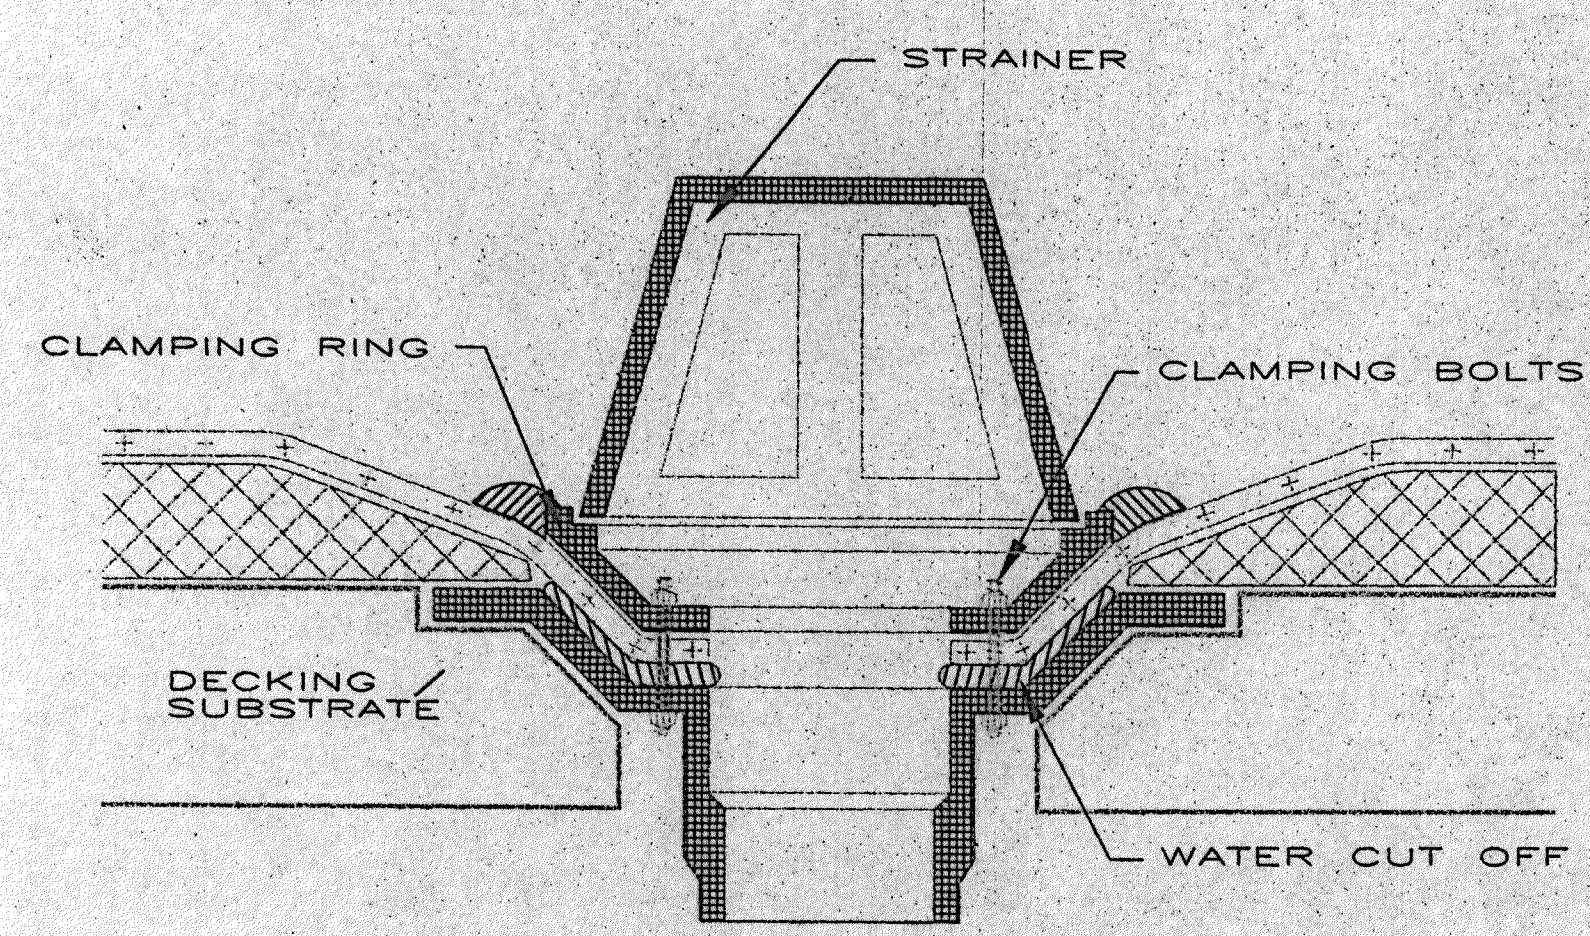

201 ROOF DRAIN DETAIL
not to scale

✓ CHECKED AND FORWARDED TO A/E
☐ REVISE AND RESUBMIT
☐ INSUFFICIENT INFORMATION
 Checking is only for conformity and compliance with the
 drawings. It is the Contractor's responsibility to be satisfied and correlated
 at the job site. It is not intended to be a substitute for the
 fabricator's practices or to test stages of construction and
 for coordination of the work of all trades.
 BY: WES
 DATE: 12/2/97
 CONSTRUCTION CONTROL
 FORT WAYNE, INDIANA

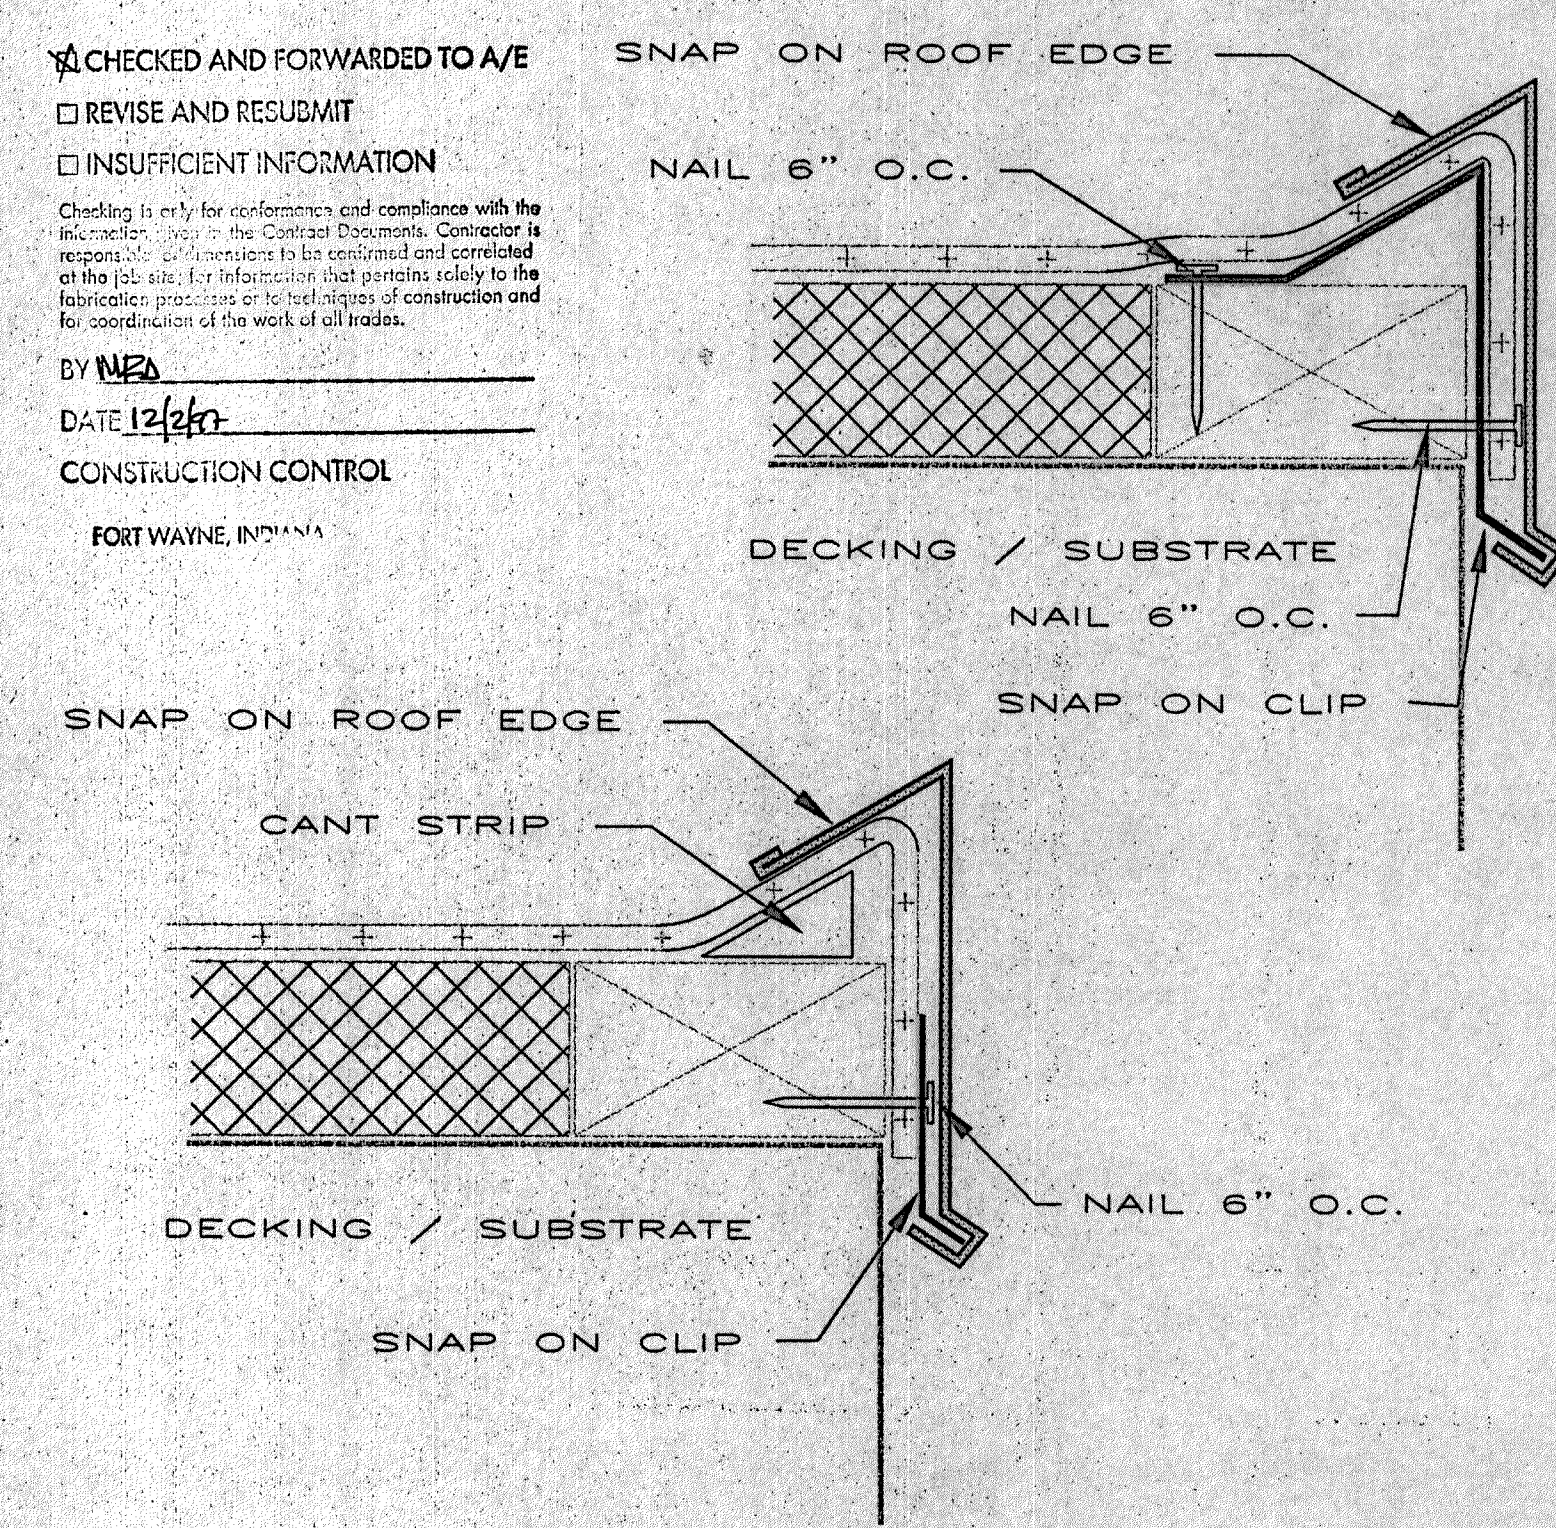

NOTE: A wood nailer is required if one (1) inch
of insulation or greater is used.

312 SNAP ON METAL
not to scale

97-R-10