
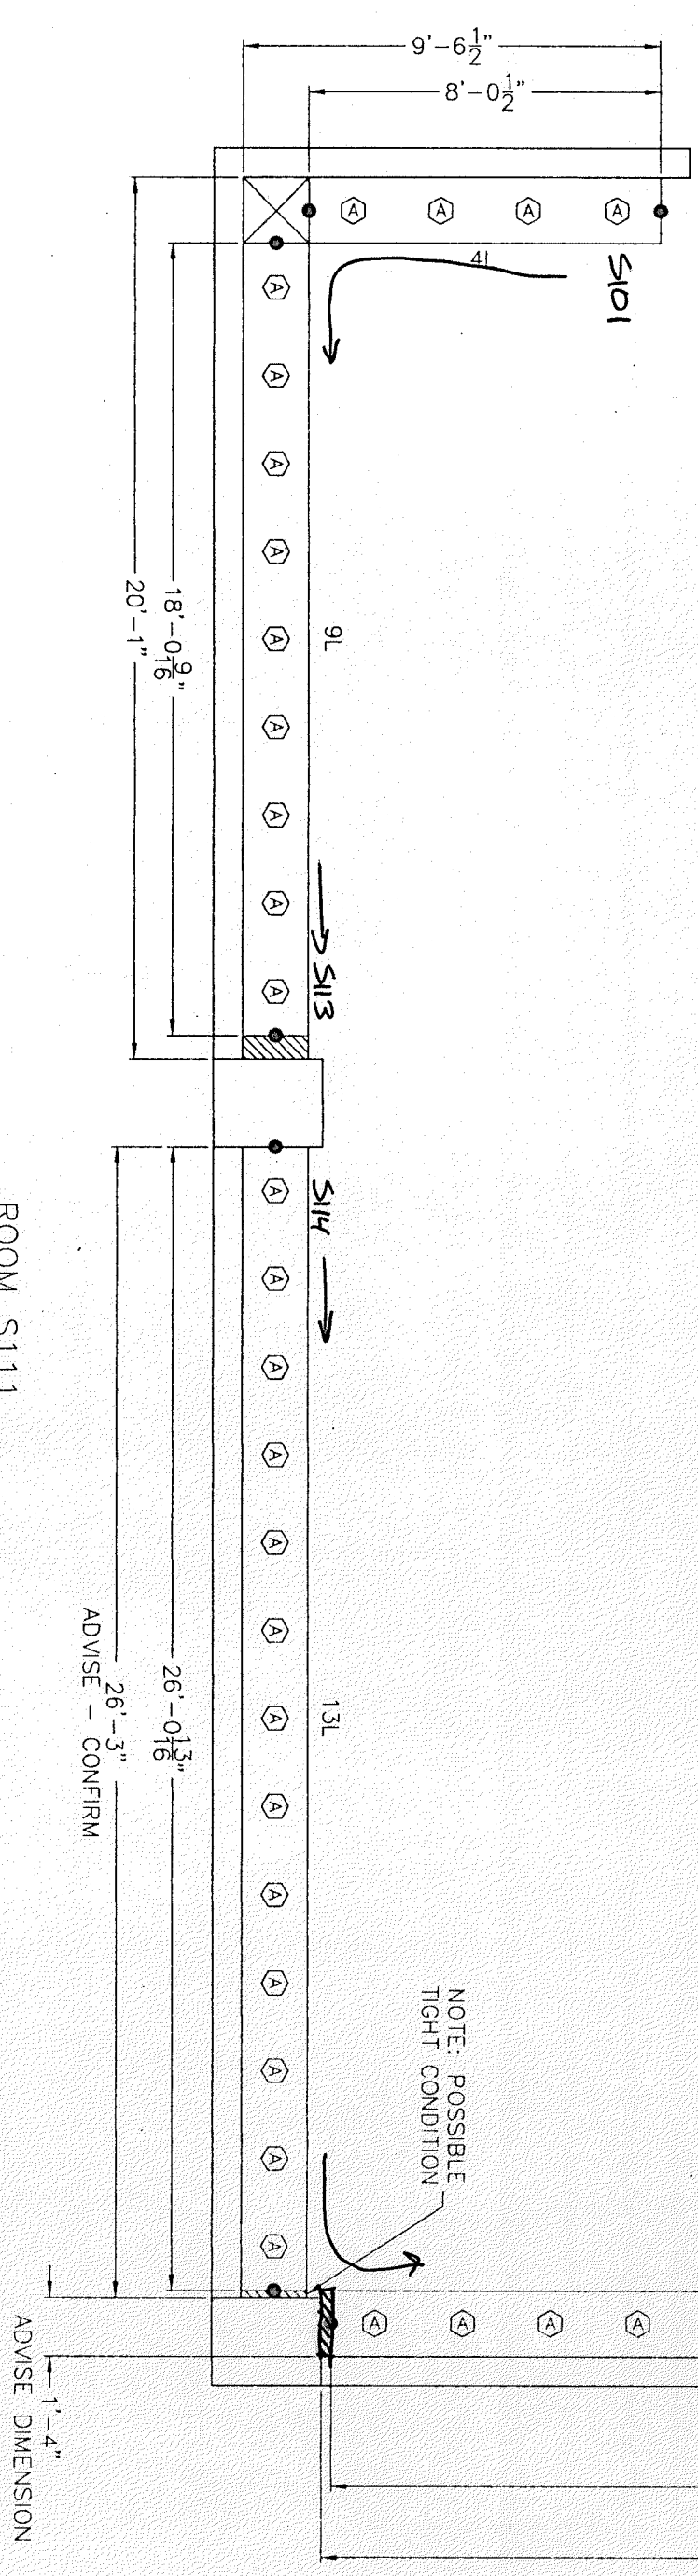


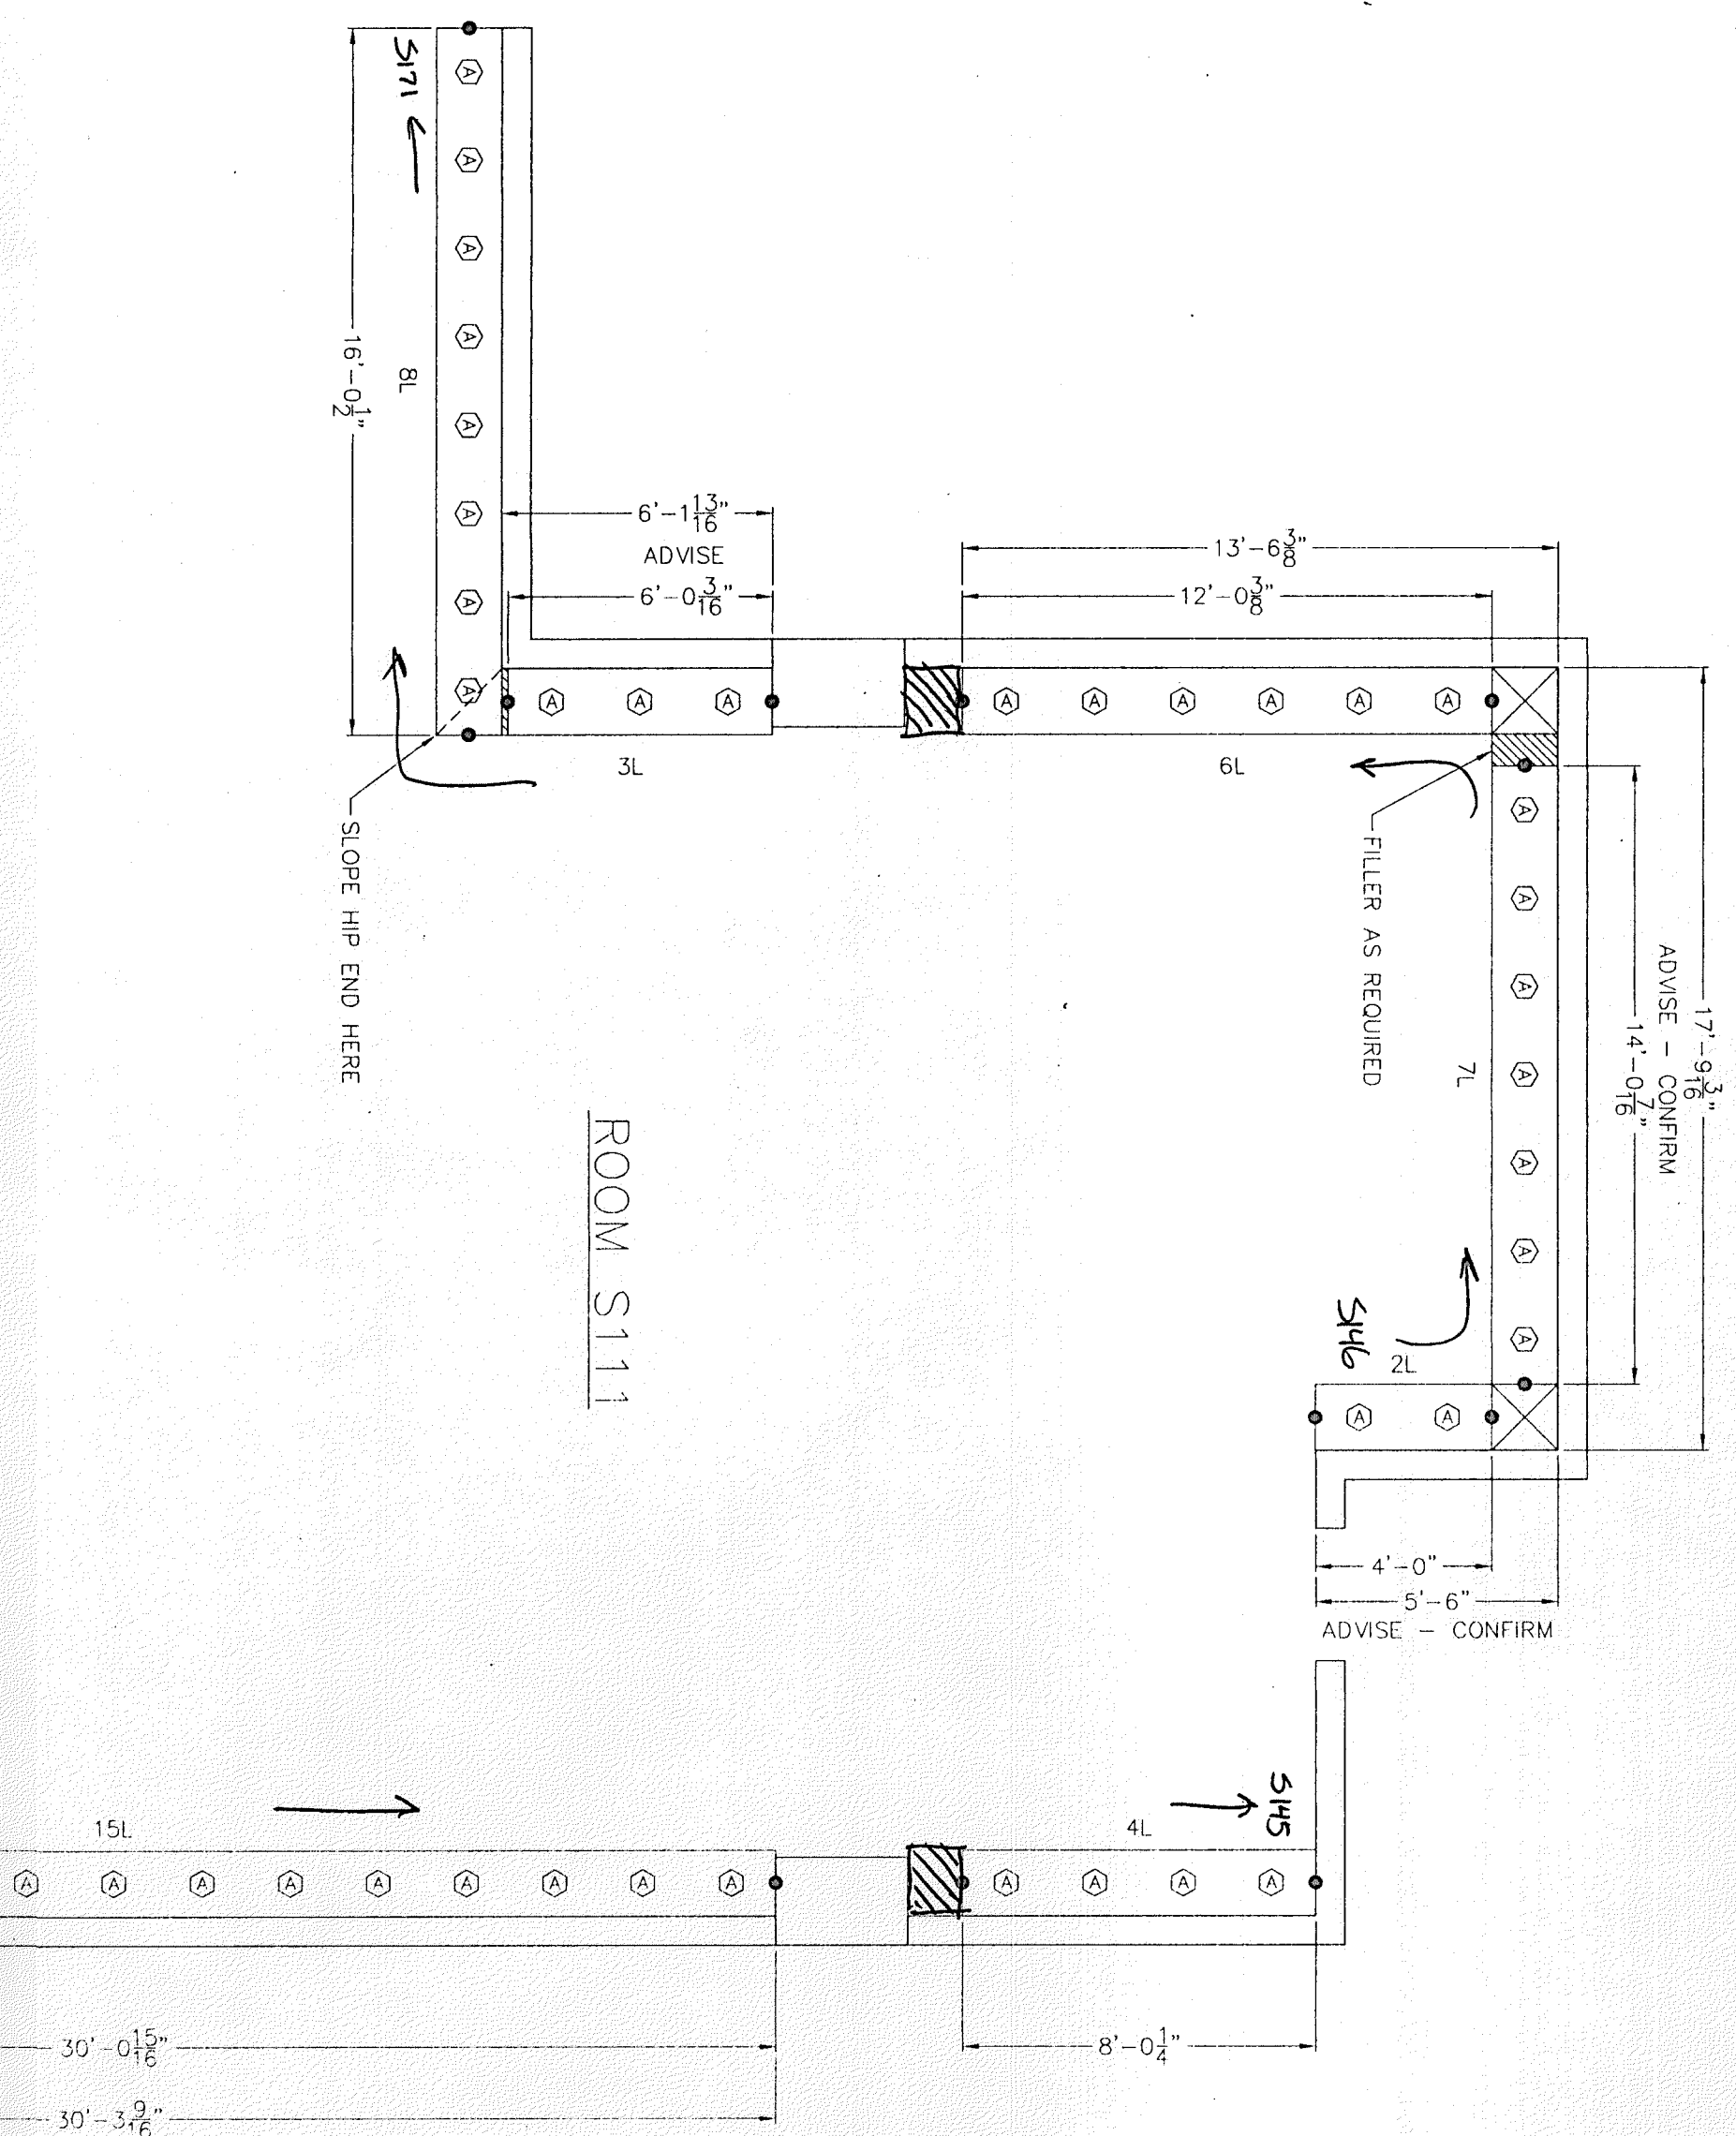

NOTE: ADVISE ► NUMBERING: See plan
ADVISE ► FINISH COLOR: 166 BURGUNDY WINE

① 52 - 24" x 18" x 72" SINGLE TIER INVINCIBLE II ALL WELDED LOCKERS
● - SOLID END, ALL OTHER SIDES ARE DIAMOND PERFORATED

① 21 - 24" x 18" x 72" SINGLE TIER INVINCIBLE II ALL WELDED LOCKERS
● - SOLID END, ALL OTHER SIDES ARE DIAMOND PERFORATED

RECHECKED AND FORWARDED TO A/E
☐ REVISE AND RESUBMIT
☐ INSUFFICIENT INFORMATION

Checking is only for conformance and compliance with the information given in the Contract Documents. Contractor is responsible for dimensions to be confirmed and coordinated at the job site; for information that pertains solely to the fabrication processes or to techniques of construction and for coordination of his work of all trades.

REQUIRED		FIELD CHECK:	1
1	REVISE PER G.C.	K.M.C.C.	1/28/99
REV	REMARKS	BY	DATE

TITLE:	WELDED LOCKER FLOOR PLANS
	
PENCO PRODUCTS • OAKS, PENNSYLVANIA	
PROJECT: CHESTERTON HIGH SCHOOL	
LOCATION: CHESTERTON, INDIANA	
ARCHITECT:	
CONTRACTOR: R.A. SNEEMS CONSTRUCTION CO.	
DRAWN BY: KEN MCCARRON	DATE: 7/30/98
CHECKED BY:	
DATE:	
SCALE: NOT TO SCALE	
ORDER NO.: C98M26829-37	SH: 1 OF: 7
DWG. NO.: 26829--37	

Postmarked

R. A. STEIN'S CONSTRUCTION CO., INC.
4770 WEST 81st AVENUE
HIGHLAND, IN 46342
(219) 547-6583

PROJECT CLASH-HIGH SCHOOL
SECTION 4-0550010505
RECEIVED 2-1-99
REVIEWED Ray
FORWARDED 2-2-99