


6	-	-	-
5	-	-	-
4	-	-	-
3	-	-	-
2	-	-	-
1	65889	RECORD DRAWING	AZ
NO.	156889	REVISION	B2
FIRE PROTECTION			

ZONE #10
UNIT B2, C2
FIRE PROTECTION

CHECKED BY Alan Zimmerman	CHECKED BY
SOURCE 178-11'-0"	DATE 10-1-97
SHEET NO. SHEET TOTAL SPRINK. SEE A00	
SPRINK. PROJECT NUMBER 240902	
APPROVAL MARKS	
JOB NO. 231893	LOCAL F.W. ARCHITECT
SHEET NO.	

FP-18

q7-pg-18

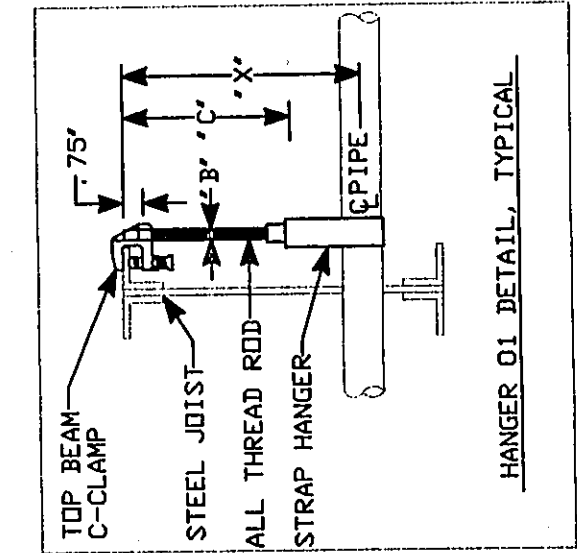

NOTE:
THIS PLAN IS ROTATED 90 DEG.
COMPARED TO ALL OTHER PLANS
IN THIS DRAWING SET