



SHAMBAUGH & SON, INC.

FIRE PROTECTION DIVISION

CONTRACTORS - ENGINEERS





7614 OPPORTUNITY DRIVE, FORT MYER, INDIANA 46325

PHONE (317) 483-7777 FAX (317) 483-7991

70 YEARS OF

EXCELLENCE

1926

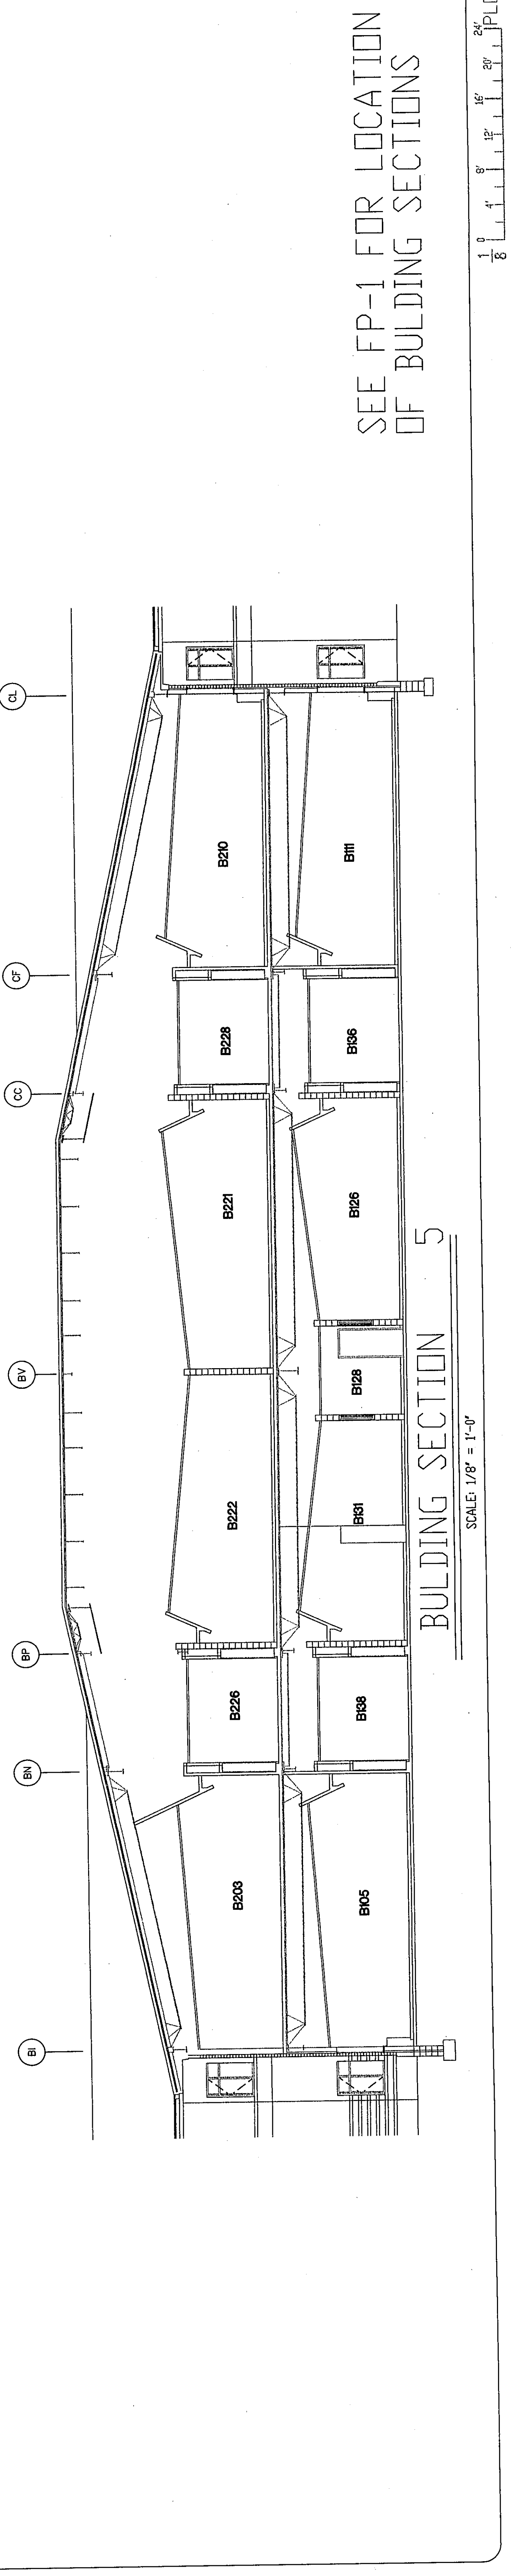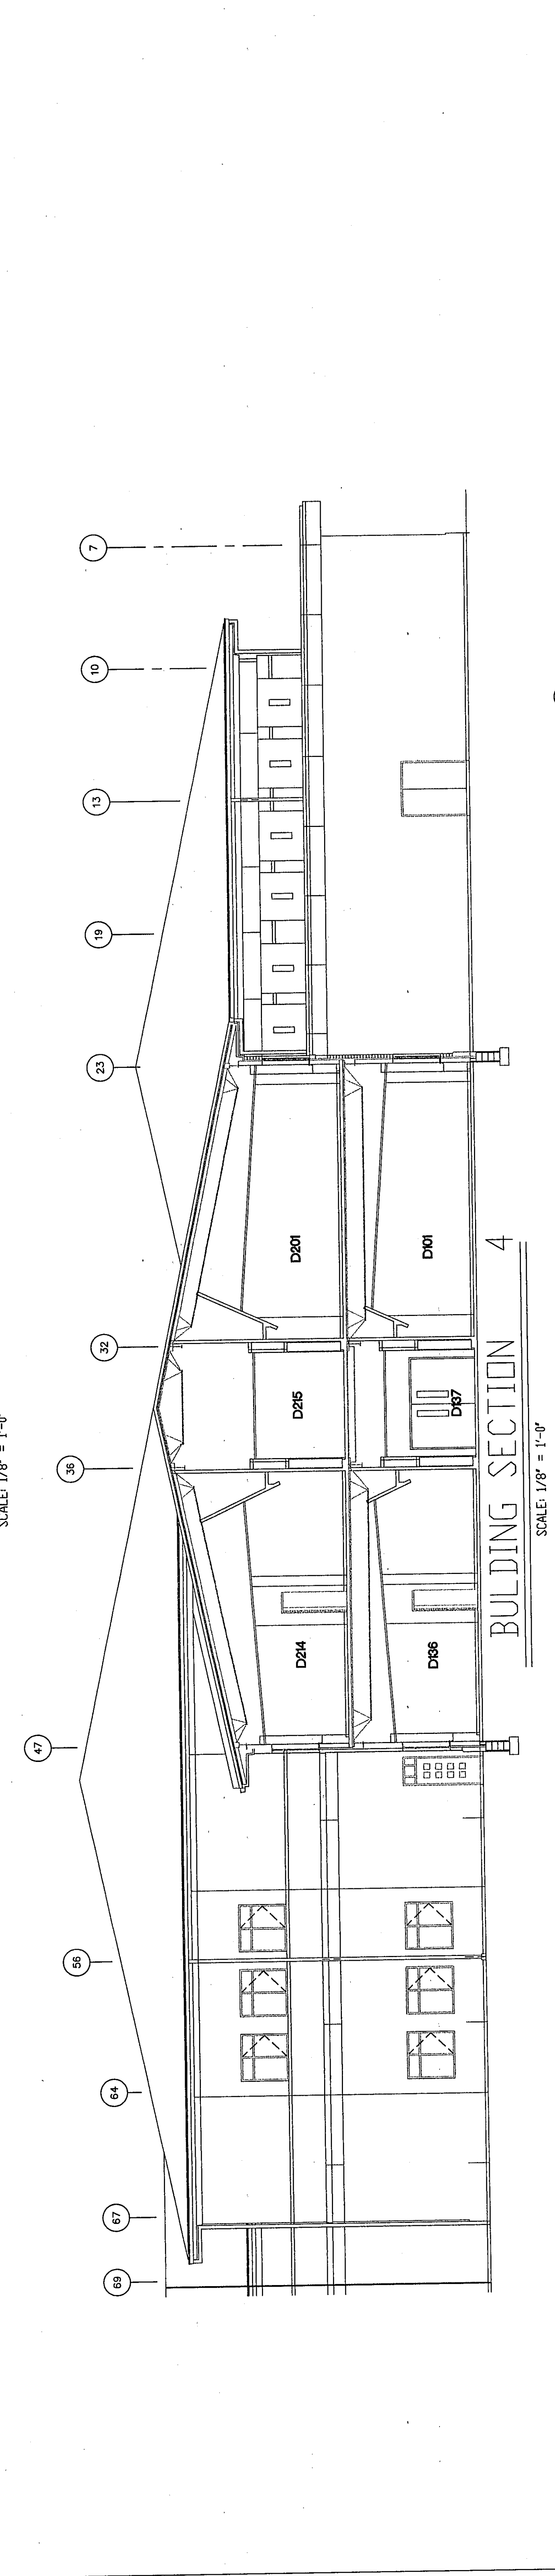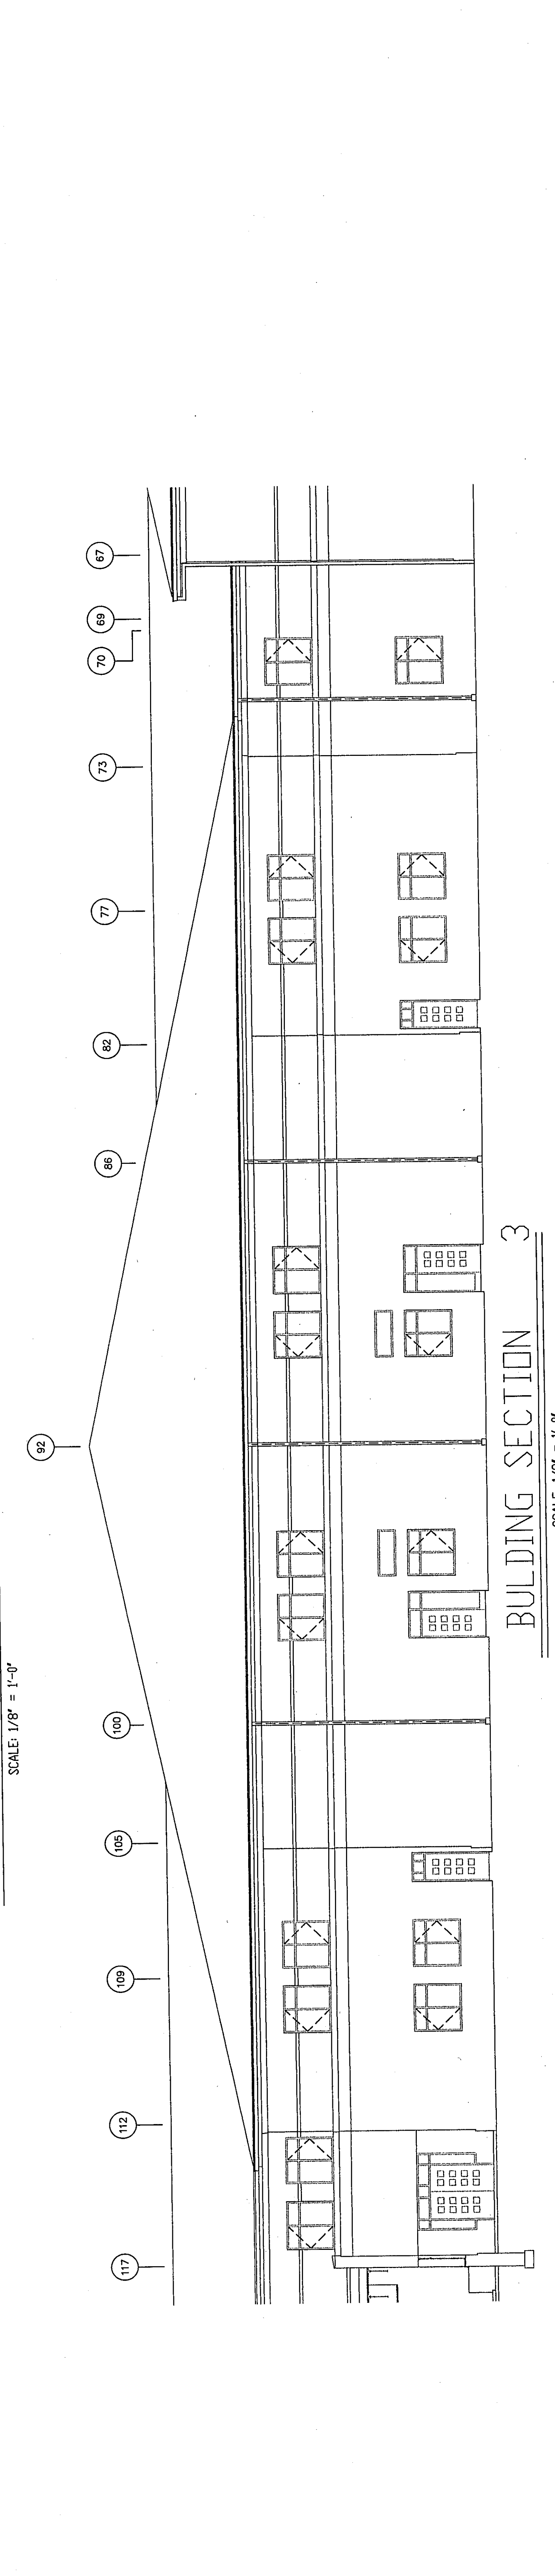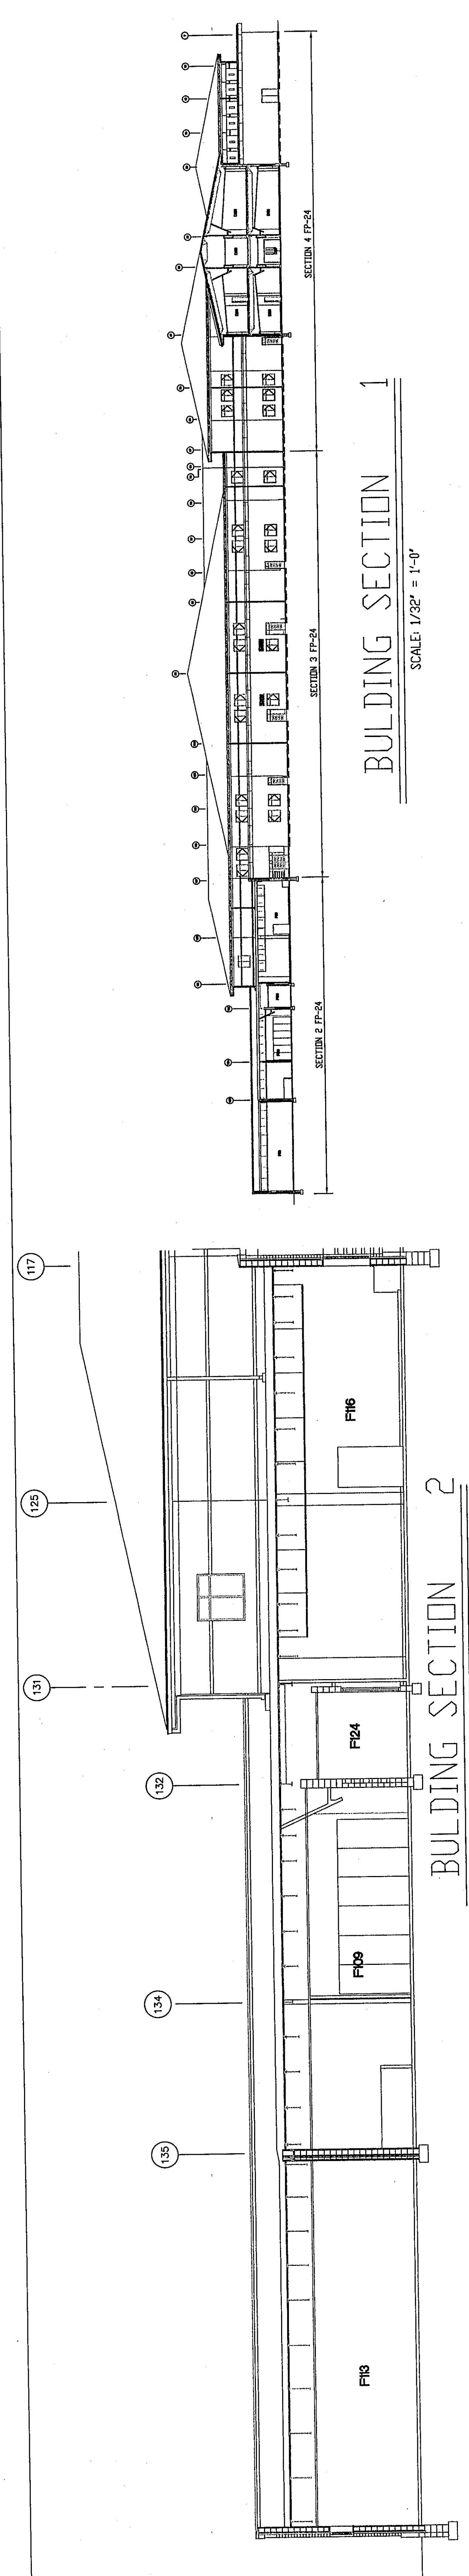

SEE FP-1 FOR LOCATION
OF BUILDING SECTIONS

Chesterton High School
2125 South Eleventh St.
Chesterton, IN 46304

PROJECT NAME:		C:\DWG\2318924.DWG	
NO.	DATE	REASON	BY
1	03/05/07	RECORD DRAWING	AZ
2			
3			
4			
5			
6			
FIRE PROTECTION			
DESIGNED BY:		ALAN ZIMMERMAN	
SCALE:		1/8" = 1'-0"	
DATE:		10-1-97	
SHEET NO.		231893	
SHEET NO.		FP-24	
STATE PROJECT NUMBER:		240902	
APPROVAL SIGNATURE:		J. M. LOCAL, P.E., ARCHITECT	
APPROVAL SIGNATURE:		231893	
SHEET NO.		FP-24	