




1574 TOTAL NET 18" SEATS
16 TOTAL NET 33" WHEELCHAIR SPACES
1590 TOTAL SEATING CAPACITY

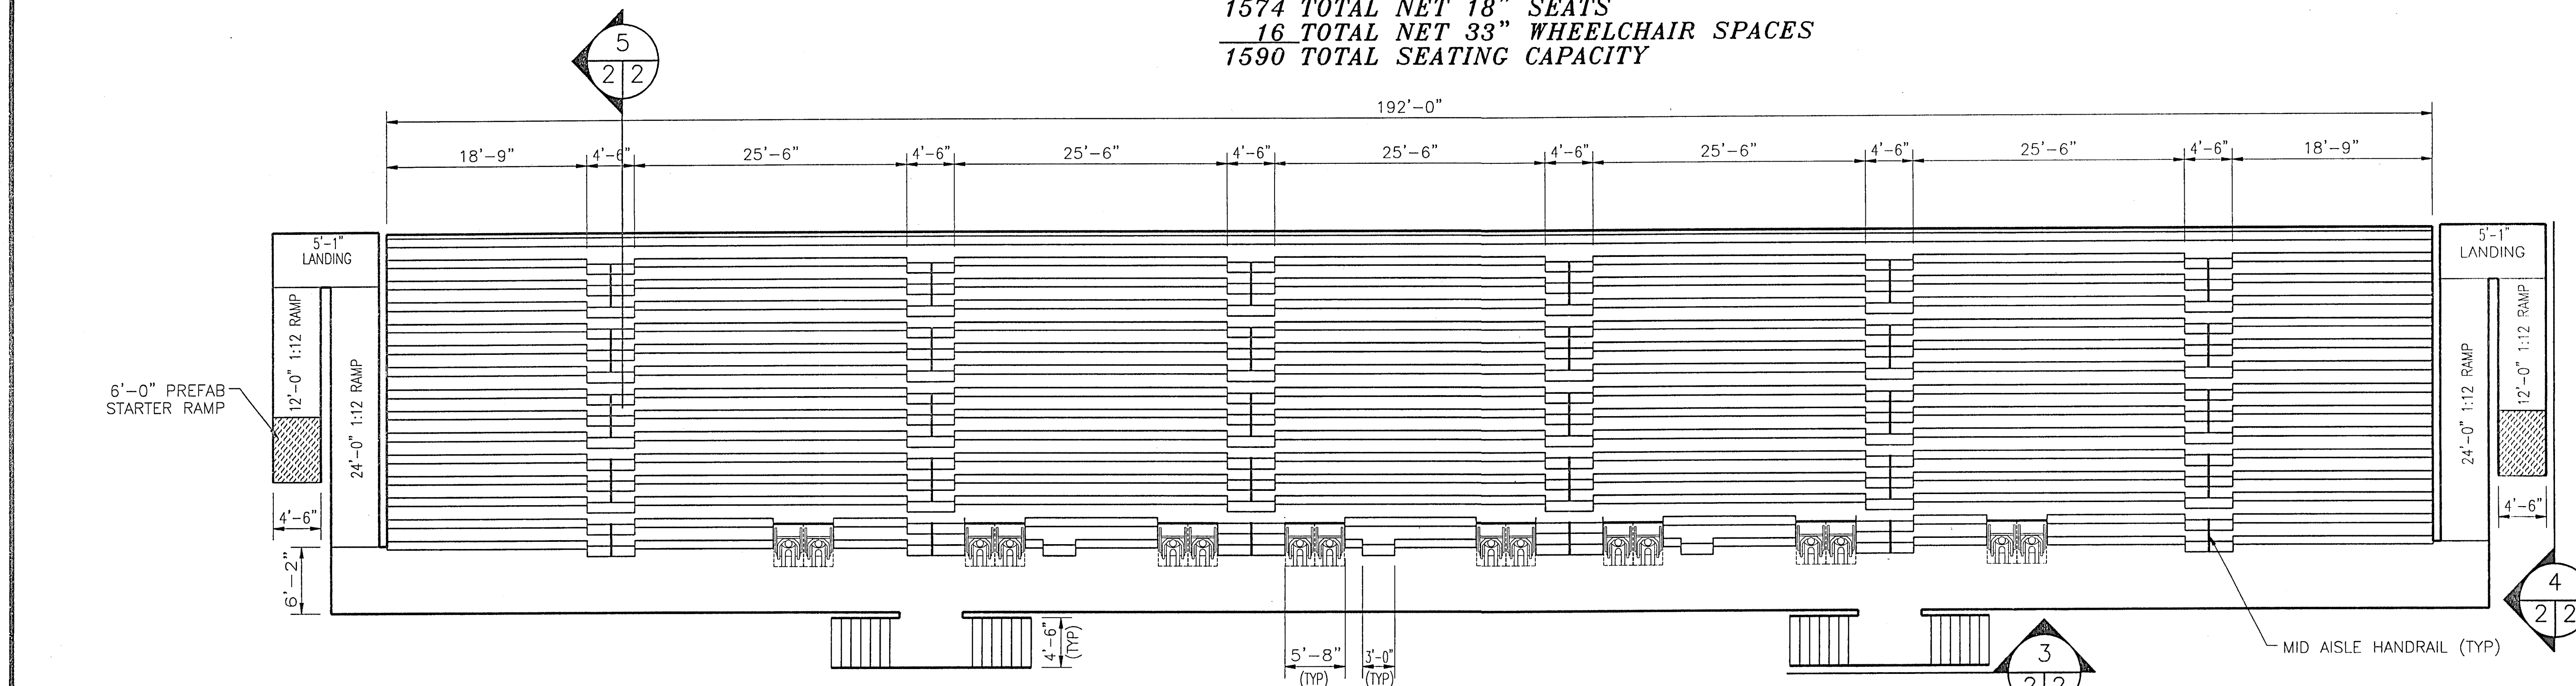

1 SEATING LAYOUT
SCALE: 1/8" = 1'-0"

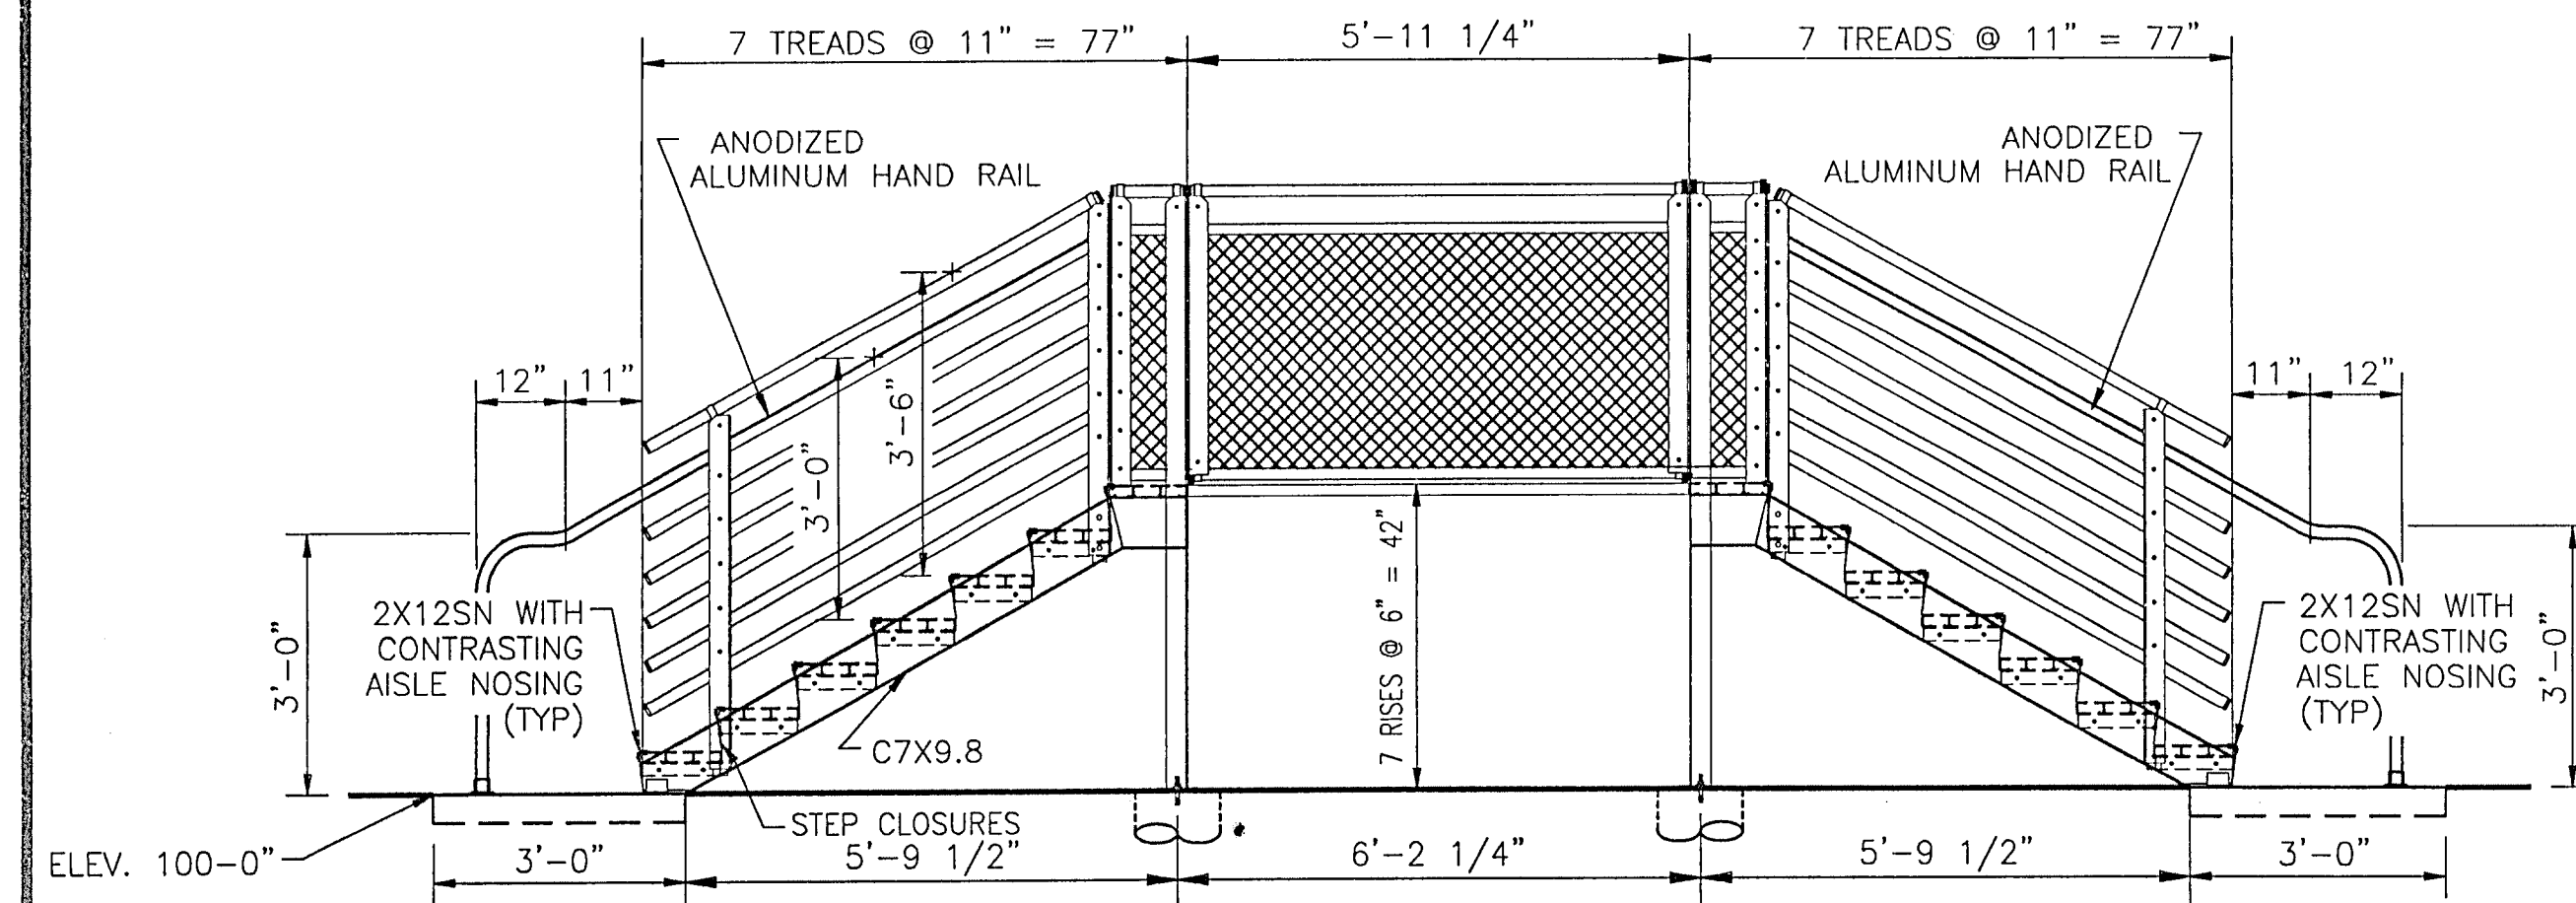

3 42" EXIT STEP DETAIL
SCALE: 1/8" = 1'-0"

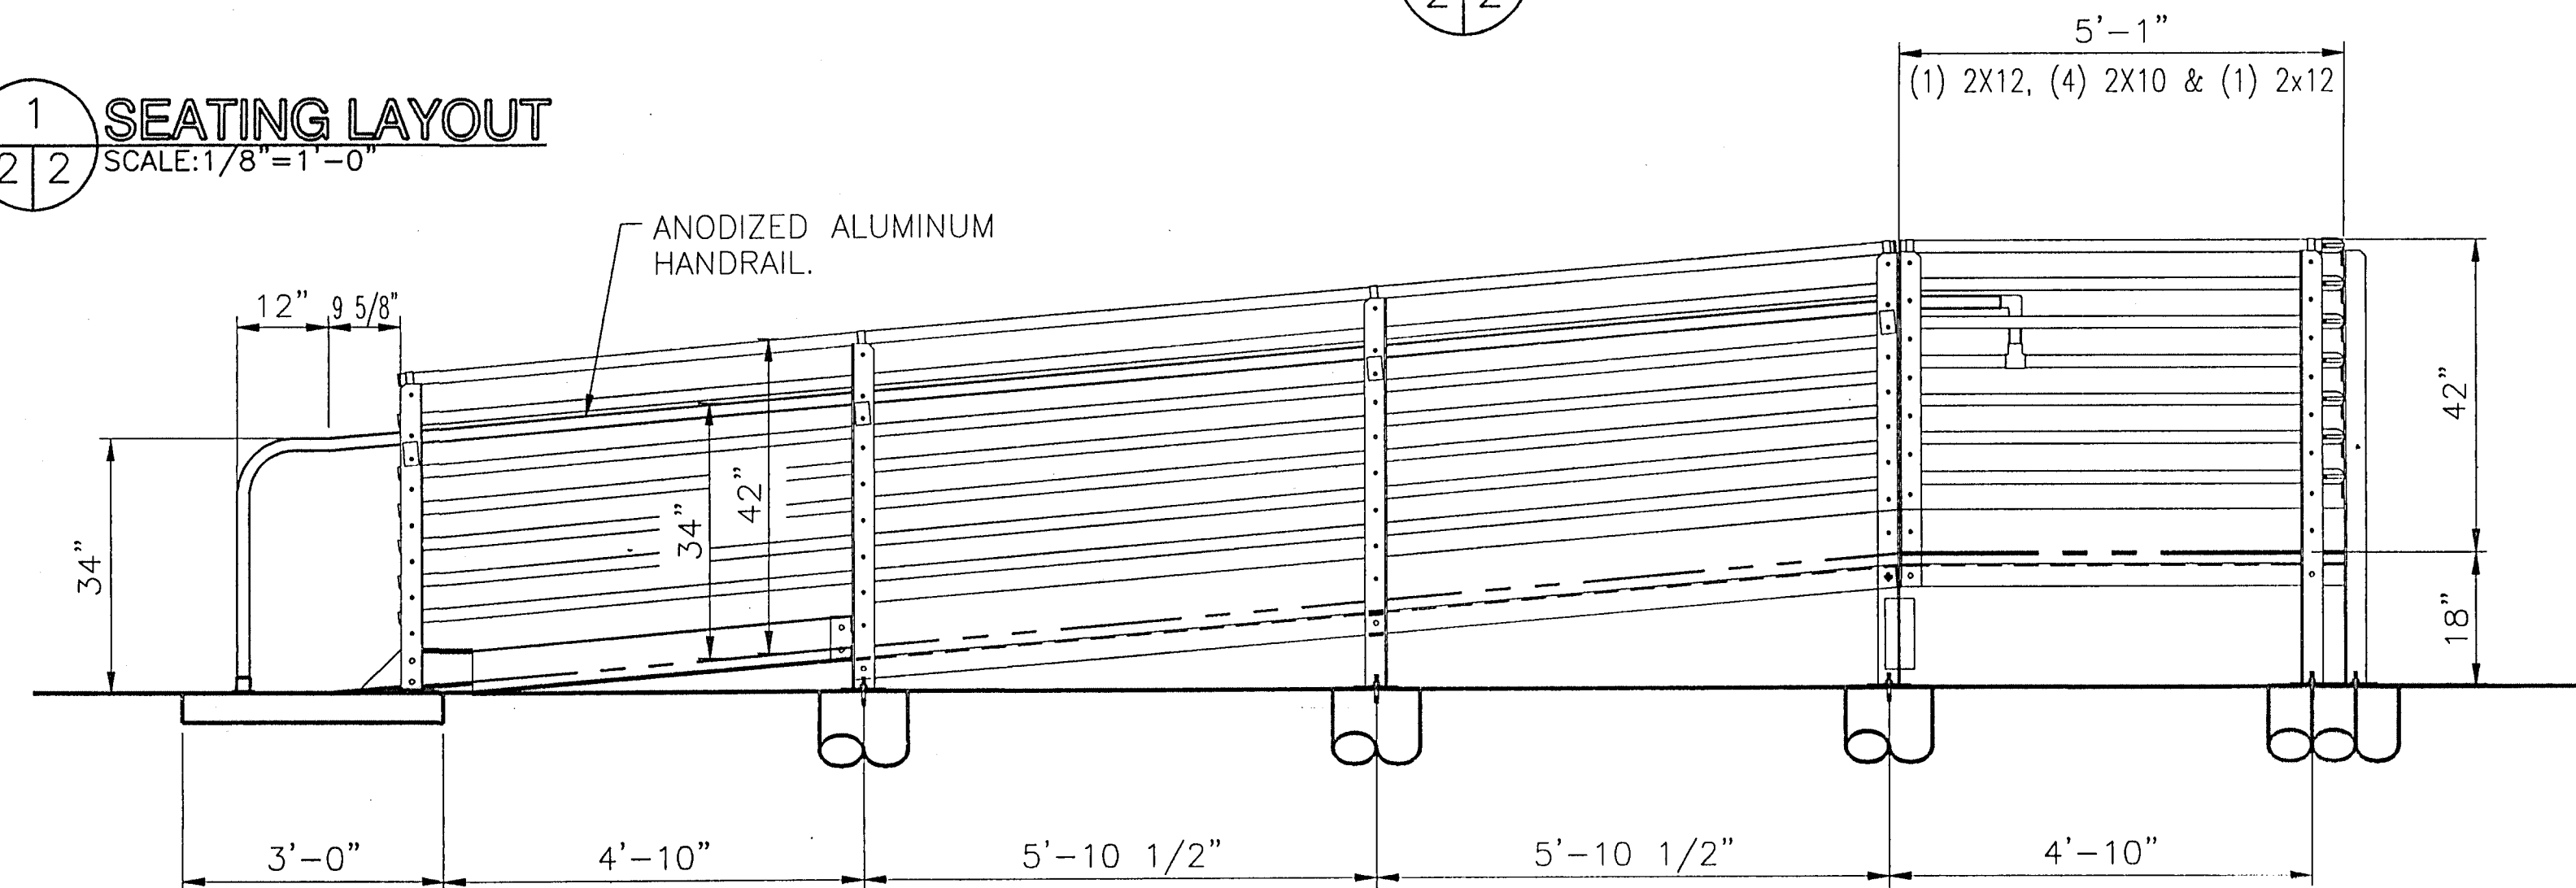


4 18" RAMP DETAIL
SCALE: 1/8" = 1'-0"


CHECKED AND FORWARDED TO A/E
☐ REVISE AND RESUBMIT
☐ INSUFFICIENT INFORMATION

Checking is only for conformance and compliance with the information given in the Contract Documents. Contractor is responsible for dimensions to be confirmed and correlated at the job site, for information that pertains solely to the fabrication processes or to techniques of construction and for coordination of the work of all trades.

BY MEB
DATE 9/16/97
CONSTRUCTION CONTROL
FORT WAYNE, INDIANA

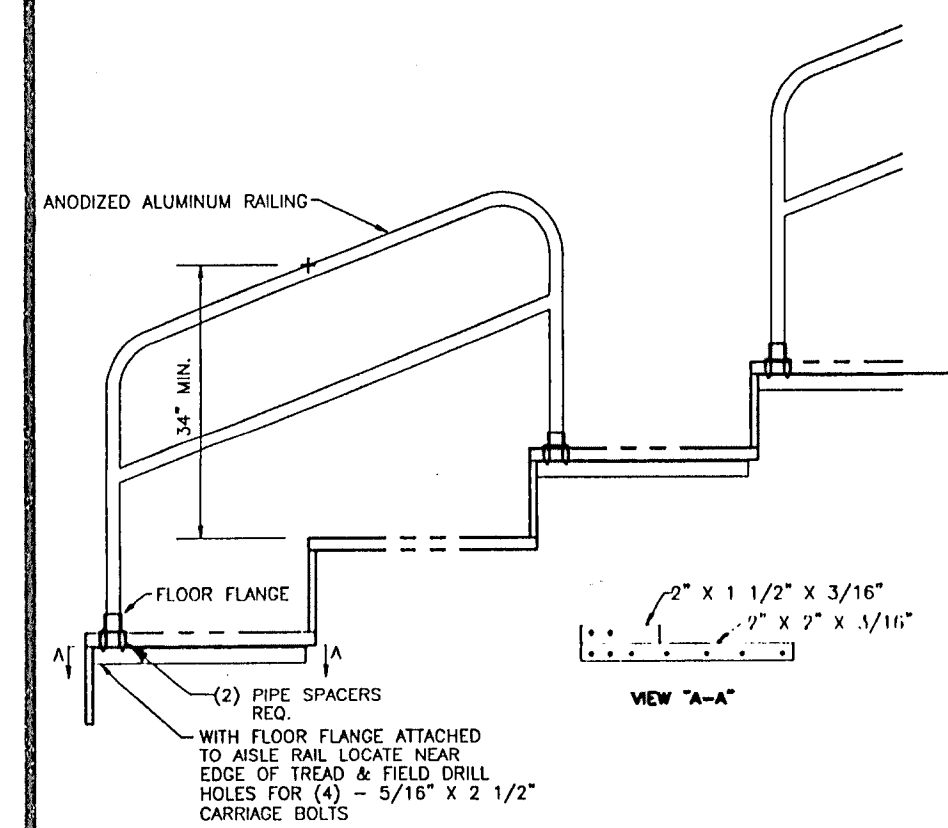

5 MID AISLE INST. DETAIL
NOT TO SCALE

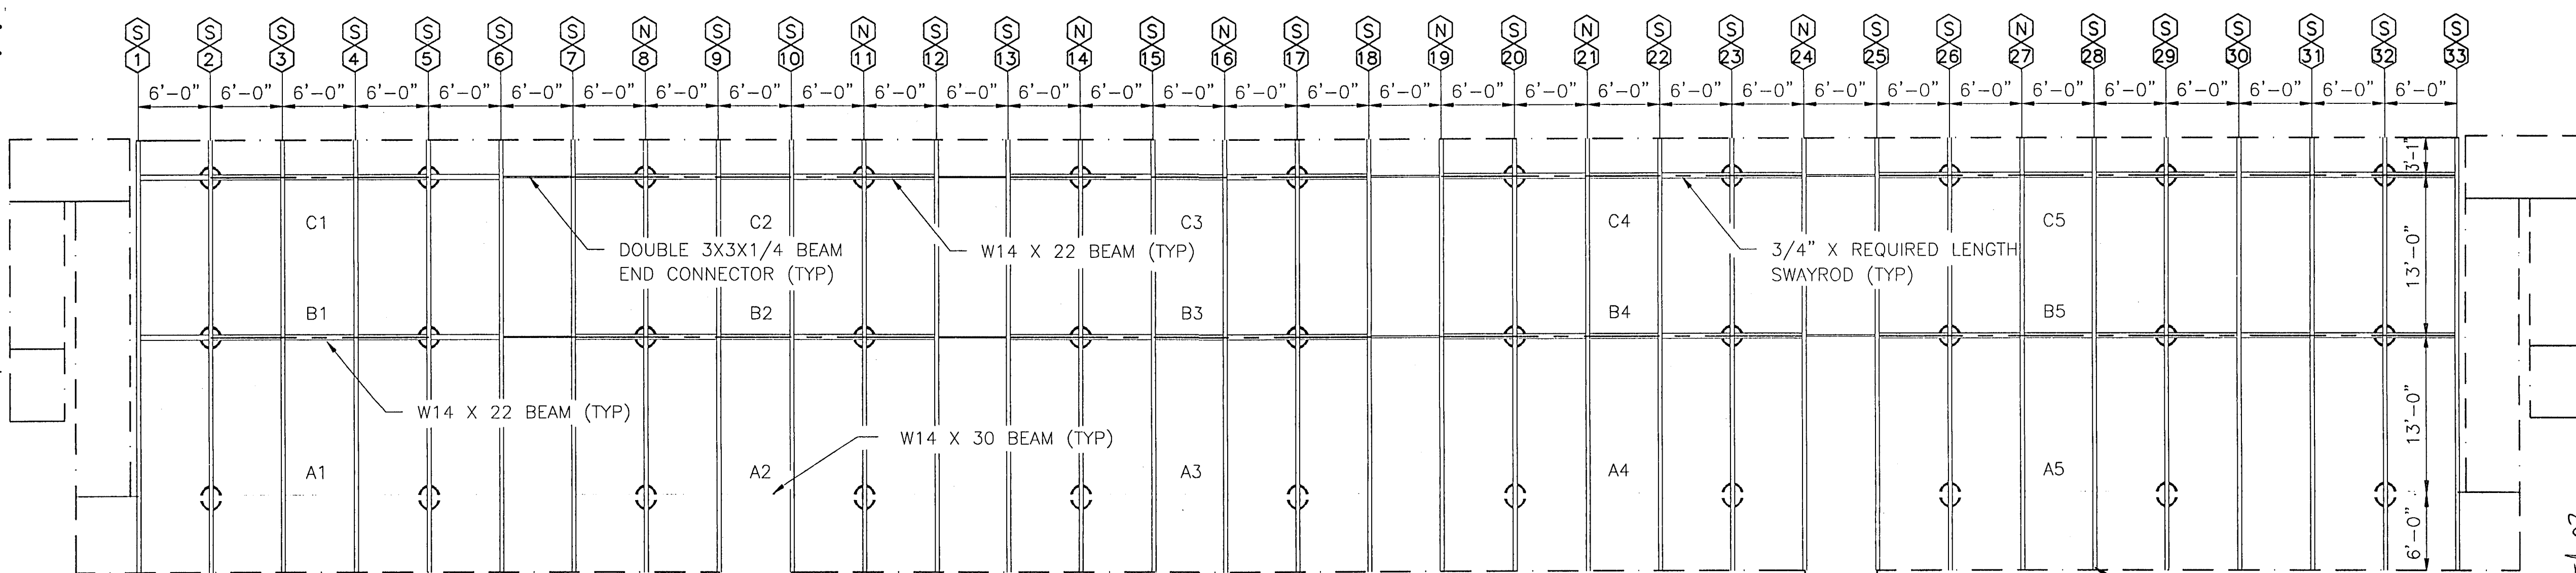

2 UNDERSTRUCTURE LAYOUT
SCALE: 1/8" = 1'-0"

DETAIL NUMBER
3102 SHEET TAKEN FROM
THIS DRAWING AND ALL INFORMATION THEREIN
IS THE PROPERTY OF SADLER GROUP AND SHALL
NOT BE REPRODUCED OR COPIED WITHOUT THE
WRITTEN CONSENT OF SADLER GROUP. THE DRAWING IS LOANED
TO THE CLIENT AND IS TO BE USED ONLY FOR THE
PROJECT SPECIFICALLY IDENTIFIED IN THE
DRAWING. IT IS NOT TO BE USED FOR ANY OTHER
PROJECT OR FOR ANY OTHER PURPOSE.
NATIONAL COPYRIGHT LAW.

THE SADLER GROUP
STRUCTURAL ENGINEERS
(817) 332-1074 • 500 MAIN STREET SUITE 707 • FORT WORTH, TX. 76102
Southern
BLEACHER COMPANY
PO Box One, Graham, TX 76650 USA
940/249-0733 Toll Free: 800/433-0912
Fax: 940/549-1365
Established 1946
GRANDSTANDS • BLEACHERS • STADIUMS

9/24/97
SADLER
No. 1980018
SITE OF
PROPOSED
CONSTRUCTION
10/10/97

PLAN VIEW
192'-0" X 15 ROWS / 24" TREAD
DUNELAND SCHOOL CORP.
GRANDSTANDS
CHESTER, INDIANA

9714-02
DATE 8/26/97
JOB NUMBER 97165
SHEET 2 OF 6
SDC