


PLAN  
ITEM #31 UTENSIL WASHING SINK  
3/4" = 1'-0"

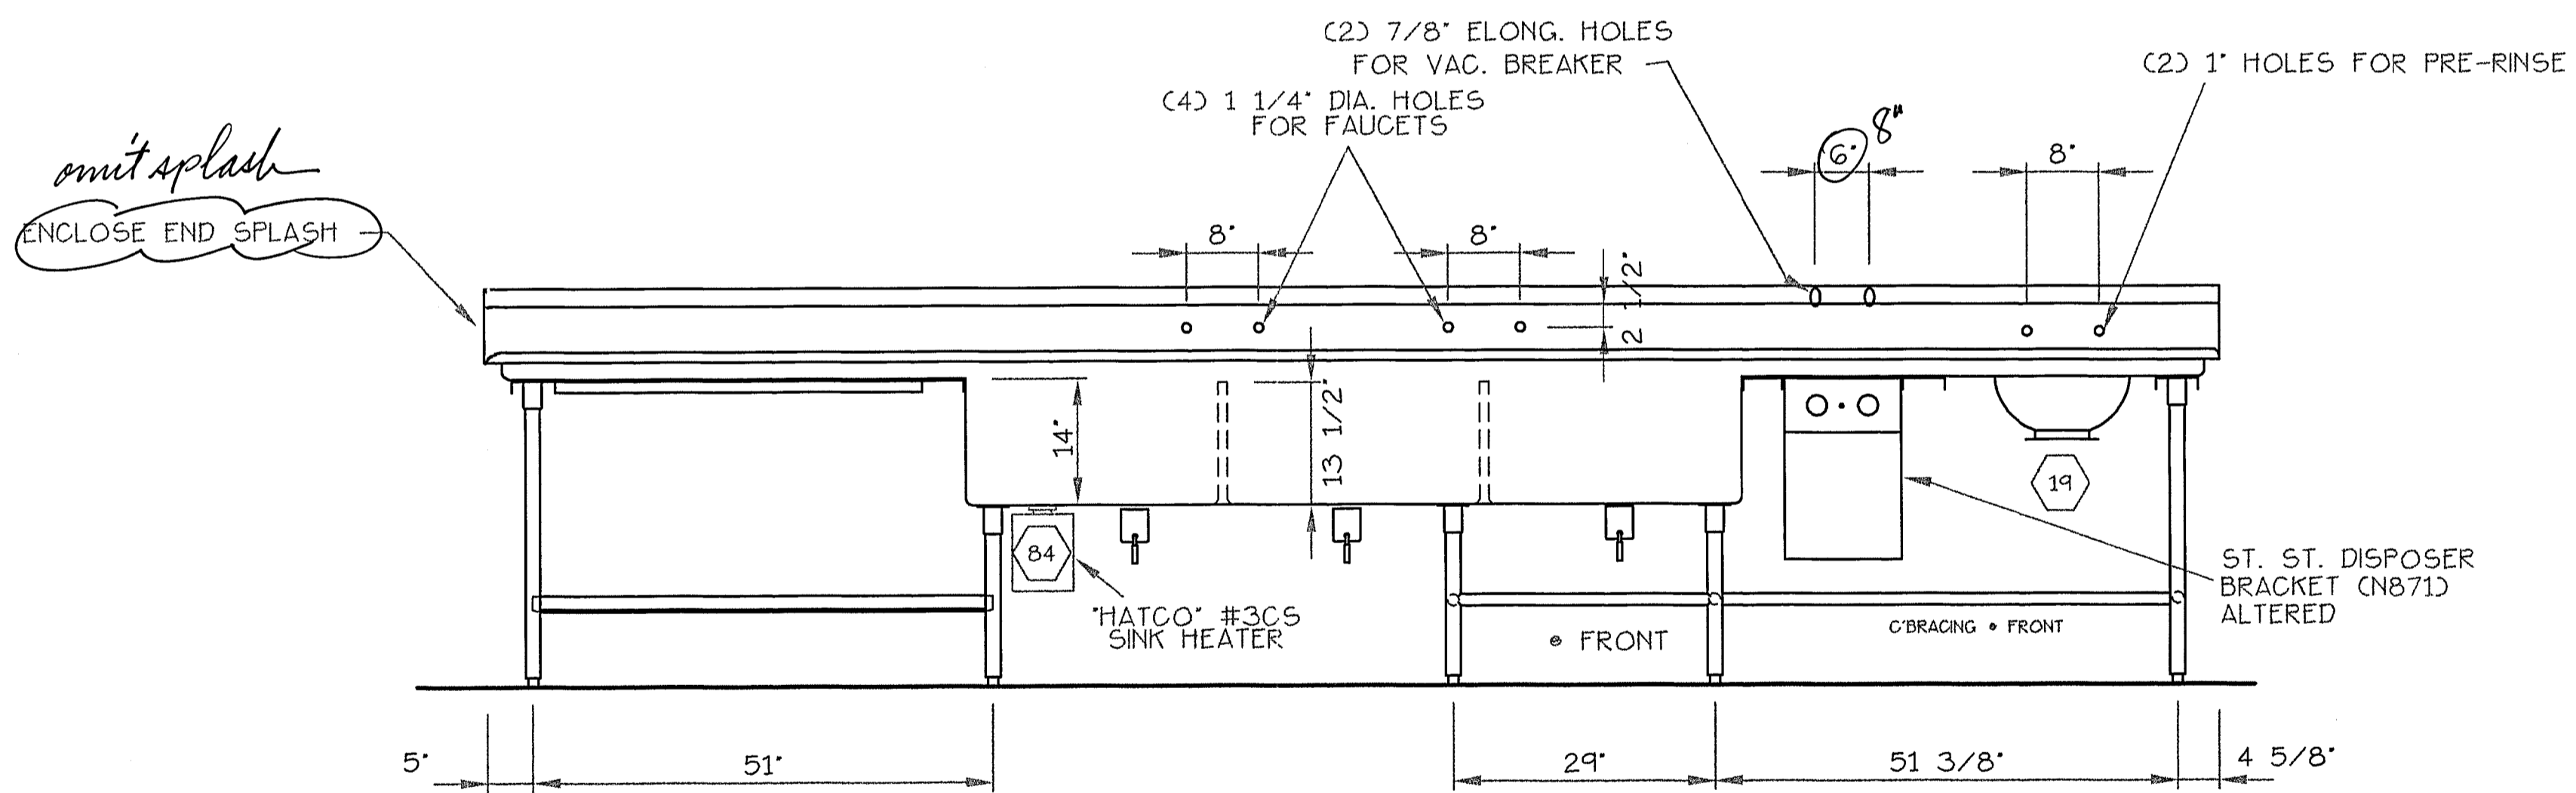

ELEVATION  
3/4" = 1'-0"

TOP: 14 GA. ST. ST. CONSTRUCTION-REIN. W/ 12 GA. ST. ST. CHANNEL-STUD WELD + CAP W/C.P.L. CAP NUTS-SOUND DEADEN-CAULK SUPPORT CAHNNELS


SINK: 14 GA. ST. ST. 3/4" R. CONSTRUCTION-"COMPONENT HARDWARE" D50-7200 ROTARY WASTE W/O OVERFLOW-ST. ST. HANDLE SUPPORT (N862)-ST. ST. APRON

LEGS: FULLY ENCLOSED ST. ST. GUSSETS-1 5/8" DIA. ST. ST. LEGS W/ADJ. BULLET FEET-1 1/4" DIA. ST. ST. CROSSBRACING-FULLY WELD. GRIND. + POLISH


UNDERSHELF: 16 GA. ST. ST. CONSTRUCTION WITH ANGLE REINFORCEMENT FULLY WELD. GRIND. + POLISH

SHIP TO SHOP: BY INDIANA REST EQUIP.

"RED GOAT" DISPOSAL CONE

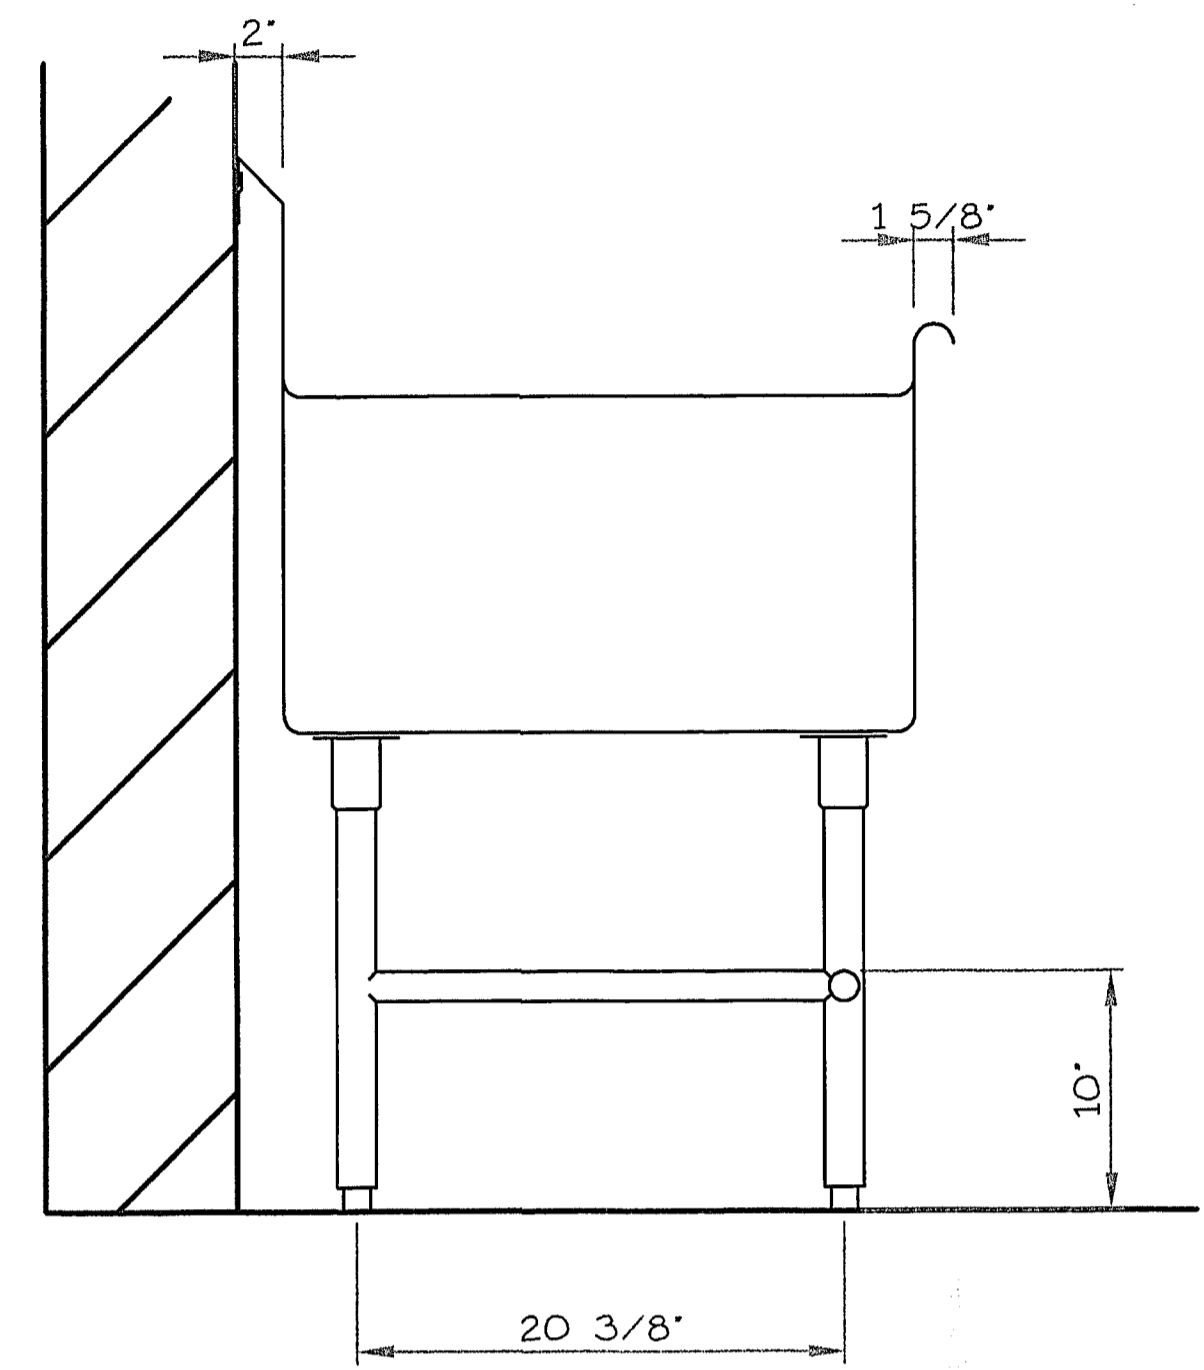

SECTION A-A  
1 1/2" = 1'-0"

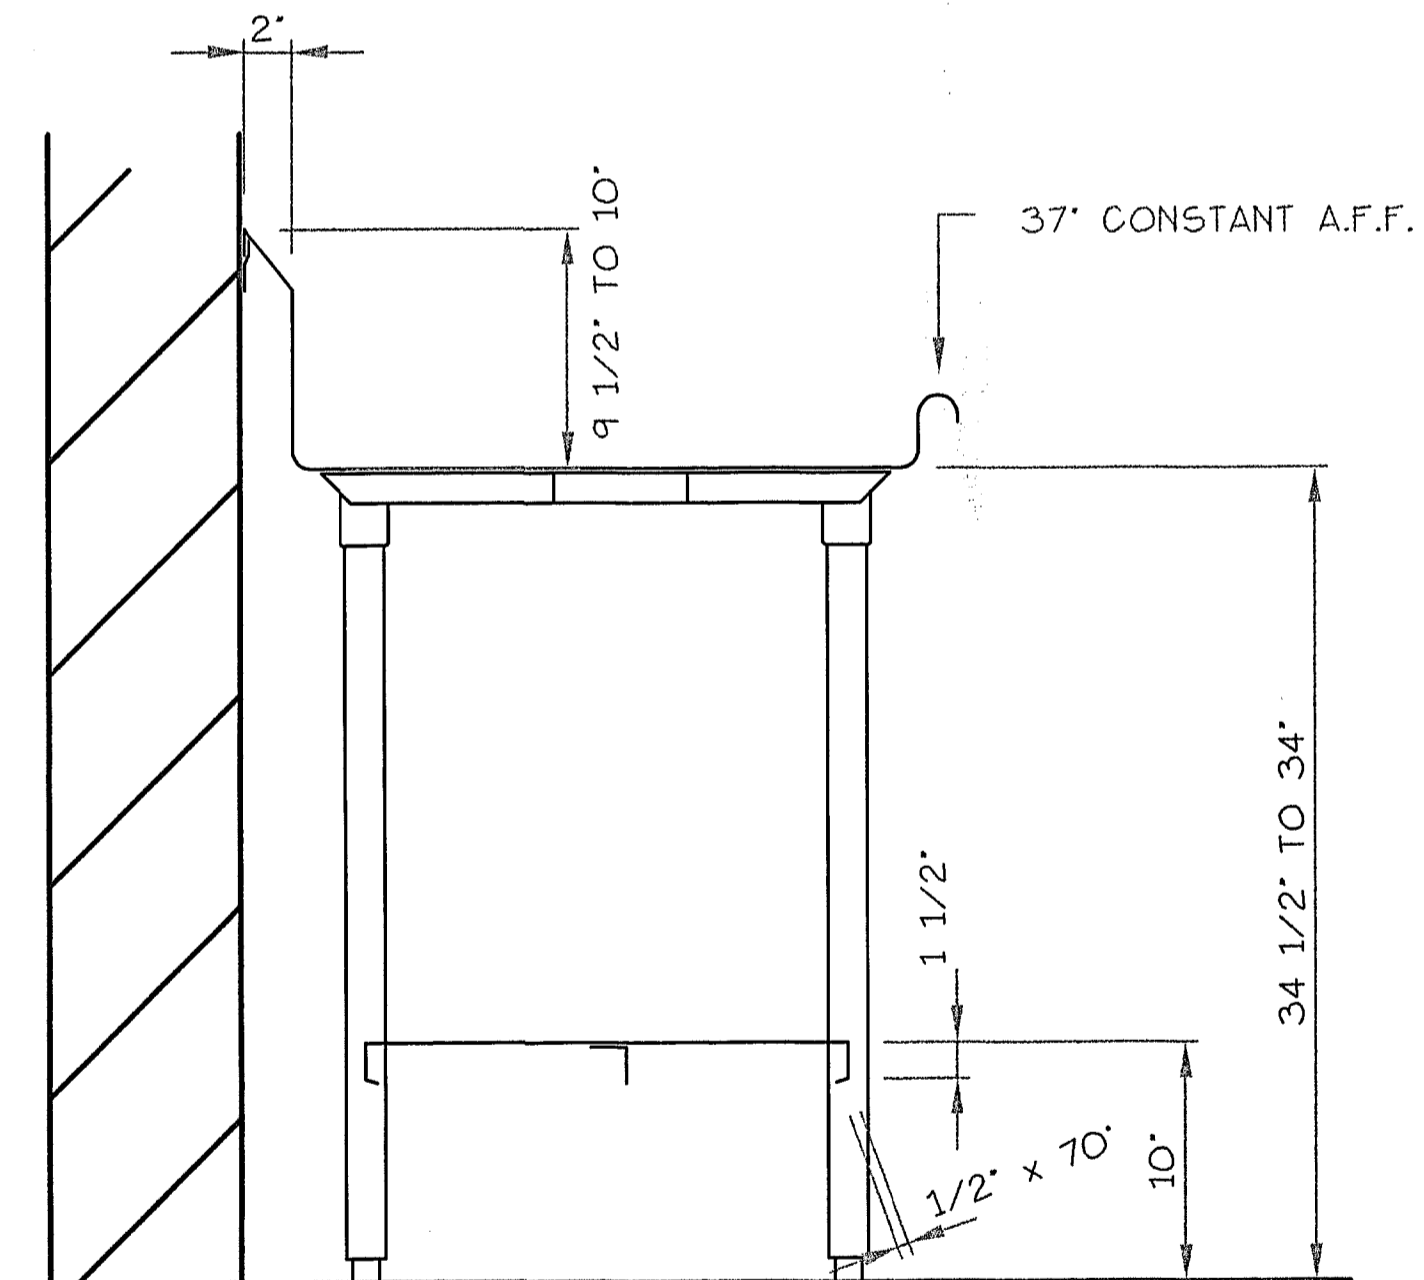

SECTION B-B  
1 1/2" = 1'-0"

This Contractor's submittal has been reviewed for general compliance with the contract documents. Contractor is responsible for dimensions, and compliance with design requirements.

By: *[Signature]* Date: *3.2.98*

VORNDRAN & ASSOCIATES  
Food Service Consultants

FOODSERVICE CONSULTANT  
VORNDRAN & ASSOCIATES


☒ CHECKED AND FORWARDED TO A/E.  
☐ REVISE AND RESUBMIT  
☐ INSUFFICIENT INFORMATION

Checking is only for conformance and compliance with the information given in the Contract Documents. Contractor is responsible for dimensions to be confirmed and corrected at the job site for information that pertains solely to the fabrication processes or to techniques of construction and for coordination of the work of all trades.

BY *MEA*  
DATE *2/26/98*  
CONSTRUCTION CONTROL  
FORT WAYNE, INDIANA

NOTE: ALL ITEMS SUBJECT TO NORMAL SHEET METAL TOLERANCES $\pm 1/8"$ .	JOB NO.
THESE PLANS AND THE DESIGNS CONTAINED HEREIN ARE THE PROPERTY OF NORTHERN STAINLESS FABRICATING INC., AND MAY NOT BE REPRODUCED OR USED BY ANYONE, EITHER ALL OR IN PART, WITHOUT FIRST SECURING OUR WRITTEN PERMISSION.	5969
Dealer Responsibility Dealer to review for final approval, check, and provide all dimensions accordingly for all items before fabrication can proceed.	SHEET NO.
Signature Approval: _____ Name _____ Date _____	1 of 14
ITEM NO. 31	

REVISIONS	BAM	MBG	DATE
REF. 5754 SH 11			
REF. 5079 SH 10			
REF. 5510 SH 10			

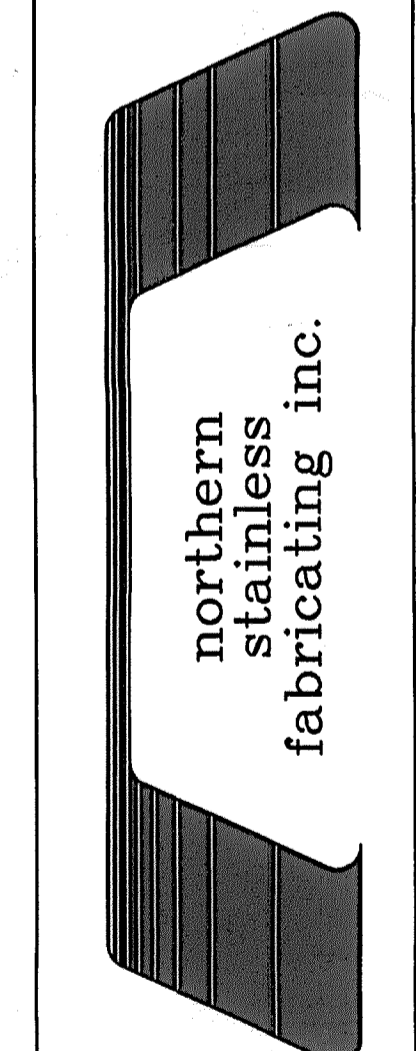

IDE - KITCHEN EQUIP. SHOP DWGS. - MRG. NORTHERN STAINLESS (Approval = 3.9.98)