

MATCHLINE

DRAWING 2 OF 5

AREAS EXCEEDING 10"  
REQUIRE BARRIER BOARD.

MATCHLINE

NOTES:  
1) INSULATION SHOWN ON THIS DRAWING IS FOAMULAR BY OWENS CORNING. INSULATION IS EXTRUDED POLYSTYRENE.  
2) LAY TAPERED BOARDS BY LETTER AS INDICATED. THE NUMBERS FOLLOWING EACH LETTER REFER TO THICKNESS OF FILL BOARDS AS PER CROSS SECTION VIEW.  
3) ALL HIPS, VALLEYS AND CRICKETS ARE TO BE FIELD CUT. MATERIAL WILL BE SUPPLIED.  
4) ROOF DIMENSIONS USED TO DRAW THIS PLAN WERE FROM ARCHITECTS PLANS SUBMITTED. THE ROOFING CONTRACTOR SHOULD CHECK DIMENSIONS BEFORE MATERIAL HAS BEEN MANUFACTURED AND CONTACT OWENS CORNING TAPER CONTROL CENTER OF ANY CHANGES. ANY ALTERATIONS AFTER PRODUCTION OF MATERIAL MAY RESULT IN ADJUSTMENT OF ORIGINAL PRICE.  
5) APPROVED SIGNED SHOP DRAWINGS MUST BE RETURNED TO OWENS CORNING TAPER CONTROL CENTER PRIOR TO RELEASE OF MATERIAL FOR FABRICATION.  
6) MANUFACTURER IS NOT RESPONSIBLE FOR SAFEKEEPING NOR MATERIAL SHORTAGES AFTER SIGNING FOR RECEIPT OF OWENS CORNING MATERIAL.  
7) IT IS REQUIRED THAT THE ROOFING MEMBRANE AND INSULATION BE BALLASTED IMMEDIATELY AFTER PLACEMENT. FOR MORE DETAILS PLEASE REFER TO CURRENT FOAMULAR LITERATURE OR CONTACT YOUR LOCAL OWENS CORNING SALES REPRESENTATIVE.

SECTION TAPERED PANELS:

E 0.50 - 1.00  
F 1.00 - 1.50  
S 0.50 - 0.875  
T 0.875 - 1.25  
U 1.25 - 1.625  
V 1.625 - 2.00

SECTION FILL PANELS:

1.00  
2.00

CRICKET TAPERED PANELS:

Q 0.50 - 1.25  
R 1.25 - 2.00

☒ APPROVED  
☐ APPROVED AS NOTED  
☐ MAKE CORRECTIONS-RESUBMIT  
☐ NOT APPROVED-RESUBMIT  
REVIEW IS ONLY FOR CONFORMANCE WITH THE DESIGN CONCEPT OF THE PROJECT AND COMPLIANCE WITH THE INFORMATION GIVEN ON THE CONTRACT DOCUMENTS. APPROVAL DOES NOT RELIEVE YOUR RESPONSIBILITY FOR DIMENSIONS TO BE CONFIRMED AT THE CITY OR FOR INFORMATION PERTAINING TO FABRICATION TECHNIQUES OR CONSTRUCTION REQUIRED FOR COMPLETE JOB.  
M. KELSO CO., INC.  
DATE: 6-15-98 BY: TLM  
PROJECT: Chesterton

NORTH

Extruded Polystyrene insulation  
**FOAMULAR**

OWENS CORNING  
SPECIALTY and FOAM PRODUCTS  
170 South Ave. P.O. Box 455  
Telmide, Ohio 44278  
1-800-875-1594 FAX: (330) 633-7316  
TAPER CONTROL CENTER



Project: CHESTERTON H.S.  
SWIMMING POOL  
CHESTERTON, INDIANA

Architect: FANNING & HOWEY

Material: THERMAPINK 25




Roofers: KELSO ROOFING

Scale: 1/16" = 1'00" Drawn: T.L.I.  
Slope: VARIES Checked: R.E.G.  
Date: 6/11/98 T-218974

Drawing number: 2 of 7

REVISIONS

1. REVISED DRAWING FOR RELOCATION OF ROOF DRAINS PER W. R. KELSO 11/3/97.
2. CHANGED TAPER LAYOUT AND SADDLE SLOPE AND THICKNESS PER FANNING & HOWEY 2/6/98
3. NO CHANGES THIS PAGE 4/14/98
4. CHANGED SLOPES IN VARIOUS ROOF AREAS AND MOVED DRAINS. 5/7/98
5. CHANGED DIRECTION OF SLOPE TO MAINTAIN 36' MAX DISTANCE BETWEEN DRAINS. 6/11/98

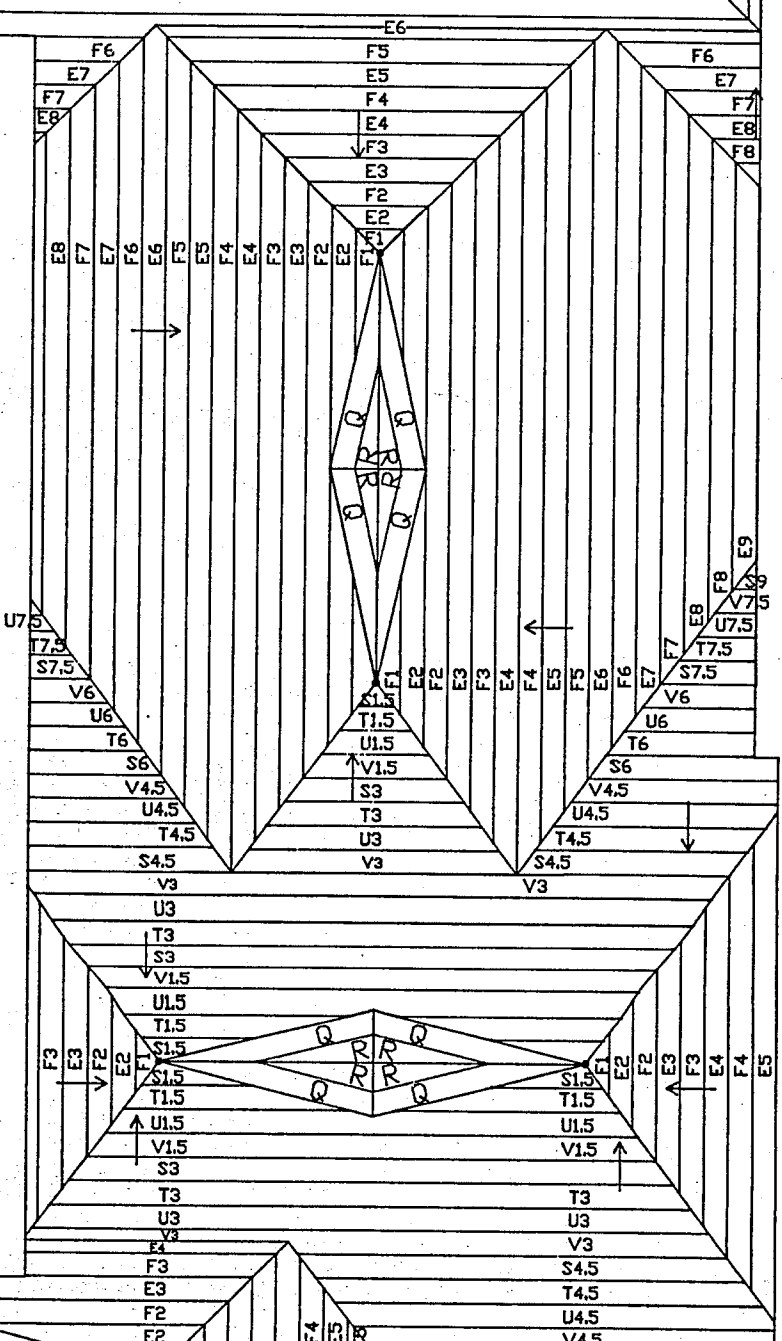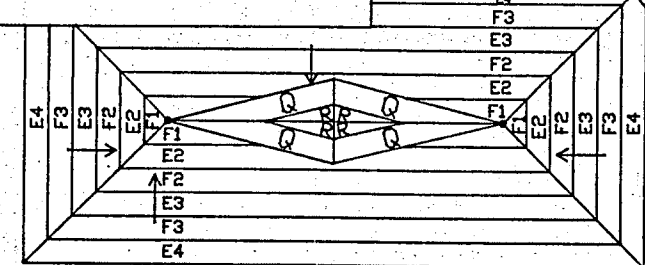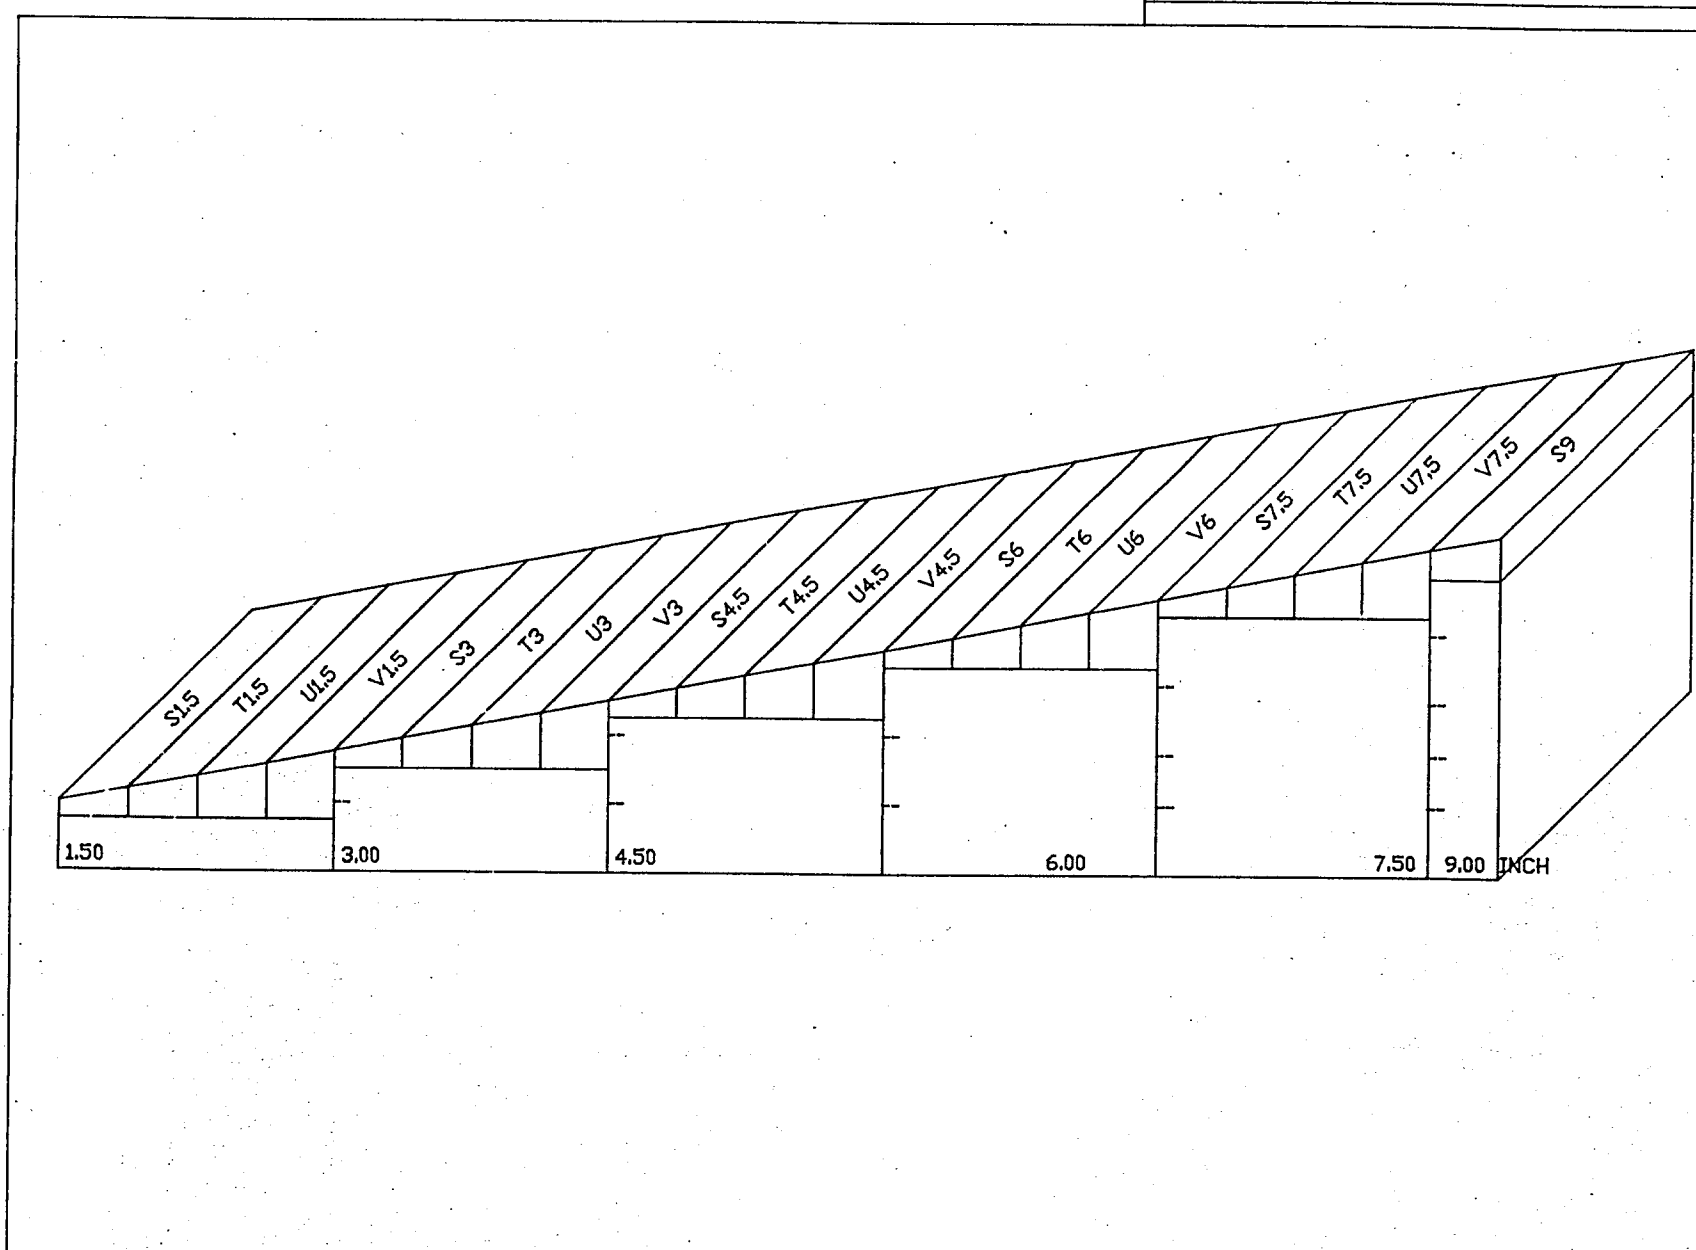

SHOP DRAWING/SUBMITTAL REVIEW STATUS		
ARCHITECT'S DETERMINATION	RESPONSE REQUIRED	
No Exceptions Taken <input type="checkbox"/>	Rejected <input type="checkbox"/>	Confirm <input checked="" type="checkbox"/>
Note Markings <input type="checkbox"/>	Comments Attached <input checked="" type="checkbox"/>	Resubmit <input type="checkbox"/>
Architect's review is only for checking conformance with the information given, and with the design concept expressed, in the Contract Documents. Any and all markings and/or comments applied by the Architect shall not relieve the Contractor from compliance with the Contract Documents, nor allow departures therefrom. The Contractor remains responsible for details and accuracy, for confirming and correlating all quantities and dimensions, for selecting fabrication processes and techniques of assembly, for performing his work in a safe manner, and for coordinating his work with all other trades.		
FANNING & HOWEY ASSOCIATES, INC.		ARCHITECTS/ENGINEERS
By: LEC		Date: 6-17-98

☒ CHECKED AND FORWARDED TO A/E

☐ REVISE AND RESUBMIT  
☐ INSUFFICIENT INFORMATION

Checking is only for conformance and compliance with the information given in the Contract Documents. Contractor is responsible for dimensions to be confirmed and correlated of the job site for information that pertains solely to the fabrication processes or to techniques of construction and for coordination of the work of all trades.

BY: MEA

DATE: 6/16/98

CONSTRUCTION CONTROL

FORT WAYNE, INDIANA

