

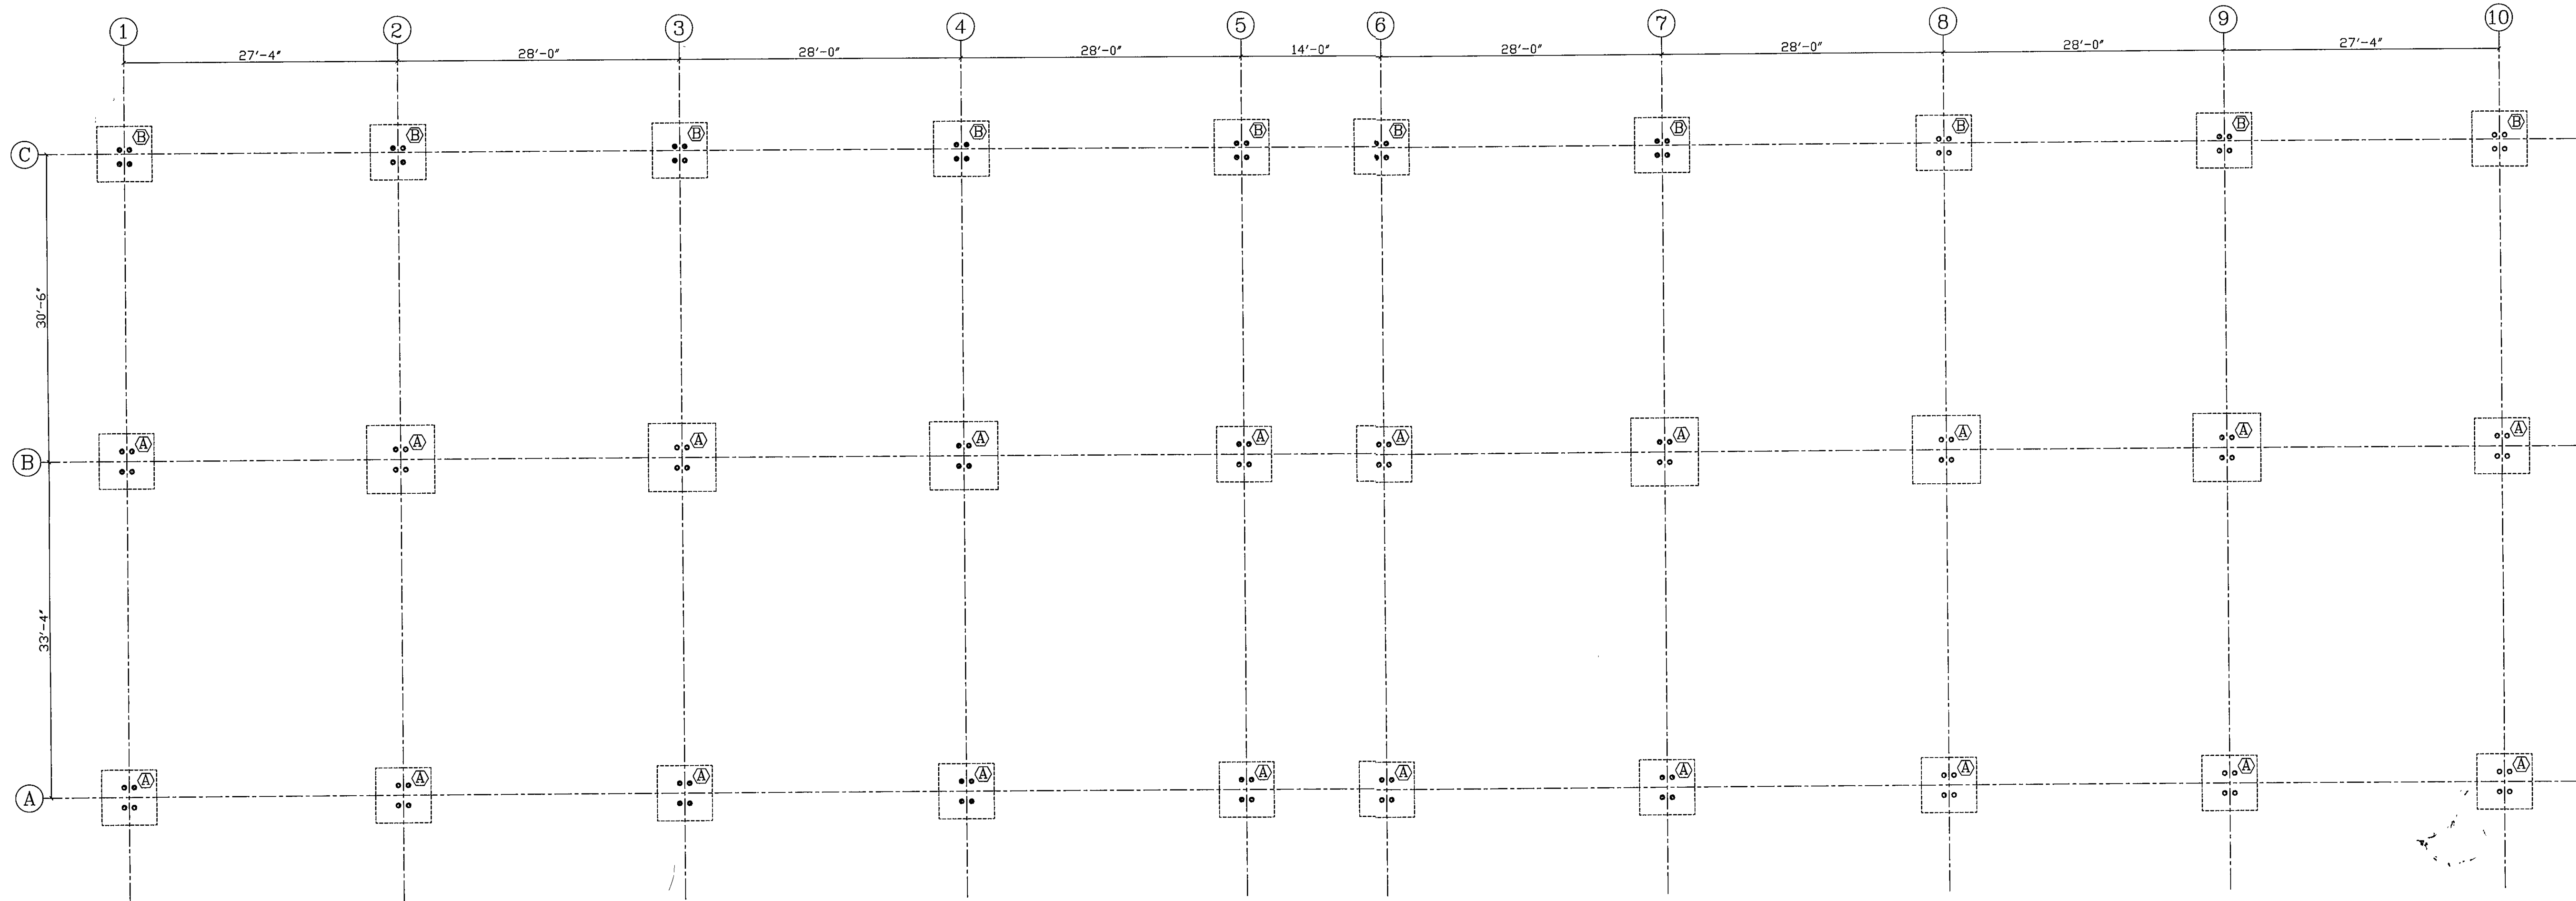


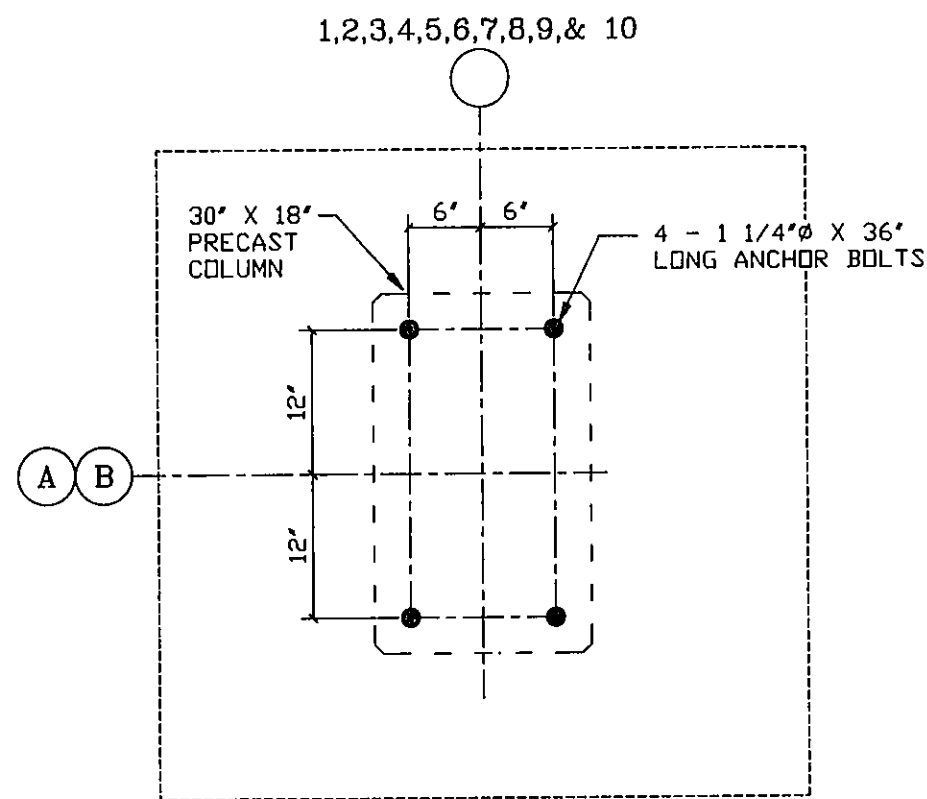

TOP OF ALL FOOTINGS = -1'-0"


ANCHOR BOLT LAYOUT

SCALE 1/8" = 1'-0"

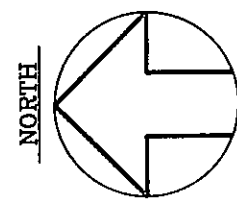


TYPE "A" SETTING DETAIL

4 - 1 1/4" ANCHOR BOLTS

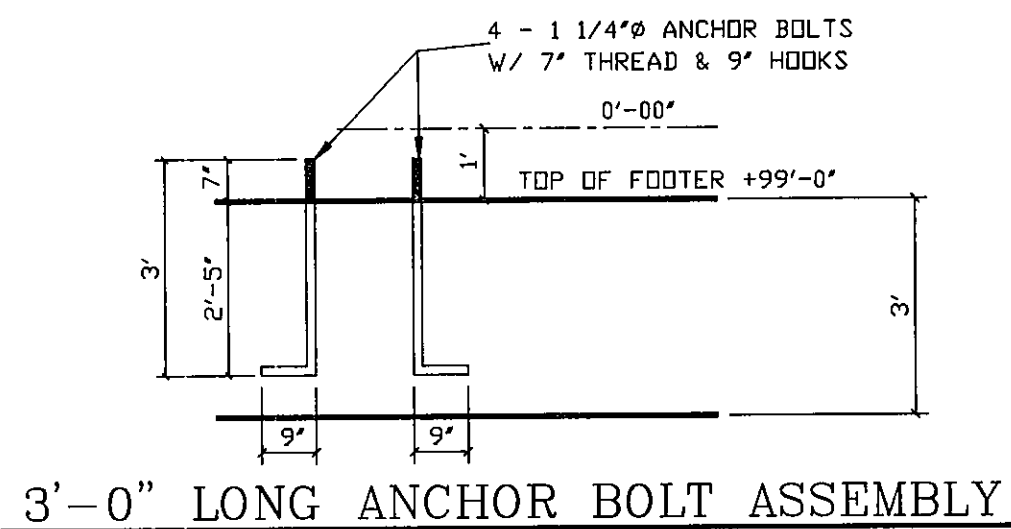

3'-0" LONG ANCHOR BOLT ASSEMBLY

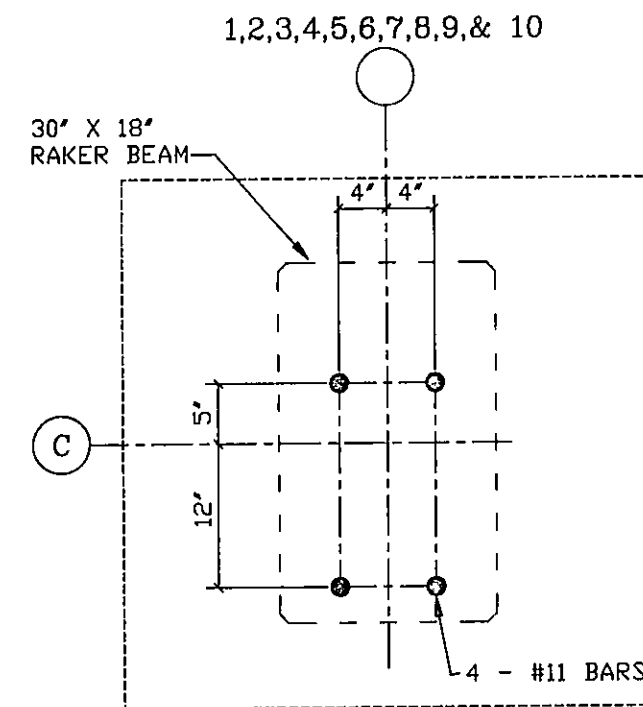


TYPE "B" SETTING DETAIL

4 - #11 BARS CAST IN POURED FOOTER

SHOP DRAWING/SUBMITTAL REVIEW STATUS			
ARCHITECT'S DETERMINATION		RESPONSE REQUIRED	
No Exceptions taken ☒	Rejected ☐	Confirm ☐	
Note Markings ☐	Comments Attached ☐	Resubmit ☐	

Architect's review is only for checking conformance with the information given, and with the design concept expressed, in the Contract Documents. Any and all markings and/or comments applied by the Architect shall not relieve the Contractor from compliance with the Contract Documents, nor allow departures therefrom. The Contractor remains responsible for details and accuracy, for confirming and correlating all quantities and dimensions, for selecting fabrication processes, or techniques of assembly, for performing his work in a safe manner, and for coordinating his work with all other trades.

FANNING/HOWEY ASSOCIATES, INC. ARCHITECTS/ENGINEERING
By [Signature] Date 2/20/98

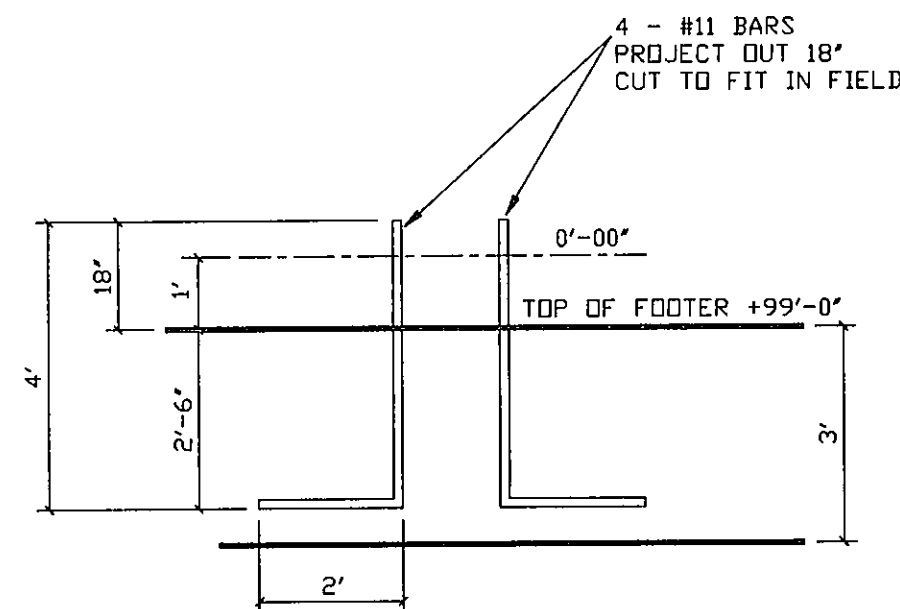

☒ CHECKED AND FORWARDED TO A/E
☐ REVISE AND RESUBMIT
☐ INSUFFICIENT INFORMATION

Checked by [Signature] and compliance with the contract documents. This does not release the supplier from responsibility for quantities, dimensions, performance or other requirements of the contract documents.

BY ME
DATE 2/18/98
CONSTRUCTION CONTROL
FORT WAYNE, INDIANA

PROJECT: Chesterton High School
CONST. MANAGER: Construction Control

ARCHITECT: Fanning/Howey Prof. 95067
GENERAL CONTR: Gough, Inc. Job # 435


SUBMITTED BY: [Signature]
SECTION # 3100 SUBMITTAL # 2

Reviewed by Gough, Inc. to be in compliance with contract documents. This does not release the supplier from responsibility for quantities, dimensions, performance or other requirements of the contract documents.

SIGNATURE [Signature] DATE 2-9-98

UNITS: PRECAST CONCRETE DWGS. (2/20/98)

PROJECT FOR
AMERICAN PRECAST CONCRETE
PREPARED BY
PRECAST CONCRETE SYSTEMS, INC.
SUBSIDIARY OF AMERICAN PRECAST CONCRETE
1030 S. KITLEY AVE
INDIANAPOLIS, INDIANA 46203

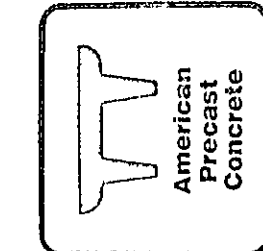

REVISIONS	NO.	DATE	BY	NO.	DATE	BY
	1			2		
	2			3		
	3			4		
	4			5		
	5			6		
	6			7		
	7			8		
	8			9		
	9			10		

ARCHITECT: FANNING/HOWEY ASSOC. INC.
CONTRACTOR: GOUGH, INC.
DRAWN BY: [Signature]
CHECKED BY: [Signature]
DATE: 1-23-98

CHESTERTON HIGH SCHOOL
STADIUM
CHESTERTON, IN

JOB NO: 1278-10
SHEET: 1

AB 1

OF SHEETS