
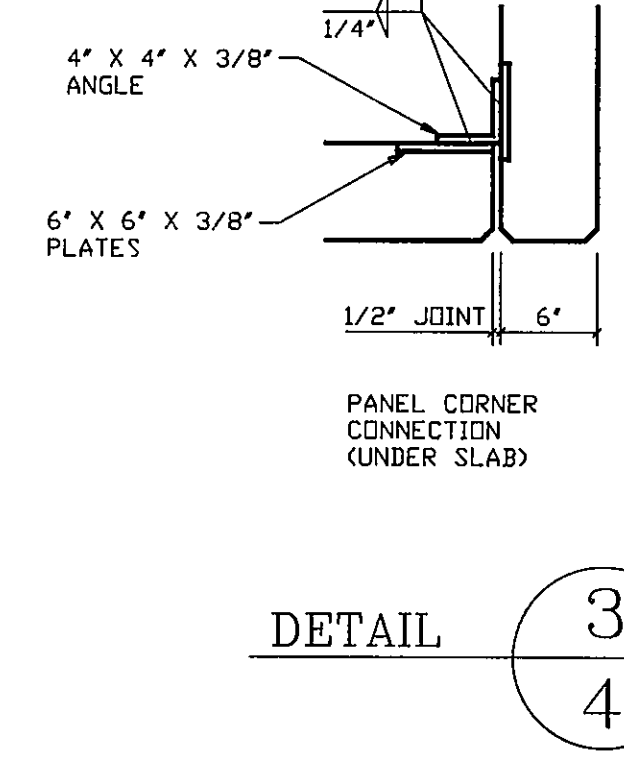
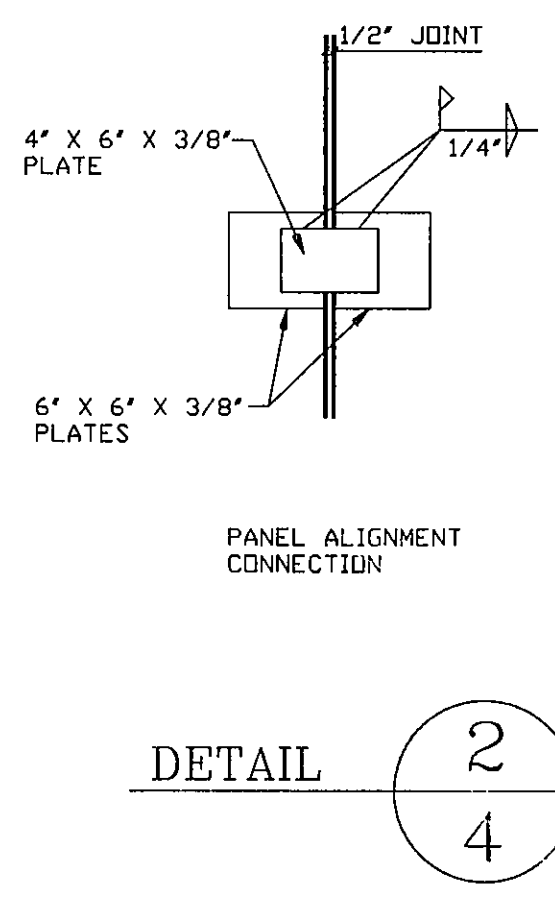
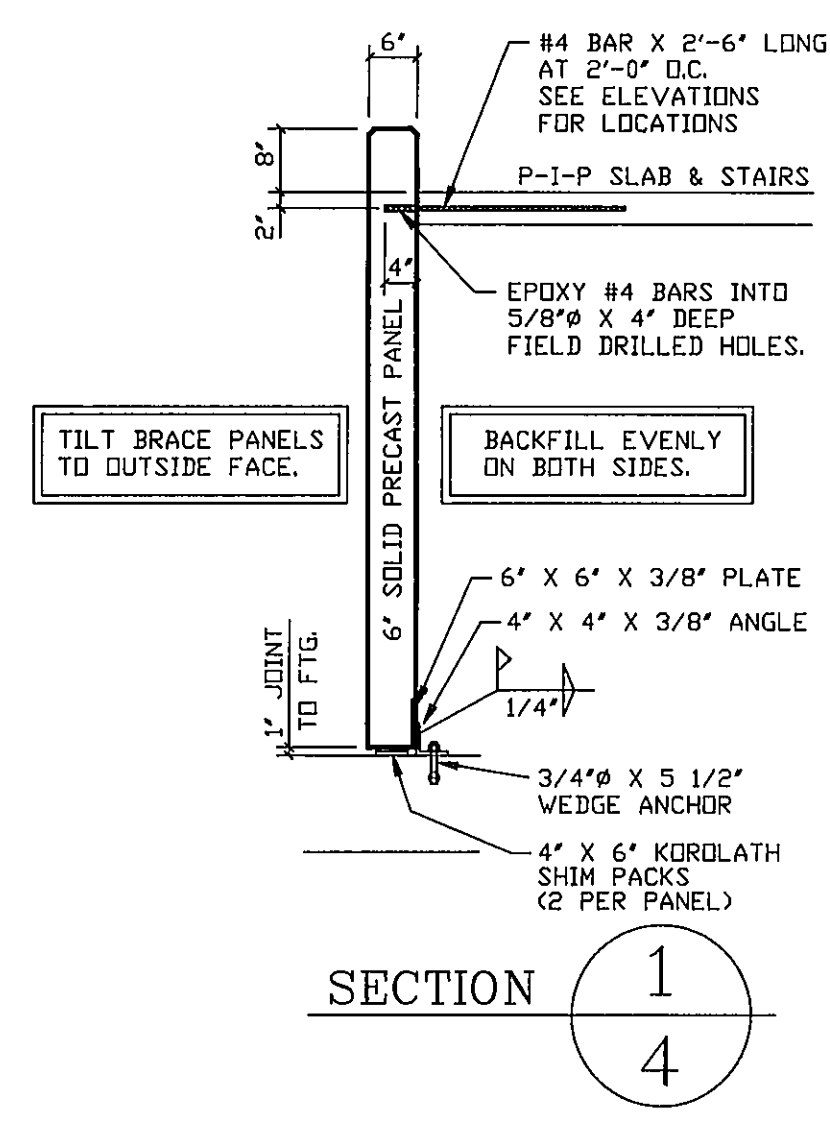


PROJECT: Chesterton High School
CONST. MANAGER: Construction Control
ARCHITECT: Fanning/Howey Proj. 95067
GENERAL CONTR: Gough, Inc. Job #435
SUBMITTED BY: *[Signature]*
SECTION # 3900 SUBMITTAL # 1
Reviewed by Gough, Inc. to be in compliance with contract documents. This does not release the supplier from responsibility for quantities, dimensions, performance or other requirements of the contract documents.
SIGNATURE *[Signature]* DATE 6-24-98



PROJECT FOR
AMERICAN PRECAST CONCRETE
1030 S. KITLEY AVE.
INDIANAPOLIS, INDIANA 46203

American Precast Concrete

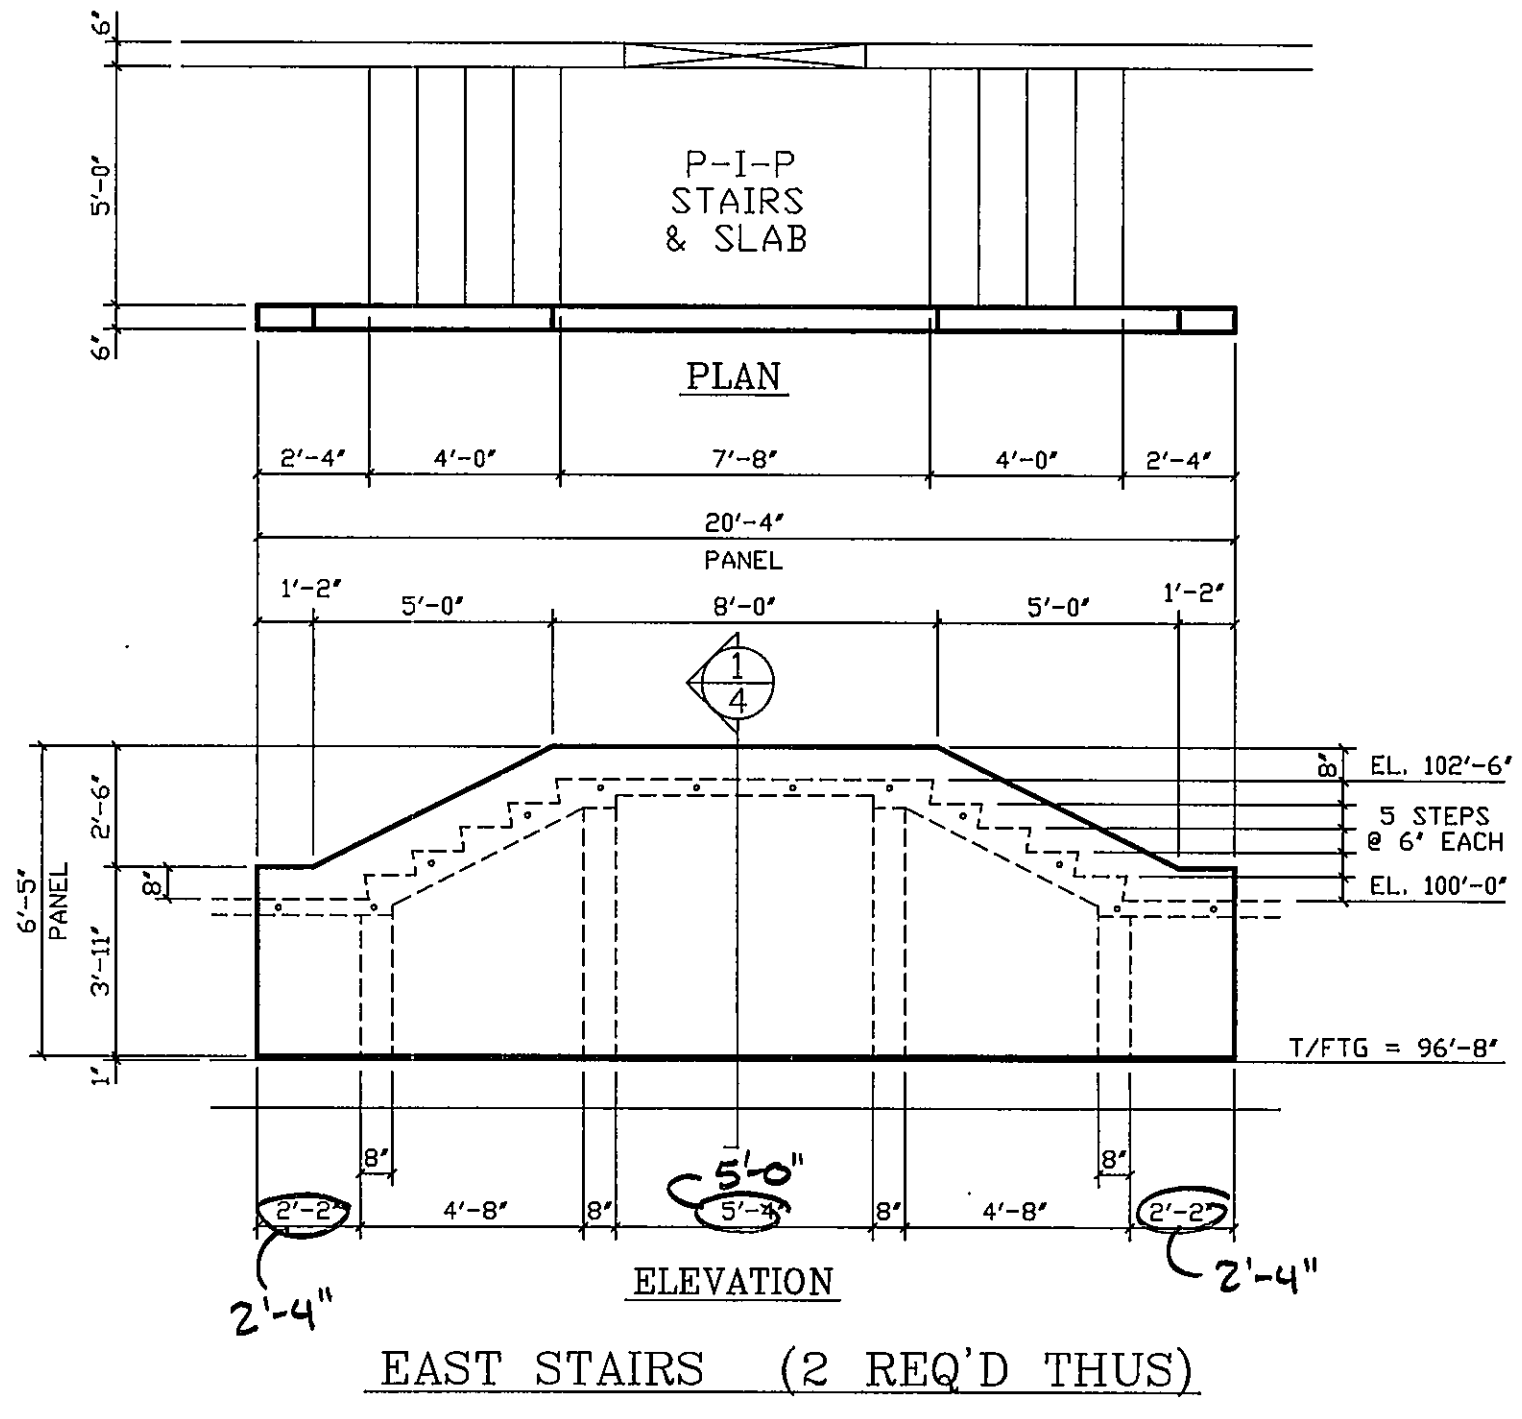

SHOP DRAWING/SUBMITTAL REVIEW STATUS	
ARCHITECT'S DETERMINATION	RESPONSE REQUIRED
No Exceptions Taken ☐	Rejected ☐ Confirm ☐
Note Markings ☒ Comments Attached ☐	Resubmit ☐

Architect's review is only for checking conformance with the information given, and with the design concept expressed, in the Contract Documents. Any and all markings and/or comments applied by the Architect shall not relieve the Contractor from compliance with the Contract Documents, nor allow departure therefrom. The Contractor remains responsible for details and accuracy, for continuing and completing all quantities and dimensions, for selecting fabrication processes or techniques of assembly, for performing the work in a safe manner, and for coordinating his work with all other trades.
FANNING/HOWEY ASSOCIATES, INC. ARCHITECTS/ENGINEERS
By *[Signature]* Date 6-24-98

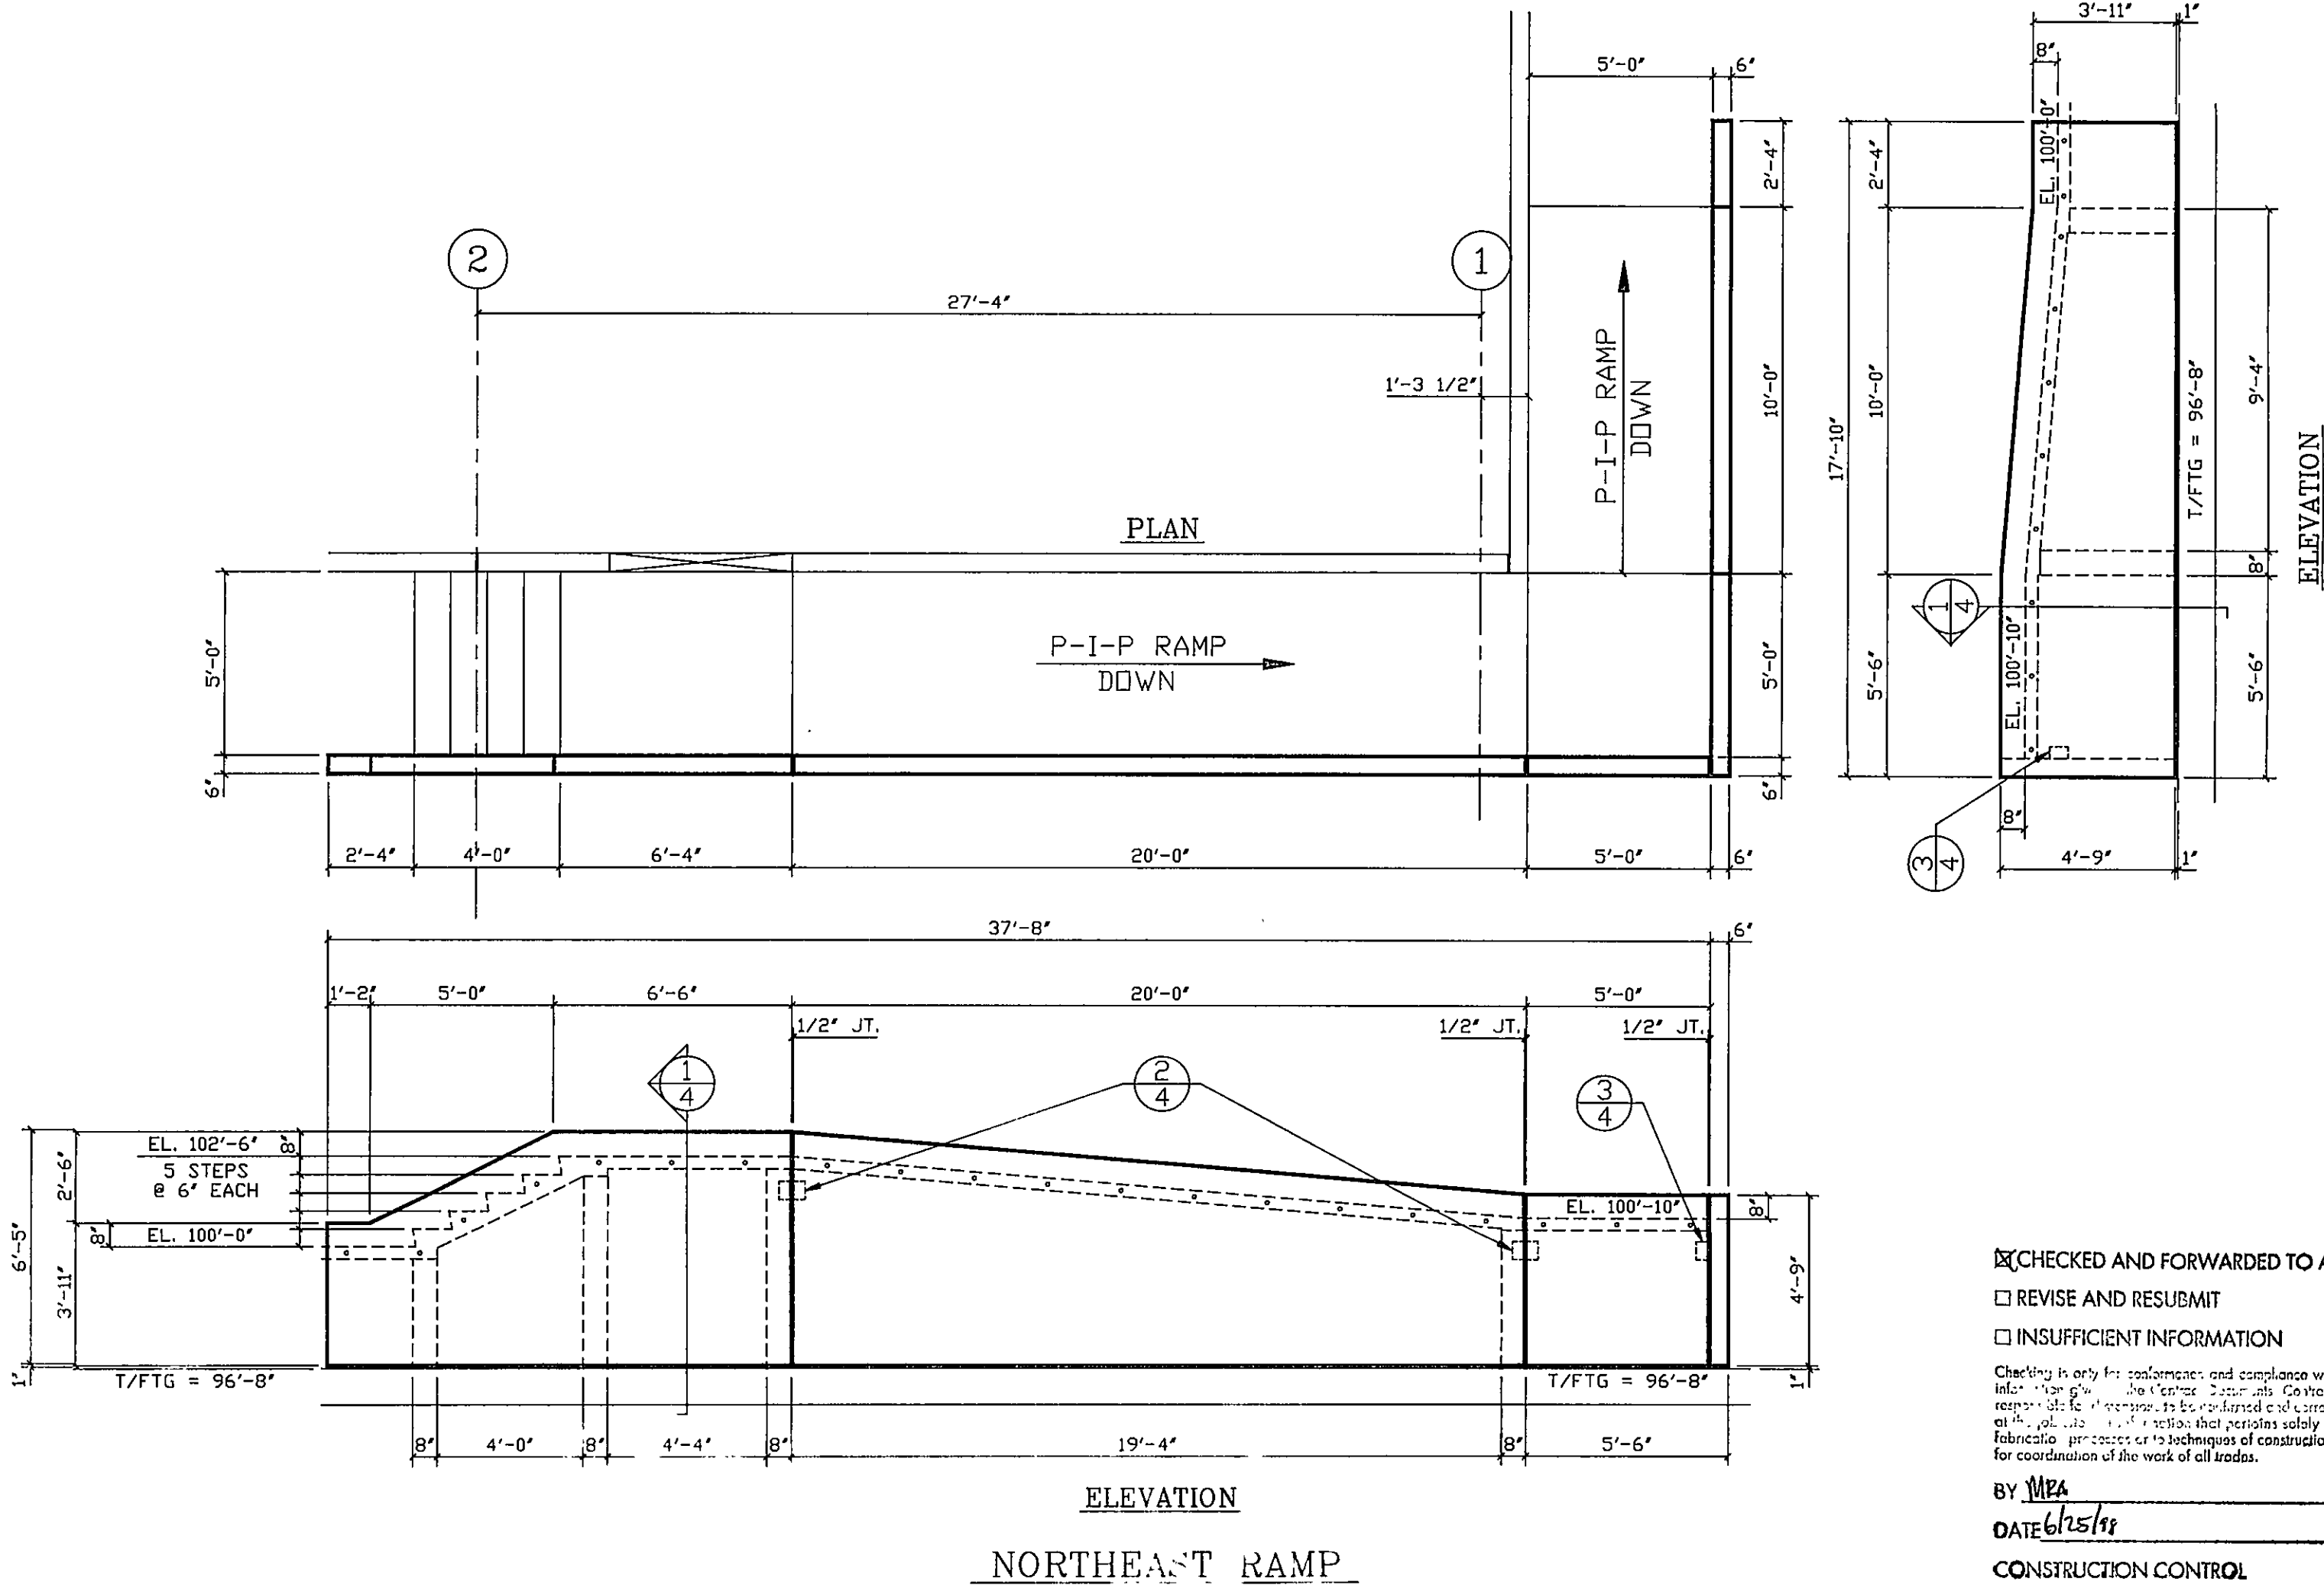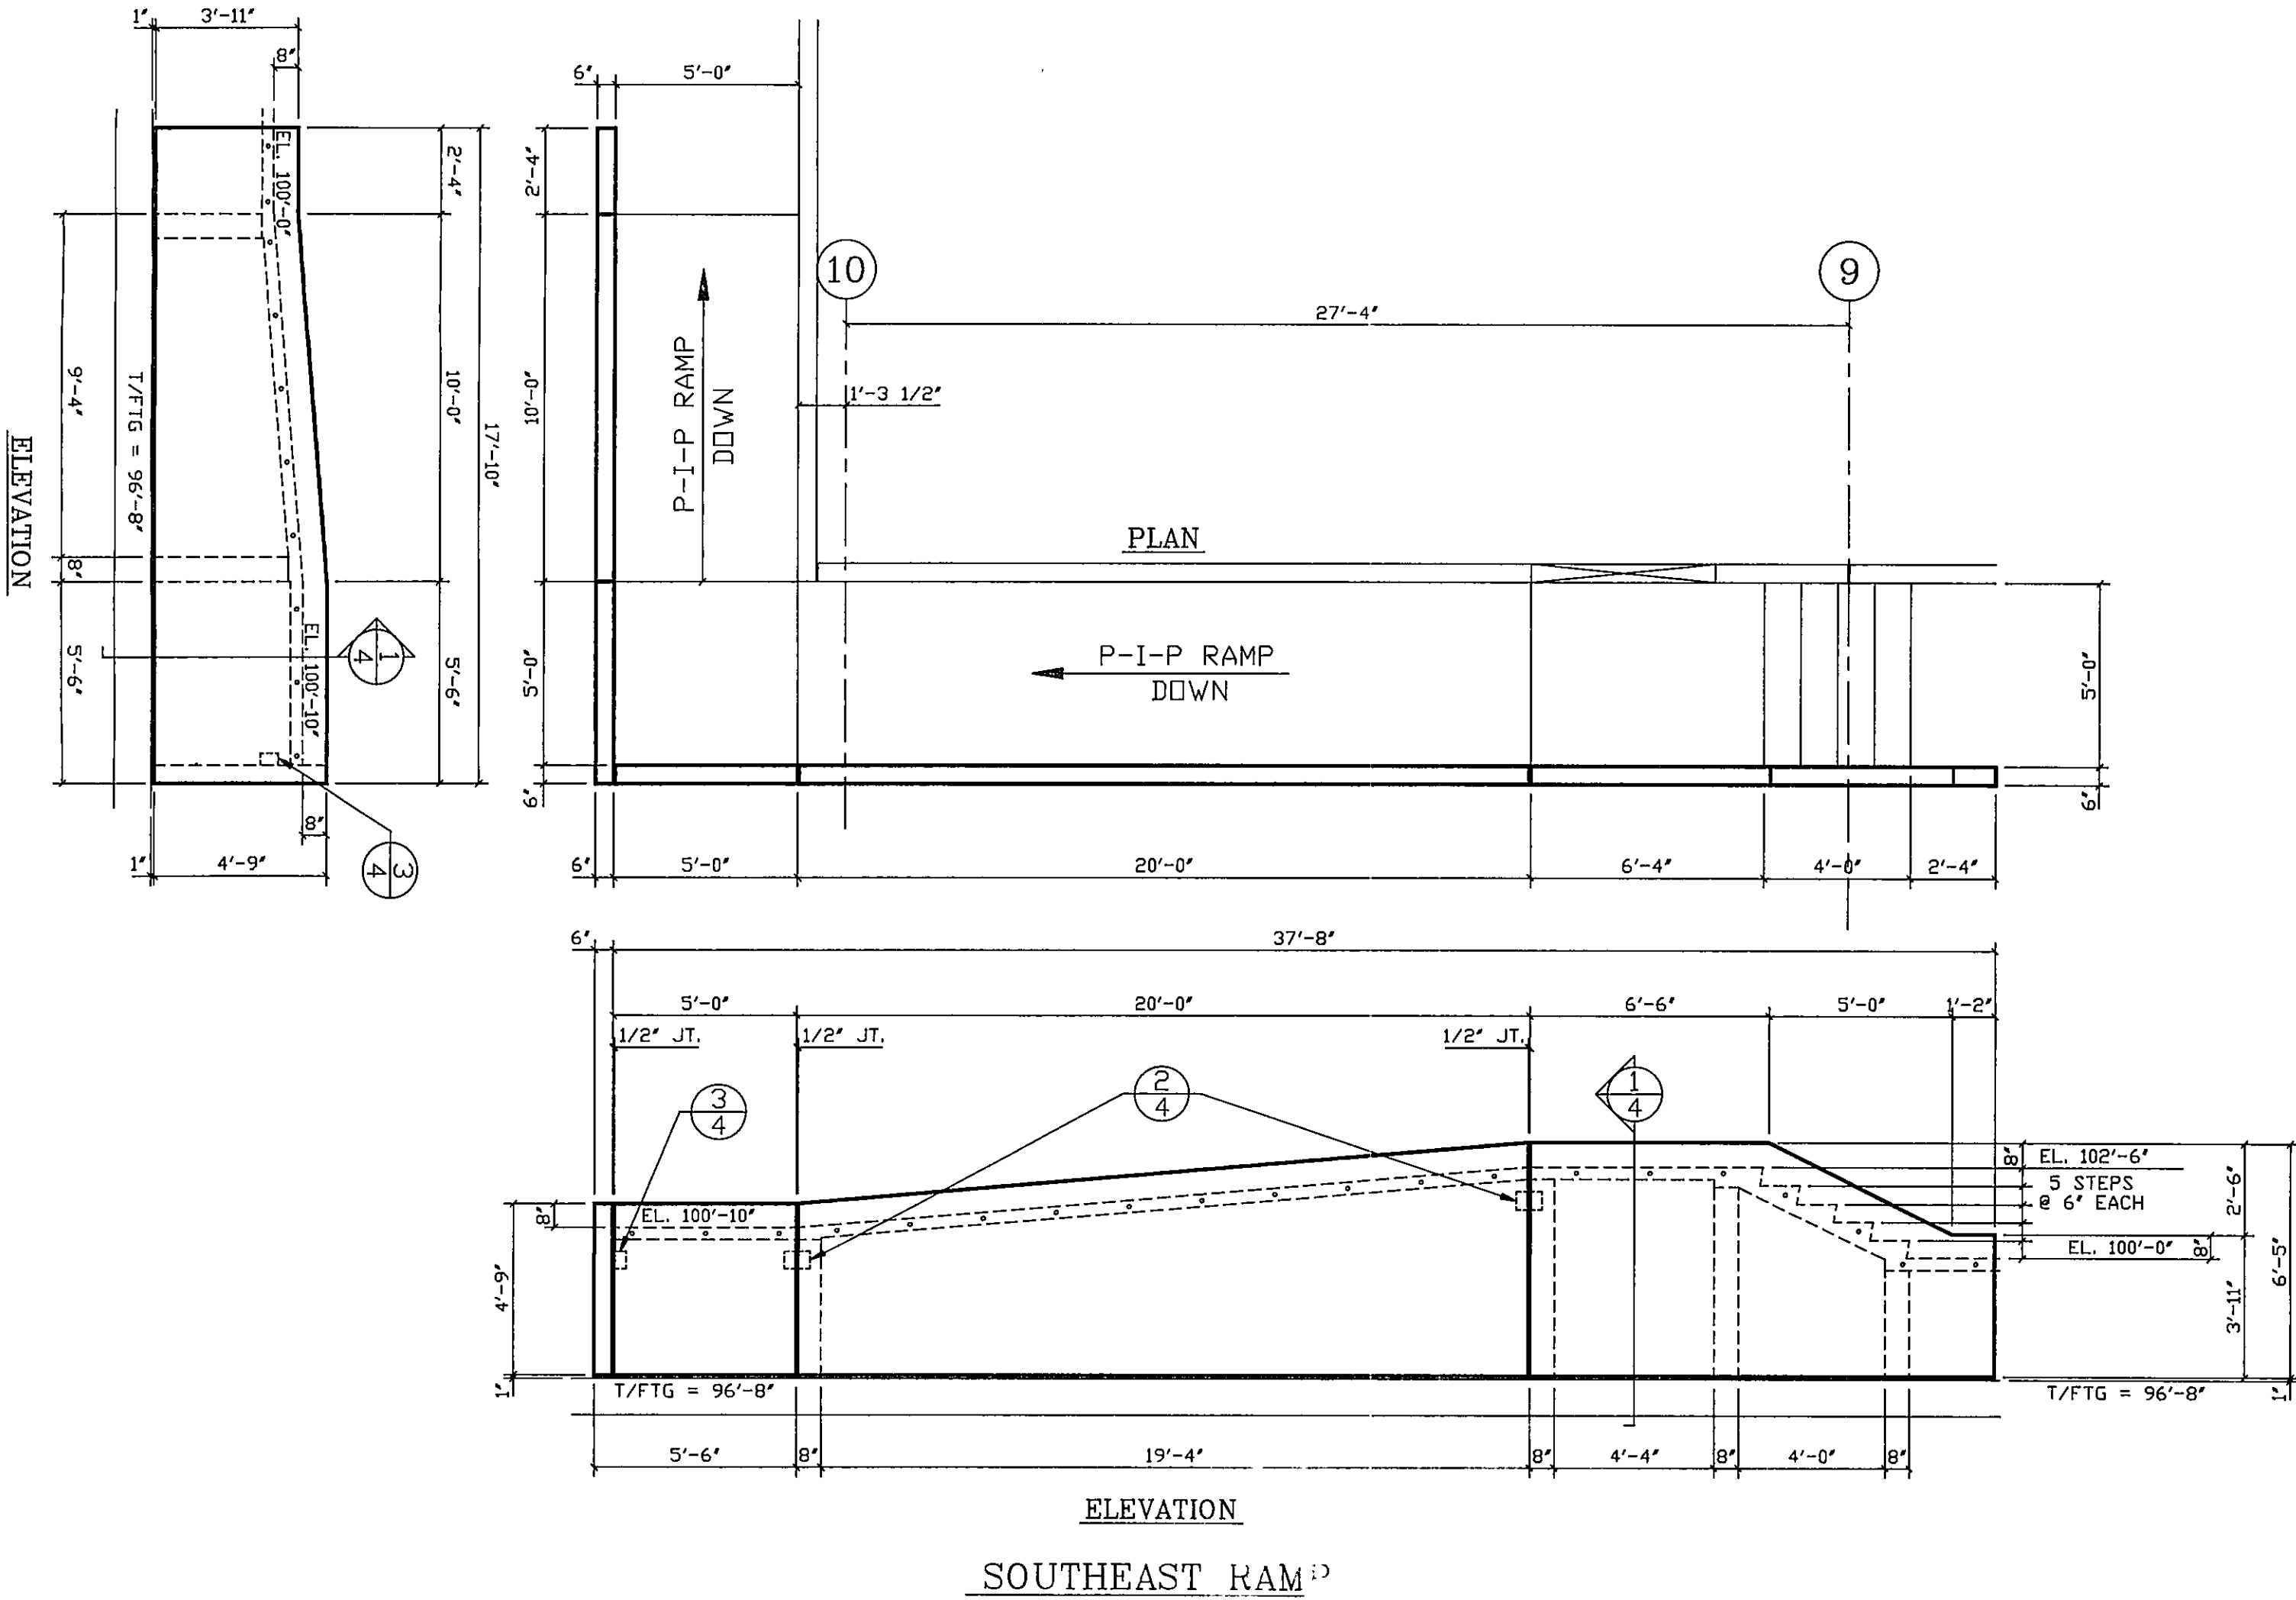

☒ CHECKED AND FORWARDED TO A/E
☐ REVISE AND RESUBMIT
☐ INSUFFICIENT INFORMATION
Checked in only for conformance and compliance with the information given. The Contractor is responsible for the accuracy of the information and for the proper use of the information. The Contractor is responsible for the proper use of the information and for the proper use of the information.
BY *[Signature]*
DATE 6/25/98
CONSTRUCTION CONTROL
FORT WAYNE, INDIANA

98-5-09

CHESTERTON HIGH SCHOOL
STADIUM
CHESTERTON, IN.

ARCHITECT: FANNING/HOWEY ASSOC., INC.
CONTRACTOR: GOUGH, INC.
DRAWN BY: D.A.
CHECK BY: *[Signature]* DATE: 6-23-98

JOB NO. 1278-10
SHEET 40
OF SHEETS