

NOTE: DRAWINGS SUBMITTED ARE AN ALTERNATE DESIGN REQUESTED BY W.R.KELSO CO. NOT AS DESIGNED BY FANNING & HOWIE. REF. QUOTE #970793 ALTERNATE DESIGN # 2 TAPER AND FILL ONLY.

MATCHLINE

DRAWING 2 OF 5

AREAS EXCEEDING 10"
REQUIRE BARRIER BOARD.

MATCHLINE

- NOTES:
- 1) INSULATION SHOWN ON THIS DRAWING IS FOAMULAR BY UCI INDUSTRIES. INSULATION IS EXTRUDED POLYSTYRENE.
 - 2) LAY TAPERED BOARDS BY LETTERS AS INDICATED. THE NUMBERS FOLLOWING EACH LETTER REFER TO THICKNESS OF FILL BOARDS, AS PER CROSS-SECTION VIEW.
 - 3) ALL HIPS, VALLEYS AND CRICKETS ARE TO BE FIELD CUT. MATERIAL WILL BE SUPPLIED.
 - 4) ROOF DIMENSIONS USED TO DRAW THIS PLAN WERE FROM ARCHITECT'S PLANS SUBMITTED. THE ROOFING CONTRACTOR SHOULD CHECK DIMENSIONS BEFORE MATERIAL HAS BEEN MANUFACTURED AND CONTACT UCI INDUSTRIES OF ANY CHANGES. ANY ALTERATIONS AFTER PRODUCTION OF MATERIAL MAY RESULT IN ADJUSTMENT OF ORIGINAL PRICE.
 - 5) APPROVED SIGNED SHOP DRAWINGS MUST BE RETURNED TO UCI INDUSTRIES PRIOR TO RELEASE OF MATERIAL TO FABRICATION.
 - 6) MANUFACTURER IS NOT RESPONSIBLE FOR SAFEKEEPING NOR MATERIAL SHORTAGES AFTER SIGNING FOR RECEIPT OF UCI MATERIAL.
 - 7) IT IS REQUIRED THAT THE ROOFING MEMBRANE AND INSULATION BE BALLASTED IMMEDIATELY AFTER PLACEMENT. FOR MORE DETAILS PLEASE REFER TO CURRENT FOAMULAR LITERATURE OR CONTACT YOUR LOCAL UCI SALES REPRESENTATIVE.

SECTION TAPERED PANELS:

E 0.50 - 1.00
F 1.00 - 1.50

SECTION FILL PANELS:

1.00
2.00

CRICKET TAPERED PANELS:

G 0.50 - 1.50

CRICKET FILL PANELS:

1.00
2.00

Extruded Polystyrene Insulation
FOAMULAR[®]

OWENS CORNING
CORPORATION
SPECIALTY and FOAM PRODUCTS



170 South Ave. P.O. Box 455
Tallmadge, Ohio 44278
1-800-875-1594 FAX: (216) 633-7316
TAPER CONTROL CENTER

CHECKED AND FORWARDED TO A/E

- ☐ REVISE AND RESUBMIT
☐ INSUFFICIENT INFORMATION

Checklist is only for performance and compliance with the information given in the Contract Documents. Contractor is responsible for determining the material and construction of the work shown for information that pertains solely to the foundation process or to techniques of construction and for coordination of the work of all trades.


BY MB

DATE 12/11/97

CONSTRUCTION CONTROL

FORT WAYNE, INDIANA

NORTH

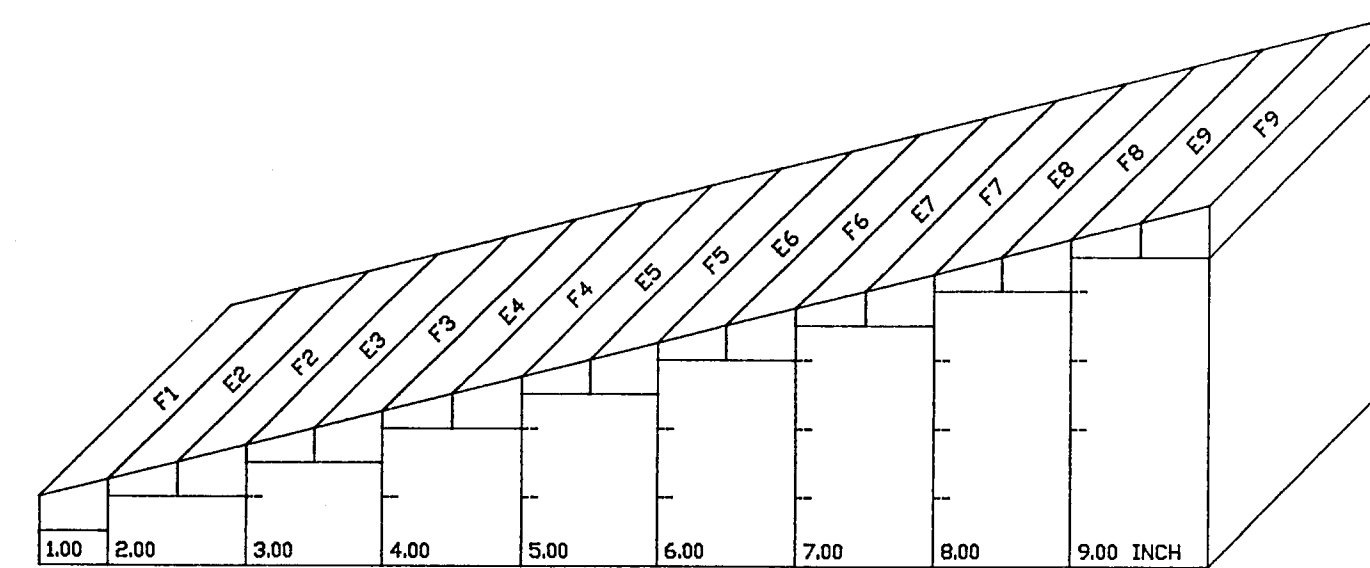

KEY PLAN

N.T.S.

Project: CHESTERTON H.S.
SWIMMING POOL
CHESTERTON, INDIANA

Architect: FANNING & HOWIE

Material: THERMAPINK 25

Roofing: KELSO ROOFING

Scale: 1/16" = 1'00" Drawn: T.L.I.
Slope: VARIES Checked: R.E.G.
Date: 11/3/97 T-21897A

Drawing number: 1 of 6

REVISIONS

1. REVISED DRAWING FOR RELOCATION OF ROOF DRAINS PER W. R. KELSO.

97-SWP-07