

NOTE: DRAWINGS SUBMITTED ARE AN ALTERNATE DESIGN REQUESTED BY W.R.KELSO CO., NOT AS DESIGNED BY FANNING & HOWIE. REF. QUOTE #970793 ALTERNATE DESIGN # 2 TAPER AND FILL ONLY.

- NOTES:
- 1) INSULATION SHOWN ON THIS DRAWING IS FOAMULAR BY UCI INDUSTRIES. INSULATION IS EXTRUDED POLYSTYRENE.
 - 2) LAY TAPERED BOARDS BY LETTERS AS INDICATED. THE NUMBERS FOLLOWING EACH LETTER REFER TO THICKNESS OF FILL BOARDS, AS PER CROSS-SECTION VIEW.
 - 3) ALL HIP, VALLEYS AND CRICKETS ARE TO BE FIELD CUT. MATERIAL WILL BE SUPPLIED.
 - 4) ROOF DIMENSIONS USED TO DRAW THIS PLAN WERE FROM ARCHITECT'S PLANS SUBMITTED. THE ROOFING CONTRACTOR SHOULD CHECK DIMENSIONS BEFORE MATERIAL HAS BEEN MANUFACTURED AND CONTACT UC INDUSTRIES OF ANY CHANGES. ANY ALTERATIONS AFTER PRODUCTION OF MATERIAL MAY RESULT IN ADJUSTMENT OF ORIGINAL PRICE.
 - 5) APPROVED SIGNED SHOP DRAWINGS MUST BE RETURNED TO UC INDUSTRIES PRIOR TO RELEASE OF MATERIAL TO FABRICATION.
 - 6) MANUFACTURER IS NOT RESPONSIBLE FOR SAFEKEEPING NOR MATERIAL SHORTAGES AFTER SIGNING FOR RECEIPT OF UC MATERIAL.
 - 7) IT IS REQUIRED THAT THE ROOFING MEMBRANE AND INSULATION BE BALLASTED IMMEDIATELY AFTER PLACEMENT. FOR MORE DETAILS PLEASE REFER TO CURRENT FOAMULAR LITERATURE OR CONTACT YOUR LOCAL UCI SALES REPRESENTATIVE.

SECTION TAPERED PANELS:

S1.	0.50 - 0.88
T1.	0.88 - 1.25
U1.	1.25 - 1.62
V1.	1.62 - 2.00
E	0.50 - 1.00
F	1.00 - 1.50

SECTION FILL PANELS:

0.50
1.00
1.50
2.00

CRICKET TAPERED PANELS:

G	0.50 - 1.50
---	-------------

CRICKET FILL PANELS:

1.00

Extruded Polystyrene Insulation
FOAMULAR®

OWENS CORNING
CORNING SPECIALTY and FOAM PRODUCTS



170 South Ave. P.O. Box 455
Tallmadge, Ohio 44278
1-800-875-1594 FAX: (216) 633-7316
TAPER CONTROL CENTER

← NORTH

✓ CHECKED AND FORWARDED TO A/E
REVISE AND RESUBMIT
DISCREPANT INFORMATION
Contractor is responsible for confirmation and compliance with the
requirements of the Owens Corning. Contractor is
responsible for the correct installation and handling
of the material. The manufacturer's literature shall be the
basis for the correct installation and storage of construction and
handling of the material at all times.
BY M26
DATE 12/11/97
CONTRACTOR CONTROL
H21 WAYNE BERNIA

Project: CHESTERTON H.S.
SWIMMING POOL
CHESTERTON, INDIANA

Architect: FANNING & HOWIE

Material: THERMAPINK 25

Roofer: KELSO ROOFING



Scale: 1/16" = 1'00" Drawn: T.L.I.
Slope: VARIES Checked: R.E.G.
Date: 11/3/97 T-21897F

Drawing number: 6 of 6

REVISIONS

1. REVISED DRAWING FOR RELOCATION
OF ROOF DRAINS PER W. R. KELSO.

97-SWP-07

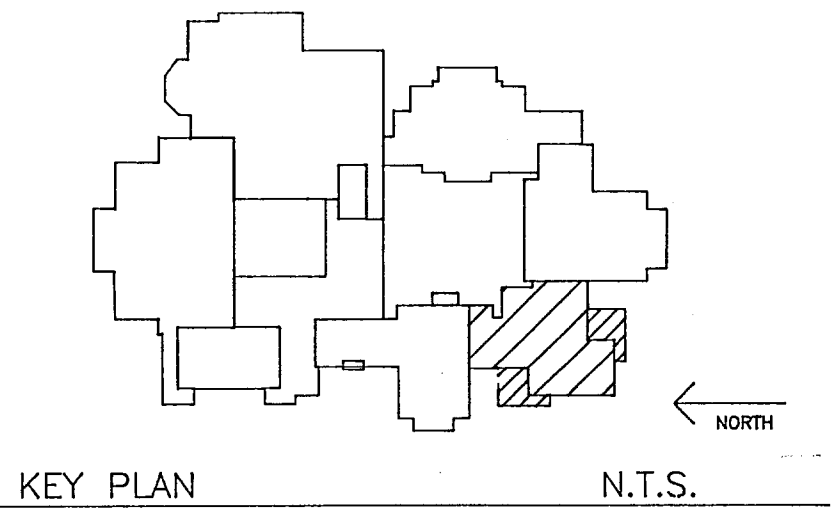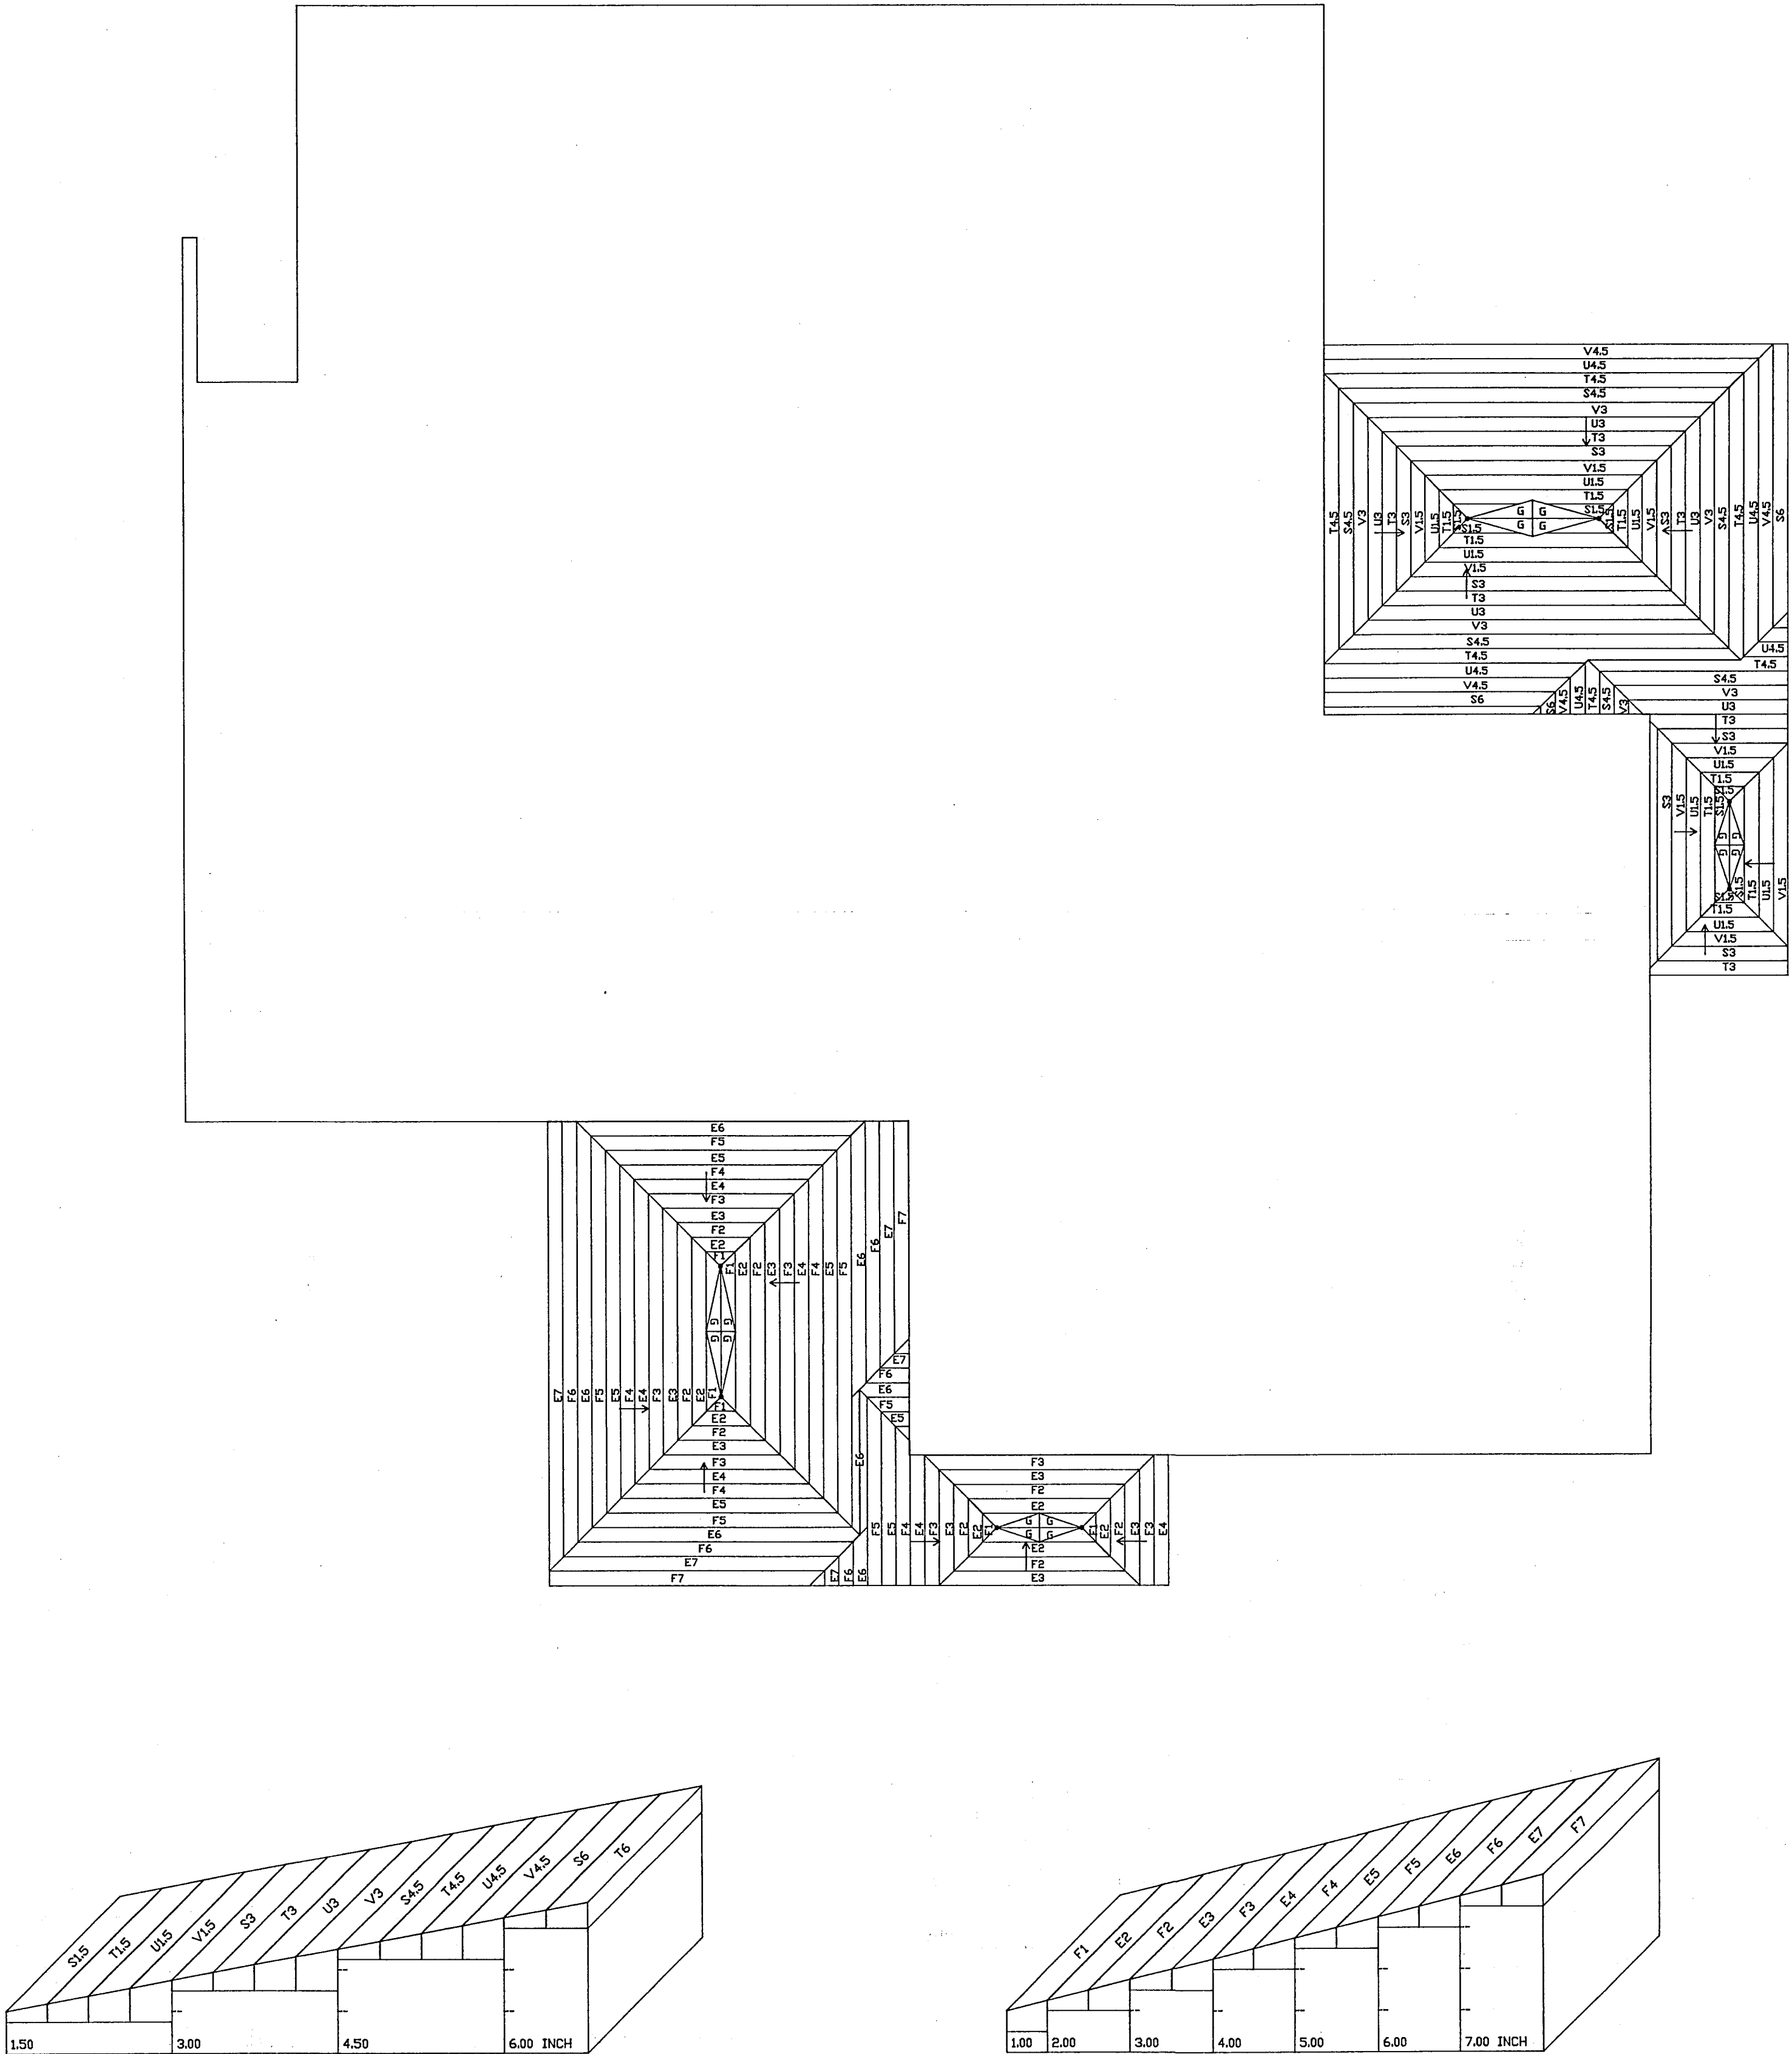

KEY PLAN

N.T.S.