
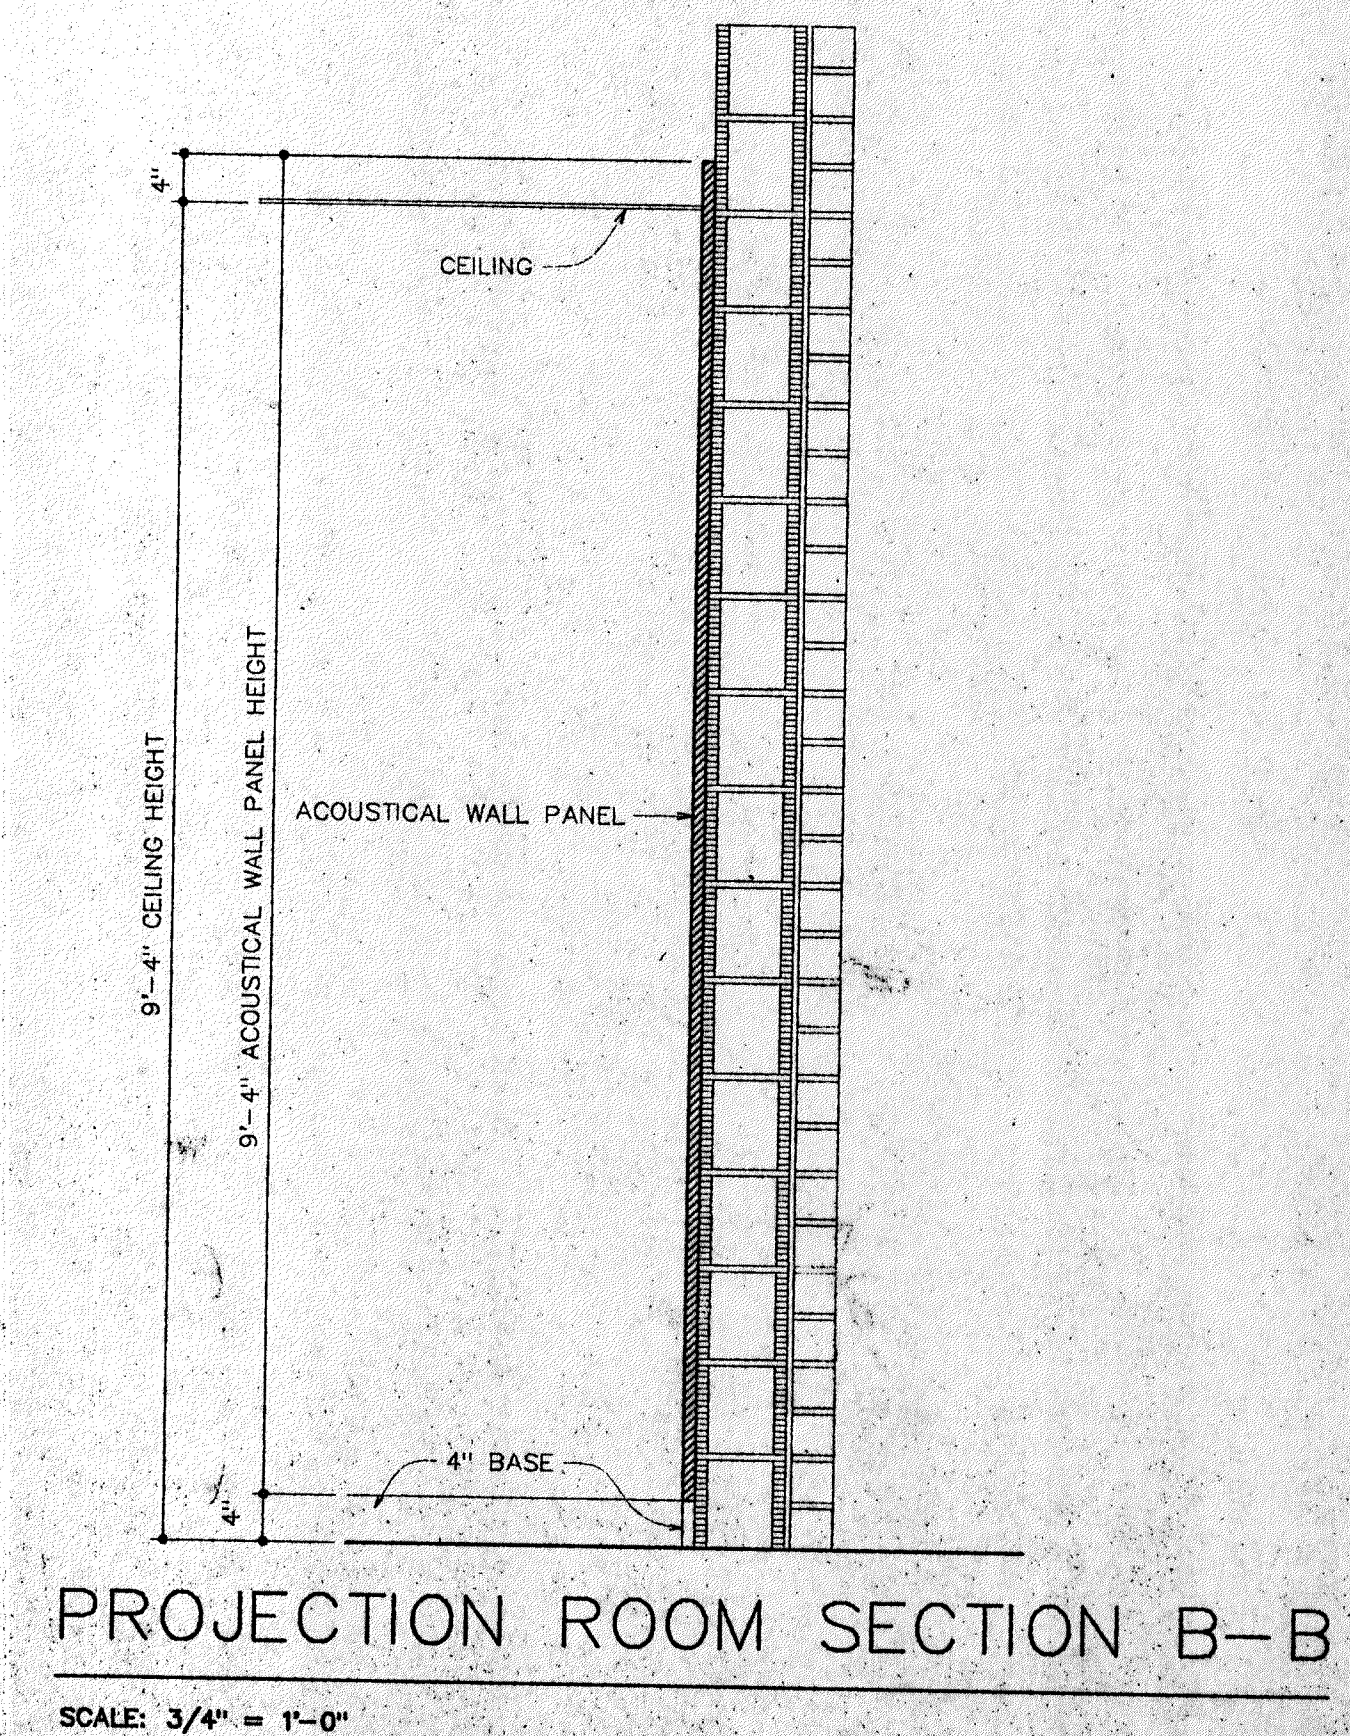
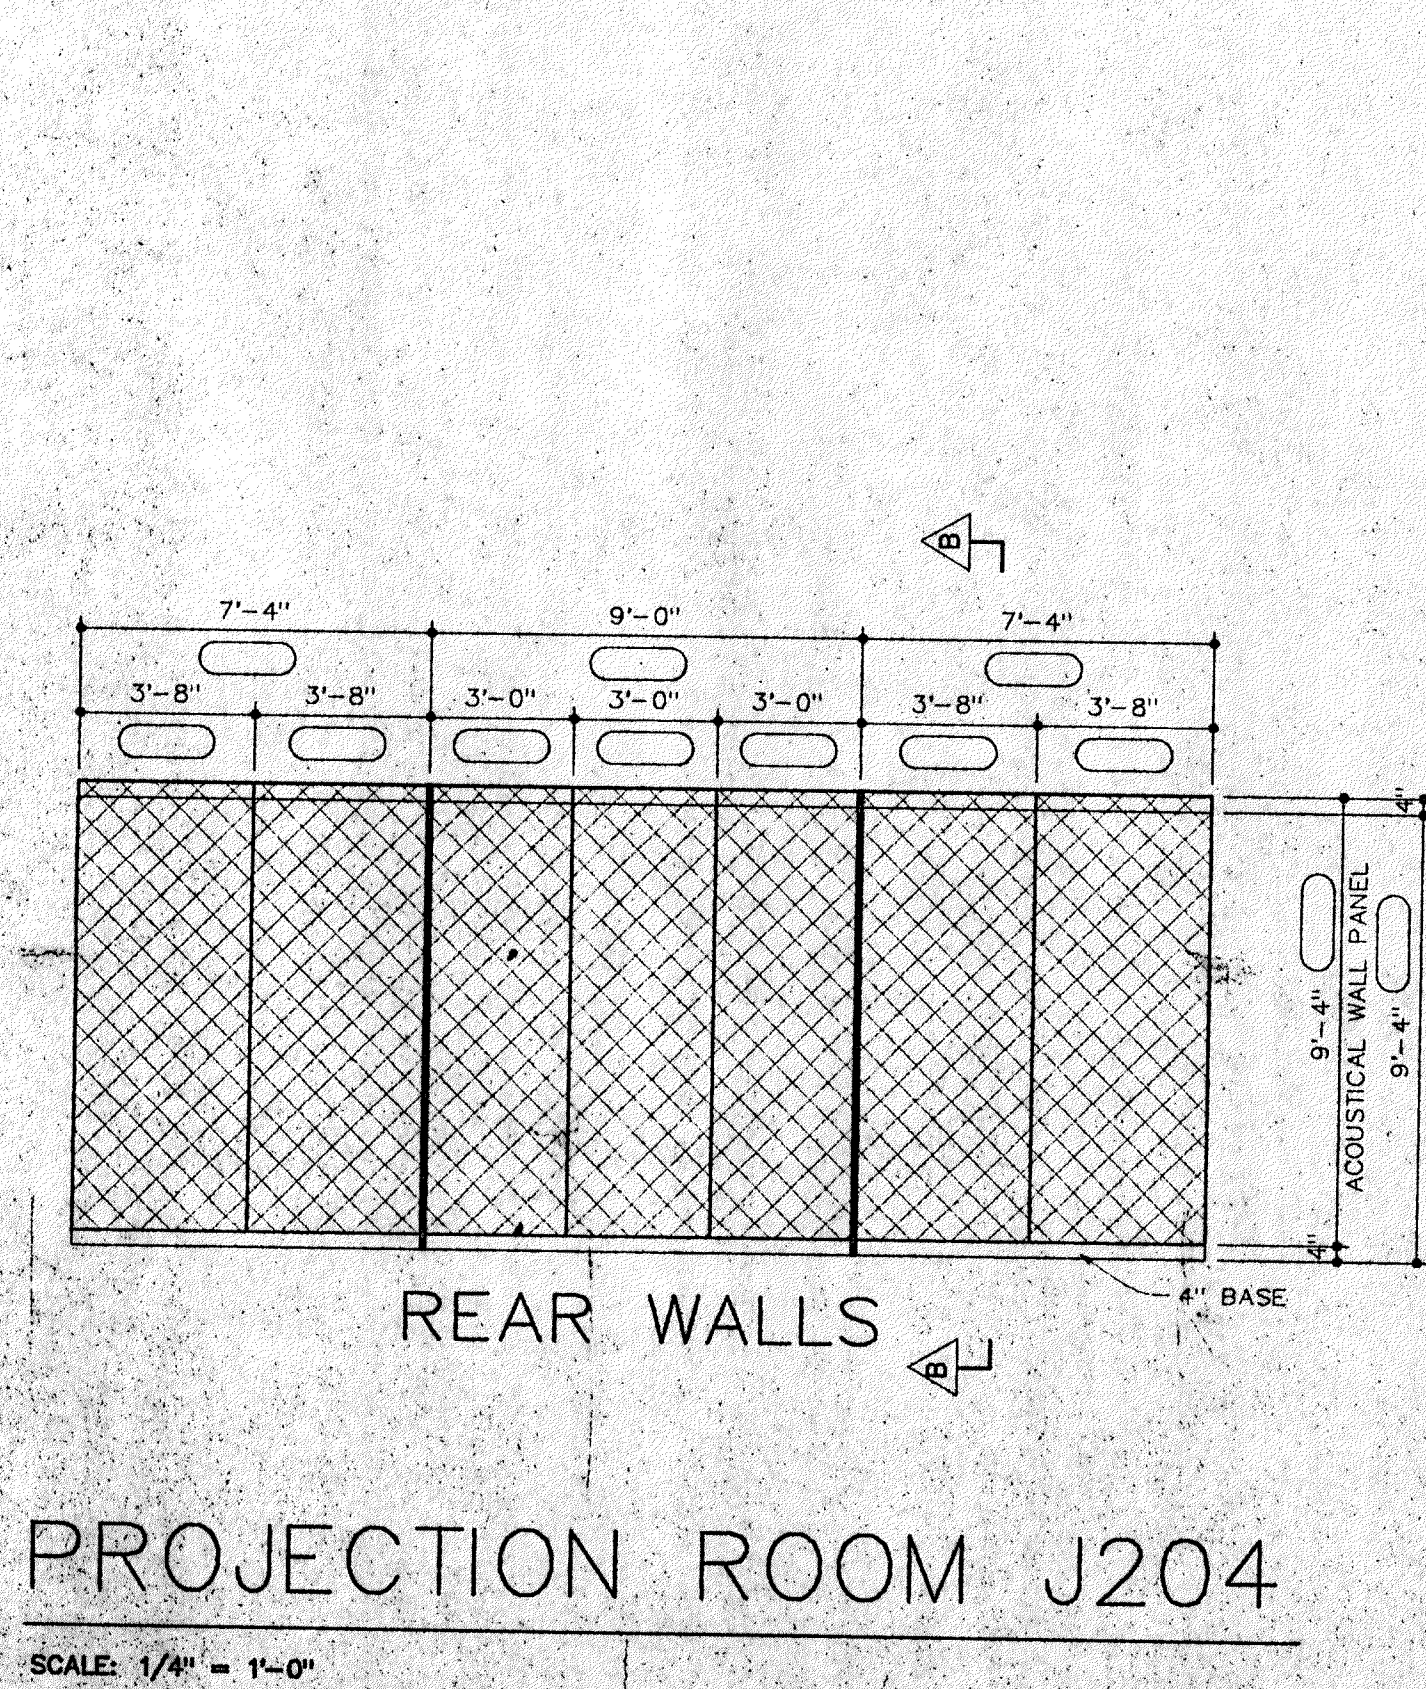
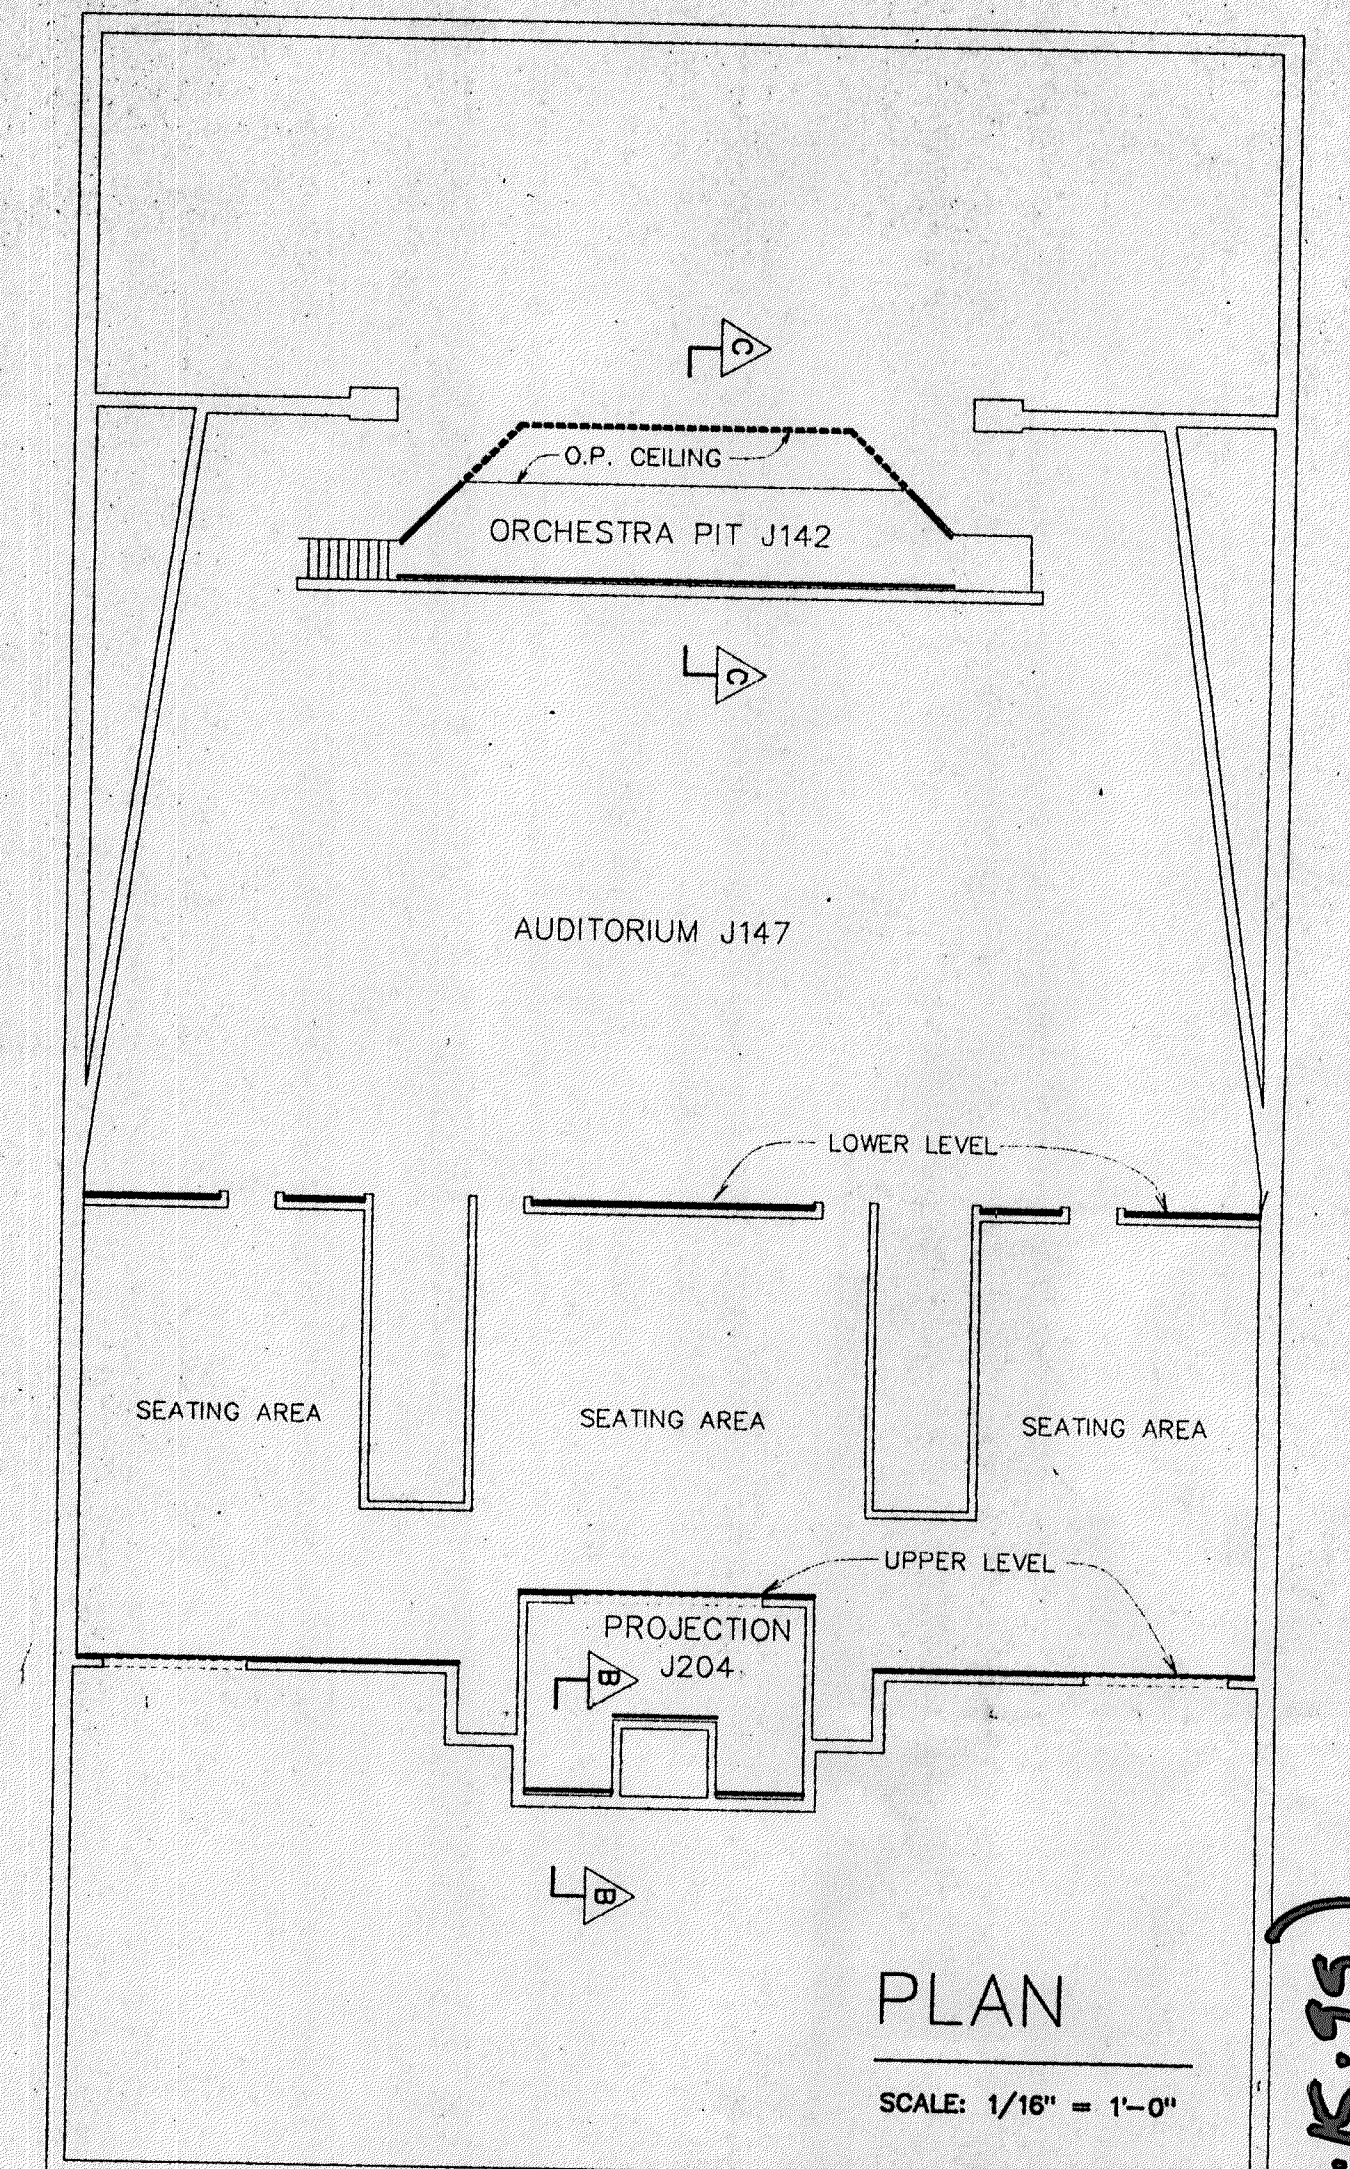
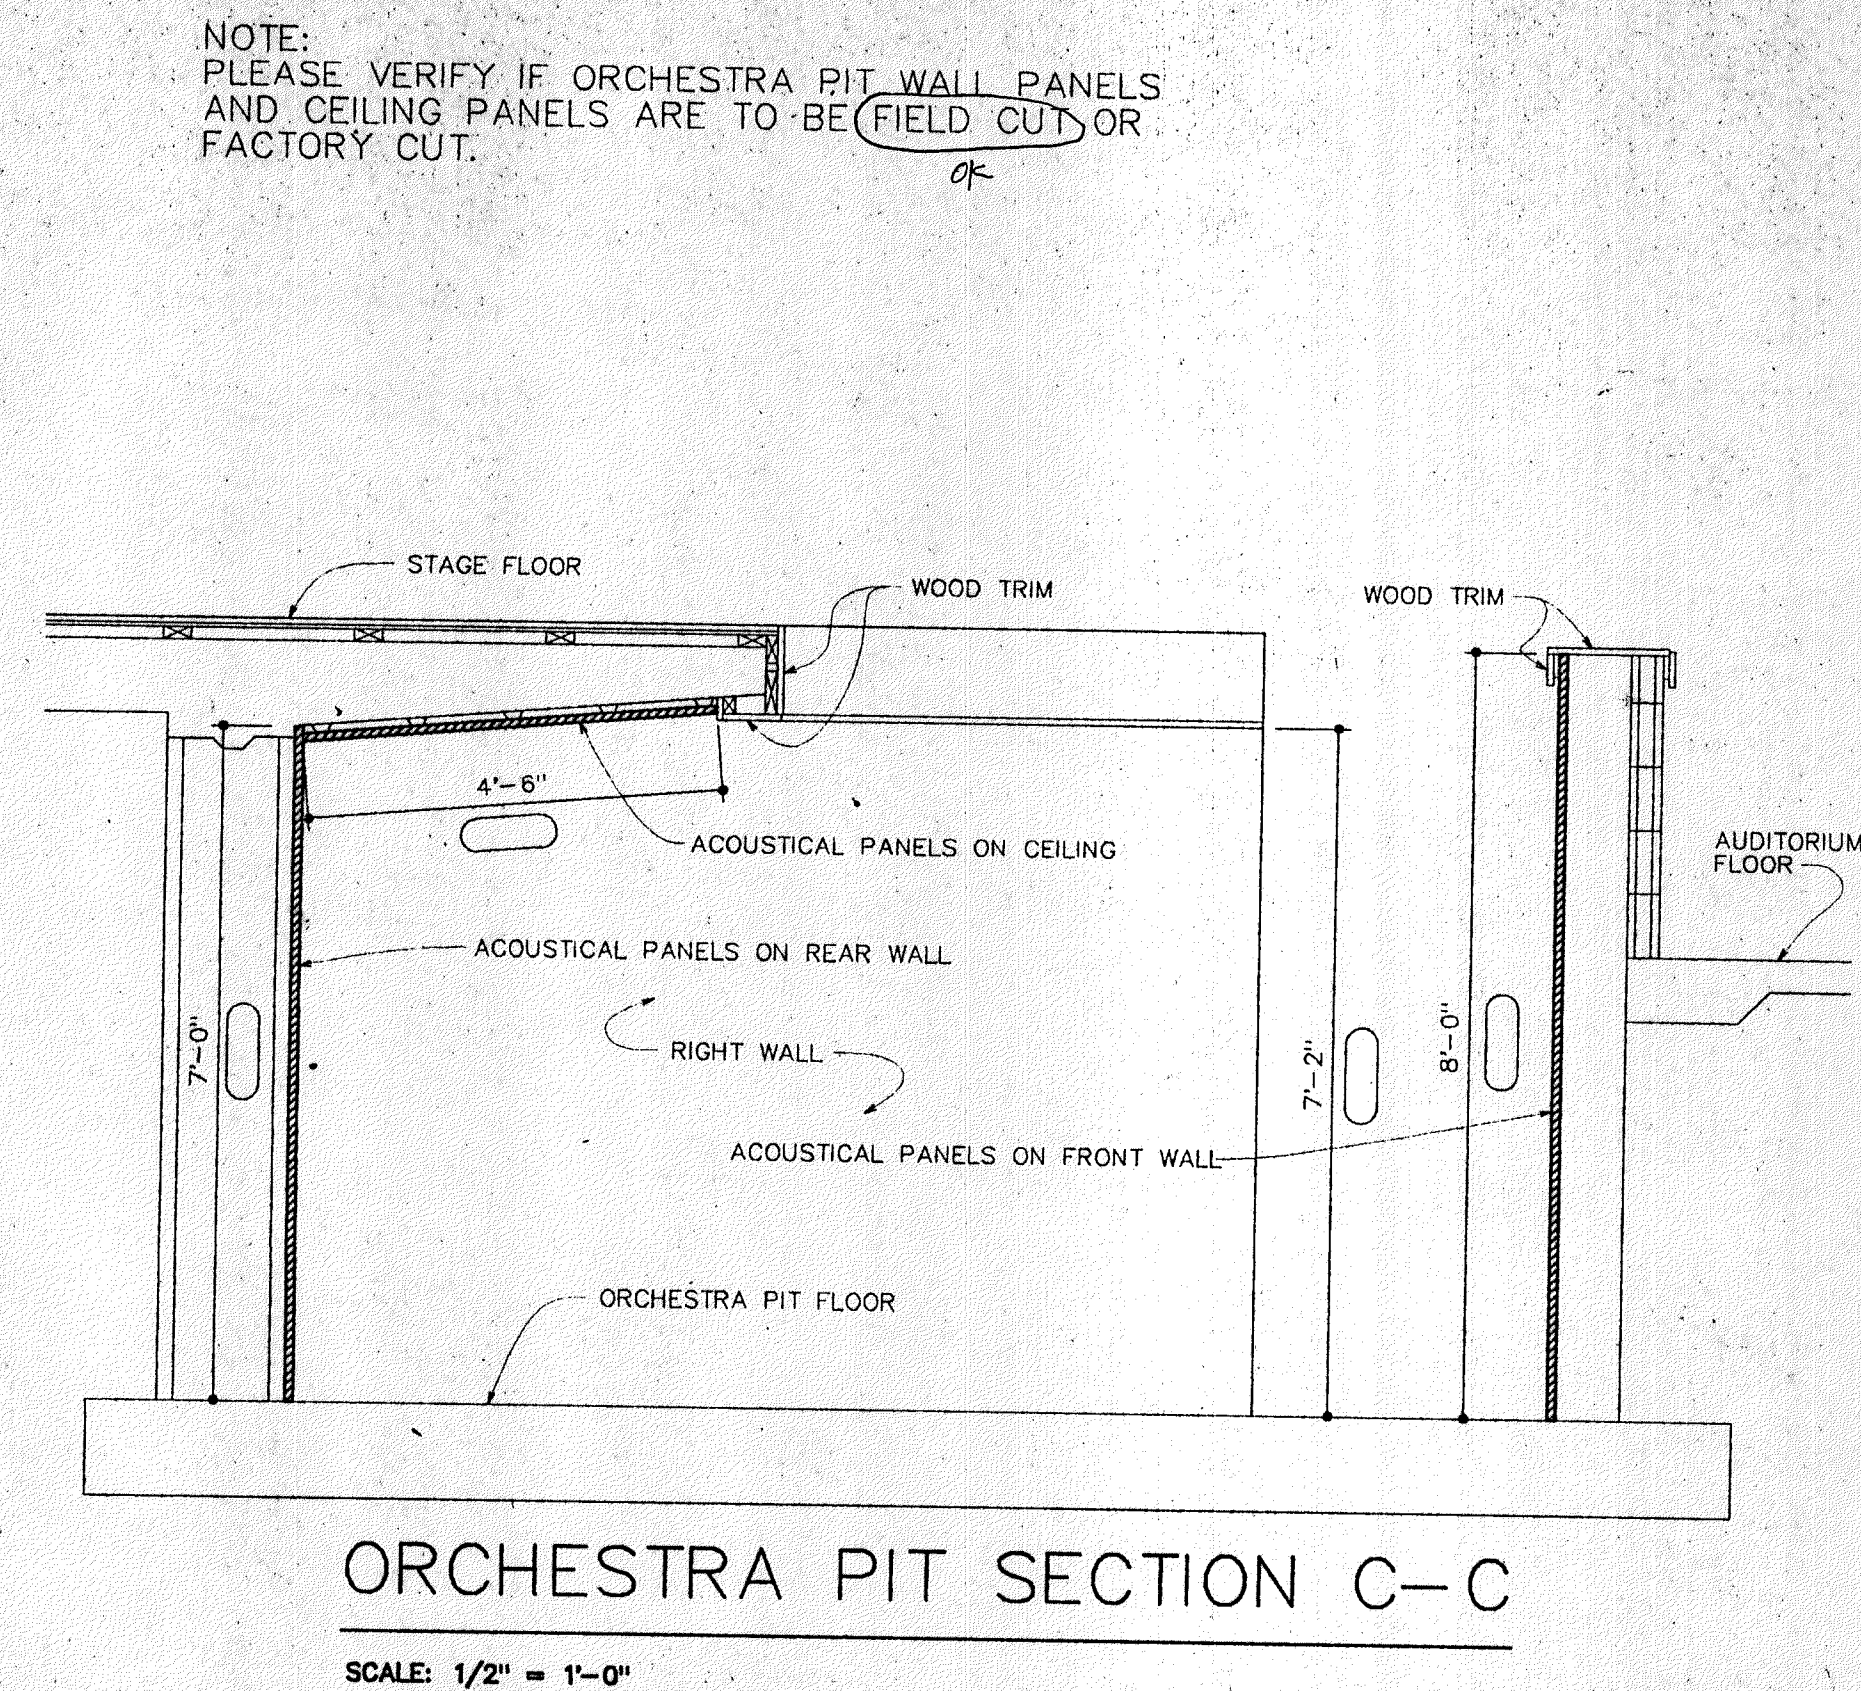


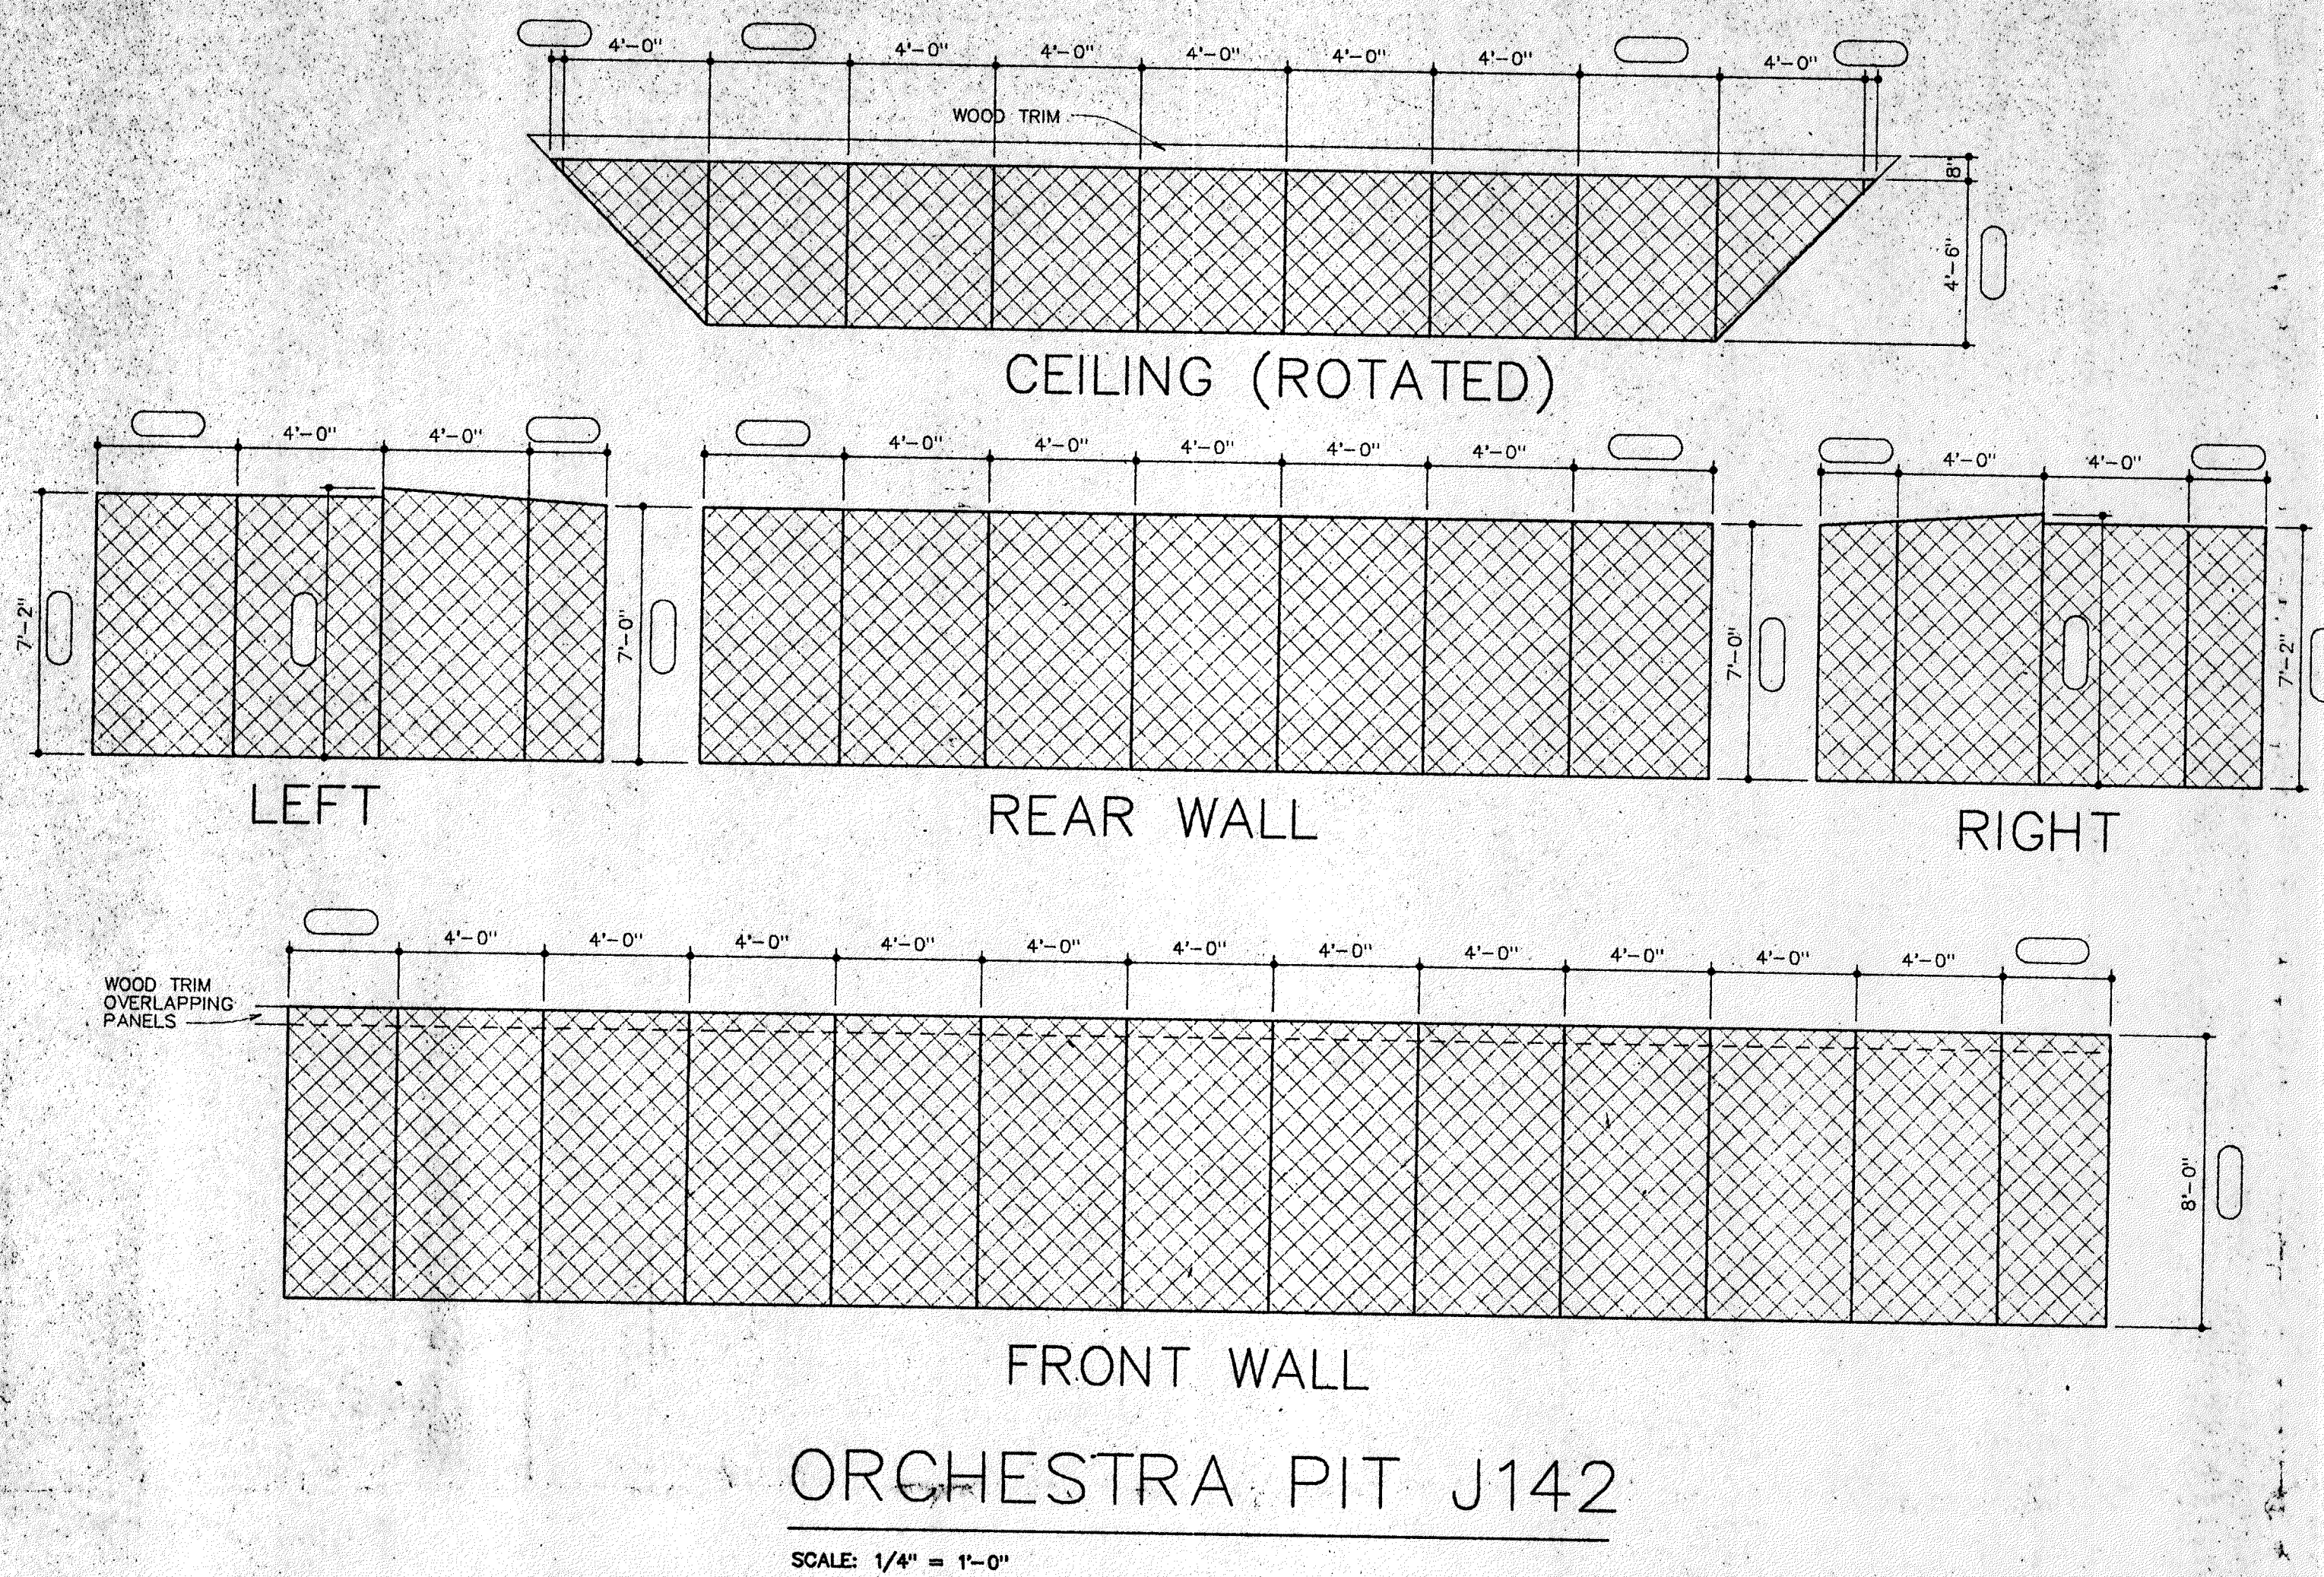

SHOP DRAWING/SUBMITTAL REVIEW STATUS			
ARCHITECT'S DETERMINATION		RESPONSE REQUIRED	
No Exceptions Taken ☒	Rejected ☐	Confirm ☐	
Note Markings ☐	Comments Attached ☐	Resubmit ☐	

Architect's review is only for checking conformance with the information given, and with the design concept expressed in the Contract Documents. Any and all markings and/or comments applied by the Architect shall not relieve the Contractor from compliance with the Contract Documents, nor shall they constitute a warranty. The Contractor shall be responsible for double-checking and confirming and correcting all quantities and dimensions, for selecting fabrication processes or techniques of assembly, for performing the work in a safe manner, and for coordinating its work with all other trades.

FAIRBANKS ASSOCIATES, INC. ARCHITECTS/ENGINEERS
By *LEP* Date *06/15/99*

☒ CHECKED AND FORWARDED TO A/E
REVISE AND RESUBMIT
FOR RECENT INFORMATION
BY *WFA*
DATE *6-9-99*
CONSTRUCTION CONTROL
FORT WAYNE, INDIANA

LEGEND

CROSS HATCHED AREA INDICATES ACTUAL SHAPE, (NORMAL VIEW) OF ACoustical PANELS.

PANELS AT FLOOR LEVEL IN AUDITORIUM AND ORCHESTRA PIT SHALL BE ATP 1.1 HIGH-IMPACT, CLASSIC FACING, COLOR *Refer to Color Brochure*

ALL OTHER PANELS SHALL BE ATP 1.0, CLASSIC FACING, COLOR *Refer to Color Brochure*

ALL PANEL EDGES SHALL BE CHEMICALLY HARDENED
ALL PANEL EDGES SHALL BE SQUARE
ALL CORNERS SHALL BE SQUARE.

VERIFY ALL PANEL DIMENSIONS

2'-6" = DIMENSION FROM ESTIMATED LAYOUT.
= CLOUD FOR FIELD MEASUREMENT VERIFICATION

PANELS SHALL BE SUPPLIED WITH SPLINE FASTENERS

THESE DRAWINGS AND ALL SPECIFICATIONS ARE THE PROPERTY OF AVL SYSTEMS, INC. AND SHALL NOT BE REPRODUCED OR COPIED, IN WHOLE OR IN PART, WITHOUT WRITTEN PERMISSION. THEY ARE TO BE USED IN CONJUNCTION WITH THE PRODUCTS OF AVL SYSTEMS, INC. AND IN CONJUNCTION WITH THIS PROJECT AT THIS SITE AS SPECIFICALLY IDENTIFIED HEREIN. THEY ARE TO BE RETURNED UPON REQUEST.

INSTALLING CONTRACTOR SHALL BE HELD RESPONSIBLE FOR HAVING VERIFIED ALL DIMENSION AND FIELD CONDITIONS PERTAINING TO THE FABRICATION AND INSTALLATION OF THE PRODUCTS SHOWN HEREIN, PRIOR TO FABRICATION.

AVL

AVL SYSTEMS, INC.
5540 SW 6TH PLACE
OCALA, FL 34474
1 (800) ACUSTIC
© AVL SYSTEMS, INC. 1999

CHESTERTON HIGH SCHOOL CHESTERTON, INDIANA		
CLIENT/ARCHITECT ARCSPC (LTD.)		
ISSUED FOR: ☐ REVIEW AND COMMENT ☐ REVIEW AND APPROVAL FOR MANUFACTURE BY: AUTHORIZED SIGNATURE _____ FOR: _____ DATE: _____ ☐ AS SUBMITTED ☐ AS REVISED		
PROJECT NO	REVISIONS	DRAWING 1
DRAWN BY DPK	PLOT TIME: 12:52PM DATE: 4-9-1999 FILE: AVL68.DCS	OF 2
DATE 9 APRIL 1999		(C)

KIS-AWT SHOPS (6.15.99)