


RENOVATION PROJECT FOR:
DUNELAND SCHOOL
CORPORATION
CHESTERTON MIDDLE SCHOOL
CHESTERTON, INDIANA

PROJECT RECORD DRAWINGS
TRI-ELECTRONICS, INC.
6231 CALUMET AVENUE
HAMMOND, IN 46324
219-931-6850
WWW.TRI-ELECTRONICS.COM

DRAWING INDEX:

TECHNOLOGY SYSTEMS:

TS 0.0	TITLE SHEET
TS 0.1	BROADBAND RF VIDEO RISER AND DETAILS
TS 0.2	1ST FLOOR COAXIAL CABLE ROUTING
TS 0.3	2ND FLOOR COAXIAL CABLE ROUTING
TS 1.1	TECHNOLOGY AS BUILT FLOOR PLAN (UNIT "A")
TS 1.2	TECHNOLOGY AS BUILT FLOOR PLAN (UNIT "B")
TS 1.3	TECHNOLOGY AS BUILT FLOOR PLAN (UNIT "C")
TS 1.4	TECHNOLOGY AS BUILT FLOOR PLAN (UNIT "D")
TS 1.5	TECHNOLOGY AS BUILT FLOOR PLAN (UNIT "E")
TS 1.6	TECHNOLOGY AS BUILT FLOOR PLAN (UNIT "F")
TS 1.7	TECHNOLOGY AS BUILT FLOOR PLAN (UNIT "G")
TS 2.1	TECHNOLOGY AS BUILT FLOOR PLAN (UNIT "H")
TS 2.2	TECHNOLOGY AS BUILT FLOOR PLAN (UNIT "J")
TS 5.1	TELECOM-DATA DETAILS

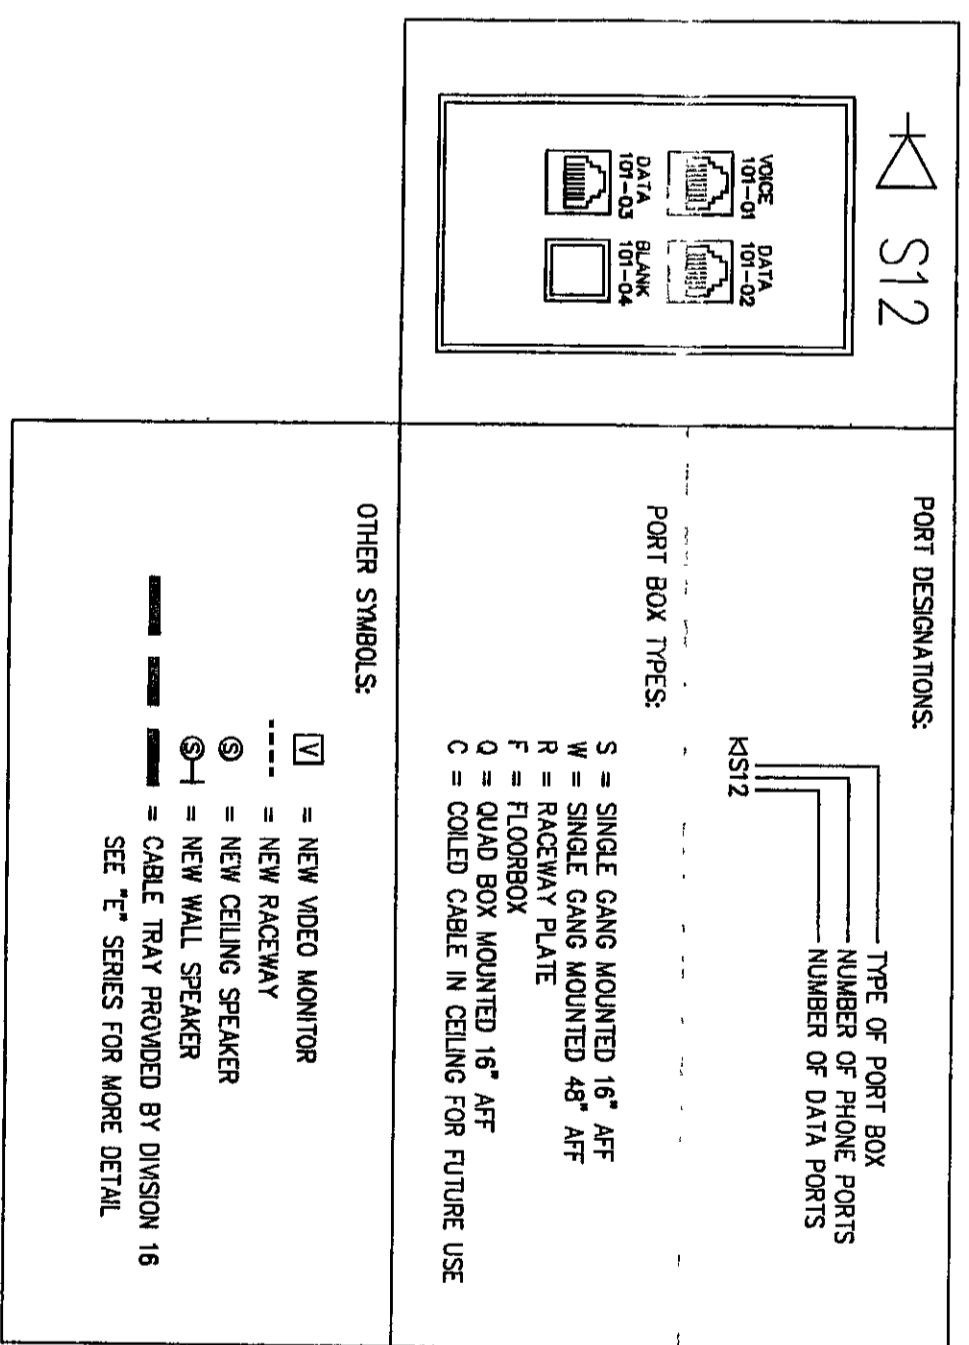

6231 Calumet Avenue
P.O. Box 4310
Hammond, IN 46324
(219) 931-6850 (312) 862-4998
1 (800) 722-6793
Fax: (219) 933-3545

CHESTERTON MIDDLE SCHOOL
CHESTERTON INDIANA

AS BUILT TITLE SHEET

SCALE: NONE

DATE: 8/27/02

DRAWN BY: A.O.

CHECKED BY: A.O.

DESIGN BY:

DRAWING NO: TS 0.0

D S&A INC.
Technology Design Consultants
16618 East 196 th Street
Noblesville IN 46060-9530
765/534-5152
D S&A INCORPORATED

2002-75-20