

WESTCHESTER INTERMEDIATE SCHOOL OFFICE REMODEL

DUNELAND SCHOOL CORPORATION

CHESTERTON, INDIANA

SCHOOL BOARD

MRS. JANICE CUSTER
MR. NICK JURASEVICH
MR. RON STONE
MR. RALPH AYRES
MR. MICHAEL TROUT

PRESIDENT
VICE PRESIDENT
SECRETARY
BOARD MEMBER
BOARD MEMBER

MR. MICHAEL C. HARRIS

BOARD ATTORNEY

ADMINISTRATION

DR. DIRK BAER
MR. MONTE MOFFETT
DR. DAVID PRUIS
MRS. BONNIE GASTON
MR. MARK McKIBBEN

**SUPERINTENDENT
ASSIST. SUPERINTENDENT
ASSIST. SUPERINTENDENT
BUSINESS MANAGER
DIR. OF SPECIAL SERVICES**

MR. SHAWN LONGACRE

WESTCHESTER PRINCIPAL

architect:

GEROMETTA & KINEL ARCHITECTS, INC.
CHESTERTON, INDIANA

consulting engineer:

M/E DESIGN SERVICES, INC.
MISHAWAKA, INDIANA

DRAWING INDEX


T-1 TITLE SHEET

architectural:

- | | | |
|-------------|--|----------------|
| A1.0 | DEMOLITION PLAN, DETAILS, & NOTES | AREA OF OFFICE |
| A1.1 | NEW FLOOR PLAN, NOTES | |
| A2.1 | NEW VESTIBULE ELEVATIONS,
SECTIONS, & DETAILS | |
| A3.1 | BUILDING SECTIONS | |
| A4.1 | WALL SECTIONS & DETAILS | |
| A5.1 | DOOR/FRAME ELEVATIONS & DETAILS | |
| A5.2 | TOILET ROOM & CASEWORK ELEVATIONS | |
| A6.1 | REFLECTED CEILING PLAN | |
| A F | FINISH SELECTIONS | |

mechanical/electrical:

- | | |
|------|---------------------------------------|
| M1.1 | -OMITTED- |
| M2.1 | PLUMBING PLAN |
| M3.1 | HVAC PLAN |
| E1.1 | ELECTRICAL DEMOLITION |
| E2.1 | POWER/SYSTEMS PLAN |
| E3.1 | LIGHTING PLAN |
| E4.1 | GENERAL NOTES, LEGEND,
AND DETAILS |

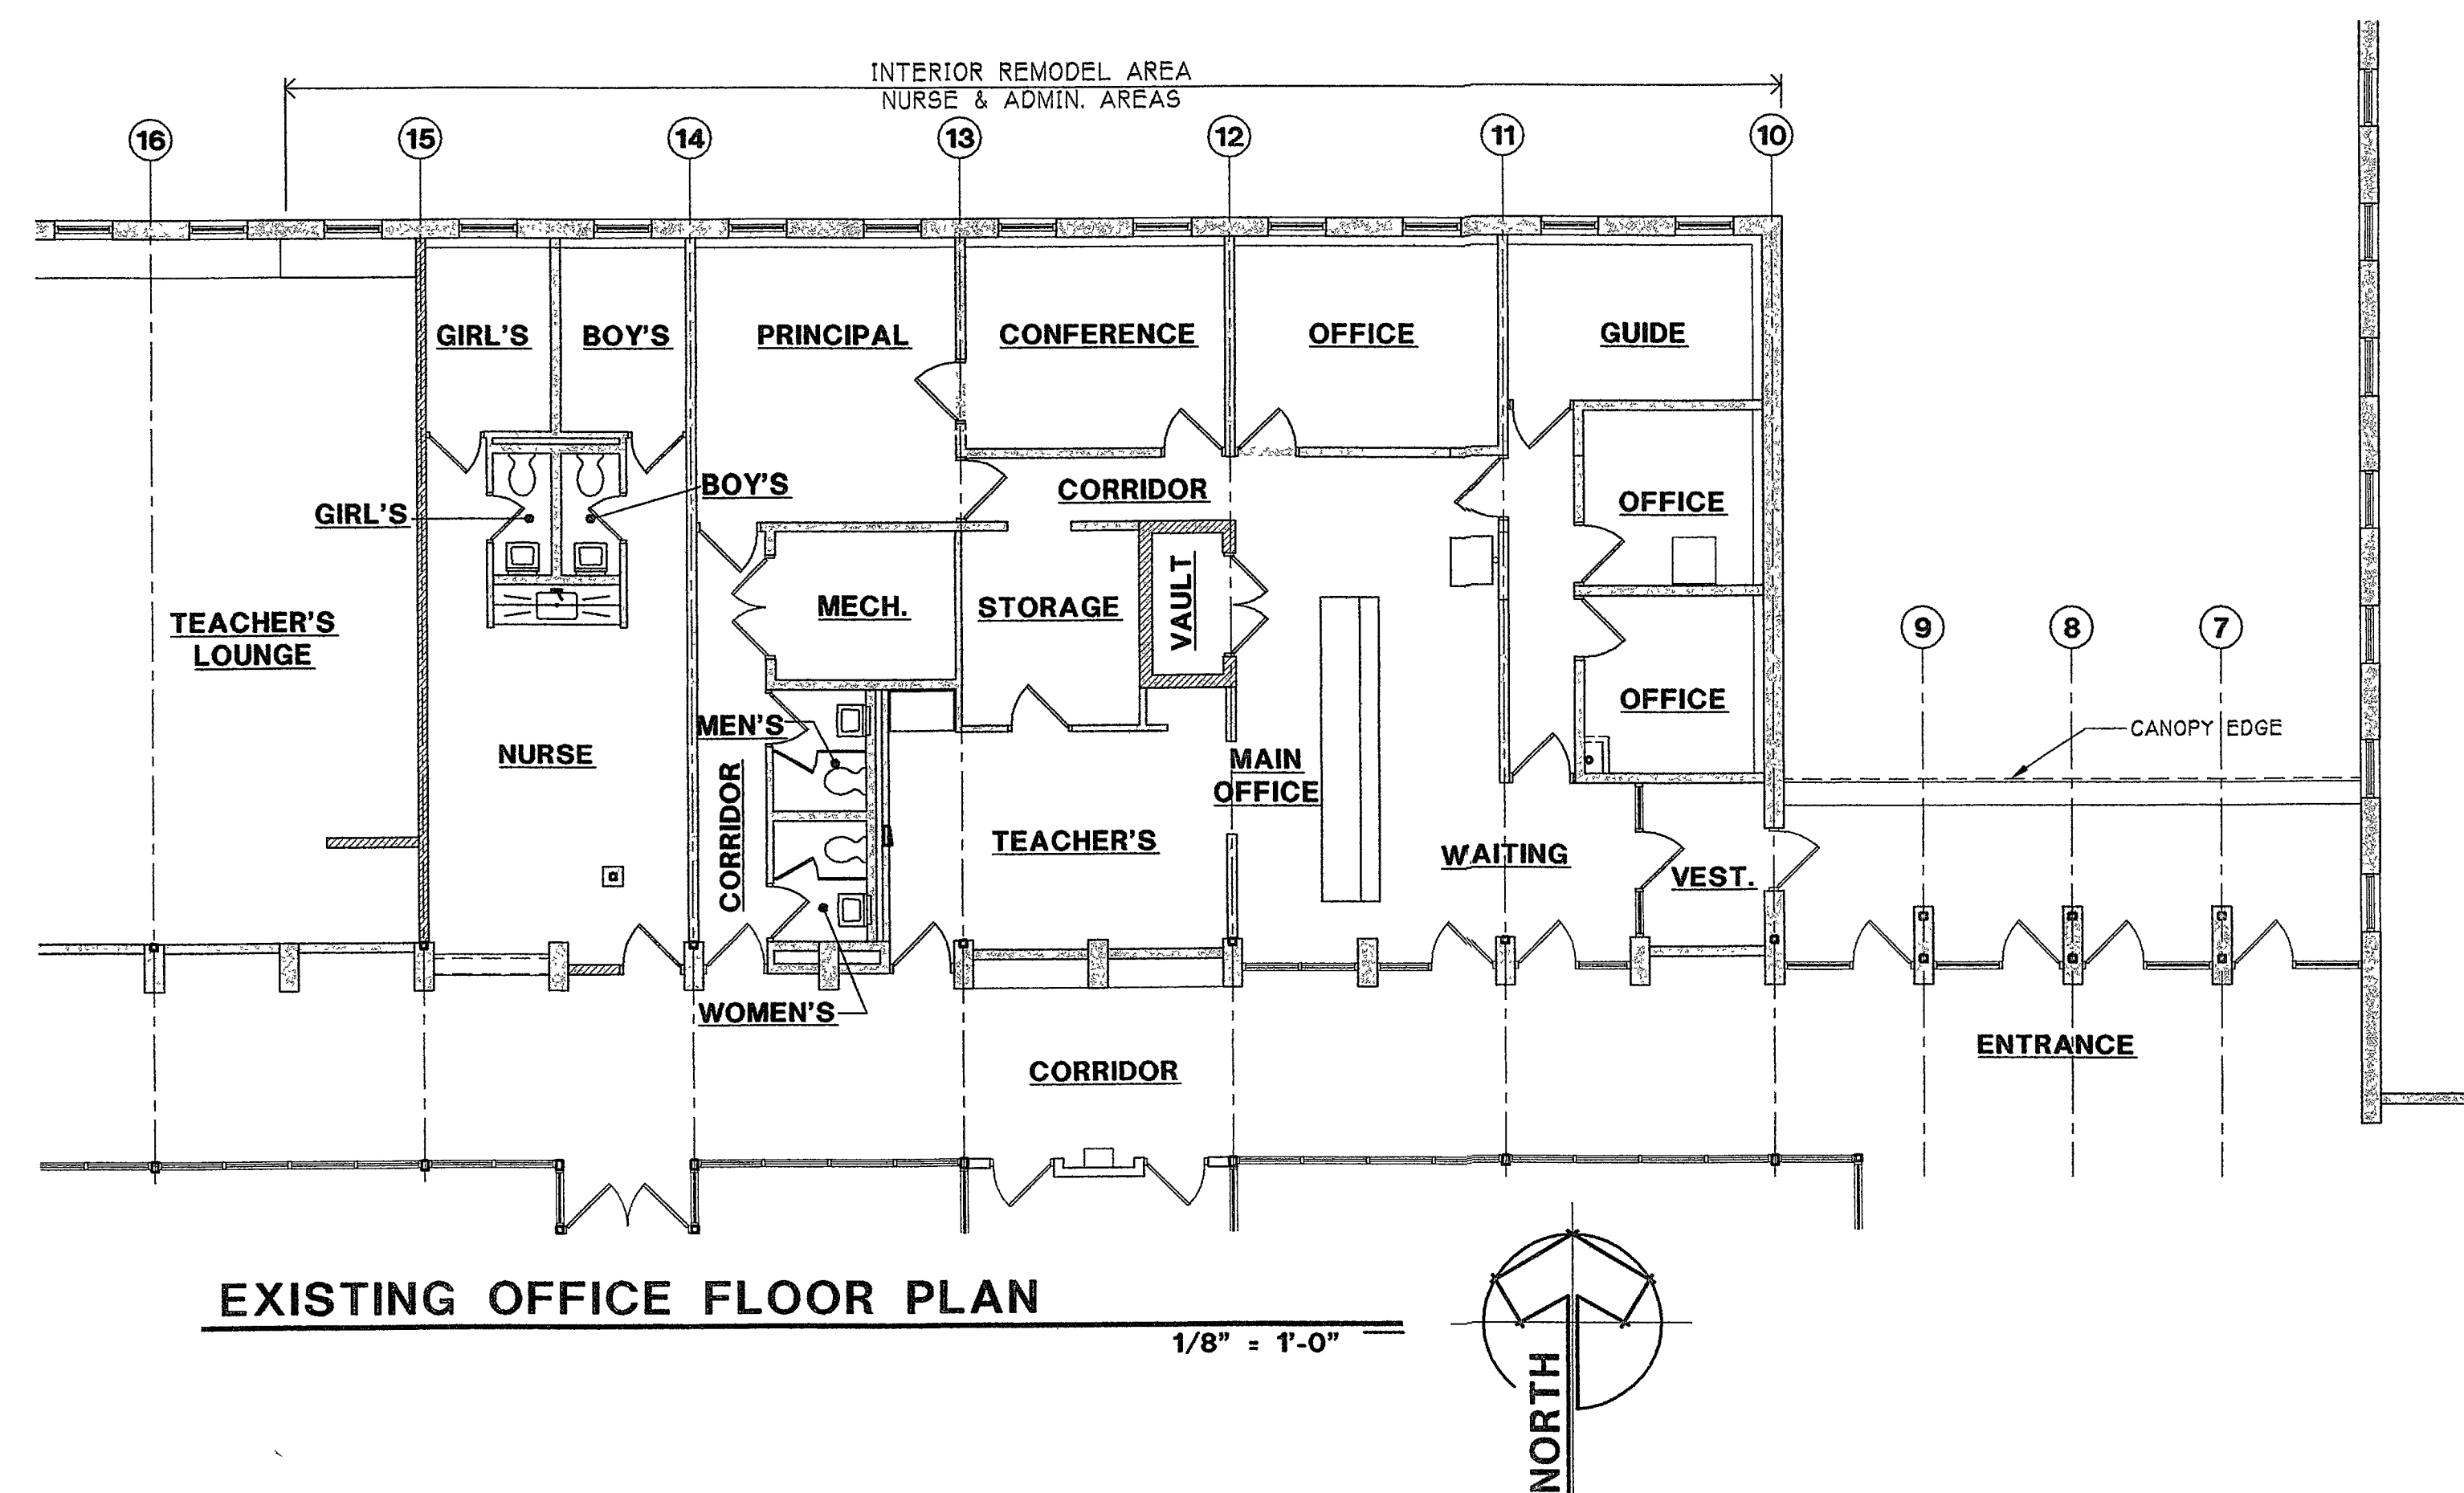

AS-BUILT

PROJECT MANAGER APPROVAL


[Signature]

AREA SCHEDULE

EXISTING:	122,030	S.F.
REMODEL:	2,996	S.F.
NEW AREA:	N/A	

OVERALL BUILDING PLAN

1. CONSTRUCTED IN 1966
2. GROUP 'E' OCCUPANCY
3. TYPE II-B CONSTRUCTION, W/
NON-RATED CORRIDORS
4. GREATER THAN 60 FT. AREA
SEPARATION ON ALL SIDES

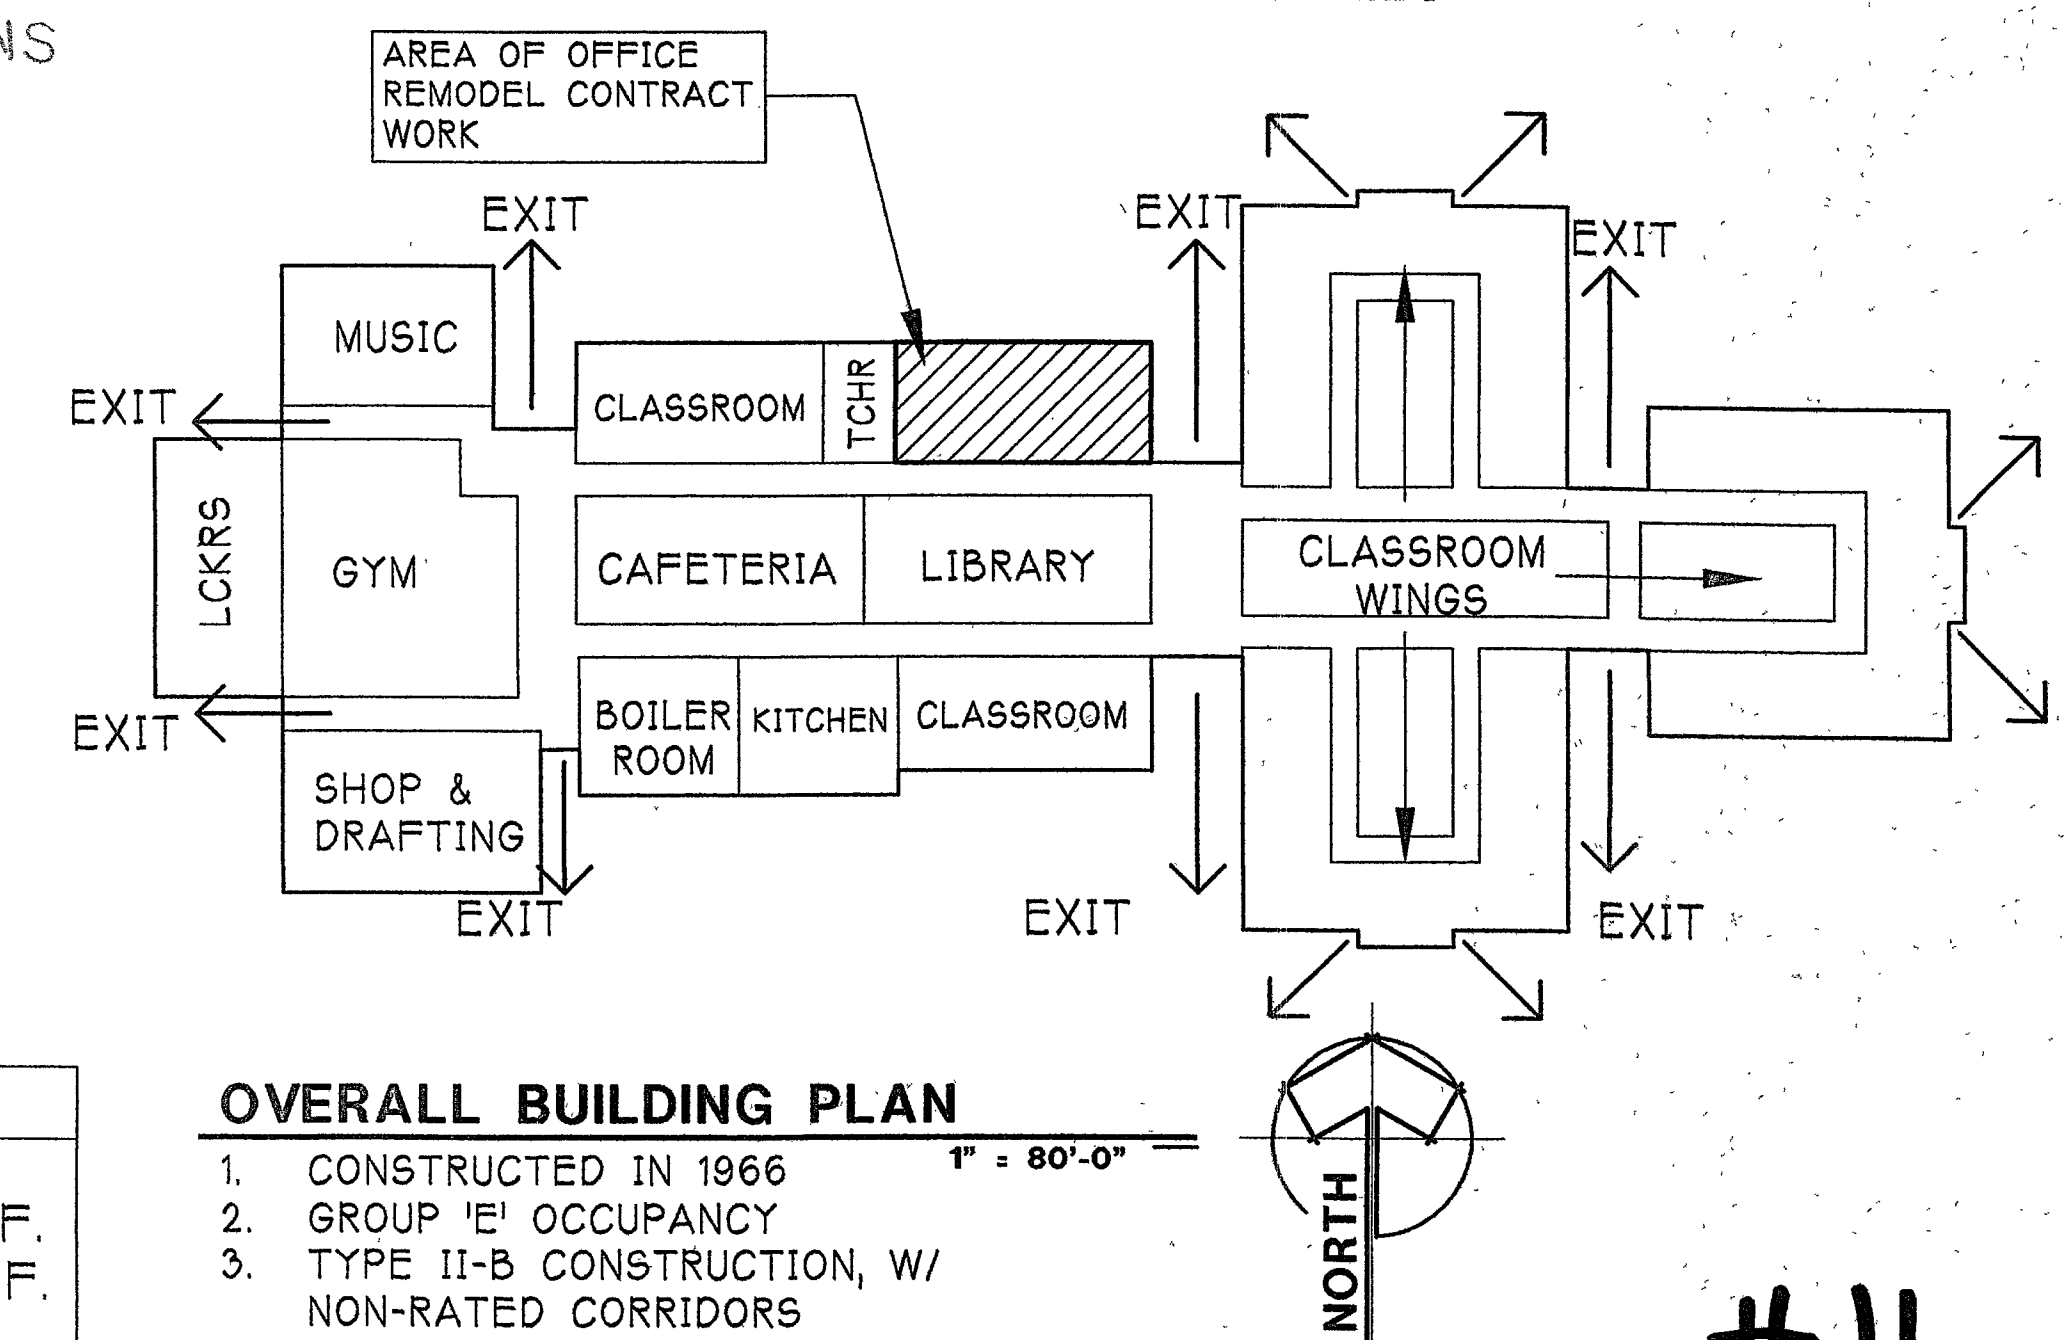

9/20/11 LARSON AS BUILT S

WESTCHESTER INTERMEDIATE SCHOOL - OFFICE REMODEL
 1050 S. FIFTH STREET
 CHESTER, INDIANA
gerometta & kinel architects, inc.
chester, indiana



DATE	4/26/11
FILE	AS NOTED
OWN	JAV
	1117
ET	T1
	15 SHEETS