

DUNELAND SCHOOL CORPORATION

2020 NURSE'S OFFICE RENOVATIONS AT: BAILLY ELEMENTARY SCHOOL

800 S. 5TH STREET, CHESTERTON, INDIANA 46304

TRIA PROJECT#: 20-006

ARCHITECT:

TRIA ARCHITECTURE, INC.

West Suburban Office: 901 McClintock Drive, Suite 100
Burr Ridge, Illinois 60521

South Suburban Office: 1820 Ridge Road, Suite 209
Homewood, Illinois 60430

Indiana Office: 436 Sand Creek Drive N, Suite 105
Chesterton, Indiana 46304


Company Main: 630.455.4500 Fax: 630.455.4040
www.TriaArchitecture.com

M.E.P. CONSULTANT:

OAS, LLC.

769 Heartland Dr., Unit A
Sugar Grove, Illinois 60554

Phone: 630.538.1996
www.oasllc.net

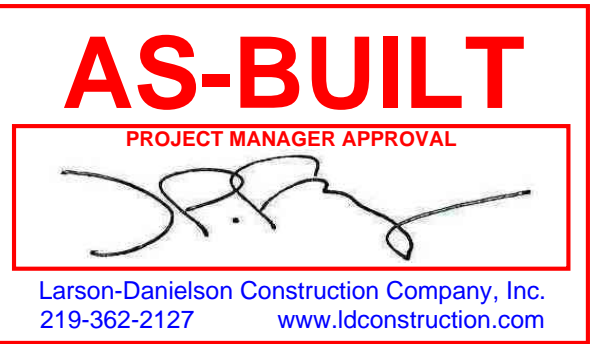

ISSUED FOR PROPOSAL:
APRIL 07, 2020

TRIA ARCHITECTURE, INC. HEREBY EXPRESSLY
RESERVES ALL COPYRIGHT AND OTHER PROPERTY
RIGHTS PRESENT WITHIN THESE DOCUMENTS.
REPRODUCTION, SALE, OR ALTERATION OF THESE
DOCUMENTS IN WHOLE, OR A PORTION THERE OF,
SHALL BE PROHIBITED WITHOUT PRIOR WRITTEN
CONSENT OF TRIA ARCHITECTURE, INC.

COPYRIGHT 2020 TRIA ARCHITECTURE, INC.

GENERAL BUILDING CODE REQUIREMENTS

BUILDING CODES REFERENCED:

2012 INTERNATIONAL BUILDING CODE WITH 2014 INDIANA AMENDMENTS

2006 INTERNATIONAL PLUMBING CODE 2ND EDITION AMENDED INDIANA 2012

2008 NATIONAL ELECTRICAL CODE WITH 2009 INDIANA AMENDMENTS

2012 INTERNATIONAL MECHANICAL CODE WITH 2014 INDIANA AMENDMENTS

INDIANA ENERGY CONSERVATION CODE 2010

2012 INTERNATIONAL FIRE CODE WITH 2014 INDIANA AMENDMENTS

2012 INTERNATIONAL FUEL GAS CODE 2ND EDITION WITH 2014 INDIANA AMENDMENTS

OCCUPANCY CLASSIFICATION:

EDUCATIONAL GROUP E

DESIGN FIRM REGISTRATION:

THOMAS R. SZURGOT

INDIANA LICENSE NUMBER: *A10200113

DRAWING INDEX

T1.00 TITLE SHEET, SITE LOCATION MAP, INDEX, AND GENERAL
BUILDING CODE REQUIREMENTS

ARCHITECTURAL

AG0.00 SYMBOLS, ABBREVIATIONS AND TYPICAL MOUNTING
HEIGHTS

AG2.10 PARTIAL SAFETY REFERENCE PLAN

A0.10 PARTIAL EXISTING FLOOR PLAN

A0.11 PARTIAL EXISTING FLOOR REFLECTED

CEILING PLAN

A1.10 PARTIAL FLOOR PLAN

A2.00 DOOR AND FRAME SCHEDULE, TYPES, DETAILS, WALL
TYPES, INTERIOR ELEVATIONS AND NOTES

A3.00 ENLARGED PLAN AND INTERIOR ELEVATIONS

A7.10 PARTIAL REFLECTED CEILING PLAN AND DETAILS

A9.10 PARTIAL FLOOR FINISH PLAN

A9.50 ROOM FINISH SCHEDULE

MECHANICAL

M0.10 PARTIAL EXISTING FLOOR PLAN - MECHANICAL

M1.10 PARTIAL FLOOR PLAN - MECHANICAL

PLUMBING

P0.10 PARTIAL EXISTING FLOOR PLAN - PLUMBING

P1.10 PARTIAL NEW FLOOR PLAN - PLUMBING

P2.00 RISER DIAGRAM - PLUMBING

P3.00 ABBREVIATIONS, NOTES, SCHEDULES, AND SYMBOLS -
PLUMBING

P4.00 DETAILS - PLUMBING

ELECTRICAL

E0.10 PARTIAL EXISTING FLOOR PLAN - ELECTRICAL


E1.10 PARTIAL FLOOR PLAN - LIGHTING - ELECTRICAL

E2.10 PARTIAL FLOOR PLAN - POWER - ELECTRICAL




SCHOOL BOARD

BOARD PRESIDENT	BRANDON KROFT
BOARD VICE PRESIDENT	KRISTIN KROEGER
BOARD SECRETARY	RONALD STONE
BOARD MEMBER	JOHN MARSHALL
BOARD MEMBER	ALAYNA LIGHTFOOT FOL
SUPERINTENDENT	DR. CHIP PETTIT

SITE LOCATION MAP

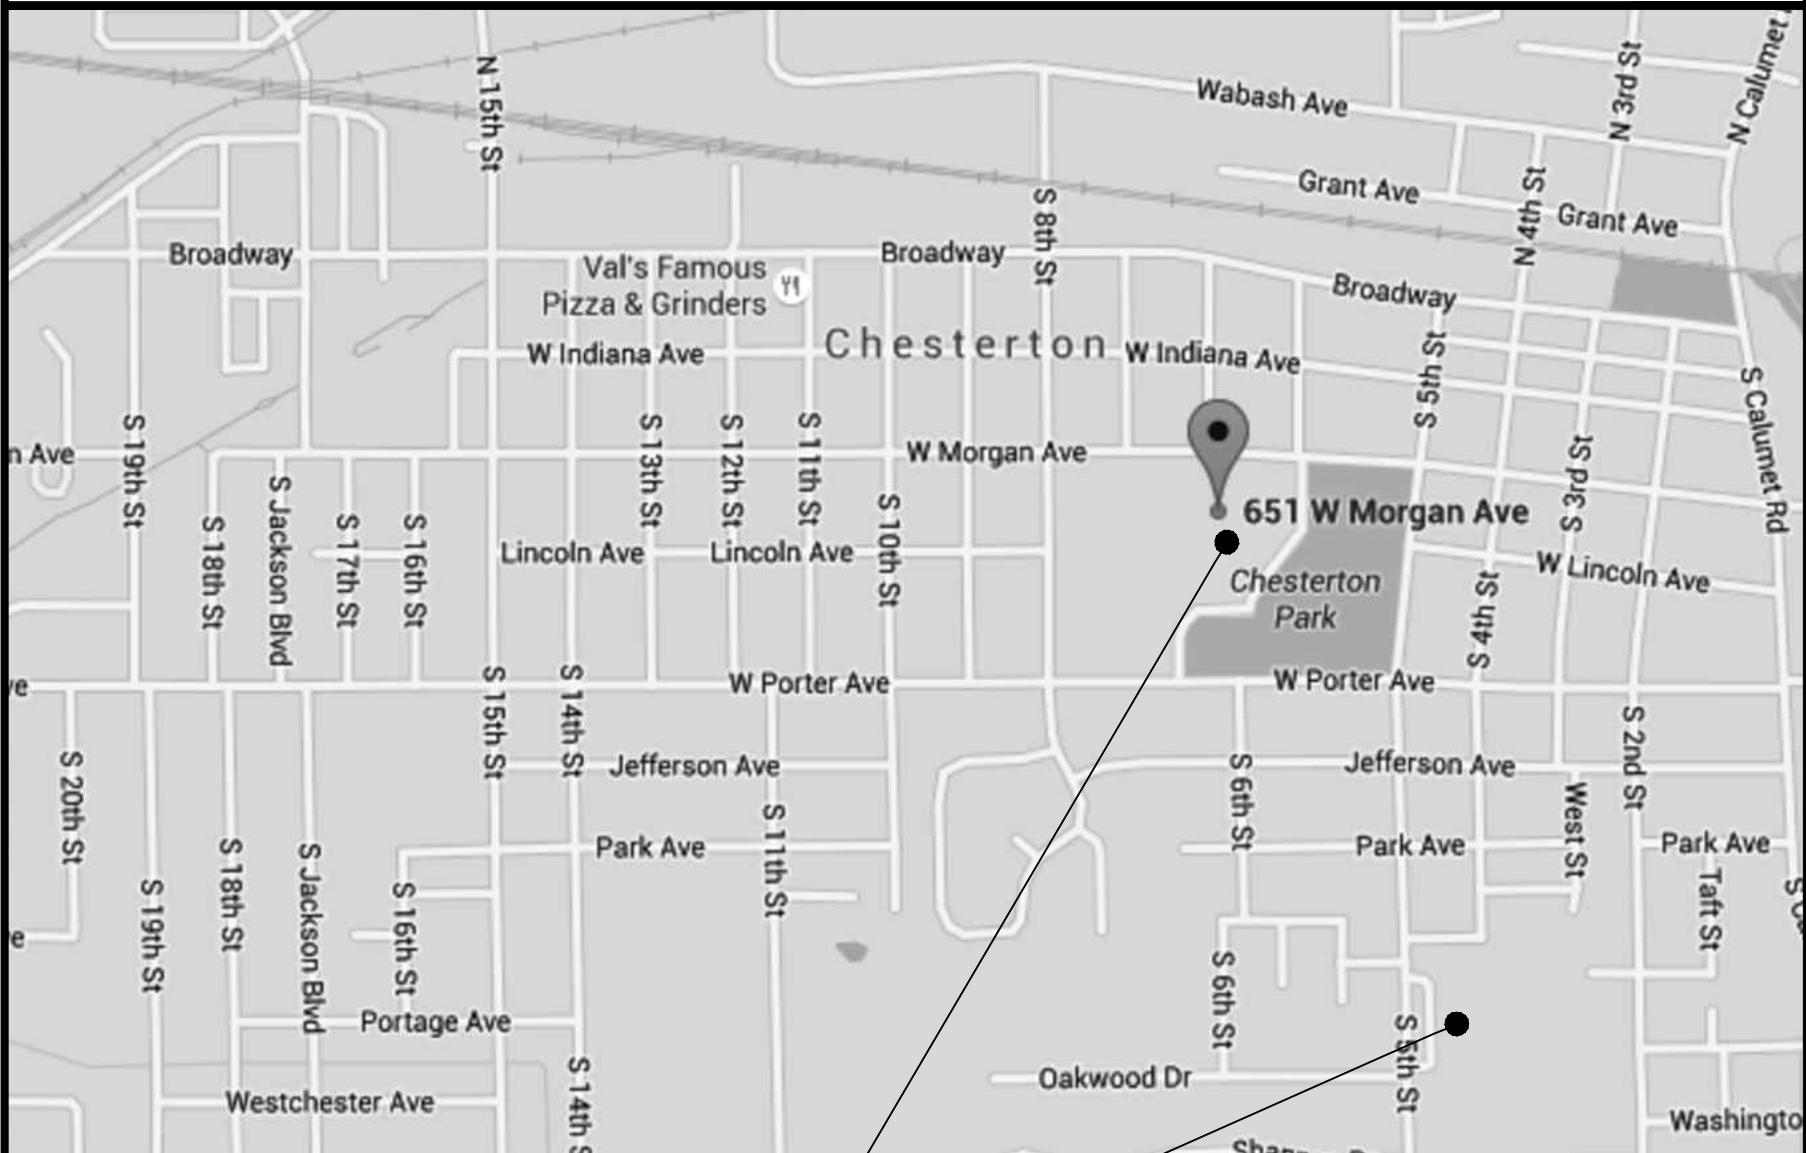




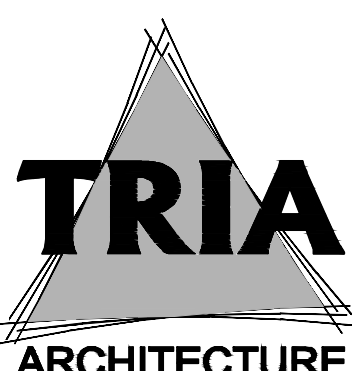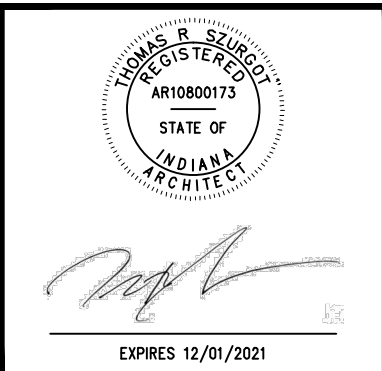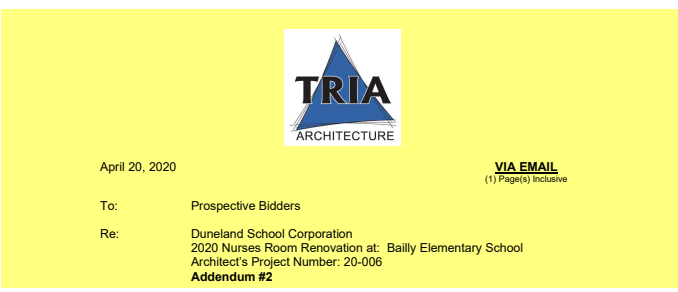





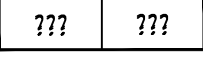



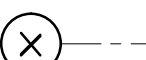
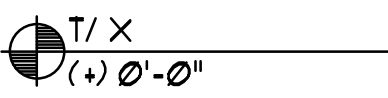
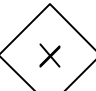
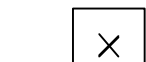
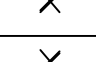
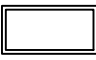
ADMINISTRATION CENTER /
DISTRICT OFFICE
BAILLY ELEMENTARY SCHOOL





REVISIONS:

T1.00

ARCHITECTURAL SYMBOLS AND ABBREVIATIONS

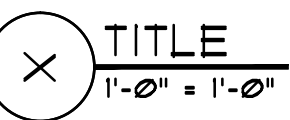	SAFETY REFERENCE ROOM INFORMATION TAG		RECESSED DOWNLIGHT	AP	ACOUSTICAL PANEL	PT	PAINT
	SAFETY REFERENCE EXIT INFORMATION TAG		HVAC SUPPLY	BCS	BABY CHANGING STATION	PTD	PAPER TOWEL DISPENSER
	SAFETY REFERENCE EGRESS PATH		HVAC RETURN	CH	COAT HOOK	PTTD	PAPER TOWEL TRASH DISPOSAL
	BREAK LINE		S.A.T. CEILING	CT	CERAMIC TILE	RBR	RUBBER
	WINDOW TAG		PLASTER OR GYP. BD.	CMU	CONCRETE MASONRY UNIT	RBB	RUBBER BASE
	DOOR TAG			CP	CONDENSATE PIPE	RBT	RUBBER TILE FLOORING
	NORTH ARROW			CPT	CARPET	RD	ROOF DRAIN
	SECTION TAG			CRT	CONCRETE	RH	ROOF HATCH
	ELEVATION TAG			CU	CONDENSING UNIT	RTU	ROOFTOP UNIT
	DETAIL TAG / DRAWING TITLE			DF	DRINKING FOUNTAIN	RST	RUBBER STAIR TREADS AND RISERS
	WALL TYPE TAG			EF	EXHAUST FAN	REF	REFRIGERATOR
	COLUMN LINE TAG			EJ	EXPANSION JOINT	SAT	SUSPENDED ACOUSTICAL TILE
	ELEVATION TAG (HEIGHT)			EP	ELECTRICAL PENETRATION	SD	SOAP DISPENSER
	REMODELING NOTE TAG			EQ	EQUAL	SGT	STRUCTURAL GLAZED TILE
	DEMOLITION NOTE TAG			ETR	EXISTING TO REMAIN	SIM	SIMILAR
	ROOF INSULATION TAGS			EWC	ELECTRIC WATER CHILLER	SND	SANITARY NAPKIN DISPOSAL
	ROOM NAME TAG			EX	EXISTING	SNP	SANITARY NAPKIN DISPENSER
	2'x4' RECESSED FLUORESCENT FIXTURE			EXP	EXPOSED	STL	STEEL
				FD	FLOOR DRAIN	TDU	TRASH DISPOSAL UNIT
				FE	FIRE EXTINGUISHER	TRZ	TERRAZZO
				F.E.C.	FIRE EXTINGUISHER CABINET	TTD	TOILET TISSUE DISPENSER
				FP	FIRE PROTECTION	TV	TELEVISION
				GB	GRAB BAR	TYP	TYPICAL
				GL	GLAZING	UR	URINAL
				GP	GAS PIPING	VCT	VINYL COMPOSITE TILE
				GYP.	GYP SUM BOARD	V.I.F.	VERIFY IN FIELD
				HC	HANDICAPPED ACCESSIBLE	VP	VENT PIPE
				HM	HOLLOW METAL	WC	WATER CLOSET
				LAV	LAVATORY	WD	WOOD
				M.E.	MATCH EXISTING	WF	WASH FOUNTAIN
				M	MIRROR	WL C	WALL COVERING
				MO	MASONRY OPENING		
				MTL	METAL		
				MUA	MAKE-UP AIR		
				N.I.C.	NOT IN CONTRACT		
				OH	OPPOSITE HAND		
				PL	PLASTER		
				PRT	PORCELAIN TILE		

TYPICAL MOUNTING HEIGHTS

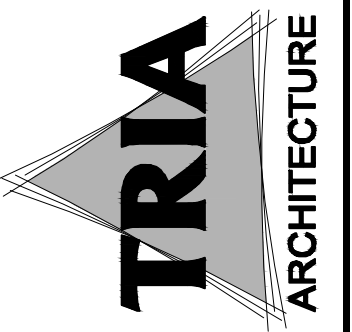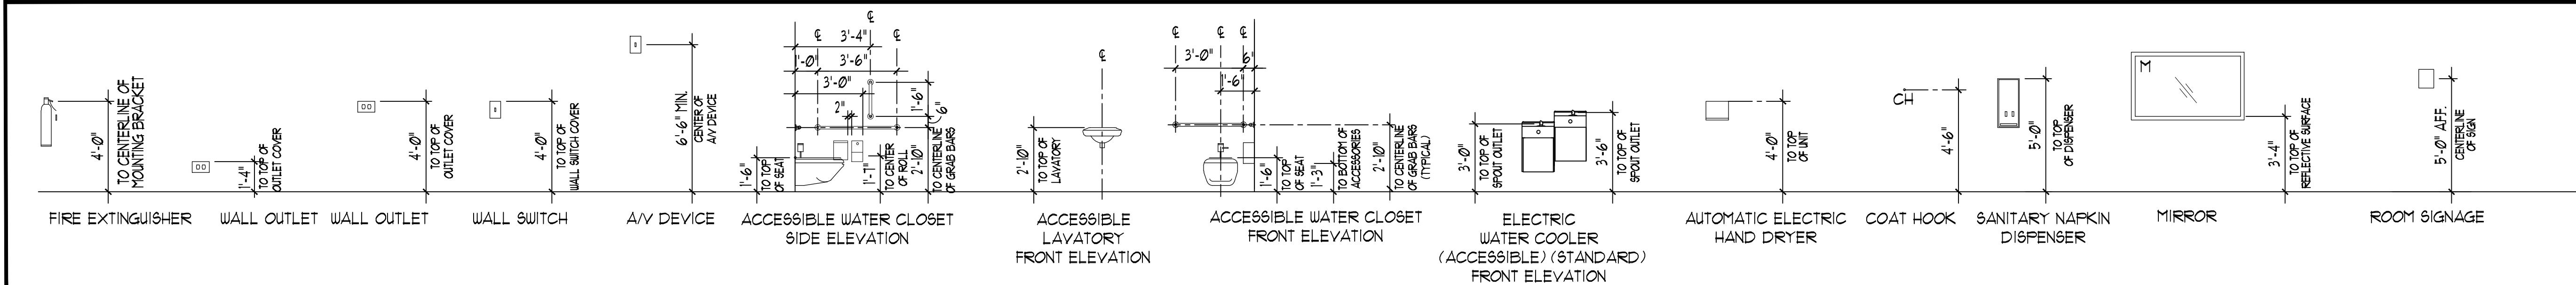

630538,1996



CR-Higgins & Arnold
Sustainable LLC
769 HEARTLAND DR., UNIT A SUGAR GROVE, ILLINOIS 60154

DUNELAND SCHOOL CORPORATION
2020 NURSE'S OFFICE RENOVATIONS AT:
BAILLY ELEMENTARY SCHOOL
800 S 5TH STREET, CHESTERTON, INDIANA 46304


PROJECT MANAGER:	MG	<input checked="" type="checkbox"/>
DRAWN BY:	GM	<input checked="" type="checkbox"/>
		<input checked="" type="checkbox"/>
		<input checked="" type="checkbox"/>
ISSUED FOR PROPOSAL:		<input checked="" type="checkbox"/>
04/07/2020		<input checked="" type="checkbox"/>

**SYMBOLS, ABBREVIATIONS AND
TYPICAL MOUNTING HEIGHTS**



EXPIRES 12/01/2021

AG0.00

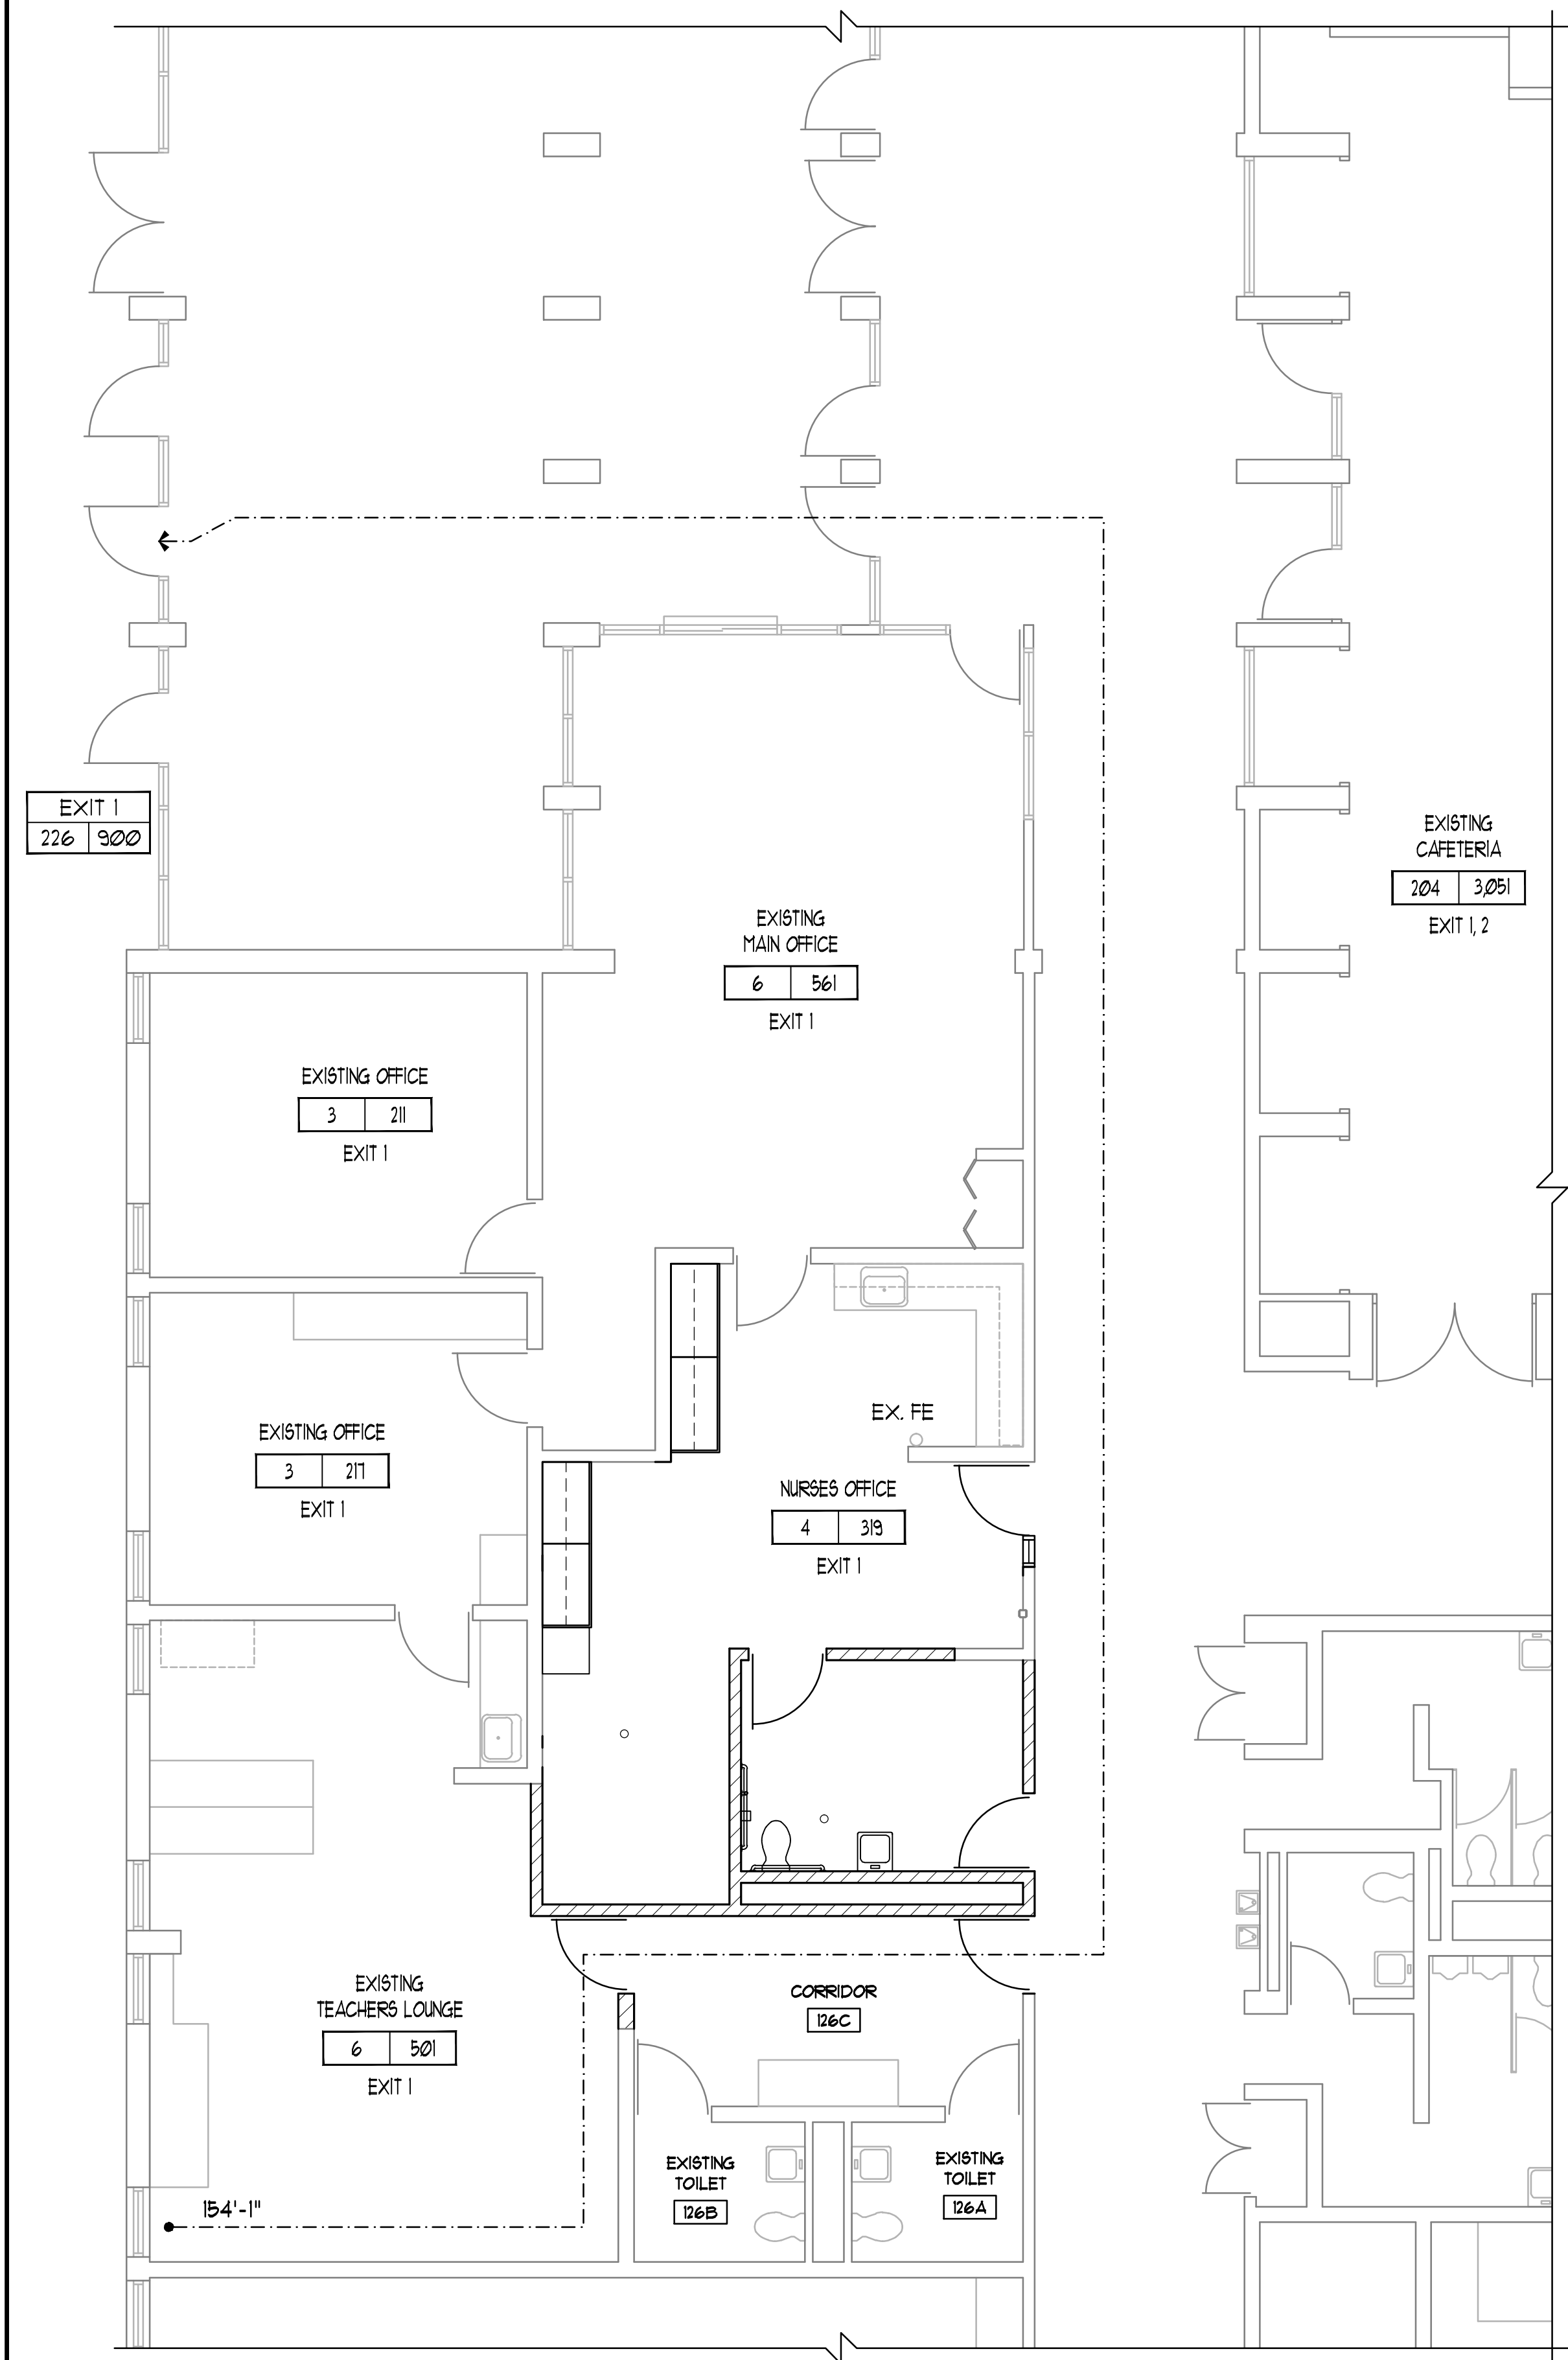

1 PARTIAL SAFETY REFERENCE PLAN
3/16" = 1'-0"

N

SAFETY REFERENCE LEGEND	
<div>OCCUPANCY</div> <div>AREA (S.F.)</div> <div>EXIT(S) USED</div> <div>EXIT X</div>	ROOM OCCUPANCY AND EXIT INFORMATION
<div>EXIT NUMBER</div> <div>EXIT #</div> <div>EGRESS CAPACITY USED</div> <div>OCC. CAP.</div> <div>MAXIMUM EGRESS CAPACITY</div>	EXIT EGRESS
<div>1 HOUR FIRE RATED WALL CONSTRUCTION (EXISTING AND NEW)</div>	
<div>2 HOUR FIRE RATED WALL CONSTRUCTION</div>	
<div>SAFETY REFERENCE EGRESS PATH AND DISTANCE</div>	
<div>(XXX)</div>	FIRE RATING OF DOOR ASSEMBLY
<div>K.B.</div>	KNOX BOX LOCATION
<div>EX FEC</div>	EXISTING FIRE EXTINGUISHER CABINET
<div>EX FE</div>	EXISTING FIRE EXTINGUISHER
<div>FEC</div>	FIRE EXTINGUISHER CABINET RECESSED IN WALL CONSTRUCTION
<div>FE</div>	FIRE EXTINGUISHER

OCCUPANCY	
ASSEMBLY: (UNCONCENTRATED)	204 OCCUPANTS
BUSINESS:	22 OCCUPANTS
TOTAL OCCUPANCY:	226 OCCUPANTS

EGRESS	
EXIT ACCESS TRAVEL DISTANCE CALCULATED PER TABLE 1017.2 OF THE 2015 INTERNATIONAL BUILDING CODE	
ALL EXIT ACCESS TRAVEL DISTANCE SHALL NOT EXCEED 250 FEET.	

KEYPLAN
NOT TO SCALE

AREA OF WORK

NOT IN SCOPE OF WORK

THOMAS R. DUNLAP
REGISTERED PROFESSIONAL ENGINEER
STATE OF INDIANA
LICENSE NO. 101000174

EXP. 12/01/2021

TRIA
ARCHITECTURE

NEFPF ONLINE
(P) 63033856


IDAS
INDIANA DESIGN & ARCHITECTURE SOCIETY
700 HIGHLAND BL., SUITE 100, SOUTH BEND, IN 46601

DUNELAND SCHOOL CORPORATION
2020 NURSE'S OFFICE RENOVATIONS AT:
BAILLY ELEMENTARY SCHOOL
800 S 5TH STREET, CHESTERTON, INDIANA 46304

PROJECT NUMBER: 20-006	REVISIONS:
PROJECT MANAGER: ND	1
DRAWN BY: GT	2
USED FOR PROPOSAL: 04/07/2020	3

PARTIAL SAFETY REFERENCE PLAN

AG2.10

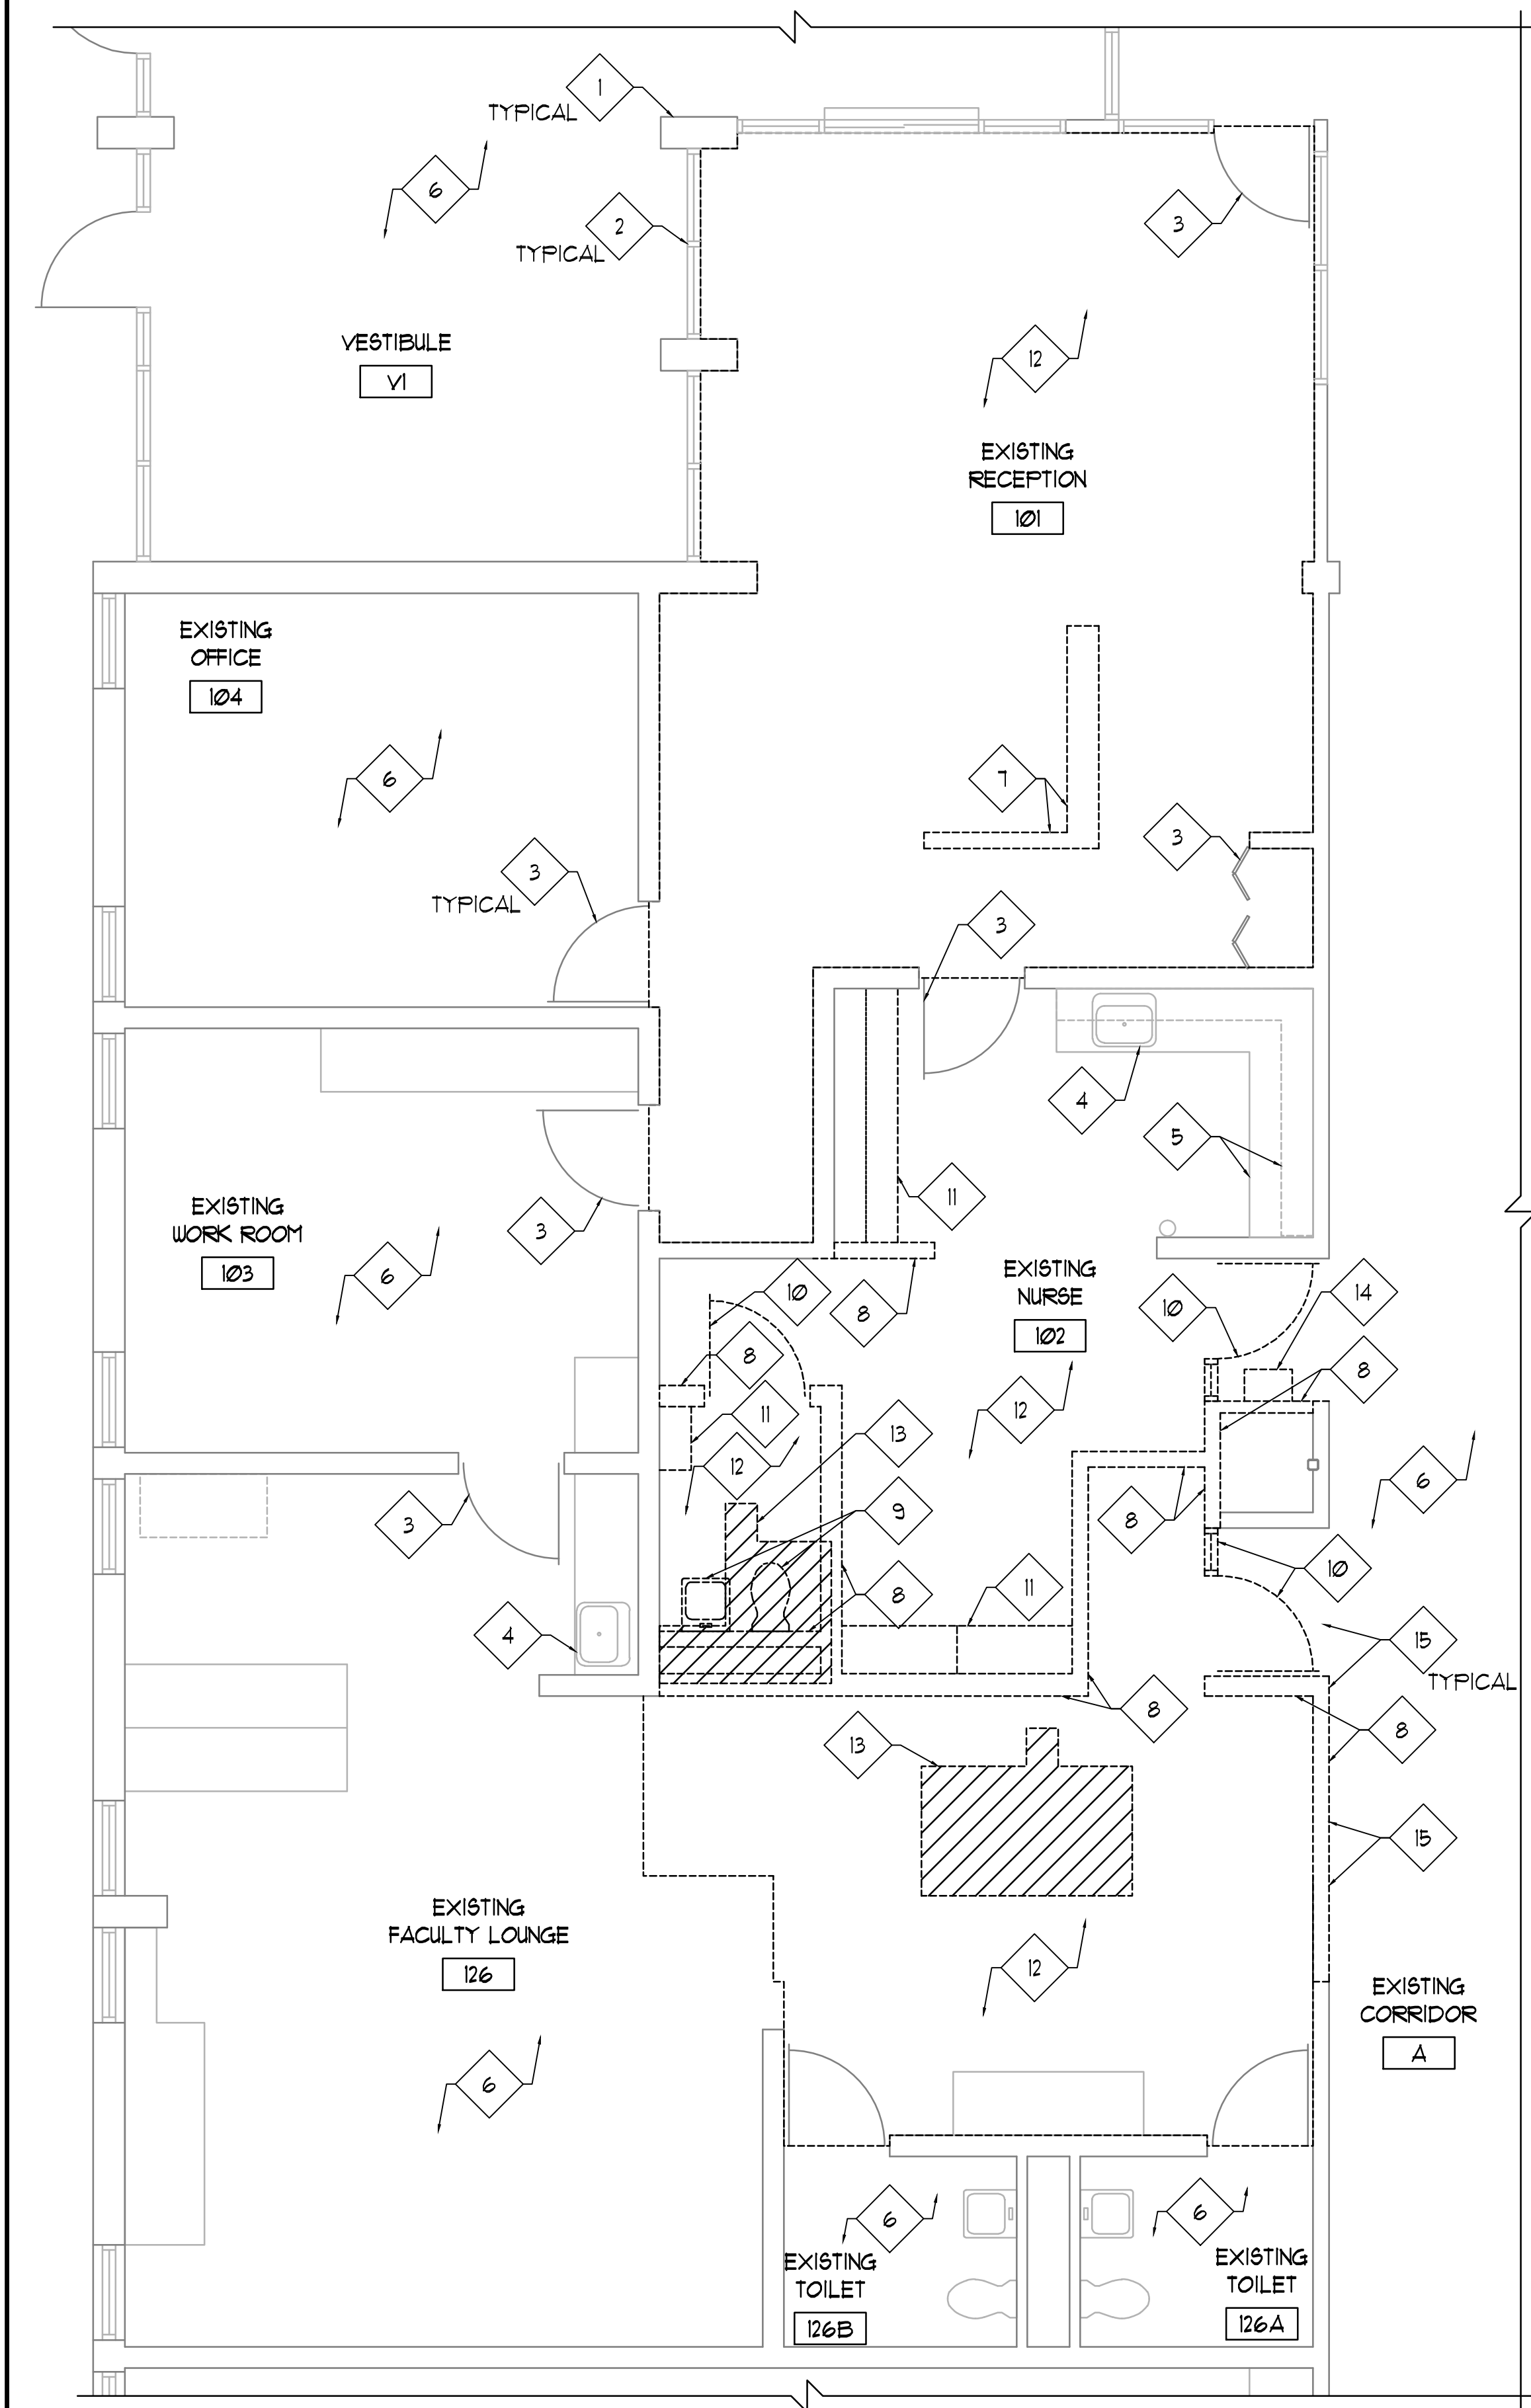

1 PARTIAL EXISTING FLOOR PLAN
1/4" = 1'-0"

LEGEND

EXISTING CONSTRUCTION TO BE REMOVED / DEMO

—

EXISTING CONSTRUCTION TO REMAIN

SAW CUT EXISTING CONCRETE FLOOR SLAB TO PROVIDE WORK INDICATED - REFER TO ELECTRICAL, MECHANICAL, PLUMBING AND STRUCTURAL DRAWINGS.

FURNITURE / EQUIPMENT RELOCATION NOTES

1. OWNER TO REMOVE AND REINSTALL ALL LOOSE FURNITURE, AND ELECTRONIC EQUIPMENT UNLESS OTHERWISE NOTED - REMOVED ITEMS WILL BE HOUSED ON SITE - CONTRACTOR TO COORDINATE MOVING SCOPE AND STORAGE LOCATIONS WITH OWNER PRIOR TO BEGINNING ANY WORK.

2. OWNER TO REMOVE AND RELOCATE ALL OFFICE FURNITURE AND EQUIPMENT UNLESS OTHERWISE NOTED - OWNER TO REINSTALL - COORDINATE ALL OUTLET AND DATA LOCATIONS WITH OWNER - REFER TO ELECTRICAL PLANS.

EXISTING PLAN GENERAL NOTES

1. REFER TO FLOOR PLANS FOR SCOPE OF NEW WORK.

2. FIELD VERIFY ALL EXISTING CONDITIONS. IN THE EVENT THAT AN ITEM NOT SHOWN ON THE DRAWINGS CONFLICTS WITH WORK UNDER THIS CONTRACT, CONTACT THE ARCHITECT PRIOR TO REMOVAL OF THAT ITEM. ITEMS SHOWN ARE INDICATED TO GIVE A GENERAL SCOPE OF WORK. ANY ITEMS REQUIRING REMOVAL/DEMOLITION TO PROPERLY PERFORM CONTRACT WORK BUT NOT SPECIFICALLY SHOWN, SHALL BE REMOVED BY THE CONTRACTOR AT NO ADDITIONAL COST, PROVIDING THE CONDITION WAS VISIBLE DURING BIDDING.

3. SHORE OR BRACE ALL EXISTING CONSTRUCTION AS REQUIRED TO PERFORM WORK.

4. EACH CONTRACTOR SHALL BE RESPONSIBLE FOR ALL CORING, CUTTING, PATCHING, INFILLING, REPAIRING, REFINISHING, AND REMOVAL/REPLACEMENT OF BUILDING CONSTRUCTION REQUIRED TO ACCOMMODATE THE INSTALLATION OR REMOVAL OF THEIR WORK. ALL PATCHING, REPAIRING, AND REFINISHING SHALL BE PERFORMED BY THOSE REGULARLY INVOLVED IN THAT TRADE AND SHALL MATCH THE ADJACENT CONSTRUCTION.

5. REMOVE ALL EQUIPMENT LOCATED ON OR WITHIN WALL CONSTRUCTION SCHEDULED TO BE REMOVED, SO AS TO NOT DISRUPT EXISTING BUILDING OPERATIONS. DISCONNECT ALL ELECTRICAL WIRING, PULL WIRE BACK TO NEAREST JUNCTION BOX OR TO SERVICE.

6. PROTECT ALL EXISTING FINISHES, EQUIPMENT, AND ADJACENT WORK NOT SCHEDULED TO BE REMOVED FROM DAMAGE DURING CONSTRUCTION. ANY DAMAGED FINISHES, EQUIPMENT, OR ADJACENT SURFACES SHALL BE REPAIRED OR REPLACED BY CONTRACTOR AT NO ADDITIONAL COST TO OWNER.

7. THE OWNER HAS FIRST RIGHT OF REFUSAL FOR ANY MATERIAL, EQUIPMENT OR FIXTURE TO BE REMOVED.

8. WHERE POSSIBLE - RUN NEW ELECTRICAL WORK INSIDE WALL AND CEILING CONSTRUCTION (NEW AND EXISTING) - REMOVE EXISTING WALL/CEILING CONSTRUCTION SCHEDULED TO REMAIN AS REQUIRED TO PERFORM WORK INDICATED - PATCH ALL CONSTRUCTION TO PROVIDE A FINISHED CONDITION.

9. AT ALL EXISTING GRASS AREAS, LANDSCAPING ITEMS OR CONCRETE/ASPHALT SURFACES TO REMAIN - PROTECT DURING CONSTRUCTION AND REPAIR ANY AREAS DAMAGED OR OTHERWISE AFFECTED DURING CONSTRUCTION.

10. REMOVE/RELOCATE ALL ACCESSORIES ON WALL CONSTRUCTION TO BE REMOVED.

11. GENERAL CONTRACTOR TO COORDINATE ALL ARCHITECTURAL WORK WITH INDICATED STRUCTURAL, MECHANICAL, ELECTRICAL, PLUMBING AND FIRE PROTECTION WORK - NOTIFY ARCHITECT OF ANY DISCREPANCIES PRIOR TO PERFORMING WORK.

12. PATCH ALL EXISTING OPENINGS AT ALL EQUIPMENT SCHEDULED TO BE REMOVED, INCLUDING ABOVE CEILING- MATCH EXISTING WALL CONSTRUCTION IN MATERIAL THICKNESS, SIZE AND COLOR, UNLESS NOTED OTHERWISE - REFER TO MECHANICAL, ELECTRICAL STRUCTURAL AND FIRE PROTECTION DRAWINGS.

13. ALL EXISTING FLOOR FINISH SCHEDULED TO REMAIN SHALL BE PROTECTED DURING CONSTRUCTION - CONTRACTOR TO PROVIDE FLYWOOD, MDF AND/OR PLASTIC AS REQUIRED TO PROTECT FLOORING FROM DAMAGE DURING CONSTRUCTION - ANY DAMAGE WILL BE REPAIRED BY CONTRACTOR AT NO ADDITIONAL COST TO OWNER.

14. CONTRACTOR TO COORDINATE SCOPE OF WORK PER PHASE SUCH THAT EQUIPMENT, MATERIALS AND SURFACES TO REMAIN IN USE DURING SUBSEQUENT PHASES ARE NOT REMOVED PREMATURELY.

EXISTING PLAN REFERENCED NOTES

1. EXISTING MASONRY WALL CONSTRUCTION TO REMAIN - PROTECT DURING CONSTRUCTION.

2. EXISTING STOREFRONT FRAME AND GLAZING SYSTEM TO REMAIN - PROTECT DURING CONSTRUCTION.

3. EXISTING DOOR AND FRAME TO REMAIN - PROTECT DURING CONSTRUCTION.

4. EXISTING PLUMBING FIXTURE TO REMAIN - PROTECT DURING CONSTRUCTION.

5. EXISTING CASEWORK TO REMAIN - PROTECT DURING CONSTRUCTION.

6. EXISTING FLOOR FINISH TO REMAIN - PROTECT DURING CONSTRUCTION.

7. EXISTING HALF-HEIGHT WALL TO BE REMOVED IN ITS ENTIRETY.

8. EXISTING MASONRY WALL CONSTRUCTION TO BE REMOVED IN ITS ENTIRETY.

9. EXISTING PLUMBING FIXTURE TO BE REMOVED IN ITS ENTIRETY - REFER TO PLUMBING DRAWINGS.

10. EXISTING DOOR AND FRAME SYSTEM TO BE REMOVED IN ITS ENTIRETY.

11. EXISTING CASEWORK TO BE REMOVED IN ITS ENTIRETY.

12. EXISTING FLOOR FINISH AND ASSOCIATED WALL BASE TO BE REMOVED IN ITS ENTIRETY.

13. SAWCUT EXISTING SLAB AS REQUIRED TO PROVIDE WORK INDICATED - REFER TO PLUMBING DRAWINGS - PROTECT ADJACENT FLOOR FINISH SCHEDULED TO REMAIN DURING CONSTRUCTION - CONTRACTOR TO REPAIR/REPLACE ANY DAMAGE AT NO COST TO OWNER.

14. EXISTING OWNER LIFE SAFETY EQUIPMENT TO BE REMOVED, SALVAGED, AND STORED FOR REINSTALLATION.

15. EXISTING STRUCTURAL BEAMS AND JOISTS MUST BE SHORED DURING CONSTRUCTION.

AREA OF WORK

NOT IN SCOPE OF WORK

KEYPLAN
NOT TO SCALE

EXPIRES 12/01/2021

TRIA
ARCHITECTURE

PROJECT NUMBER: 20-006
PROJECT MANAGER: ND
DRAWN BY: GT
USED FOR PROPOSAL: 04/07/2020


REVISIONS:
1
2
3
4
5

DUNELAND SCHOOL CORPORATION
2020 NURSE'S OFFICE RENOVATIONS AT:
BAILLY ELEMENTARY SCHOOL
800 S 5TH STREET, CHESTERTON, INDIANA 46304

PARTIAL EXISTING FLOOR PLAN

A0.10

EXPIRES 12/01/2021

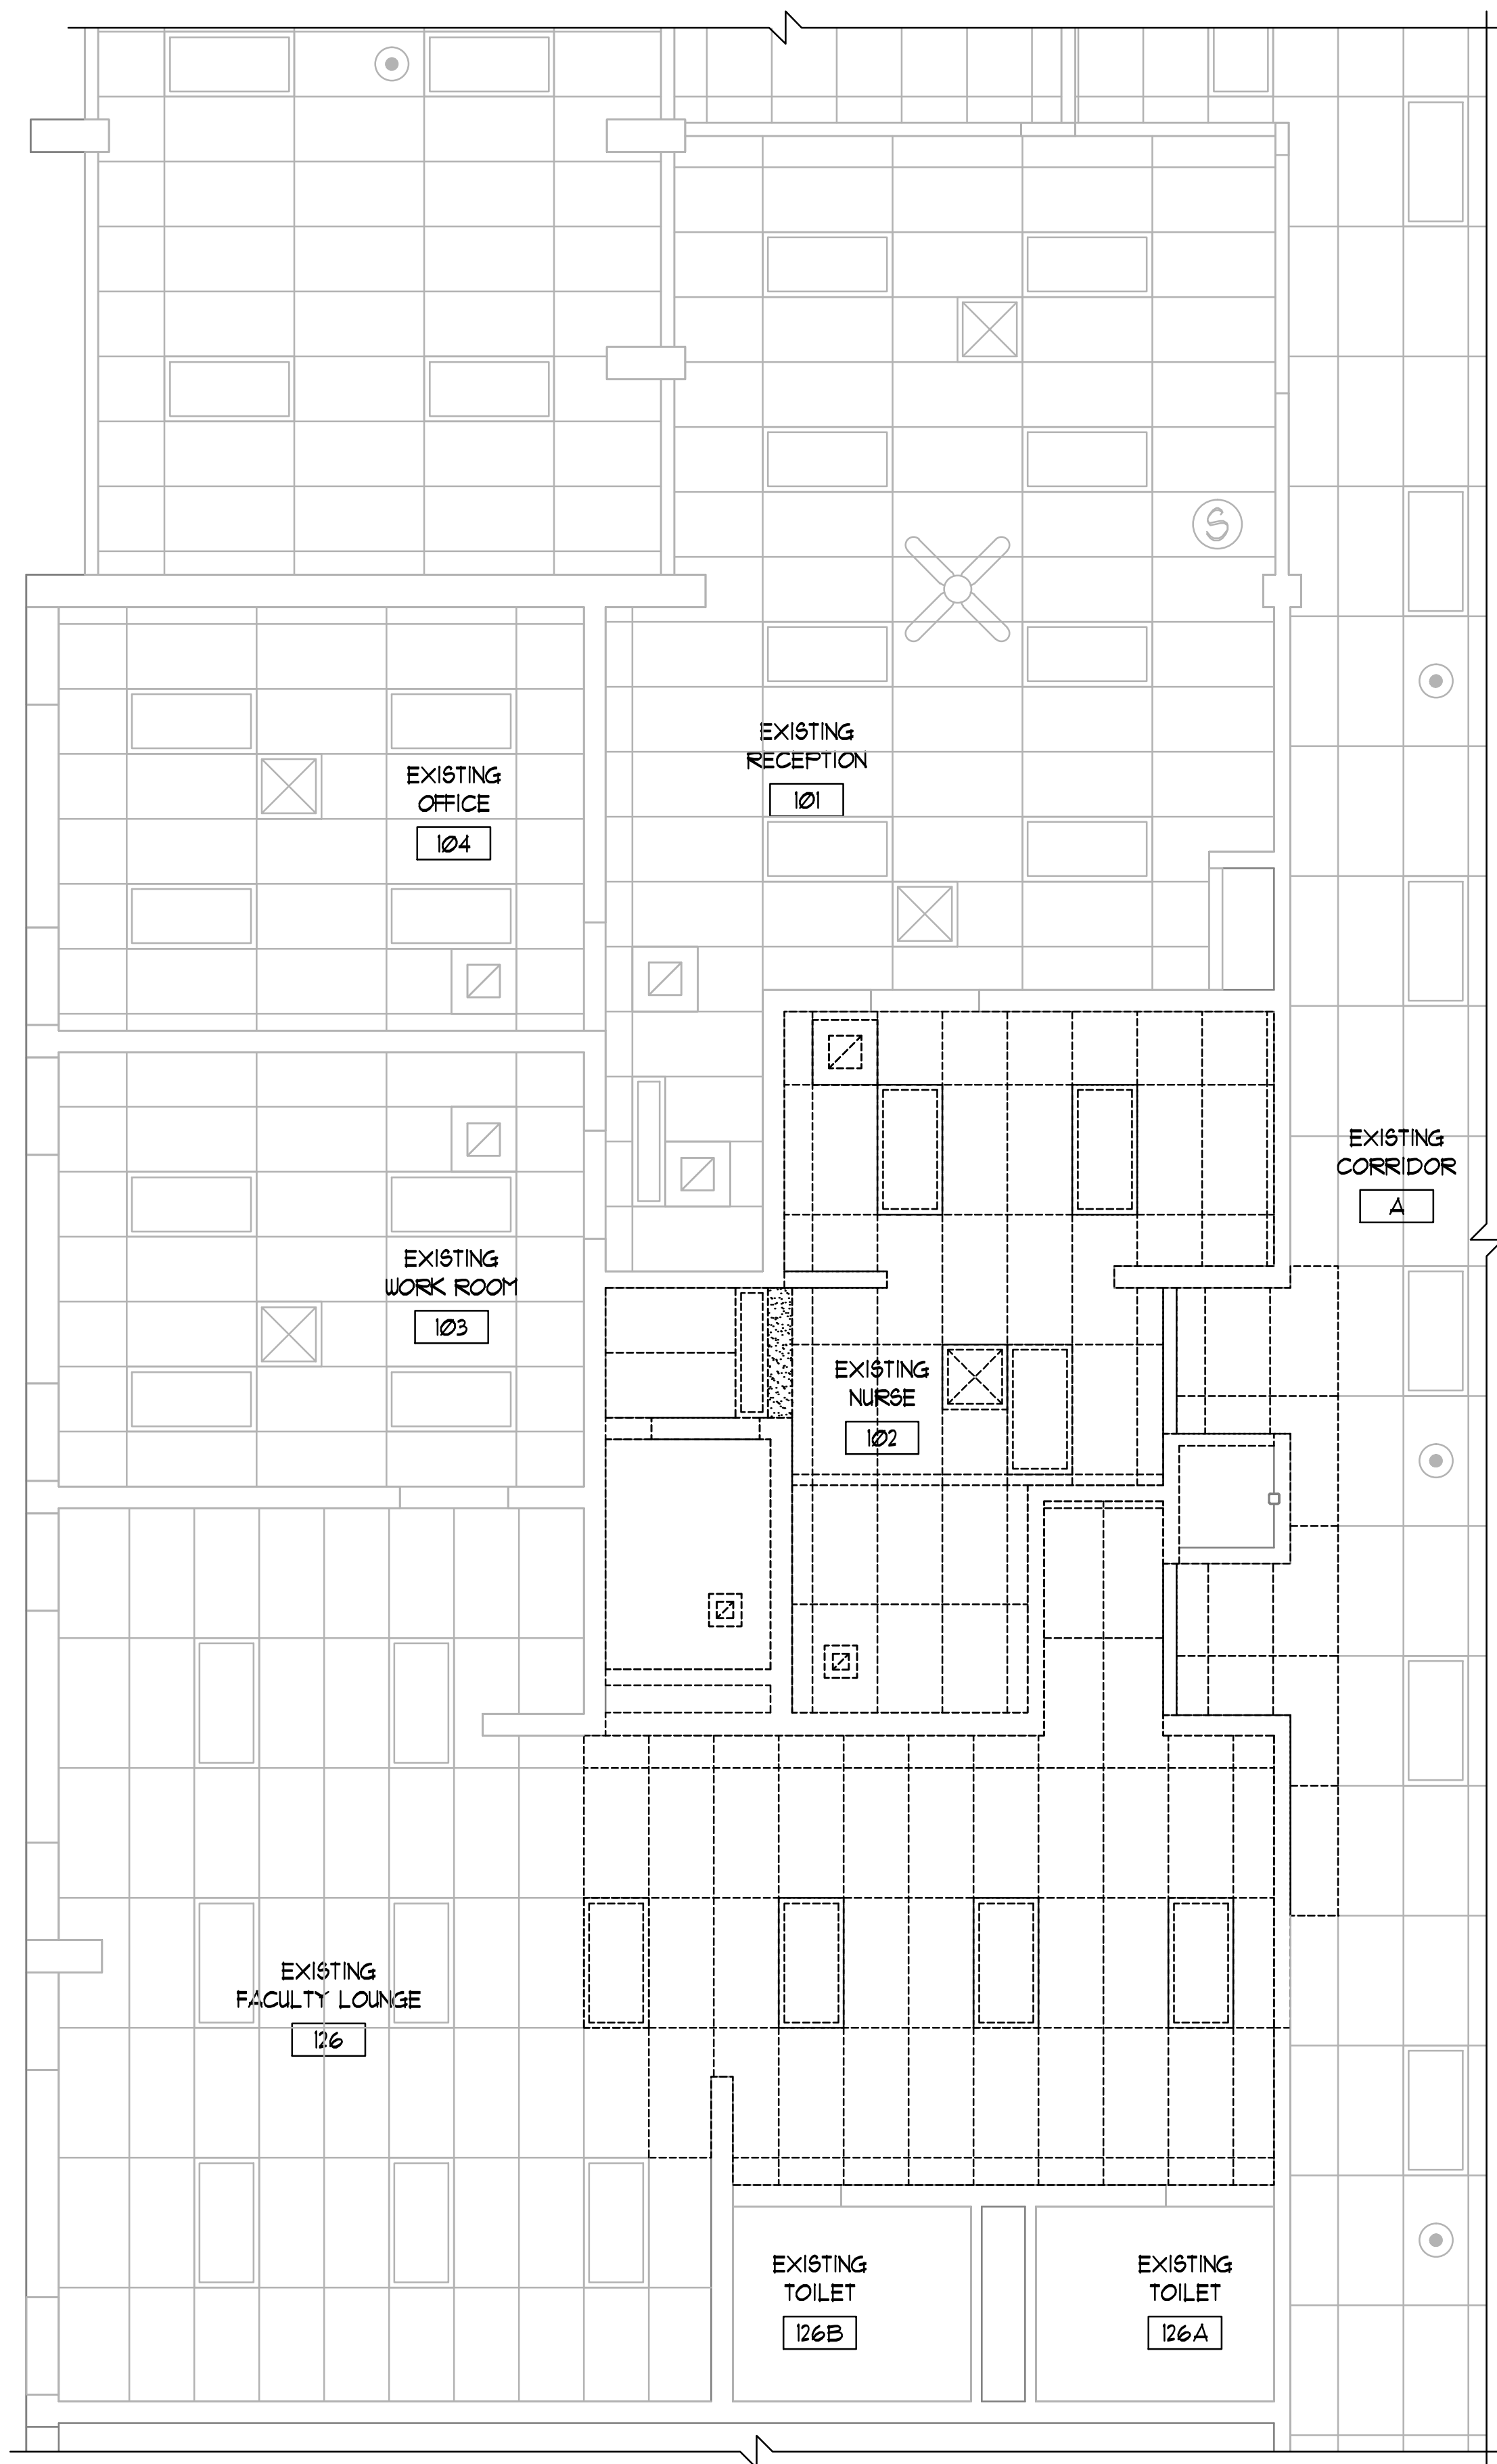

1 PARTIAL EXISTING REFLECTED CEILING PLAN
1/4" = 1'-0"




LEGEND


- SUSPENDED ACOUSTICAL TILE CEILING TO REMAIN - PROTECT DURING CONSTRUCTION.
- SUSPENDED ACOUSTICAL TILE CEILING TO BE REMOVED IN ITS ENTIRETY. REMOVE ALL LIGHTS, LOUVERS, AND OTHER DEVICES.
- AREA OF GYPSUM CEILING/SOFFIT/HEADER TO BE REMOVED IN ITS ENTIRETY - REFER TO DETAILS (UNLESS NOTED OTHERWISE) - REMOVE ALL LIGHTS, LOUVERS, AND OTHER DEVICES
- 2' X 4' RECESSED LIGHT FIXTURE TO REMAIN - REFER TO ELECTRICAL DRAWINGS
- 1' X 4' RECESSED LIGHT FIXTURE TO REMAIN - REFER TO ELECTRICAL DRAWINGS
- 2' X 4' RECESSED LIGHT FIXTURE TO BE REMOVED AND RELOCATED - REFER TO ELECTRICAL DRAWINGS
- 1' X 4' RECESSED LIGHT FIXTURE TO BE REMOVED AND RELOCATED - REFER TO ELECTRICAL DRAWINGS
- MECHANICAL SUPPLY DIFFUSER TO REMAIN - REFER TO MECHANICAL DRAWINGS
- MECHANICAL RETURN/EXHAUST DIFFUSER TO REMAIN - REFER TO MECHANICAL DRAWINGS
- MECHANICAL SUPPLY DIFFUSER TO BE REMOVED - REFER TO MECHANICAL DRAWINGS
- MECHANICAL RETURN/EXHAUST DIFFUSER TO BE REMOVED - REFER TO MECHANICAL DRAWINGS
- SPEAKER TO REMAIN - REFER TO ELECTRICAL DRAWINGS
- EXIT SIGN TO REMAIN - REFER TO ELECTRICAL DRAWINGS
- OCCUPANCY SENSOR TO REMAIN - REFER TO ELECTRICAL DRAWINGS
- SPEAKER TO BE REMOVED - REFER TO ELECTRICAL DRAWINGS
- EXIT SIGN TO BE REMOVED - REFER TO ELECTRICAL DRAWINGS
- OCCUPANCY SENSOR TO BE REMOVED - REFER TO ELECTRICAL DRAWINGS
- EXISTING CONSTRUCTION TO BE REMOVED/DEMO
- EXISTING CONSTRUCTION TO REMAIN

EXISTING REFLECTED CEILING PLAN GENERAL NOTES

- ALL EXISTING CEILING SYSTEMS, LIGHTS, EQUIPMENT AND CEILING-MOUNTED SPEAKERS TO BE REMOVED IN THEIR ENTIRETY WHERE INDICATED - REFER TO MECHANICAL, ELECTRICAL, PLUMBING AND FIRE PROTECTION DRAWINGS.
- REFER TO SHEETS A7.102A-A7.102B AND MECHANICAL, ELECTRICAL AND FIRE PROTECTION DRAWINGS FOR SCOPE OF NEW WORK.
- REFER TO ELECTRICAL PLANS FOR ADDITIONAL CEILING MOUNTED DEVICES AND EQUIPMENT TO BE REMOVED.
- CONTRACTOR TO VERIFY ALL EXISTING CEILING HEIGHTS PRIOR TO BEGINNING WORK ON ANY CEILING SCHEDULED TO RECEIVE WORK.
- FIELD VERIFY ALL EXISTING CONDITIONS. IN THE EVENT THAT AN ITEM NOT SHOWN ON THE DRAWINGS CONFLICTS WITH WORK UNDER THIS CONTRACT, CONTACT THE ARCHITECT PRIOR TO REMOVAL OF THAT ITEM. ITEMS SHOWN ARE INDICATED TO GIVE A GENERAL SCOPE OF WORK. ANY ITEMS REQUIRING REMOVAL/DEMOLITION TO PROPERLY PERFORM CONTRACT WORK BUT NOT SPECIFICALLY SHOWN, SHALL BE REMOVED BY THE CONTRACTOR AT NO ADDITIONAL COST, PROVIDING THE CONDITION WAS VISIBLE DURING BIDDING.
- SHORE OR BRACE ALL EXISTING CONSTRUCTION AS REQUIRED TO PERFORM DEMOLITION WORK.
- EACH CONTRACTOR SHALL BE RESPONSIBLE FOR ALL CORING, CUTTING, PATCHING, INFILLING, REPAIRING, REFINISHING, AND REMOVAL/ REPLACEMENT OF BUILDING CONSTRUCTION REQUIRED TO ACCOMMODATE THE INSTALLATION OR REMOVAL OF THEIR WORK. ALL PATCHING, REPAIRING, AND REFINISHING SHALL BE PERFORMED BY THOSE REGULARLY INVOLVED IN THAT TRADE AND SHALL MATCH THE ADJACENT CONSTRUCTION.
- PROTECT ALL EXISTING FINISHES, EQUIPMENT, AND ADJACENT WORK NOT SCHEDULED TO BE REMOVED FROM DAMAGE DURING CONSTRUCTION. ANY DAMAGED FINISHES, EQUIPMENT, OR ADJACENT SURFACES SHALL BE REPAIRED OR REPLACED BY CONTRACTOR AT NO ADDITIONAL COST TO OWNER.
- THE OWNER HAS FIRST RIGHT OF REFUSAL FOR ANY MATERIAL OR EQUIPMENT REMOVED.

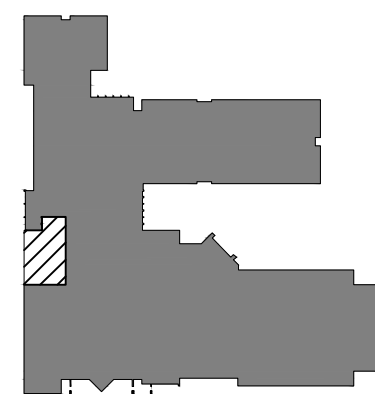

- AREA OF WORK
- NOT IN SCOPE OF WORK

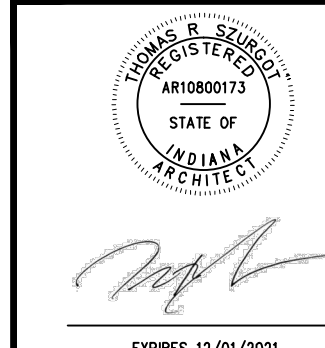

KEYPLAN
NOT TO SCALE



DUNELAND SCHOOL CORPORATION
2020 NURSE'S OFFICE RENOVATIONS AT:
BAILLY ELEMENTARY SCHOOL
800 S 5TH STREET, CHESTERTON, INDIANA 46304


PROJECT NUMBER: 20-006	REVISION:
PROJECT MANAGER: ND	
DRAWN BY: GT	
USED FOR PROPOSAL: 04/07/2020	
PARTIAL EXISTING REFLECTED CEILING PLAN	

A0.11



NEPFP ONLINE
(P) 630338156



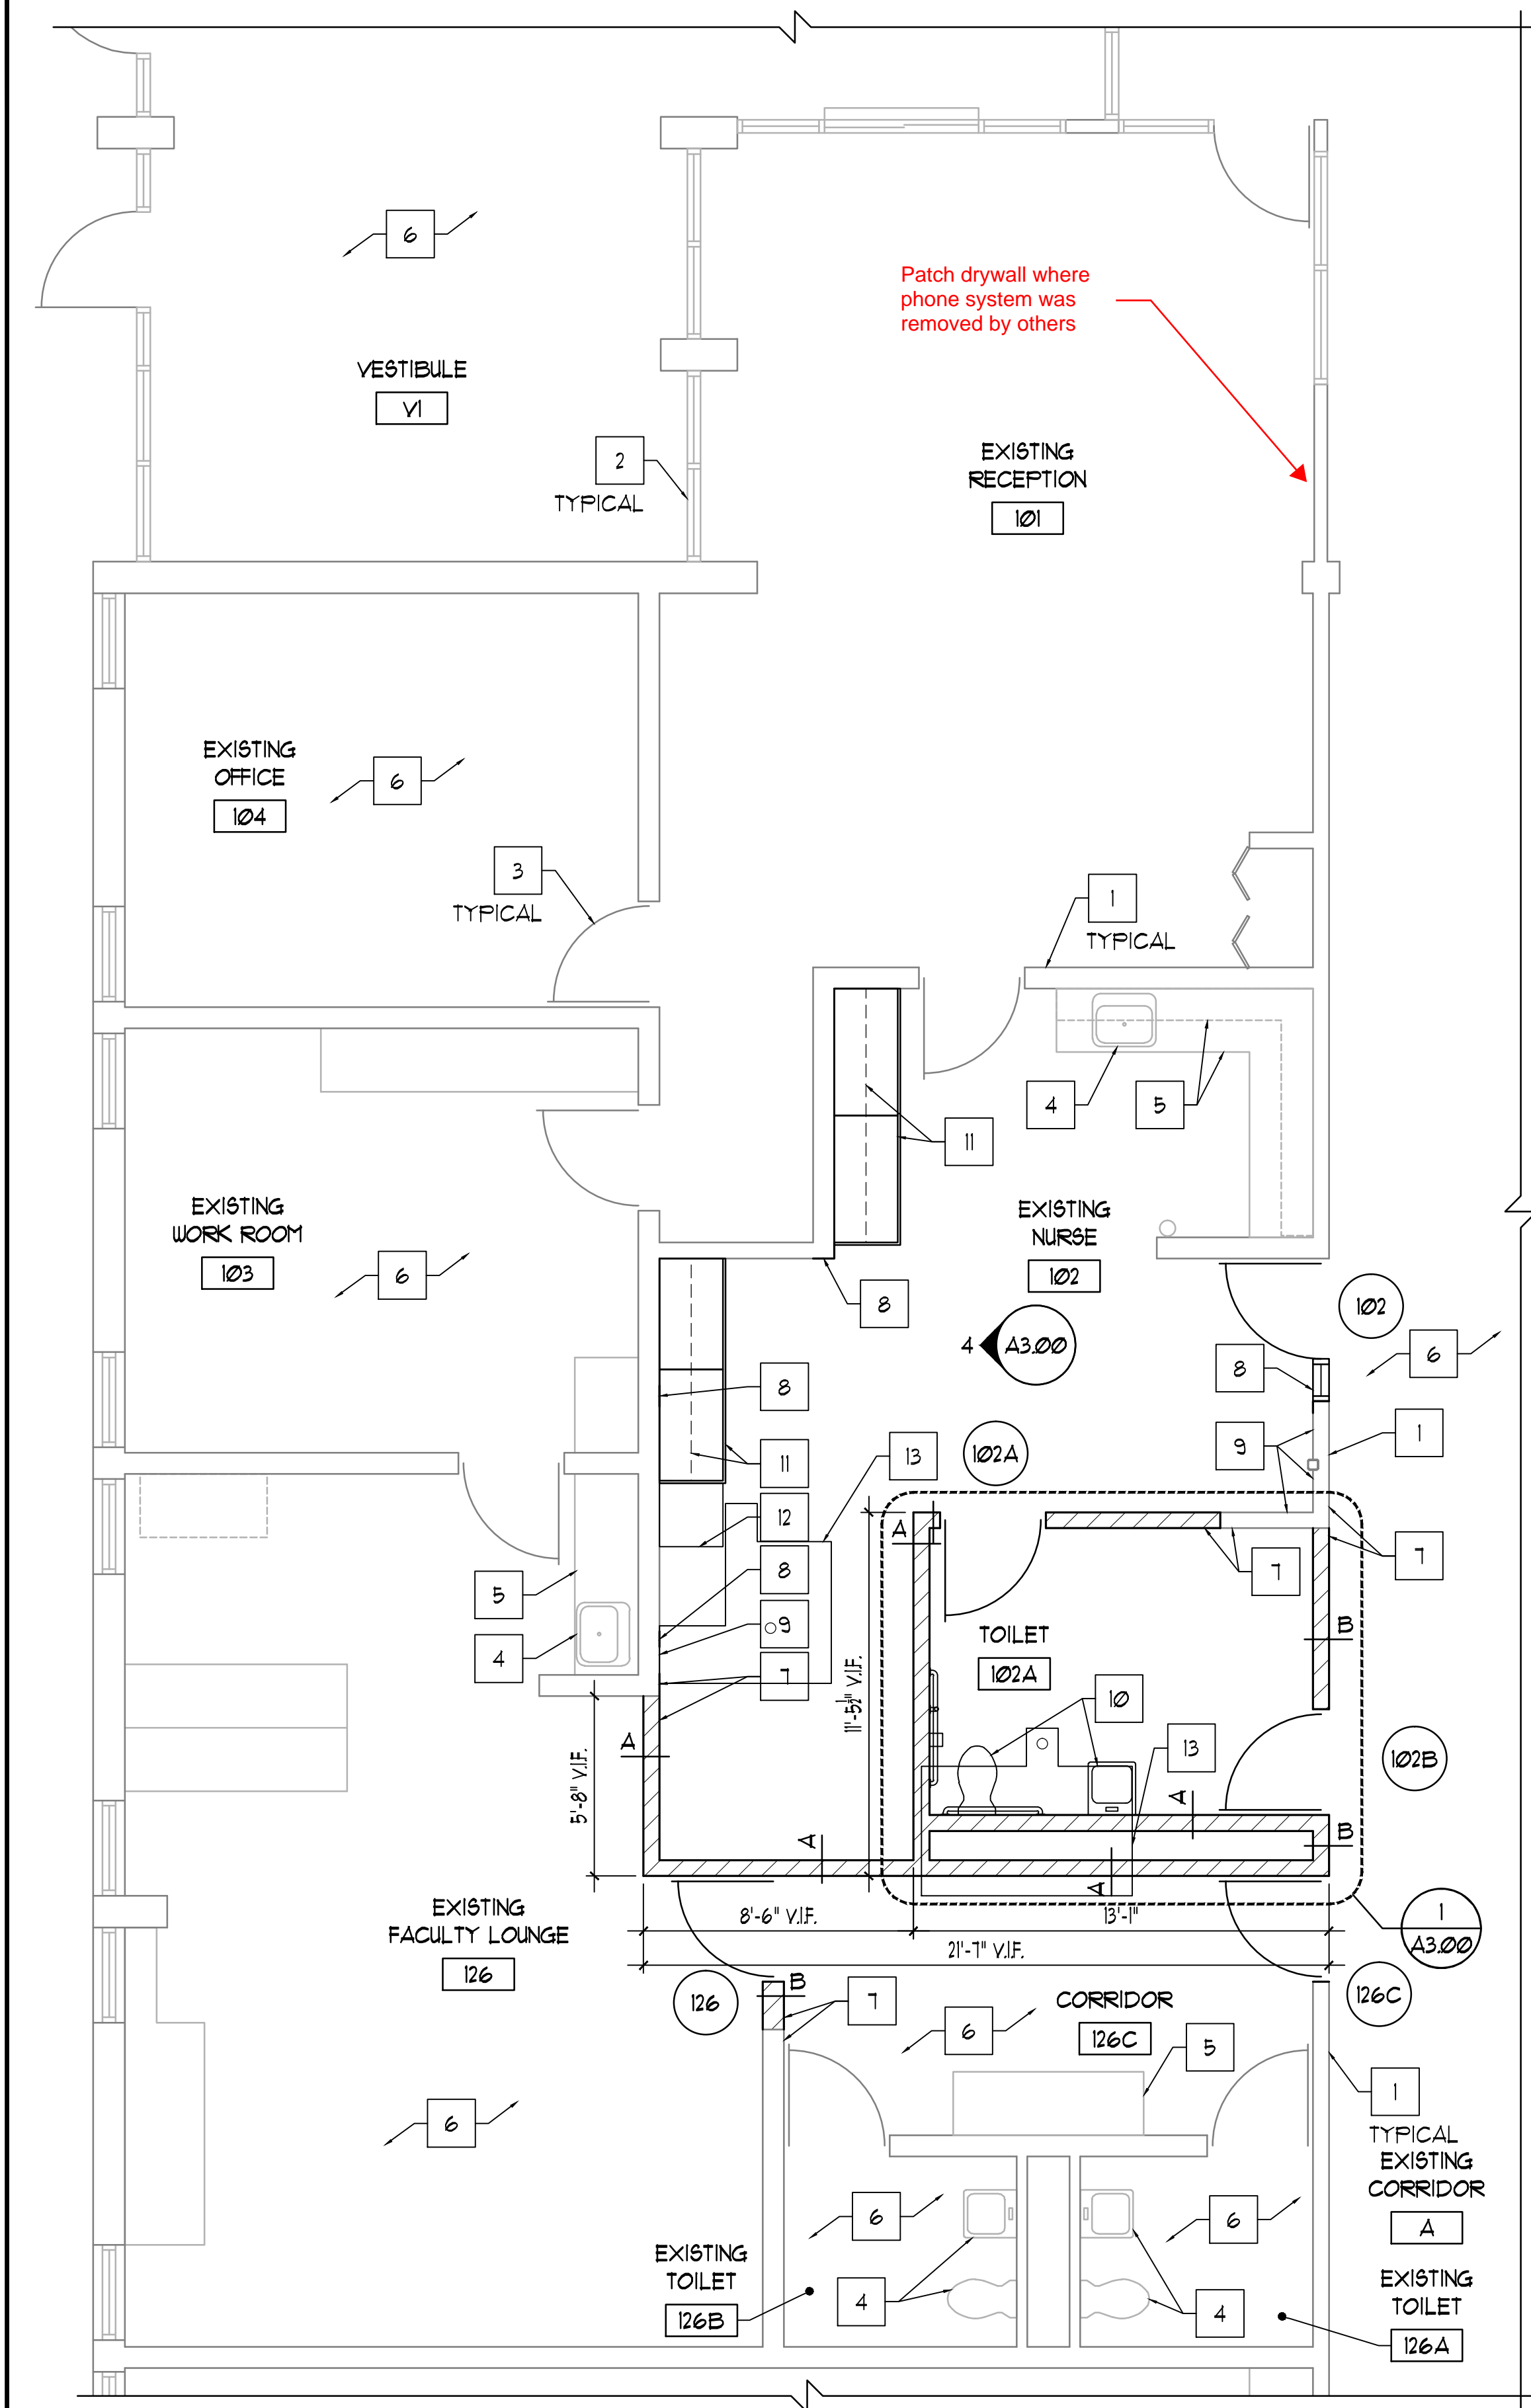

1 PARTIAL FLOOR PLAN
1/4" = 1'-0"

LEGEND

EXISTING CONSTRUCTION TO REMAIN

FURNITURE / EQUIPMENT RELOCATION NOTES

- OWNER TO REMOVE AND REINSTALL ALL LOOSE FURNITURE, AND ELECTRONIC EQUIPMENT UNLESS OTHERWISE NOTED - REMOVED ITEMS WILL BE HOUSED ON SITE - CONTRACTOR TO COORDINATE MOVING SCOPE AND STORAGE LOCATIONS WITH OWNER PRIOR TO BEGINNING ANY WORK.
- OWNER TO REMOVE AND RELOCATE ALL OFFICE FURNITURE AND EQUIPMENT UNLESS OTHERWISE NOTED - OWNER TO REINSTALL - COORDINATE ALL OUTLET AND DATA LOCATIONS WITH OWNER - REFER TO ELECTRICAL PLANS.

ROOF GENERAL NOTES

- ALL INSULATION JOINTS ARE TO BE STAGGERED.
- ALL GAPS IN INSULATION JOINTS GREATER THAN 1/4" ARE TO BE FILLED WITH INSULATION STRIPS.
- FIELD VERIFY ALL EXISTING CONDITIONS PRIOR TO SUBMITTING SHOP DRAWINGS.
- ALL COUNTER FLASHING, COPING, AND MISCELLANEOUS METAL FLASHING PIECES ARE TO HAVE SEALANT APPLIED AT THEIR END CONDITIONS.
- ALL EXPOSED FASTENERS TO BE CORROSION RESISTIVE, HAVE NEOPRENE WASHERS, AND BE COVERED WITH SEALANT FOLLOWING ARCHITECT'S APPROVAL.
- APPLY EPDM MANUFACTURER'S SEALANT OVER FASTENER HEADS AT BASE FLASHING SECUREMENT.
- ALL AREAS OF EXISTING SITE USED TO ACCESS AREA OF WORK SHALL BE PROTECTED AND/OR REPAIRED BACK TO ORIGINAL CONDITION PRIOR TO SUBSTANTIAL COMPLETION DATE - AT ALL GRASS AREAS DAMAGED DURING CONSTRUCTION, PROVIDE NEW SOD TO MATCH EXISTING SPECIES.
- EXTEND ALL PIPE PENETRATIONS AS REQUIRED TO PROVIDE WORK INDICATED.
- AT ALL ROOF PENETRATIONS TO BE REMOVED - PATCH DECK, FILL OPENING WITH INSULATION TO MATCH EXISTING AND PATCH MEMBRANE PER MANUFACTURER'S REQUIREMENTS TO MAINTAIN EXISTING ROOF WARRANTY.
- CONTACT GLUTH BROTHERS ROOFING COMPANY, INC., PHONE 219.844.5536. YOU CAN ALSO CONTACT THE SCHOOL'S TREMCO ROOFING REPRESENTATIVE, DOUG COPLEY, PHONE 260.312.0483. TREMCO CERTIFIES ALL ROOFING FOR THE DUNELAND SCHOOL CORPORATION.

ROOF CONSTRUCTION NOTES

ROOF AREA #1:
EXISTING ROOF CONSISTS OF METAL DECK, INSULATION AND TREMCO SINGLE PLY ROOF SYSTEM - AT AREAS TO PATCH, MATCH EXISTING ADJACENT CONSTRUCTION - CONTACT GLUTH BROTHERS ROOFING COMPANY, INC., PHONE 219.844.5536. YOU CAN ALSO CONTACT THE SCHOOL'S TREMCO ROOFING REPRESENTATIVE, DOUG COPLEY, PHONE 260.312.0483. TREMCO CERTIFIES ALL ROOFING FOR THE DUNELAND SCHOOL CORPORATION.

CHANGE ORDER INFORMATION:
Change Order Number: 001

Date: August 6, 2020

Terrazzo Patching

FLOOR PLAN GENERAL NOTES


- VERIFY EXACT DIMENSIONS OF ALL EXISTING CONDITIONS IN FIELD. DIMENSIONS SHOWN FOR REFERENCE ONLY - GENERAL CONTRACTOR TO VERIFY AND COORDINATE ALL LAY OUTS AMONG ALL TRADES AFFECTED - NOTIFY ARCHITECT OF ANY CONFLICTS PRIOR TO INSTALLATION BY ANY TRADE.
- ALL CONTRACTORS SHALL REPORT ALL DISCREPANCIES OR DIMENSIONAL QUESTIONS TO THE ATTENTION OF THE ARCHITECT PRIOR TO INSTALLATION.
- REFER TO PROJECT MANUAL FOR PRODUCTS, MATERIALS, PROCEDURES AND ADDITIONAL INFORMATION NOT COVERED IN DRAWINGS.
- PROTECT ALL EXISTING FINISHES, EQUIPMENT, AND ADJACENT WORK FROM DAMAGE DURING CONSTRUCTION. ANY DAMAGED FINISHES, EQUIPMENT, OR ADJACENT SURFACES SHALL BE REPAIRED OR REPLACED BY CONTRACTOR AT NO ADDITIONAL COST TO OWNER.
- PATCH EXISTING CONSTRUCTION AT ALL LOCATIONS OF ITEMS SCHEDULED TO BE REMOVED. FINISH TO MATCH ADJACENT SURFACES IN MATERIAL AND TEXTURE. TOOTH-IN ALL MASONRY IN WHOLE UNITS.
- PATCH AND SMOOTH EXISTING FLOOR TO MATCH ADJACENT SURFACES AS REQUIRED TO INSTALL NEW FLOOR FINISH.
- AT ALL FLOOR SLABS TO RECEIVE FLOOR FINISH, CONTRACTOR SHALL GRIND HIGH SPOTS, FILL DEPRESSIONS AND INFILL ANY UNUSED PENETRATIONS IN THE FLOOR SLAB WITH A MATERIAL SUITABLE TO THE FLOORING MANUFACTURER. ALL CRACKS LARGER THAN 1/8" ARE TO BE GROUND OUT AND FILLED AS PER THE MANUFACTURER'S RECOMMENDATIONS.
- PROVIDE LINTELS ABOVE ALL DOORS, PENETRATIONS, LOUVERS, ETC. IN MASONRY WALLS - REFER TO LINTEL SCHEDULE ON STRUCTURAL DRAWINGS - REFER TO MECHANICAL DRAWINGS FOR ADDITIONAL LINTEL LOCATIONS REQUIRED DUE TO DUCT PENETRATIONS, ETC.
- PATCH, PAINT, AND CLEAN EXISTING WALLS, FLOORS, AND CEILINGS AT ITEMS SCHEDULED TO BE REMOVED.
- REFER TO ROOF, MECHANICAL AND PLUMBING PLANS FOR LOCATIONS OF ROOF PENETRATIONS.
- REFER TO MECHANICAL, ELECTRICAL, AND PLUMBING DRAWINGS FOR ADDITIONAL INFORMATION.
- REMOVE EXISTING WALL CONSTRUCTION AS REQUIRED TO INSTALL MECHANICAL, PLUMBING, AND ELECTRICAL WORK - PATCH WALLS AT REMOVED MECHANICAL, ELECTRICAL AND PLUMBING EQUIPMENT TO BE REMOVED. TOOTH-IN ALL MASONRY WHERE POSSIBLE - RUN NEW ELECTRICAL WORK INSIDE WALL AND CEILING CONSTRUCTION (NEW AND EXISTING) - PATCH CONSTRUCTION AS REQUIRED TO PROVIDE WORK INDICATED.
- CUT, CORE AND PATCH SLABS (NEW AND EXISTING) AS REQUIRED TO INSTALL PLUMBING, MECHANICAL AND ELECTRICAL WORK.
- AT ALL NEW WINDOW AND DOOR OPENINGS, TOOTH-IN NEW MASONRY UNITS AT JAMB CONDITIONS IN WHOLE UNITS TO PROVIDE A FINISHED APPEARANCE.

FLOOR PLAN REFERENCED NOTES

- EXISTING WALL CONSTRUCTION - PROTECT DURING CONSTRUCTION.
- EXISTING STOREFRONT FRAME AND GLAZING SYSTEM - PROTECT DURING CONSTRUCTION.
- EXISTING DOOR AND FRAME - PROTECT DURING CONSTRUCTION.
- EXISTING PLUMBING FIXTURE - PROTECT DURING CONSTRUCTION.
- EXISTING CASEWORK - PROTECT DURING CONSTRUCTION.
- EXISTING FLOOR FINISH - PROTECT DURING CONSTRUCTION.
- ALIGN WALLS.
- PATCH CONCRETE MASONRY WALL - PROVIDE NEW MASONRY AND TOOTH-IN IN WHOLE UNITS AS REQUIRED FOR SMOOTH SURFACE - PAINT
- TUCKPOINT EXISTING CONCRETE MASONRY WALL WHERE NEWLY EXPOSED - PAINT TO MATCH EXISTING ADJACENT FINISH.
- PLUMBING EQUIPMENT - REFER TO PLUMBING DRAWINGS.
- PLASTIC LAMINATE CASEWORK - REFER TO INTERIOR ELEVATIONS.
- OWNER PROVIDED ELECTRICAL EQUIPMENT - INSTALLED BY OWNER
- PATCH EXISTING CONCRETE SLAB - MATCH ADJACENT SLAB IN CONSTRUCTION - PROVIDE 12" #4 DOWELS AT 12" ON CENTER STAGGERED - EMBED DOWELS 6" INTO EXISTING SLAB - WRAP ONE END IN BOND BREAK PAPER.



AREA OF WORK
NOT IN SCOPE OF WORK

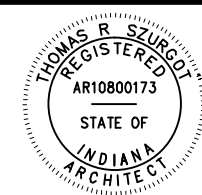

EXPIRES 12/01/2021

KEYPLAN
NOT TO SCALE



DUNELAND SCHOOL CORPORATION
2020 NURSE'S OFFICE RENOVATIONS AT:
BAILLY ELEMENTARY SCHOOL
800 S 5TH STREET, CHESTERTON, INDIANA 46304

PROJECT NUMBER: 20-006	REVISIONS:
PROJECT MANAGER: NO	
DRAWN BY: GT	
USED FOR PROPOSAL:	
24/07/2020	
PARTIAL FLOOR PLAN	

A1.10

DOOR AND FRAME SCHEDULE


	DOOR						FRAME						FRAME DETAILS				COMMENTS	ROOM SIGN TYPE	LINTEL
OP'NG NO.	SIZE		TYPE	MAT'L	HDWR SET	PROT. RATING HOURS	SIZE		TYPE	MAT'L	PROT. RATING HOURS	REF. NOTES	HEAD	JAMB	JAMB	SILL	ROOM TYPE		
	WIDTH	HEIGHT					WIDTH	HEIGHT											
FIRST FLOOR																			
102	3'-0"	7'-0"	B	WD	Ø1	-	5'-0" V.I.F.	7'-4"	B	HM	-	4	1/A2.00	4/A2.00	8/A2.00	-	NURSE'S OFFICE	-	L3
102A	3'-0"	7'-0"	A	WD	Ø2	-	3'-4"	7'-4"	A	HM	-	-	1/A2.00	3/A2.00	5/A2.00	-	TOILET	-	L2
102B	3'-0"	7'-0"	A	WD	Ø2	-	3'-4"	7'-4"	A	HM	-	-	2/A2.00	3/A2.00	6/A2.00 SIM	-	TOILET	-	L3
126	3'-0"	7'-0"	B	WD	Ø1	-	3'-4"	7'-4"	A	HM	-	-	1/A2.00	3/A2.00	7/A2.00	-	FACULTY LOUNGE	-	L1
126C	3'-0"	7'-0"	B	WD	Ø1	-	3'-4"	7'-4"	A	HM	-	-	2/A2.00	4/A2.00	6/A2.00	-	CORRIDOR	-	L3

DOOR AND FRAME ABBREVIATIONS

EX	EXISTING	SIM	SIMILAR
HM	HOLLOW METAL	VIF	VERIFY IN FIELD
ME	MATCH EXISTING	WD	WOOD


DOOR AND FRAME REFERENCED NOTES

- SALVAGED AND REINSTALLED WOOD DOOR.
- 4 HINGED DOOR.
- PROVIDE 180 DEGREE HINGES.
- NEW DOOR AND FRAME IN EXISTING MASONRY OPENING - VERIFY IN FIELD.

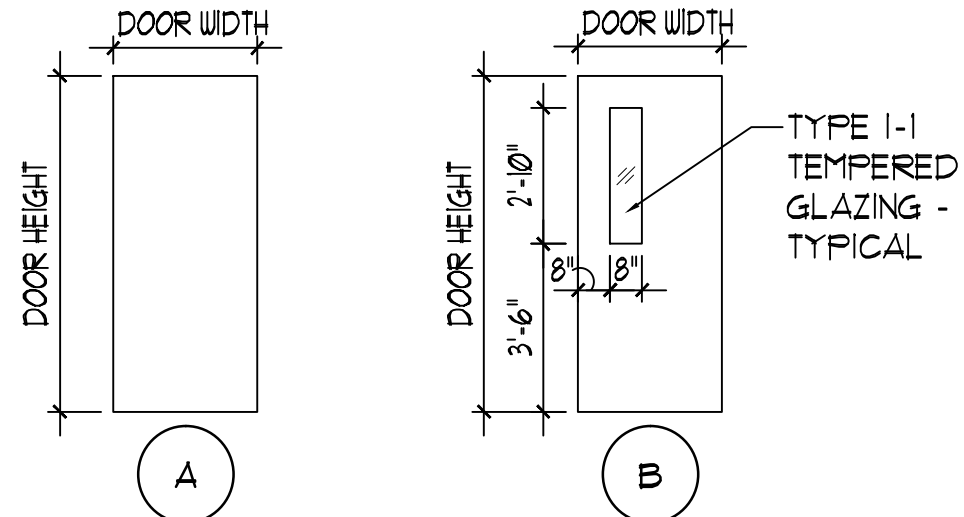

DOOR TYPES

NOT TO SCALE

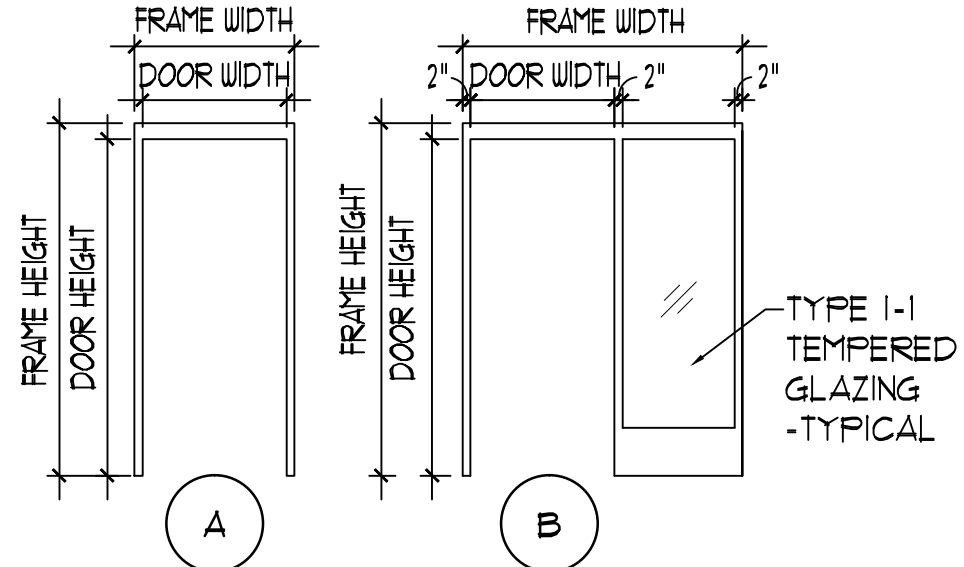

FRAME TYPES

NOT TO SCALE

DOOR AND FRAME GENERAL NOTES

- CONTRACTOR TO VERIFY DIMENSIONS, QUANTITIES AND CONDITIONS OF ALL ROUGH OPENINGS IN FIELD.
- REFER TO WALL TYPES FOR WALL CONSTRUCTION AT DOOR LOCATIONS.
- REFER TO SPECIFICATIONS FOR DESCRIPTIONS OF HARDWARE SETS.
- GROUT JAMBS SOLID AT ALL FRAMES INSTALLED IN MASONRY OPENINGS.
- ALL EXPOSED ANCHORS ON HOLLOW METAL FRAMES ARE TO BE COUNTERSUNK INTO FRAMES, COVERED IN BONDO, SANDED SMOOTH, AND PAINTED TO MATCH FRAME.
- REFER TO STRUCTURAL DRAWINGS FOR LINTEL INFORMATION.
- VERIFY DIMENSIONS OF ALL DOORS AND FRAMES TO BE INSTALLED IN EXISTING WALL OPENINGS PRIOR TO SUBMITTING SHOP DRAWINGS.
- HEIGHT OF DOOR OPERATING HARDWARE SHALL BE NO LESS THAN 34" AND NO MORE THAN 48" ABOVE FINISHED FLOOR. COORDINATE EXACT HEIGHT WITH OWNER AND ARCHITECT.
- DOOR HARDWARE SHALL NOT REQUIRE TIGHT GRASPING, PINCHING, OR TWISTING OF THE WRIST TO OPERATE.
- DOOR OPERATING FORCE SHALL NOT EXCEED: EXTERIOR HINGED DOORS: 8.5 LB
INTERIOR HINGED DOORS: 5 LB
- ALL EGRESS DOORS ARE TO UTILIZE KEYLESS LOCKETS ON THE EGRESS SIDE. NO FLUSH BOLTS, DEAD OR DRAW BOLTS, ETC. WILL BE ALLOWED.
- AT ALL OPENINGS SCHEDULED TO RECEIVE WORK - BOND AND PAINT ALL FRAMES (NEW AND EXISTING).
- ALL EXISTING FIRE RATED OPENINGS ARE TO BE MAINTAINED.


LOOSE LINTEL SCHEDULE

MARK	SIZE	END BEARING	SHAPE	REMARKS
L1	(2) L3-1/2"x3-1/2"x5/16"	8" MIN	⌋	---
L2	(2) L3-1/2"x2-1/2"x5/16"	8" MIN	⌋	---
L3	(2) L5"x3-1/2"x5/16"	8" MIN	⌋	---

- PLATES ON LINELS SHALL BE SHOP WELDED TO MEMBER W/ 1/4"x2" FILLET WELDS AT 12" O.C. STAGGERED. PLATES TO BE 1/2" LESS THAN NOMINAL WIDTH OF WALL.
- WELD TOGETHER ALL BACK-TO-BACK ANGLES.
- CONTRACTOR TO FIELD VERIFY EXISTING WALL CONSTRUCTION PRIOR TO FABRICATING LINELS.


WALL TYPE GENERAL NOTES

- PROVIDE HORIZONTAL JOINT REINFORCING AT FIRST TWO COURSES AT TOP AND BOTTOM OF ALL MASONRY WALLS AND ABOVE AND BELOW ALL MASONRY OPENINGS.
- ALL WALL TYPES ARE TO EXTEND UP THROUGH, AND AROUND, ALL STRUCTURES, AND INTERFERENCES TO MAINTAIN CONTINUITY UP TO DECK - UNLESS NOTED OTHERWISE.
- PROVIDE FIRESAFING AT PERIMETER AND AT ALL PENETRATIONS OF ALL FIRE RATED WALL CONSTRUCTION.
- ALL WALL TYPES TO EXTEND ABOVE AND BELOW ALL OPENINGS AND PENETRATIONS.

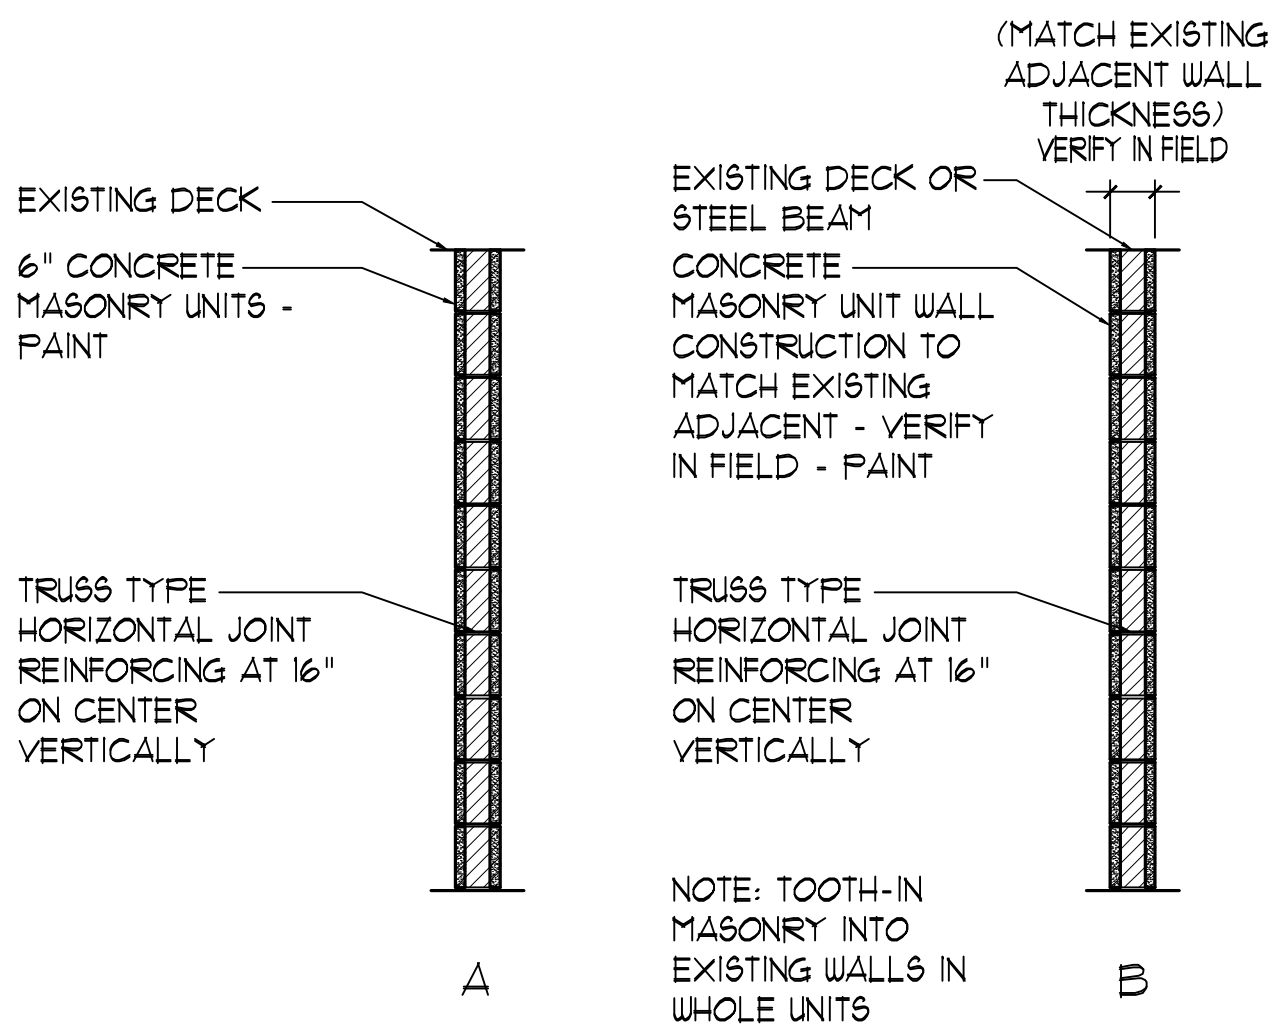

WALL TYPES

NOT TO SCALE

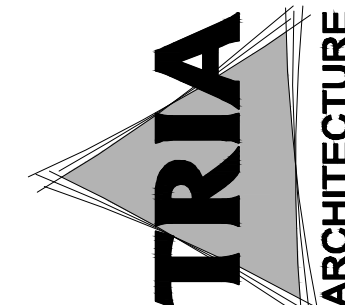

NEPFP CONSULTING
(P) 6303381596



700 HIGHLAND BL. SUITE 1000, LANSING, MI 48206

DUNELAND SCHOOL CORPORATION

2020 NURSE'S OFFICE RENOVATIONS AT:

BAILLY ELEMENTARY SCHOOL


800 S 5TH STREET, CHESTERTON, INDIANA 46304

PROJECT NUMBER: 20-006	PROJECT MANAGER: NO	PROJECT DATE: 01/2021	DRAWN BY: [signature]	USED FOR PROPOSAL: 04/07/2020
PROJECT: DUNELAND SCHOOL NURSE'S OFFICE				
SHEET: A2.00				
SHEET TITLE: DOOR AND FRAME SCHEDULE, TYPES, DETAILS & WALL TYPES, INTERIOR ELEVATIONS AND NOTES				




EXPIRES 12/01/2021

A2.00

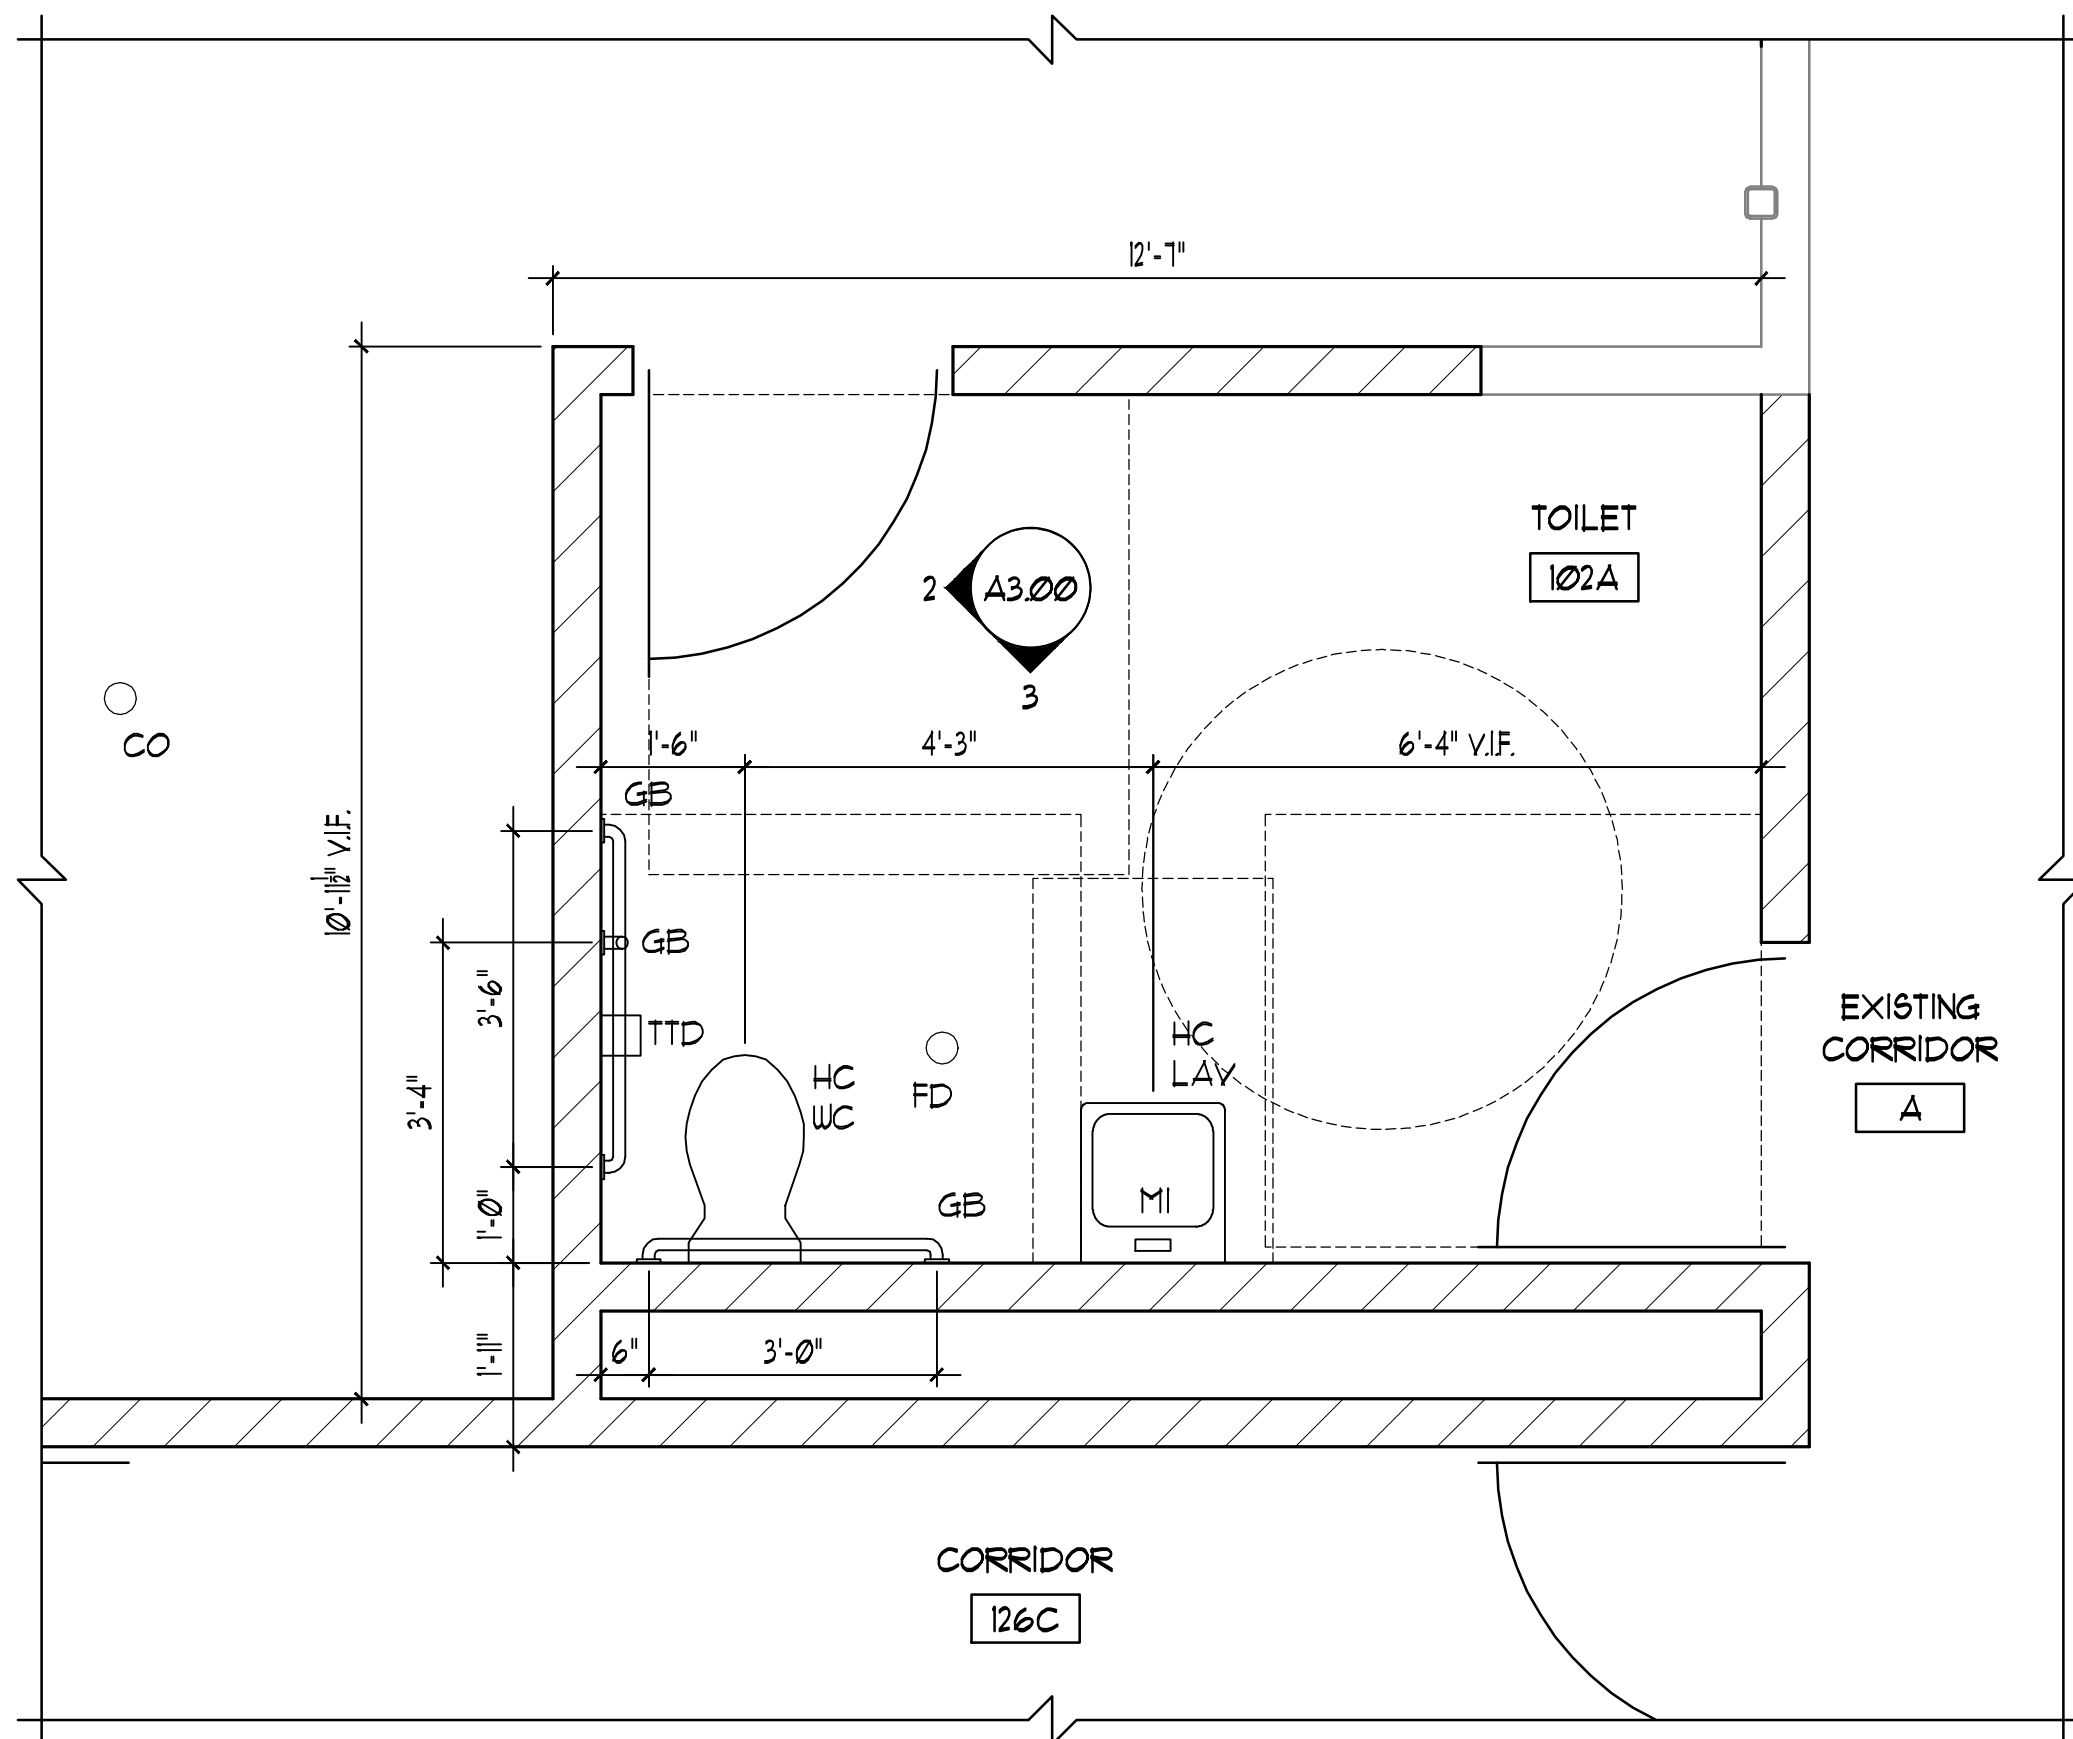


1 PARTIAL FLOOR PLAN
1/4" = 1'-0"

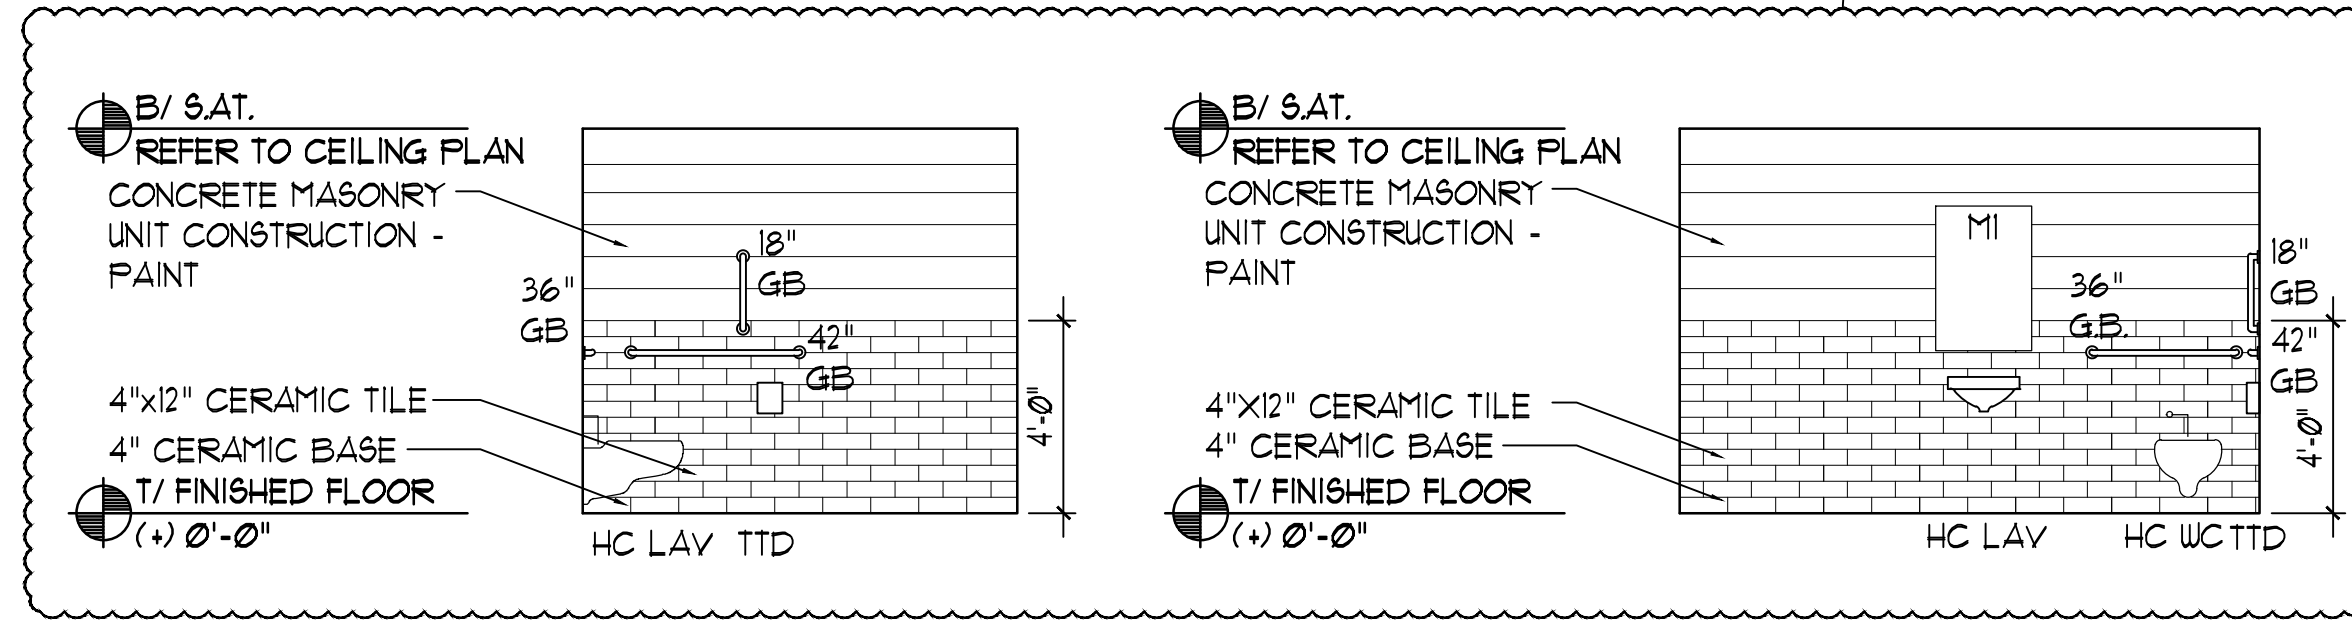

2 INTERIOR ELEVATION
1/4" = 1'-0"

3 INTERIOR ELEVATION
1/4" = 1'-0"

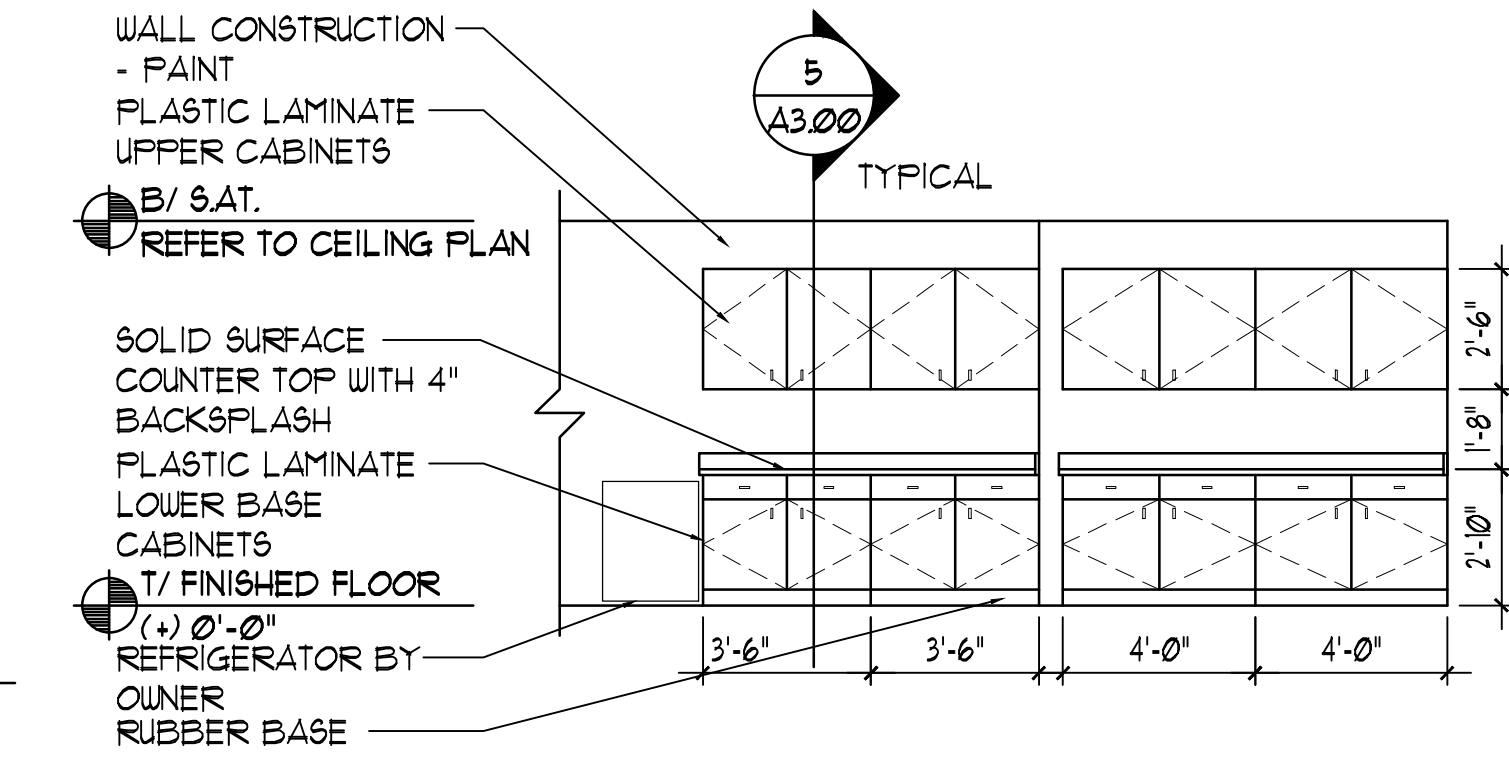


4 INTERIOR ELEVATION
1/4" = 1'-0"

ABBREVIATIONS	
C.O.	CLEAN OUT - REFER TO PLUMBING DRAWINGS
FD	FLOOR DRAIN - REFER TO PLUMBING DRAWINGS
GB	GRAB BAR
HC LAV	HANDICAPPED ACCESSIBLE LAVATORY - REFER TO PLUMBING DRAWINGS
MI	MIRROR (ADA - 24"x36")
TTD	TOILET TISSUE DISPENSER - PROVIDED AND
HC WC	HANDICAPPED ACCESSIBLE WATER CLOSET - REFER TO PLUMBING DRAWINGS



LEGEND	
	EXISTING CONSTRUCTION
	NEW CONSTRUCTION
	60" DIAMETER TURNING RADIUS
	30"x48" CLEAR FLOOR SPACE
	36" GRAB BAR
	42" GRAB BAR

GENERAL NOTE

DIMENSIONS SHOWN FOR REFERENCE ONLY - GENERAL CONTRACTOR TO VERIFY AND COORDINATE ALL LAY OUTS AMONG ALL TRADES AFFECTED - NOTIFY ARCHITECT OF ANY CONFLICTS PRIOR TO INSTALLATION BY ANY TRADE.

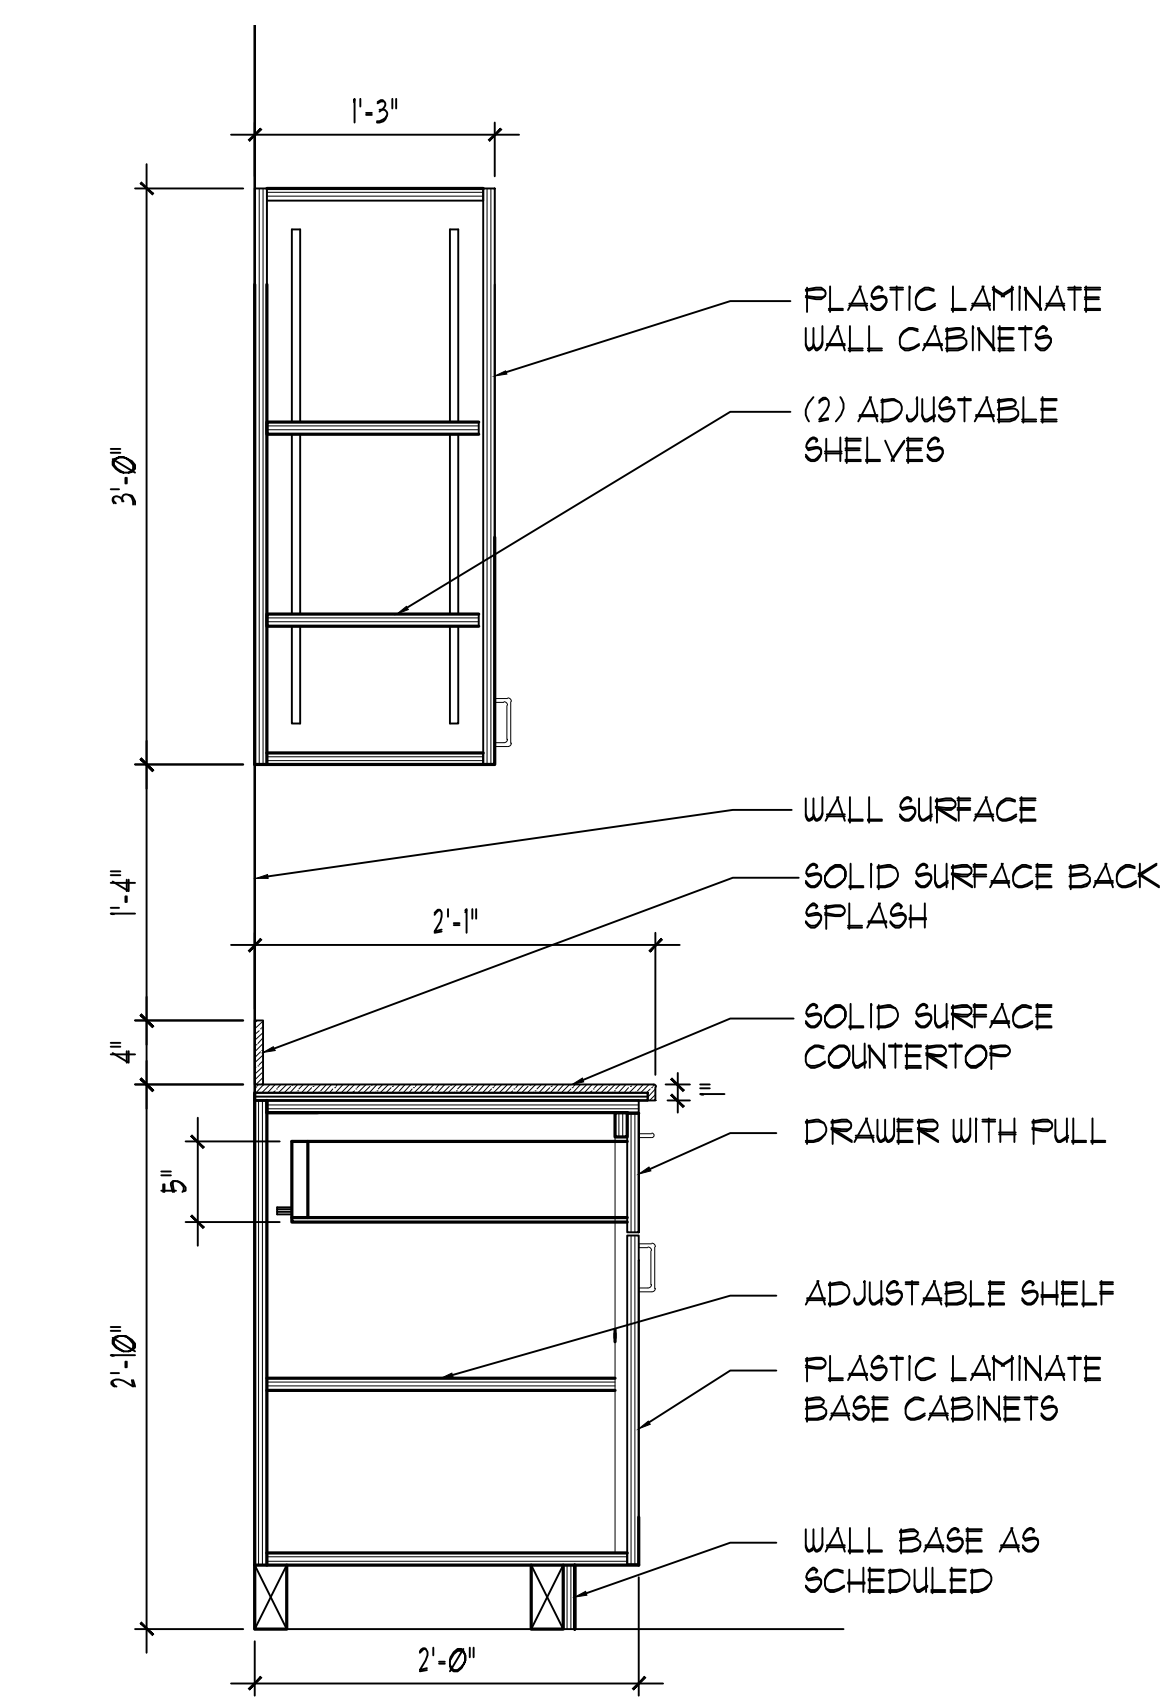

5 CASEWORK SECTION
1" = 1'-0"

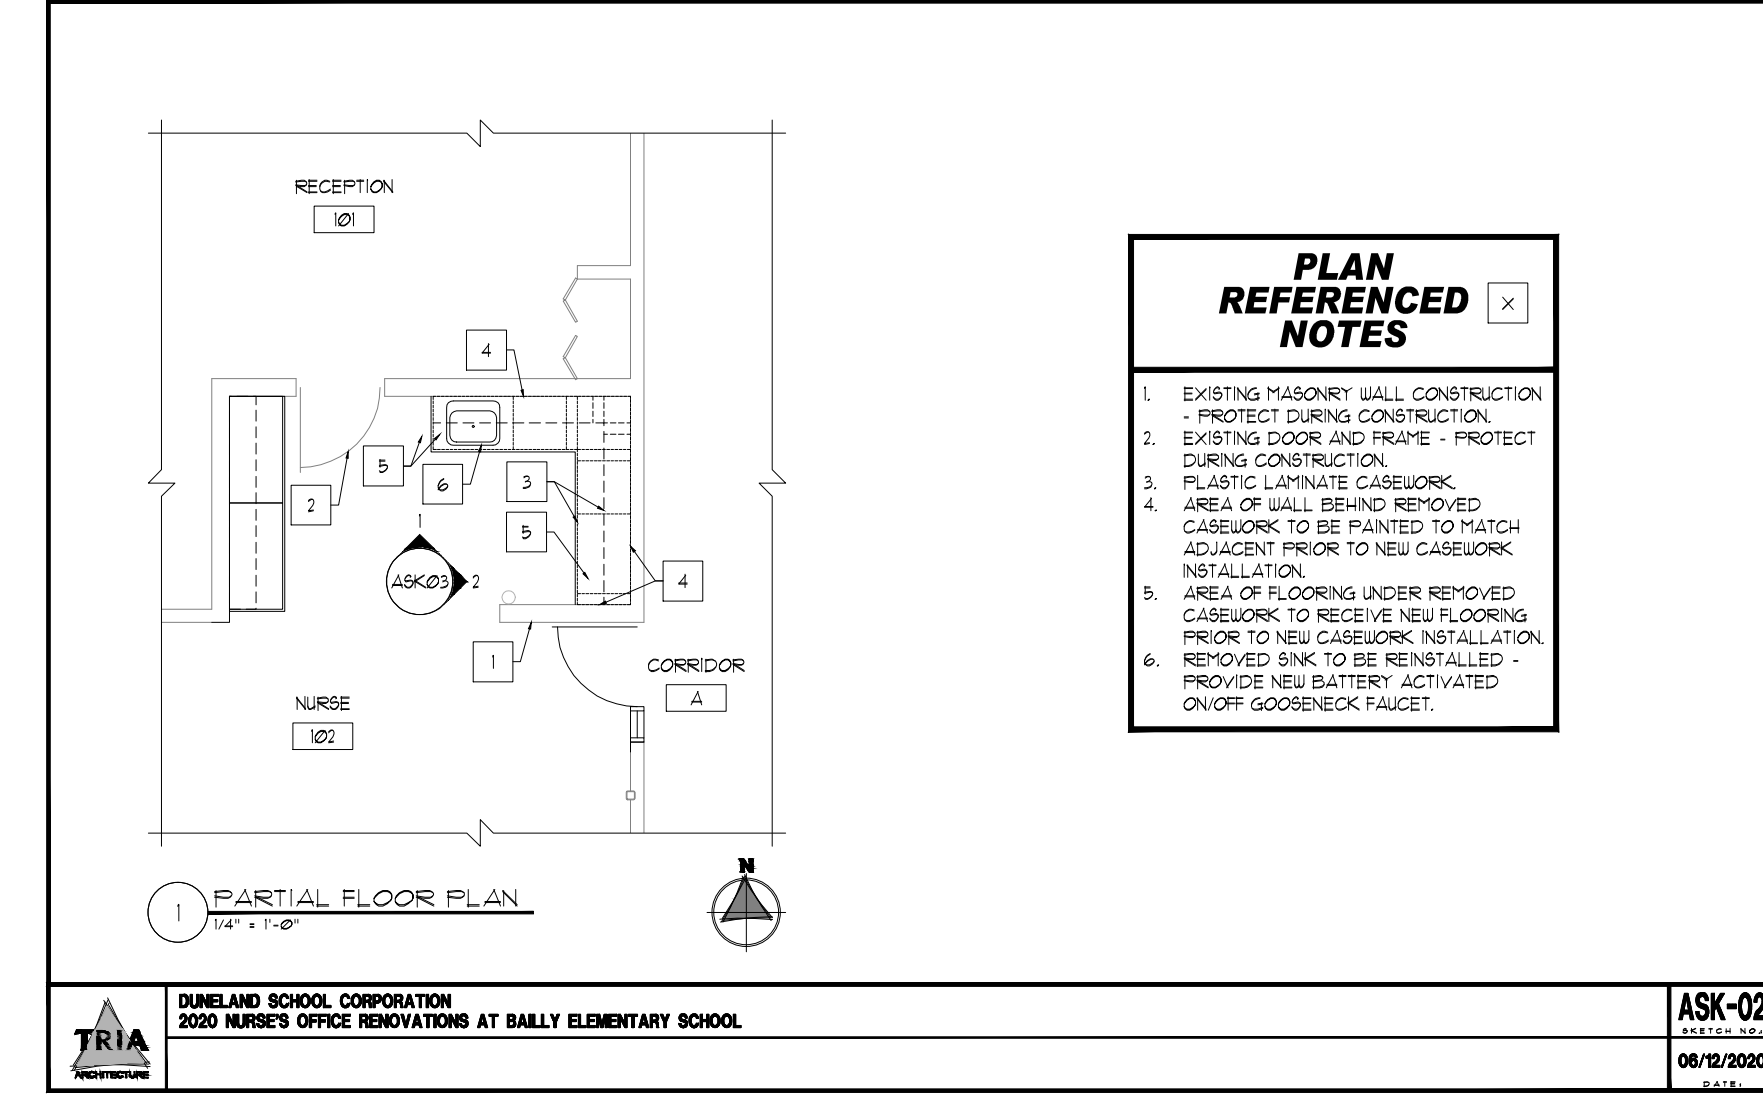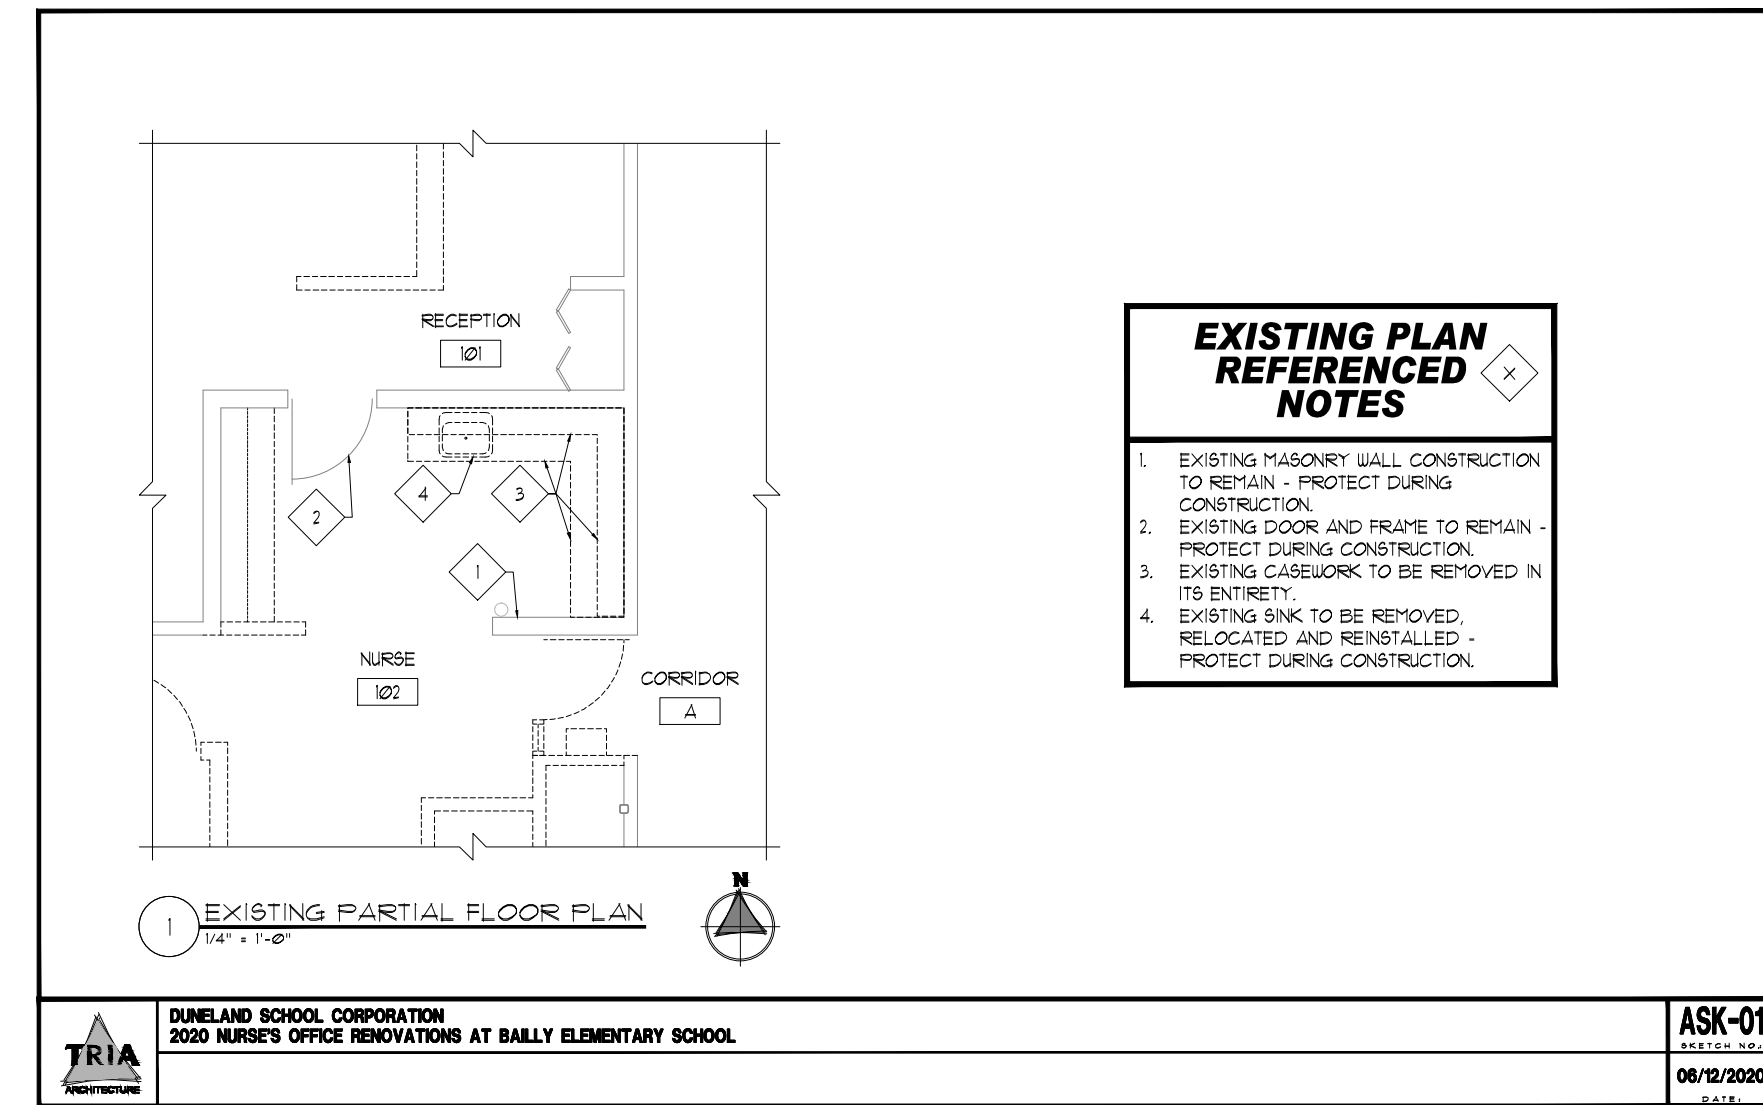

EXISTING PLAN REFERENCED NOTES


- EXISTING MASONRY WALL CONSTRUCTION TO REMAIN - PROTECT DURING CONSTRUCTION.
- EXISTING DOOR AND FRAME - PROTECT DURING CONSTRUCTION.
- EXISTING CASEWORK TO BE REMOVED IN ITS ENTIRETY.
- EXISTING SINK TO BE REMOVED, RELOCATED AND REINSTALLED - PROTECT DURING CONSTRUCTION.

PLAN REFERENCED NOTES

- EXISTING MASONRY WALL CONSTRUCTION - PROTECT DURING CONSTRUCTION.
- EXISTING DOOR AND FRAME - PROTECT DURING CONSTRUCTION.
- PLASTIC LAMINATE CASEWORK.
- AREA OF WALL BEHIND REMOVED CASEWORK TO BE PAINTED TO MATCH ADJACENT PRIOR TO NEW CASEWORK INSTALLATION.
- AREA OF FLOORING UNDER REMOVED CASEWORK TO RECEIVE NEW FLOORING PRIOR TO NEW CASEWORK INSTALLATION.
- REMOVED SINK TO BE REINSTALLED - PROVIDE NEW BATTERY ACTIVATED ON-OFF GOOSENECK FAUCET.


CHANGE ORDER INFORMATION:
Change Order Number: 001

Date: August 6, 2020

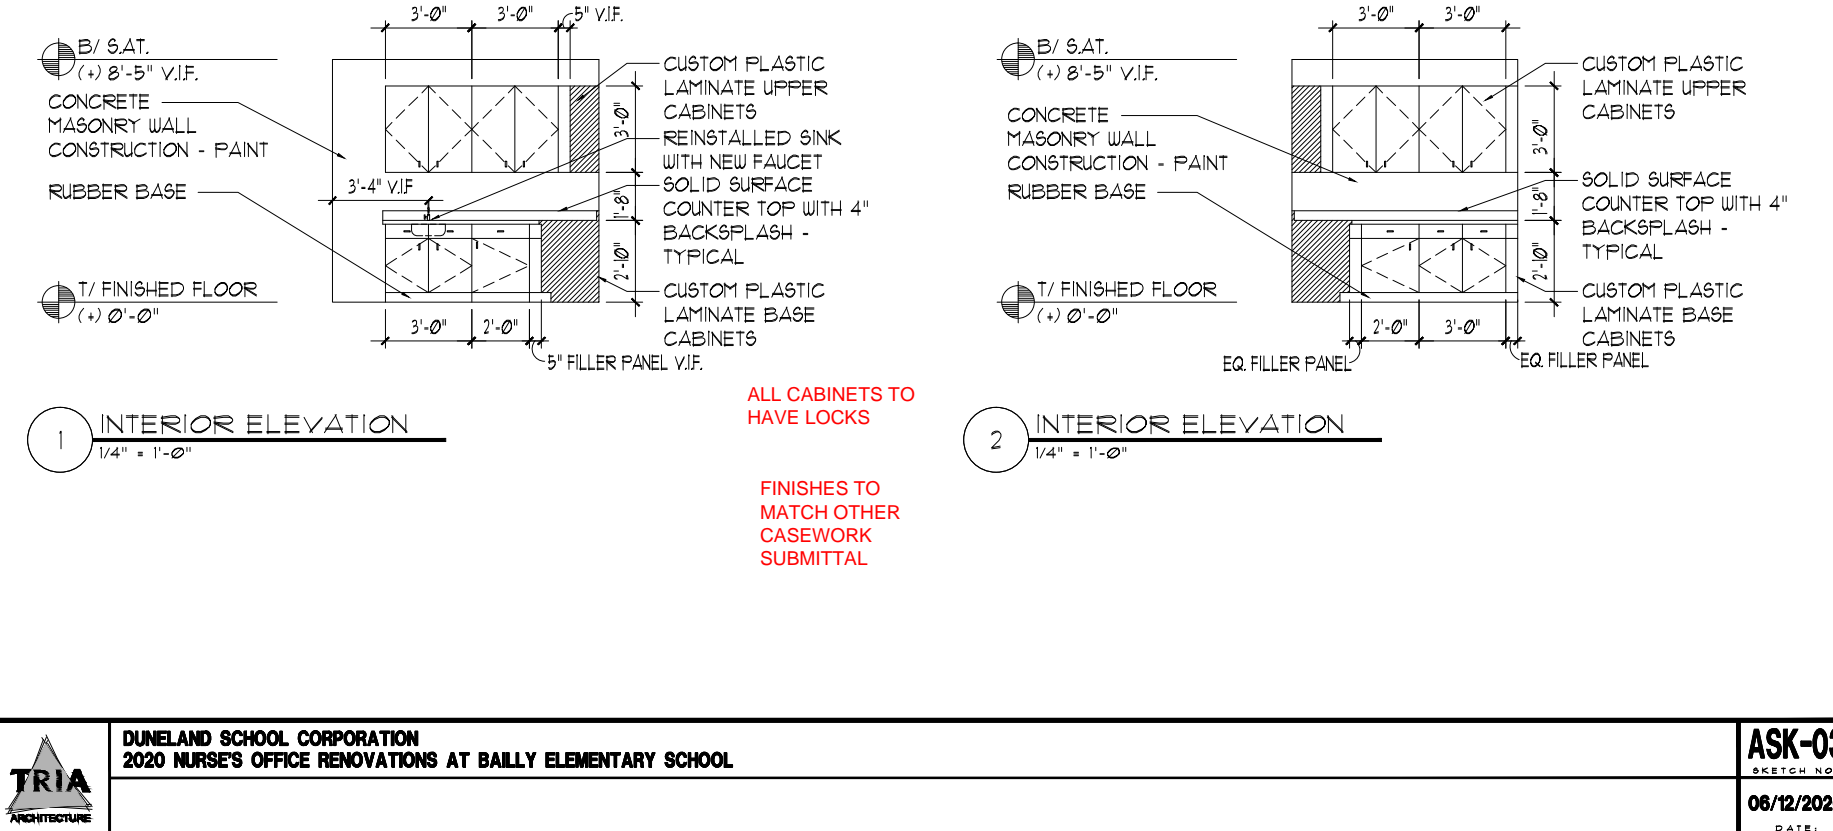


1 INTERIOR ELEVATION
1/4" = 1'-0"

2 INTERIOR ELEVATION
1/4" = 1'-0"

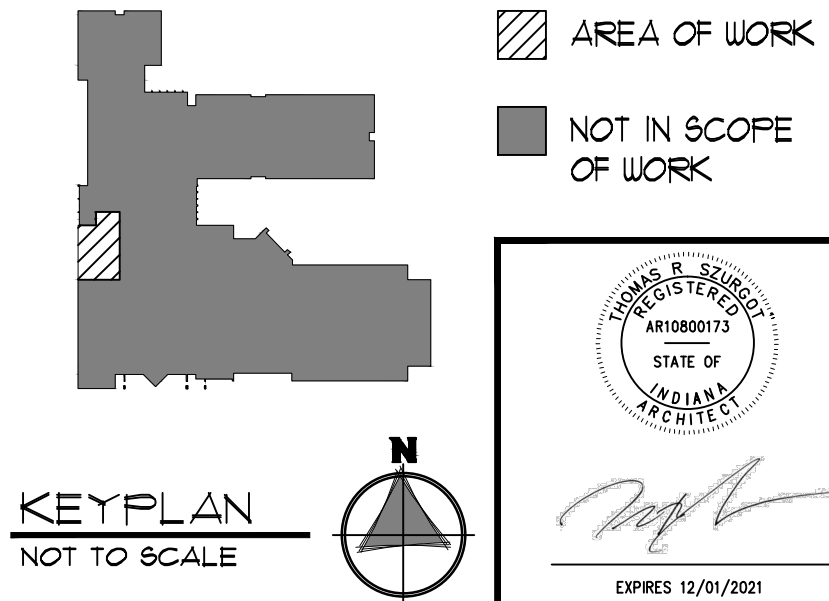

PROJECT NUMBER: 20-006	DATE: 04/11/2020
PROJECT MANAGER: NO	GT
DRAWN BY:	
USED FOR PROPOSAL:	
DATE: 04/07/2020	
ENLARGED PLAN AND INTERIOR ELEVATIONS	

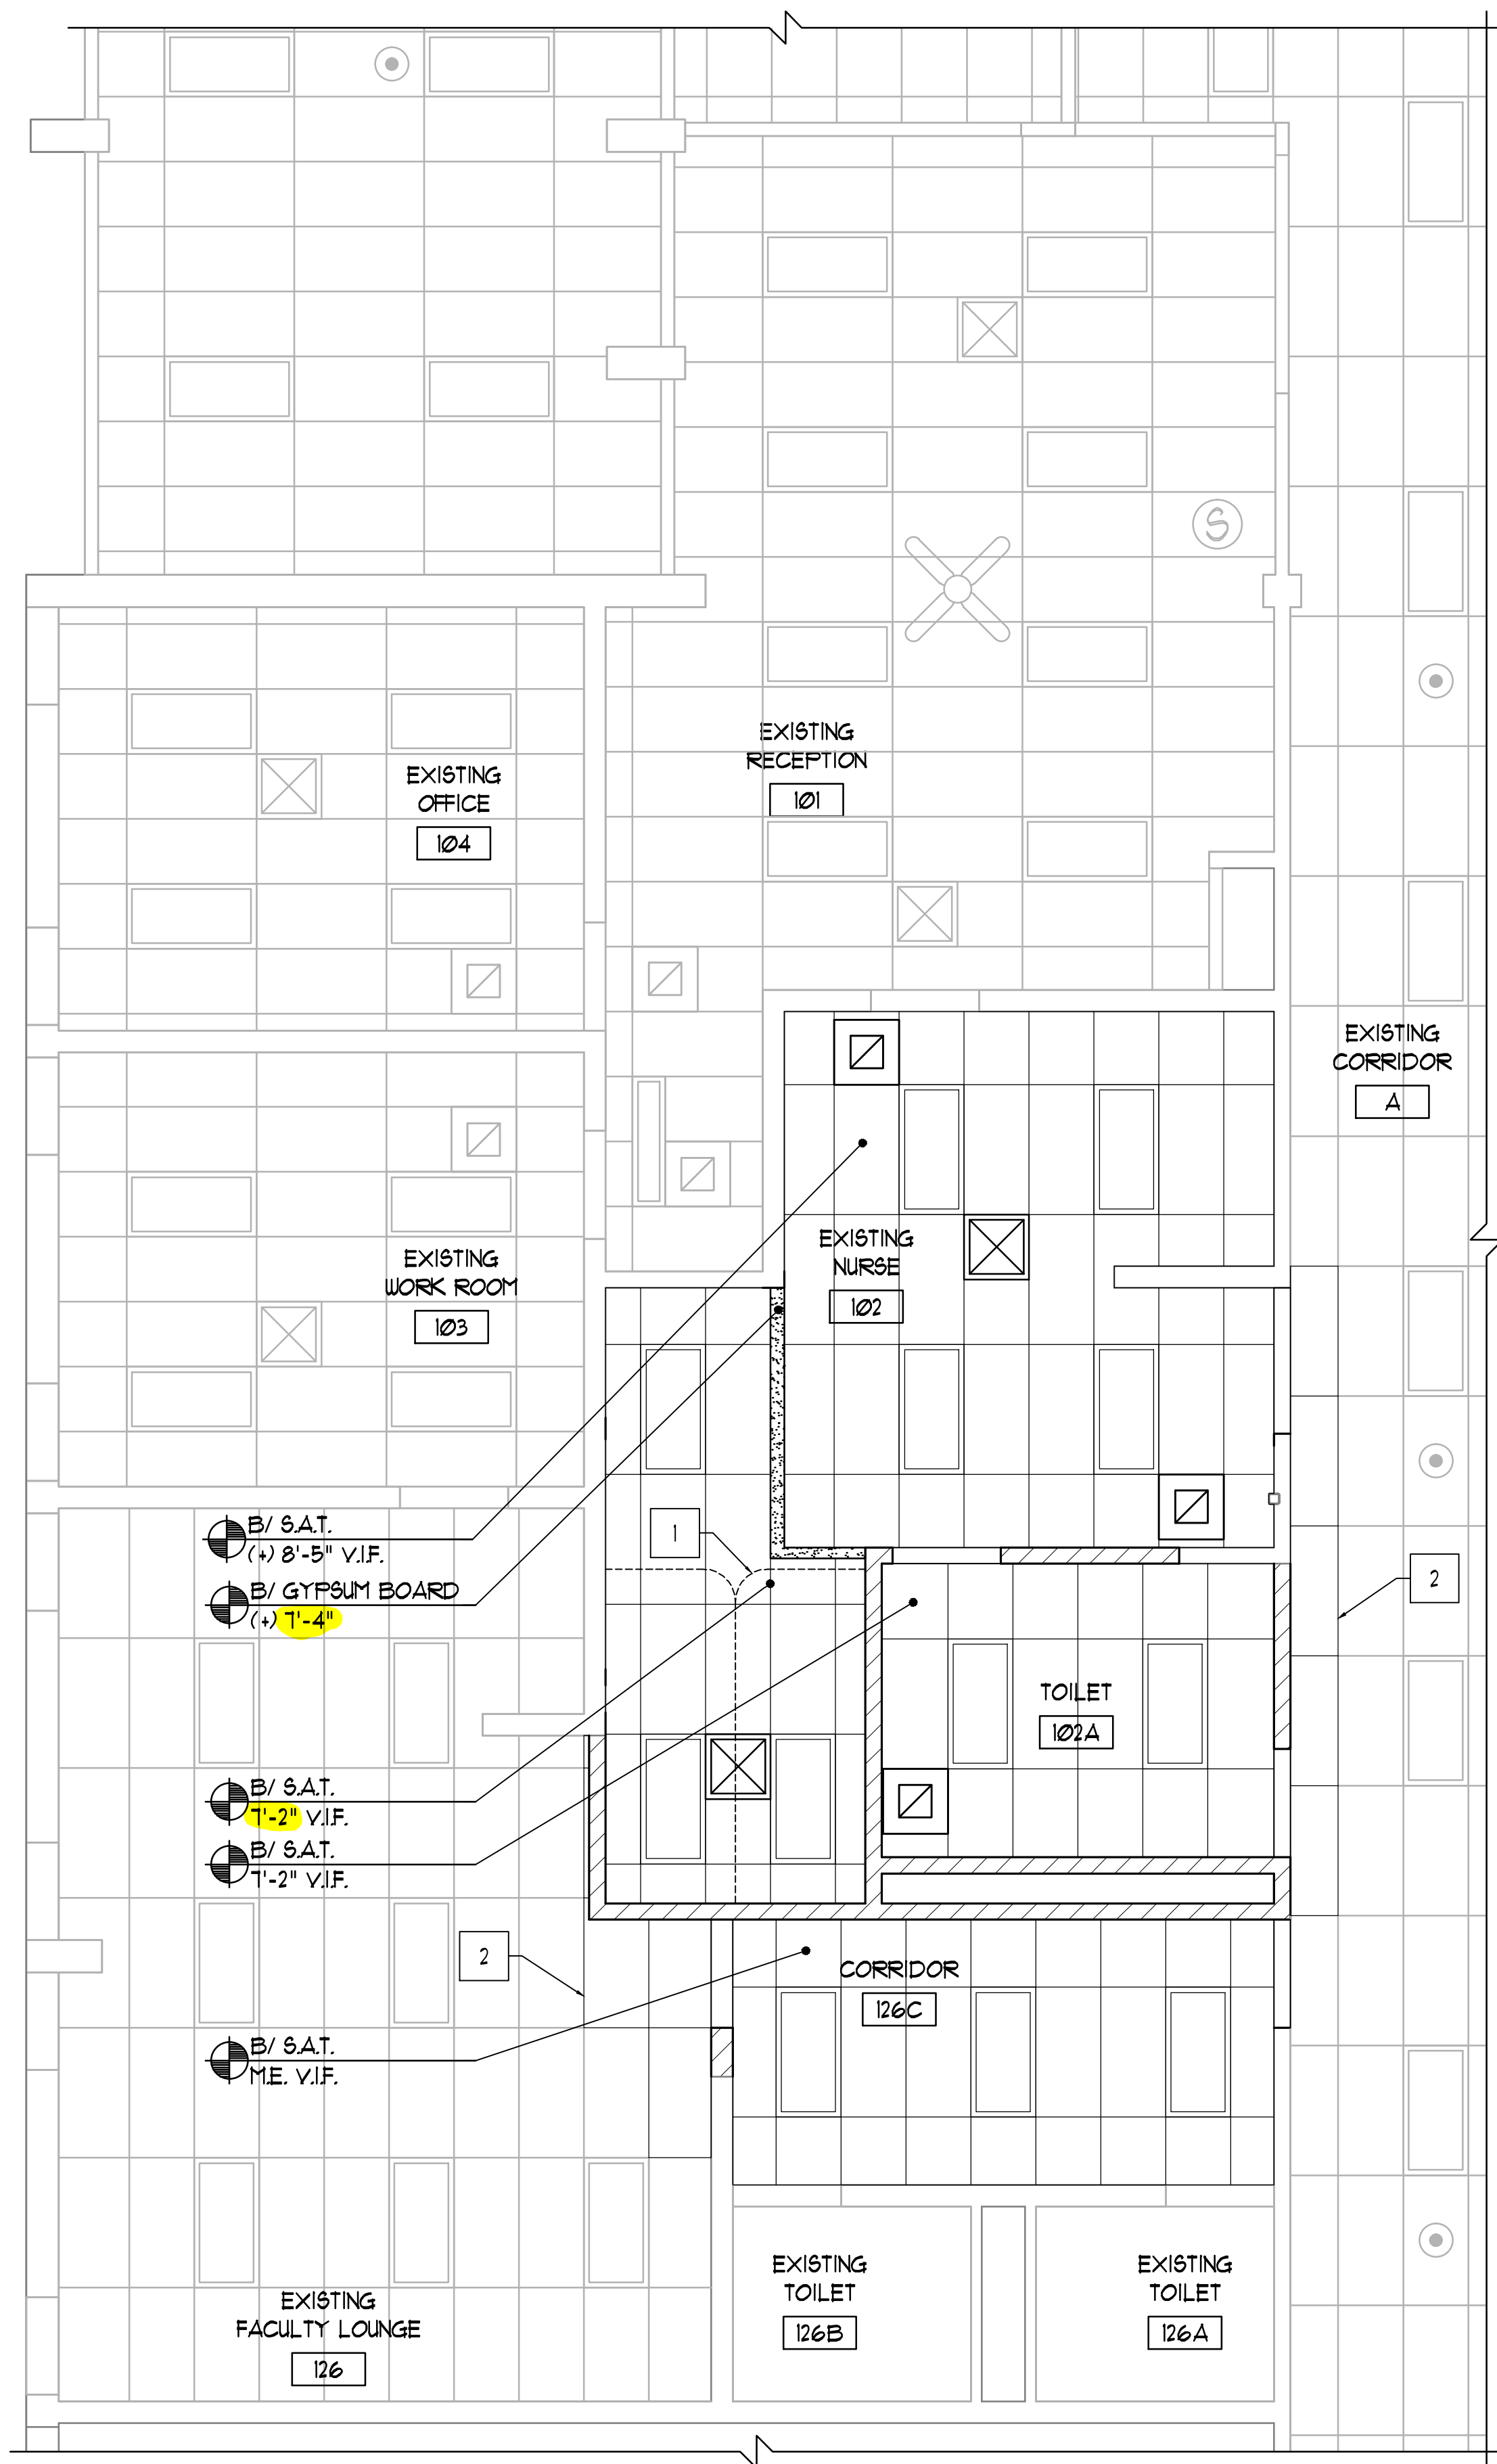

1 PARTIAL REFLECTED CEILING PLAN
1/4" = 1'-0"



LEGEND

- SUSPENDED ACOUSTICAL TILE CEILING TO REMAIN - PROTECT DURING CONSTRUCTION.
- 2'x4' SUSPENDED ACOUSTICAL TILE CEILING SYSTEM
- AREA OF GYPSUM HEADER - 5/8" GYPSUM BOARD SHALL BE SUPPORTED BY 3-5/8" METAL STUD FRAMING AT 16" ON CENTER MAXIMUM - PAINT
- 2' X 4' EXISTING RECESSED LIGHT FIXTURE - REFER TO ELECTRICAL DRAWINGS
- 1' X 4' EXISTING RECESSED LIGHT FIXTURE - REFER TO ELECTRICAL DRAWINGS
- 2' X 4' RECESSED LIGHT FIXTURE - REFER TO ELECTRICAL DRAWINGS
- 1' X 4' RECESSED LIGHT FIXTURE - REFER TO ELECTRICAL DRAWINGS
- EXISTING MECHANICAL SUPPLY DIFFUSER - REFER TO MECHANICAL DRAWINGS
- EXISTING MECHANICAL RETURN/EXHAUST DIFFUSER - REFER TO MECHANICAL DRAWINGS
- MECHANICAL SUPPLY DIFFUSER - REFER TO MECHANICAL DRAWINGS
- MECHANICAL RETURN/EXHAUST DIFFUSER - REFER TO MECHANICAL DRAWINGS
- EXISTING SPEAKER TO REMAIN - REFER TO ELECTRICAL DRAWINGS
- EXISTING EXIT SIGN - REFER TO ELECTRICAL DRAWINGS
- OCCUPANCY SENSOR TO REMAIN - REFER TO ELECTRICAL DRAWINGS
- SPEAKER - REFER TO ELECTRICAL DRAWINGS
- EXIT SIGN - REFER TO ELECTRICAL DRAWINGS
- OCCUPANCY SENSOR - REFER TO ELECTRICAL DRAWINGS
- EXISTING CONSTRUCTION TO REMAIN

REFLECTED CEILING PLAN GENERAL NOTES

- ALL CEILING IN EXISTING BUILDING ARE TO BE INSTALLED AT EXISTING HEIGHT UNLESS NOTED OTHERWISE. DESIGN INTENT IS TO MATCH EXISTING CEILING HEIGHT - DO NOT RE-USE EXISTING WALL ANGLE. CONTRACTOR TO COORDINATE ALL HEIGHTS IN FIELD WITH MECHANICAL, ELECTRICAL, PLUMBING AND FIRE PROTECTION ITEMS (NEW AND EXISTING) - NOTIFY ARCHITECT OF ANY DISCREPANCY PRIOR TO INSTALLATION. PATCH AND PAINT ANY WALL SURFACES DAMAGED BY THE REMOVAL OF EXISTING CEILINGS.
- REFER TO MECHANICAL, ELECTRICAL, PLUMBING AND FIRE PROTECTION DRAWINGS FOR ADDITIONAL AREAS OF ABOVE CEILING WORK. REMOVE AND PATCH /OR RE-INSTALL EXISTING CEILINGS IN THESE LOCATIONS ONLY AS REQUIRED TO PROVIDE WORK INDICATED TO OCCUR PRIOR TO PHASE OF CEILING WORK.
- CONTRACTOR TO VERIFY ALL EXISTING CEILING HEIGHTS PRIOR TO BEGINNING WORK ON ANY CEILING SCHEDULED TO RECEIVE WORK.
- FIELD VERIFY ALL EXISTING CONDITIONS. IN THE EVENT THAT AN ITEM NOT SHOWN ON THE DRAWINGS CONFLICTS WITH WORK UNDER THIS CONTRACT, CONTACT THE ARCHITECT PRIOR TO REMOVAL OF THAT ITEM. ITEMS SHOWN ARE INDICATED TO GIVE A GENERAL SCOPE OF WORK. ANY ITEMS REQUIRING REMOVAL/DEMOLITION TO PROPERLY PERFORM CONTRACT WORK BUT NOT SPECIFICALLY SHOWN, SHALL BE REMOVED BY THE CONTRACTOR AT NO ADDITIONAL COST, PROVIDING THE CONDITION WAS VISIBLE DURING BIDDING.
- SHORE OR BRACE ALL EXISTING CONSTRUCTION AS REQUIRED TO PERFORM WORK.
- EACH CONTRACTOR SHALL BE RESPONSIBLE FOR ALL CORING, CUTTING, PATCHING, INFILLING, REPAIRING, REFINISHING, AND REMOVAL/REPLACEMENT OF BUILDING CONSTRUCTION REQUIRED TO ACCOMMODATE THE INSTALLATION OR REMOVAL OF THEIR WORK. ALL PATCHING, REPAIRING, AND REFINISHING SHALL BE PERFORMED BY THOSE REGULARLY INVOLVED IN THAT TRADE AND SHALL MATCH THE ADJACENT CONSTRUCTION.
- PROTECT ALL EXISTING FINISHES, EQUIPMENT, AND ADJACENT WORK NOT SCHEDULED TO BE REMOVED FROM DAMAGE DURING CONSTRUCTION. ANY DAMAGED FINISHES, EQUIPMENT, OR ADJACENT SURFACES SHALL BE REPAIRED OR REPLACED BY CONTRACTOR AT NO ADDITIONAL COST TO OWNER.
- THE OWNER HAS FIRST RIGHT OF REFUSAL FOR ANY MATERIAL OR EQUIPMENT REMOVED.

REFLECTED CEILING PLAN REFERENCED NOTES

- CEILING MOUNTED TRACK WITH CURTAIN DIVIDER - REFER TO SPECIFICATIONS.
- MODIFY EXISTING GRID AND REPLACE CEILING TILES TO FIT NEW WORK.

LARSON DANIELSON
Construction Company, Inc.

302 Tyler Street
Lafayette, IN 46330
Ph: 219-362-2127
Fax: 219-362-2848

Request for information

To: Margaret Goy
TRIA ARCHITECTURE
801 MCCLINTOCK DRIVE, STE 100
BURR RIDGE, IL 60527
Ph: (830)455-4500
E-Mail: mgoy@tria-arch.com

RFI #: 5
Date: 6/9/2020
L-D Job #: 56-521
Project: DUNELAND SCH-2020 NURSE'S OFF.

CC:

Subject: Acoustical Ceiling Tile


Drawing: Spec Section: 09511
Cost Impact: TBD Schedule Impact: TBD

Request: The specification calls for USG Radar Climate Plus 2410. We are hearing from our local supplier that Duneland Schools has been using Certainteed's Fine Fissured HMF-197. Please confirm which ceiling tile you would like.


Date Required: 6/12/2020

Requested by: Jonathan Foglesong
LARSON-DANIELSON CONST. CO INC

Response: Certainteed's Fine Fissured HMF - 197 is acceptable. Provide shop drawings for grid and tiles.

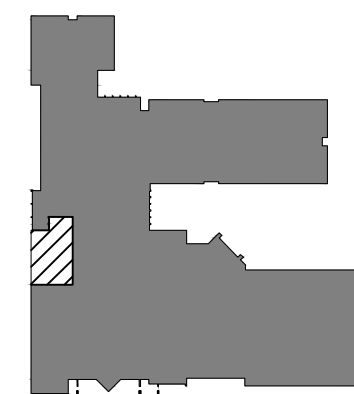

KEYPLAN
NOT TO SCALE

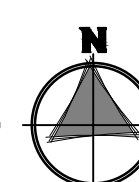

- AREA OF WORK
- NOT IN SCOPE OF WORK




EXPIRES 12/01/2021


DUNELAND SCHOOL CORPORATION
2020 NURSE'S OFFICE RENOVATIONS AT:
BAILLY ELEMENTARY SCHOOL
800 S 5TH STREET, CHESTERTON, INDIANA 46304

PROJECT NUMBER: 20-006	REVISIONS:
PROJECT MANAGER: MG	1
DRAWN BY: GT	2
USED FOR PROPOSAL:	3
DATE: 04/07/2020	4
PARTIAL REFLECTED CEILING PLAN	


A.7.10

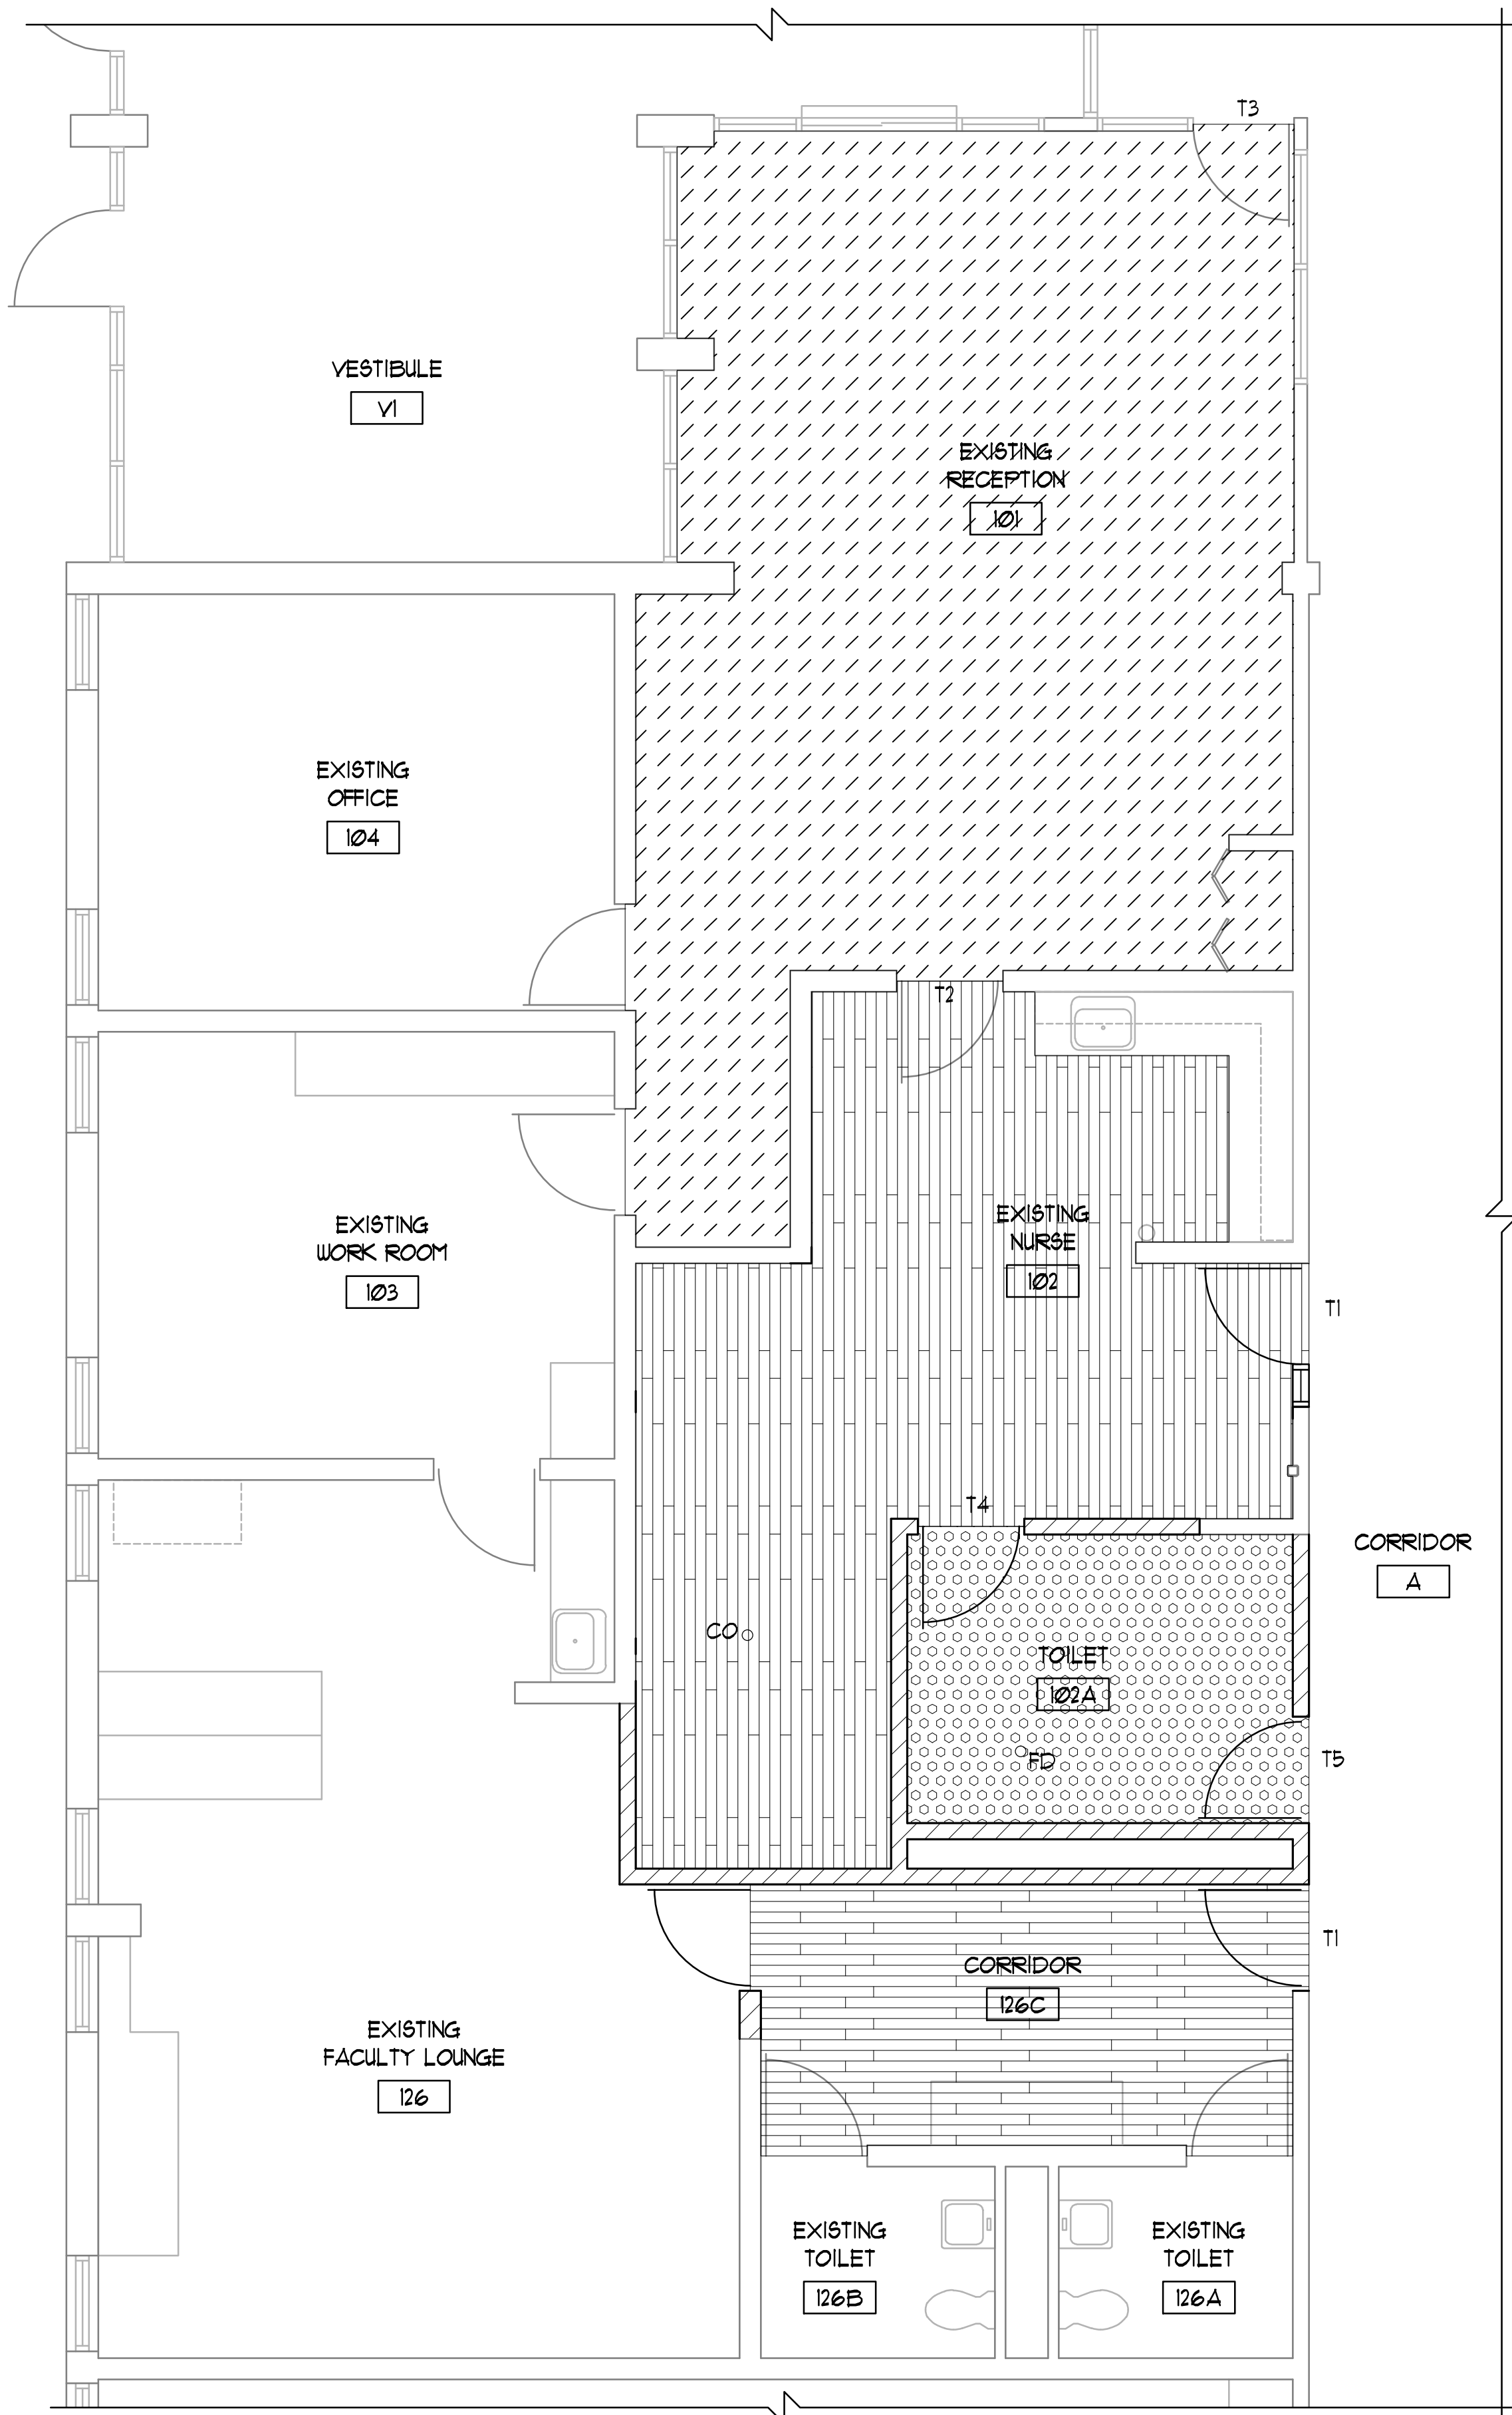


1 PARTIAL FLOOR FINISH PLAN
1/4" = 1'-0"

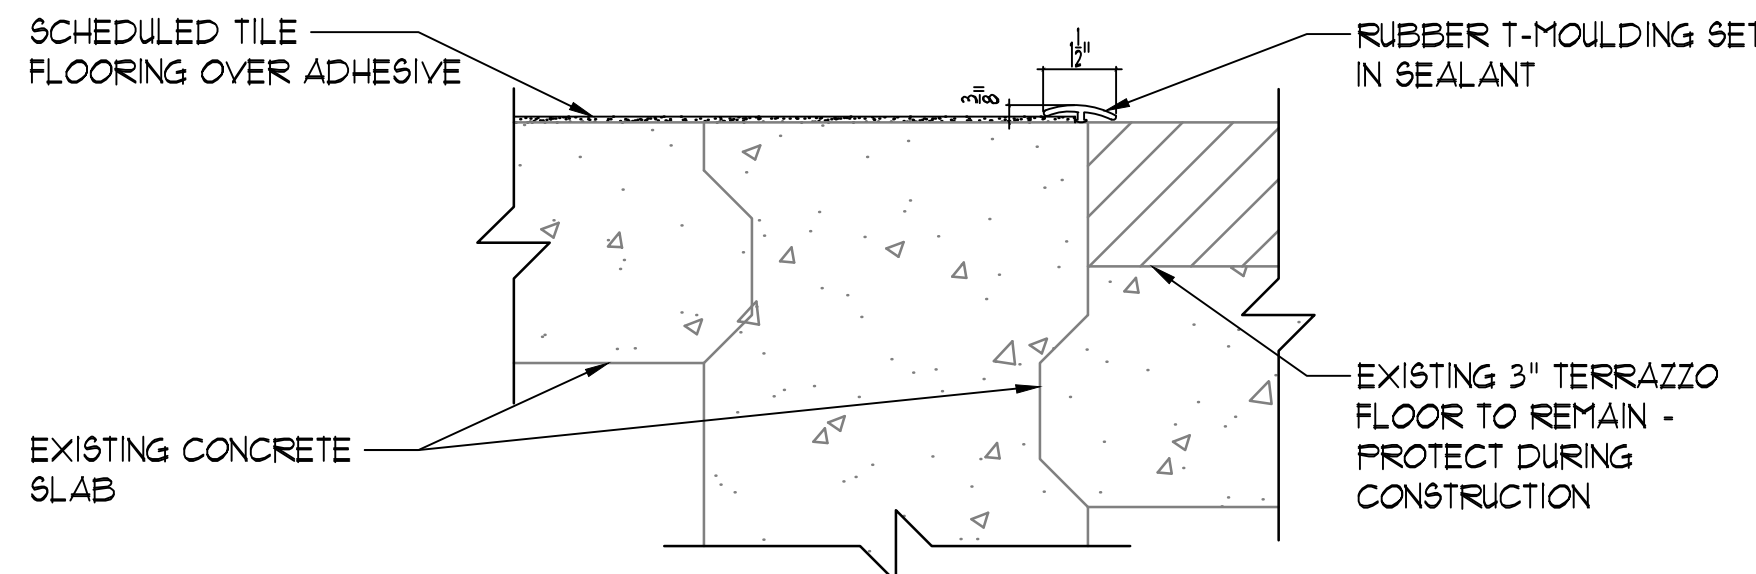


2 T1 - TRANSITION DETAIL
3" x 1'-0"

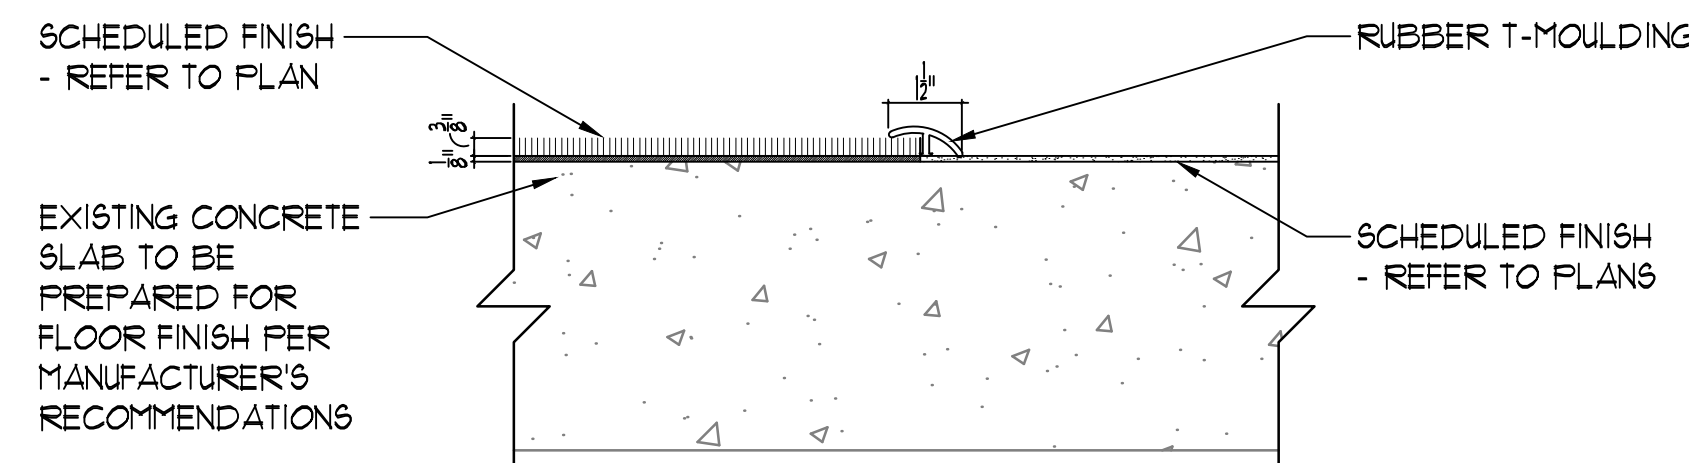


3 T2 - TRANSITION DETAIL
3" x 1'-0"

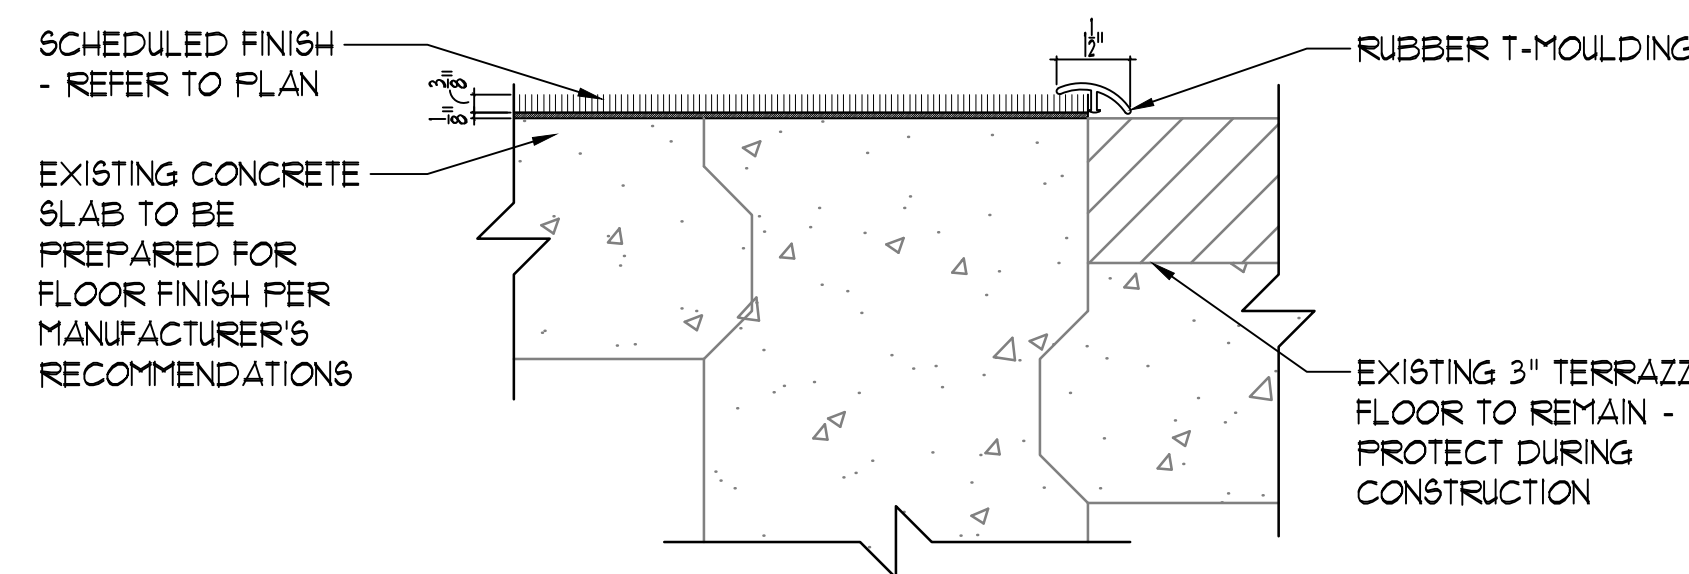

4 T3 - TRANSITION DETAIL
3" x 1'-0"

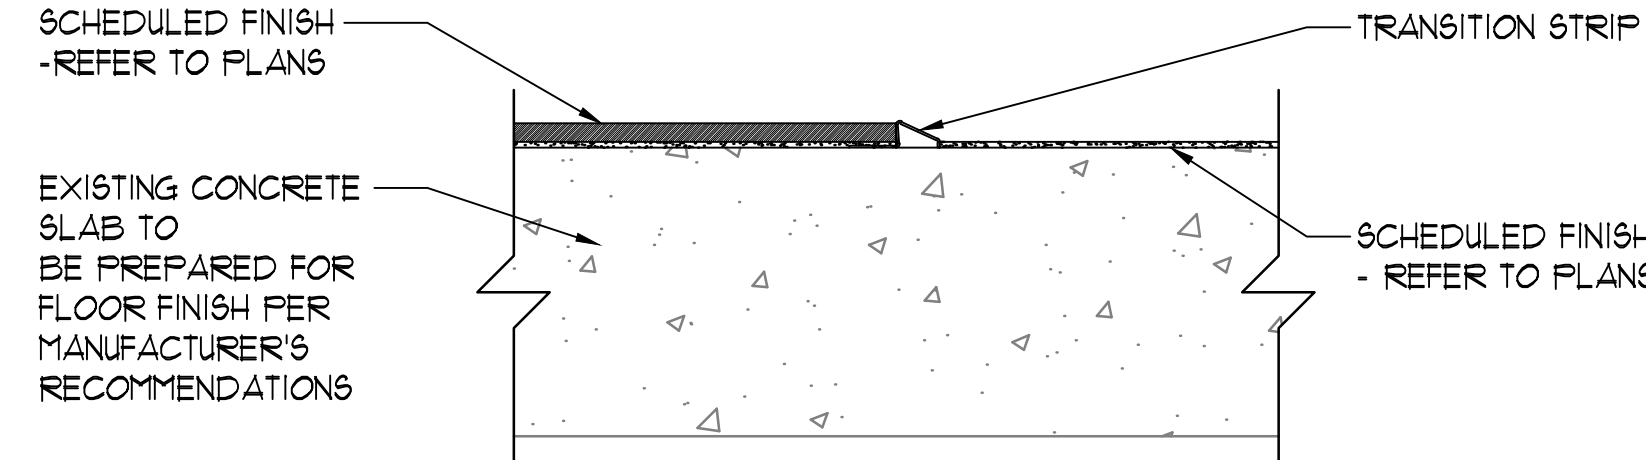

5 T4 - TRANSITION DETAIL
3" x 1'-0"

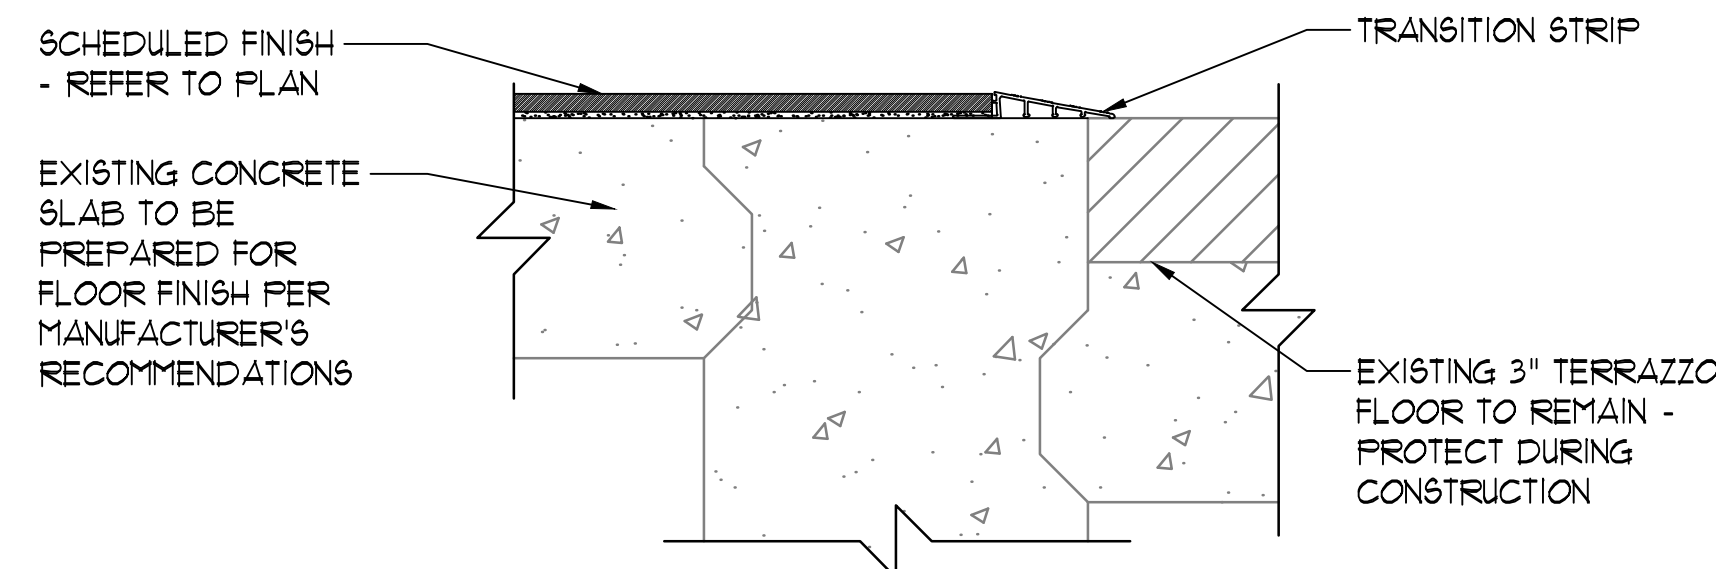

6 T5 - TRANSITION DETAIL
3" x 1'-0"

FLOOR FINISH PLAN GENERAL NOTES

1. REFER TO SPECIFICATIONS FOR ADDITIONAL PRODUCT INFORMATION.
2. MAKE EXISTING FLOOR SLAB SMOOTH AND FLAT TO FLOOR FINISH MANUFACTURER'S TOLERANCE WITH MATERIAL SUITABLE TO FLOOR FINISH. MANUFACTURER PRIOR TO INSTALLATION.
3. ALL TRANSITIONS BETWEEN DISSIMILAR FLOORING MATERIALS ARE TO RECEIVE A NEW TRANSITION STRIP - REFER TO TRANSITION DETAILS 2/4/9.10 AND 3/4/9.10.
4. PROVIDE WALL BASE AT ALL LOCATIONS OF NEW FLOORING AND/OR NEW WALL CONSTRUCTION - UNLESS NOTED OTHERWISE.
5. AREAS OF RESILIENT FLOORING ARE TO RECEIVE RUBBER COVERED BASE AND CARPETED AREAS ARE TO RECEIVE RUBBER STRAIGHT BASE - VERIFY WITH BUILDING STANDARD.
6. AT AREAS WHERE PATCHING OF WALL BASE IS REQUIRED - FINISH TO MATCH ADJACENT IN MATERIAL, COLOR, HEIGHT, FINISH AND PROFILE.
7. DO NOT PAINT PRE-FINISHED ITEMS, FACE BRICK, AND TILE FINISHES.
8. VERIFY CARPET TILE PATTERNS WITH OWNER PRIOR TO BEGINNING WORK.
9. AT ALL DOOR AND WINDOW FRAMES INSTALLED IN EXISTING OPENINGS - PATCH AND PAINT EXISTING WALL, JAMB AND HEAD SURFACES AFTER FRAME INSTALLATION - DO NOT PAINT PRE-FINISHED ITEMS - MATCH EXISTING COLOR, UNLESS NOTED OTHERWISE.
10. AT ALL AREAS WHERE MECHANICAL EQUIPMENT HAS BEEN REMOVED - PATCH AND PAINT EXISTING EXPOSED CONSTRUCTION - MATCH ADJACENT EXISTING CONSTRUCTION IN MATERIAL, TEXTURE, SIZE, FINISH AND COLOR.
11. CONTRACTOR TO VERIFY CONDITIONS AT EACH TRANSITION AND SIZE REDUCERS ACCORDINGLY.

FLOOR FINISH PLAN LEGEND

- ETR (EXISTING TO REMAIN) - PROTECT EXISTING FLOORING DURING CONSTRUCTION - CONTRACTOR TO REPAIR ANY AFFECTED AREAS - MATCH ADJACENT FINISH IN MATERIAL, COLOR, TEXTURE AND SIZE
- CPT-1 - 24"x24" CARPET TILE - REFER TO SPECIFICATIONS FOR PATTERN AND COLOR
- LVT-1 AND LVT-2 WITH 4" RUBBER BASE - REFER TO SPECIFICATIONS FOR PATTERN AND COLORS
- PRT-1 - PORCELAIN TILE - REFER TO SPECIFICATIONS FOR PATTERN AND COLOR

Addendum 1

11. QUESTION: What is expected of the terrazzo flooring in the existing reception area and the doorways adjacent to the existing corridor where new flooring is to be installed? Is it to be demoed in its entirety?
ANSWER: Existing Terrazzo (Approximately 6ft x 15ft) to remain at Existing Reception 101. Contractor to prep-existing subfloor for new floor finish as well as level, smooth and feather existing floor to match elevation of terrazzo.
12. QUESTION: What would be the expectation with the terrazzo flooring and terrazzo base where the new walls are being built and where the existing walls are being demoed. Please advise.
ANSWER: Remove existing floor finish and wall base as required to provide work indicated. Sawcut terrazzo at floor finish transition areas. At removed flooring and walls, patch and prep floor for new floor finish. Infill floor at removed terrazzo to meet existing floor level. At Existing Corridor A only, all new CMU walls should have no wall base. Provide appropriate ADA floor transition strips are every change in floor finish material.
13. QUESTION: Is the LVT1 & LVT2 a 50/50 random pattern blend? Or do they have a certain pattern they are wanting to use?
ANSWER: Provide LVT-1: Interface, Studio Set #A007, Color A00702 Pewter only at the Existing Nurse 102.
14. QUESTION: Toilet 102A calls for tile on the walls, but there are no drawings or clear instructions. Are they taking this to the ceiling or a certain height off the floor? Also calls for ceramic tile wall base, but not very clear.
ANSWER: Refer to drawing A3.00 (attached). Per spec section 09300, Floor Tile: 12"x24", Walls: 4"x24". Provide porcelain tile bull nose top trim piece (3"x12") and coved wall base to match specified wall tile.


Addendum 2

1. QUESTION: Is there still LVT to be installed at Corridor 126?
ANSWER: Yes. Provide LVT-1: Interface, Studio Set #A007, Color A00702 Pewter only.
2. QUESTION: Is all tile in Nurse Toilet to be porcelain tile?
ANSWER: Yes.
3. QUESTION: There is no coved wall tile base to match porcelain tile. What should I provide?
ANSWER: Provide Schluter®-DILEX-AHK at intersection of Wall Tile and Floor Tile.




KEYPLAN
NOT TO SCALE

- AREA OF WORK
- NOT IN SCOPE OF WORK

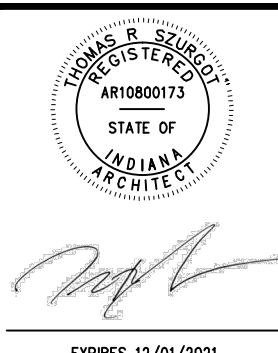

DUNELAND SCHOOL CORPORATION
2020 NURSE'S OFFICE RENOVATIONS AT:
BAILLY ELEMENTARY SCHOOL
800 S 5TH STREET, CHESTERTON, INDIANA 46304

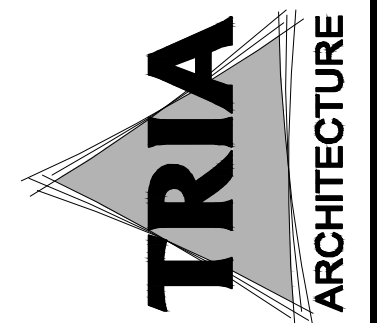

TRIA ARCHITECTURE
TRIA ARCHITECTURE
A9.10

ROOM FINISH SCHEDULE												
ROOM NO	ROOM NAME	NORTH WALL		EAST WALL		SOUTH WALL		WEST WALL		CEILING	FLOORING	REF. NOTES
		WALL FINISH	WALL BASE	WALL FINISH	WALL BASE	WALL FINISH	WALL BASE	WALL FINISH	WALL BASE			
FIRST FLOOR												
101	EXISTING RECEPTION	PT-1	RBB-1	PT-1	RBB-1	PT-1	RBB-1	PT-1	RBB-1	SAT-1	CPT-1	-
102	EXISTING NURSE	PT-1	RBB-1	PT-1	RBB-1	PT-1	RBB-1	PT-1	RBB-1	SAT-1	LVT-1/LVT-2	-
102A	TOILET	PRT-1	PRT-1	PRT-1	PRT-1	PRT-1	PRT-1	PRT-1	PRT-1	SAT-1	PRT-1	-
103	EXISTING OFFICE	ETR	ETR	ETR	ETR	ETR	ETR	ETR	ETR	ETR	ETR	-
104	EXISTING OFFICE	ETR	ETR	ETR	ETR	ETR	ETR	ETR	ETR	ETR	ETR	-
126	EXISTING STAFF LOUNGE	PT-1/ETR	RBB-1/ETR	PT-1/ETR	RBB-1/ETR	ETR	ETR	ETR	ETR	SAT-1/ETR	ETR	-
126A	EXISTING TOILET	ETR	ETR	ETR	ETR	ETR	ETR	ETR	ETR	ETR	ETR	-
126B	EXISTING TOILET	ETR	ETR	ETR	ETR	ETR	ETR	ETR	ETR	ETR	ETR	-
126C	CORRIDOR	PT-1	RBB-1	PT-1	RBB-1	PT-1	RBB-1	PT-1	RBB-1	SAT-1	LVT-1/LVT-2	-
A	CORRIDOR	ETR	ETR	ETR	ETR	ETR	ETR	PT-1/ETR	-	SAT-1/ETR	ETR	-

ROOM FINISH SCHEDULE LEGEND	
PT-1	PAINT COLOR 1 - GENERAL FIELD COLOR
PT-2	PAINT COLOR 2 - INTERIOR METAL FRAMES
RBB-1	4" RUBBER BASE - REFER TO SPECIFICATIONS FOR COLOR
CPT-1	24"x24" CARPET TILE - REFER TO SPECIFICATIONS FOR PATTERN AND COLOR
LVT-1	REFER TO SPECIFICATIONS FOR PATTERN AND COLOR
LVT-2	REFER TO SPECIFICATIONS FOR PATTERN AND COLOR
PRT-1	PORCELAIN TILE - REFER TO SPECIFICATIONS FOR PATTERN AND COLOR
SAT-1	SUSPENDED ACOUSTICAL TILE CEILING

ROOM FINISH GENERAL NOTES	
1.	ALL INTERIOR WALL AND CEILING FINISH MATERIALS SHALL BE IN ACCORDANCE WITH THE 2012 INTERNATIONAL BUILDING CODE WITH LOCAL AMENDMENTS.
2.	REFER TO SPECIFICATIONS FOR ADDITIONAL INFORMATION.
3.	REFER TO FLOOR PLANS AND WALL TYPES FOR WALL CONSTRUCTION.
4.	REFER TO REFLECTED CEILING PLANS FOR CEILING CONSTRUCTION AND SOFFIT LOCATIONS.
5.	ALL FINISHES, FURNITURE, AND EQUIPMENT ARE TO BE PROTECTED DURING WORK.
6.	ALL EXPOSED NEW CONSTRUCTION (LISTED IN THE SCHEDULE OR NOT) SHALL BE PAINTED, EXCEPT FOR PREFINISHED MATERIALS, UNLESS NOTED OTHERWISE.
7.	ALL EXISTING CONSTRUCTION ON SURFACES LISTED IN SCHEDULE, EXCEPT FOR PREFINISHED ITEMS OR FOR SURFACES LISTED AS EXISTING TO REMAIN, SHALL BE PAINTED UNLESS NOTED OTHERWISE.
8.	ALL EXISTING PAINTED SURFACES IMMEDIATELY ADJACENT TO AREAS AFFECTED BY CONSTRUCTION SHALL BE PAINTED AS NEEDED TO BLEND NEW CONSTRUCTION INTO EXISTING AND TO TOUCH-UP DAMAGED PAINT SURFACES ON EXISTING SURFACES.
9.	ALL EXPOSED PIPING, DUCTWORK ELECTRICAL CONDUIT, SPRINKLER PIPING, AND ALL OTHER EXPOSED MECHANICAL, ELECTRICAL, PLUMBING, AND FIRE PROTECTION ITEMS TO BE PAINTED UNLESS NOTED OTHERWISE.
10.	ALL NEW HOLLOW METAL DOORS AND FRAMES (ALL EXPOSED FACES) SHALL BE PAINTED UNLESS NOTED OTHERWISE (PT-2).
11.	ALL EXISTING HOLLOW METAL DOORS AND FRAMES (ALL EXPOSED FACES) IN WALLS LISTED IN SCHEDULE SHALL BE PAINTED, EXCEPT FOR LOCATIONS INDICATED TO BE EXISTING TO REMAIN. (PT-2)
12.	AT ALL DOORS AND FRAMES INSTALLED IN EXISTING WALL CONSTRUCTION - PATCH AND PAINT EXISTING WALL, JAMB AND HEAD SURFACES AFTER FRAME INSTALLATION.
13.	AT ALL LOCATIONS OF EXISTING EQUIPMENT, CASEWORK, OR FURNISHINGS TO BE REMOVED, PAINT THE EXISTING WALL CONSTRUCTION EXPOSED BY REMOVAL OF THESE ITEMS TO MATCH EXISTING ADJACENT WALL FINISHES.
14.	DO NOT PAINT PREFINISHED ITEMS (FACE BRICK, FIRE ALARM DEVICES, TILE FINISHES, ETC.).
15.	ALL FLOORING SHALL BE STABLE, FIRM AND SLIP-RESISTANT AND SHALL COMPLY WITH SECTION 400.10(A)5 OF THE STATE OF ILLINOIS ACCESSIBILITY CODE.
16.	ALL FLOOR DRAINS, CLEANOUT COVERS AND ELECTRICAL FLOOR DEVICES ARE TO BE FLUSH WITH FINISHED FLOORING. REFER TO PLUMBING AND ELECTRICAL DRAWINGS FOR ADDITIONAL INFORMATION.
17.	TRANSITIONS IN FLOOR FINISHES, COLORS, OR PATTERNS ARE TO OCCUR AT THE CENTER OF DOORS UNLESS NOTED OTHERWISE.
18.	ALL TRANSITIONS BETWEEN FLOORING MATERIALS TYPES ARE TO RECEIVE A TRANSITION STRIP.
19.	FLOOR FINISHES INDICATED IN SCHEDULE SHALL CONTINUE UNDER ALL FIXTURES, EQUIPMENT, AND CASEWORK UNLESS NOTED OTHERWISE.
20.	PROVIDE WALL BASE AT ALL LOCATIONS OF NEW FLOOR FINISH OR NEW WALL CONSTRUCTION - UNLESS NOTED OTHERWISE.

CHANGE ORDER INFORMATION:
Change Order Number: 001

Date: August 6, 2020
Eliminate Painting Room 101
Terrazzo Patching

MEMO

VIA E-MAIL
(1) Page(s) Inclusive
jpr@ldconstruction.com

PROJECT: Duneland School Corporation – 2020 Nurse Renovation - Bailly
TO: Jonathan Foglesong
FROM: Tom Szurgot
DATE: June 23, 2020
PROJ. #: 20-006
RE: Color Selections

Please see the following color selections:

LVT

- LVT#1 – Interface "Pewter" (Rooms: 102, 126c)
- LVT#2 – Interface "Pepper" NOT NEEDED

FLOOR AND WALL TILE

- Daltile Fabrique "Crème Linen P686" (Room 102A)
- Match floor and wall tile layout as per the existing kindergarten toilet room as discussed.

GROUT

- Custom Building Products – "Snow White #11"

METAL EDGE

- Schluter "Dilex-AHK" Satin Anodized

RUBBER BASE

- Tarkett – "Burgundy #85"


CARPET

- CPT#1 – Tandus "Forge" NOT NEEDED
- CPT#2 – Interface Aerial "Iron" (Room 101)
- CPT#3 – Interface Viva Colores "Cereza" NOT NEEDED



AREA OF WORK
NOT IN SCOPE OF WORK

KEYPLAN
NOT TO SCALE

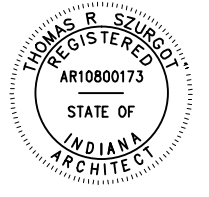

EXPRES 12/01/2021

DUNELAND SCHOOL CORPORATION
2020 NURSE'S OFFICE RENOVATIONS AT:
BAILLY ELEMENTARY SCHOOL
800 S 5TH STREET, CHESTERTON, INDIANA 46304


PROJECT NUMBER: 20-006	REVISIONS:
PROJECT MANAGER: JF	1
DRAWN BY: GT	2
USED FOR PROPOSAL:	3
04/07/2020	4
ROOM FINISH SCHEDULE	


A9.50

NEP-PF CONSULTANT
(P) 6302381956



700 WILSON RD., SUITE 100, CHICAGO, ILLINOIS 60654

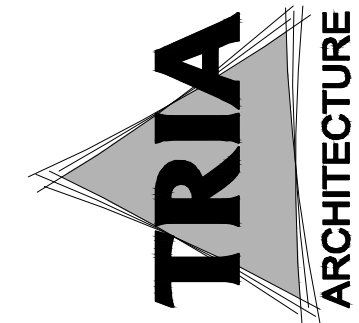

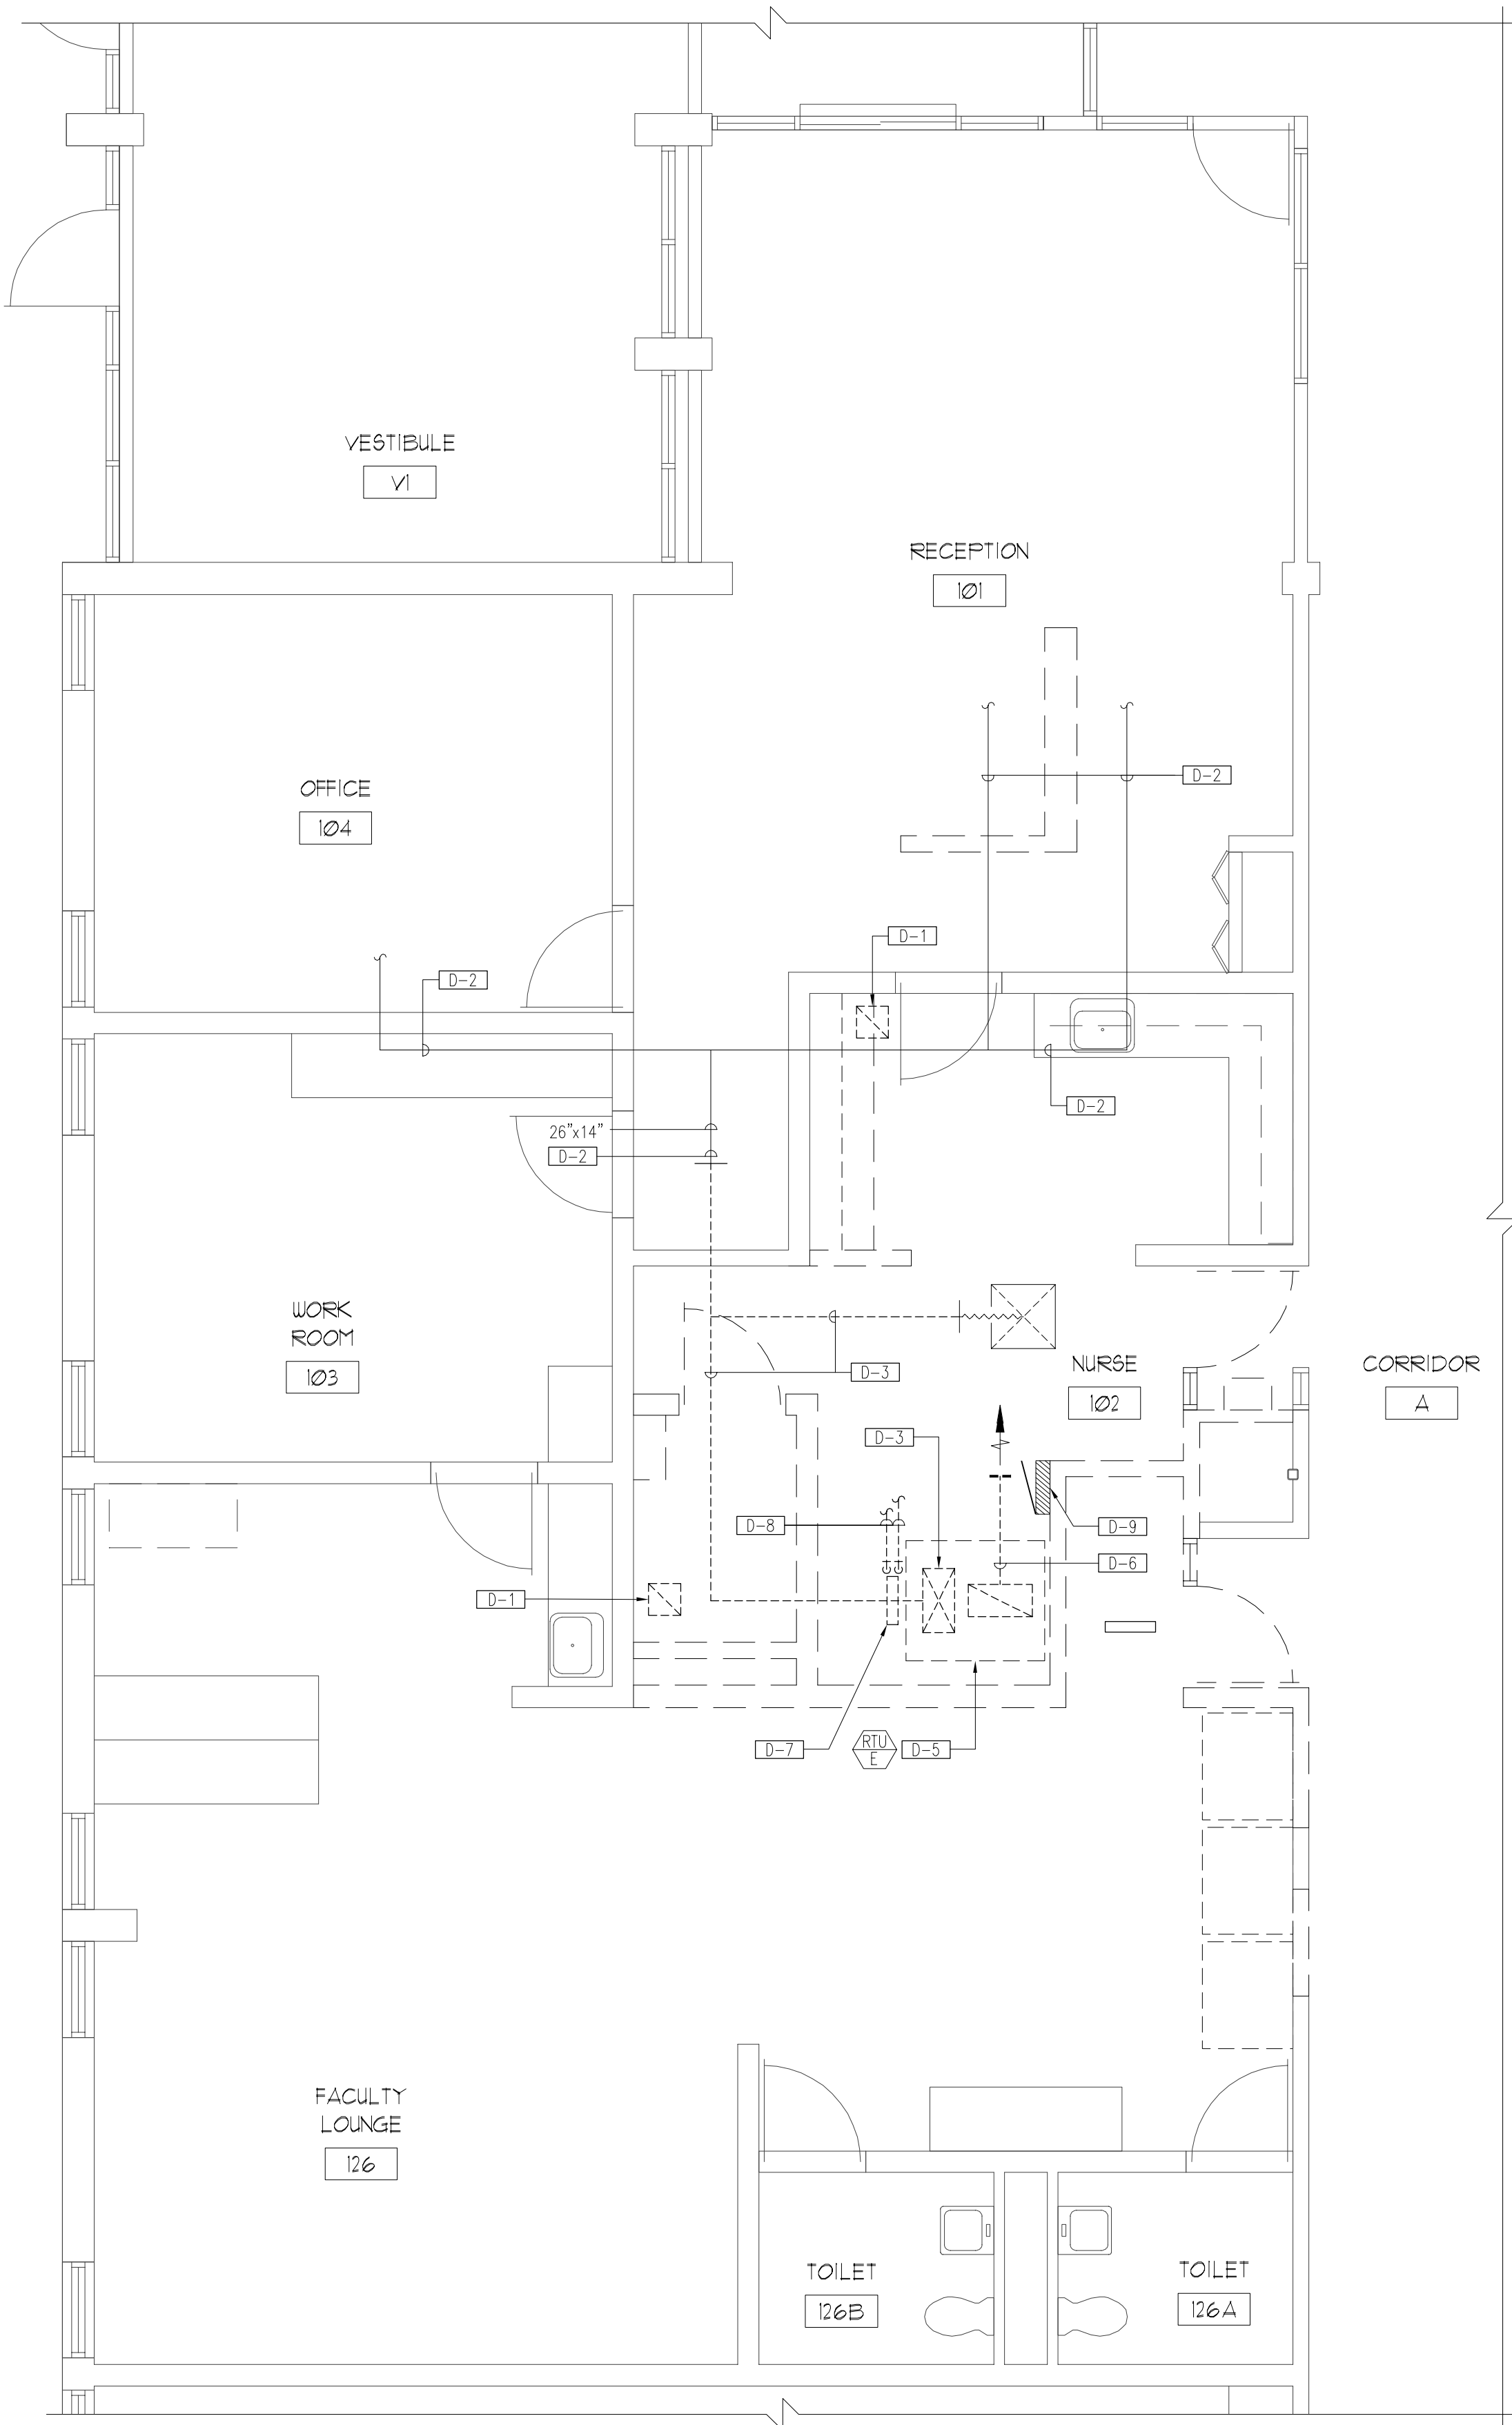

1 PARTIAL EXISTING FLOOR PLAN - MECHANICAL
1/4" = 1'-0"



MECHANICAL DEMOLITION SYMBOLS	
SYM BOL	DESCRIPTION
R	EXISTING ELECTRICAL EQUIPMENT OR OUTLET TO BE REMOVED.
X	EXISTING ELECTRICAL EQUIPMENT OR OUTLET TO REMAIN.
XN	EXISTING ELECTRICAL EQUIPMENT OR OUTLET RELOCATED (NEW LOCATION).
XRR	EXISTING ELECTRICAL EQUIPMENT OR OUTLET TO BE REMOVED, RELOCATED AND JUNCTION BOX REMOVED OR CAPPED AS REQUIRED


MECHANICAL DEMOLITION NOTES:	
D-1	REMOVE EXISTING RETURN/ EXHAUST REGISTER. EXHAUST DUCT WORK TO REMAIN AND BE CAPPED ABOVE THE CEILING.
D-2	EXISTING SUPPLY DUCT TO REMAIN.
D-3	CUT EXISTING SUPPLY DUCT IN CORRIDOR
D-4	REMOVE EXISTING SUPPLY DUCTWORK, INCLUDING ELBOW AT DUCT DROP FROM RTU-E.
D-5	RTU-E TO REMAIN.
D-6	REMOVE RETURN DUCT AND ELBOW UP TO RTU-E.
D-7	REMOVE HOT WATER HEATING COIL.
D-8	CUT 3/4" HWS & R ± 2'-0" FROM HEATING COIL. INSTALL SHUT-OFF BALL VALVES FOR INSTALLATION OF NEW HOT WATER HEATING COIL. EXISTING COIL CONTROLS TO REMAIN TO INCLUDE CONTROL VALVE, CONTROLLER, WIRING, ETC.
D-9	EXISTING JCI CONTROL CABINET, LOCATED ABOVE THE CEILING TO BE RELOCATED PER NEW WORK DRAWING. CONTROLS TO BE DONE BY JO. CALUMET CITY, IL. OFFICE: CONTACT MARY PULLO @ 708-828-3421; NO SUBSTITUTIONS.

GENERAL NOTES FOR MECHANICAL WORK

- DRAWINGS ARE GENERALLY DIAGRAMMATIC. ROUTING OF PIPING AND DUCTWORK AS SHOWN, DOES NOT INTEND TO SHOW EVERY RISE, DROP, OFFSET, FITTING NOR EVERY STRUCTURAL ELEMENT THAT MAY BE ENCOUNTERED DURING THE INSTALLATION OF THIS WORK. EACH CONTRACTOR SHALL MAKE ANY REQUIRED CHANGES FROM THE GENERAL ROUTING SHOWN ON THESE DRAWINGS, SUCH AS OFFSETS, BENDS OR CHANGES IN ELEVATION DUE TO COORDINATION WITH THE WORK OF OTHER TRADES AND BUILDING CONSTRUCTION. ALL CHANGES SHALL BE MADE WITHOUT ADDITIONAL COST TO THE OWNER OR DELAY IN COMPLETION DATE OF THE PROJECT.
- IT IS INTENDED THAT EQUIPMENT SHALL BE LOCATED SYMMETRICALLY WITH THE ARCHITECTURAL ELEMENTS OF THE BUILDING, NOTWITHSTANDING THE FACT THAT LOCATIONS INDICATED BY THESE DRAWINGS MAY BE DISTORTED FOR CLARITY OF PRESENTATION.
- CONTRACTOR SHALL CHECK DRAWINGS OF OTHER TRADES TO VERIFY THAT SPACES IN WHICH THEIR WORK WILL BE INSTALLED ARE CLEAR OF OBSTRUCTIONS. WORK SHALL BE INSTALLED TO MAINTAIN MAXIMUM HEADROOM AND SPACE CONDITION AT ALL POINTS IN THE BUILDING. WHERE HEADROOM OR SPACE CONDITIONS APPEAR INADEQUATE, CONTRACTOR SHALL NOTIFY ARCHITECT/ENGINEER BEFORE PROCEEDING WITH THE INSTALLATION OF THEIR WORK.
- CONTRACTOR SHALL FURNISH OTHER TRADES ADVANCE INFORMATION AND/OR SHOP DRAWINGS ON LOCATIONS AND SIZES OF PIPING, DUCTWORK, EQUIPMENT, FRAMES, BOXES, SLEEVES AND OPENINGS, ETC. NEEDED FOR THEIR WORK TO PERMIT OTHER TRADES AFFECTED TO INSTALL THEIR WORK PROPERLY AND WITHOUT DELAY.
- WHERE THERE IS EVIDENCE THAT WORK OF ONE TRADE WILL INTERFERE WITH WORK OF OTHER TRADES, ALL TRADES SHALL MEET ON JOB SITE TO WORK OUT SPACE CONDITIONS AND MAKE SATISFACTORY ADJUSTMENTS TO INSTALLATION OF THE NEW WORK. CONTRACTOR SHALL BE RESPONSIBLE, AT THEIR OWN EXPENSE, FOR THE REMOVAL AND REINSTALLATION OF ANY PART OF THEIR WORK IF SAME WAS INSTALLED WITHOUT CONSULTING WITH OTHER TRADES BEFORE INSTALLING THEIR WORK.
- CONTRACTOR SHALL PROVIDE SLEEVES IN FLOORS AND WALLS AS SHOWN ON THE DRAWINGS, AS REQUIRED BY JOB SITE CONDITIONS, AND/OR AS SPECIFIED, WHEN INSTALLING THEIR WORK.
- THE SEQUENCE FOR THE INSTALLATION OF ALL WORK SHALL BE COORDINATED BETWEEN ALL CONTRACTORS ON THE PROJECT AND IN STRICT ACCORDANCE WITH ARCHITECT/ENGINEER AND OWNERS STIPULATION AS CALLED FOR IN THE SPECIFICATION AND/OR AS DIRECTED.
- CONTRACTOR SHALL REFER TO THE ARCHITECTURAL AND STRUCTURAL CONTRACT DRAWINGS (BEFORE SUBMITTING THEIR BIDS) TO FAMILIARIZE THEMSELVES WITH THE EXTENT OF THE OTHER TRADES CONTRACTORS WORK, CEILING HEIGHTS AND CLEARANCE FOR INSTALLING THEIR WORK.
- CONTRACTOR SHALL BE RESPONSIBLE AND PAY FOR ALL CORING, CUTTING, PATCHING, REPAIRING AND REFINISHING OF BUILDING CONSTRUCTION REQUIRED TO ACCOMMODATE THE INSTALLATION OF THEIR WORK. ALL PATCHING, REPAIRING AND REFINISHING WORK SHALL BE PERFORMED BY THOSE REGULARLY INVOLVED IN THAT TRADE AND SHALL MATCH THE NEW CONSTRUCTION AS CLOSELY AS POSSIBLE. CARE SHALL BE TAKEN SO AS NOT TO DAMAGE ANY EXISTING BUILDING CONSTRUCTION OR ITEMS THAT ARE TO REMAIN. ANY EXISTING FINISHES THAT ARE DAMAGED DURING THE INSTALLATION OF NEW WORK SHALL BE REPAIRED, REPLACED AND PAID FOR BY THE INSTALLING CONTRACTOR, TO THE SATISFACTION OF THE ARCHITECT AND OWNER. REFER TO ARCHITECTURAL DRAWINGS FOR EXISTING BUILDING CONSTRUCTION THAT IS TO REMAIN AND, THEREFORE, SUBJECT TO PATCHING, REPAIRING, AND REFINISHING.
- CONTRACTOR SHALL BE RESPONSIBLE FOR THEIR OWN CLEAN-UP DURING CONSTRUCTION. IF CONTRACTOR FAILS TO PROVIDE SUCH CLEAN-UP, THE ARCHITECT/ENGINEER WILL DIRECT ANOTHER CONTRACTOR TO PERFORM THE CLEAN-UP AND THE NEGLIGENT CONTRACTOR SHALL PAY THE ASSOCIATED BACK-CHARGES AS DEEMED APPROPRIATE BY THE ARCHITECT/ENGINEER.
- CONTRACTOR SHALL INSTALL ALL AUXILIARY SUPPORTING STEEL AS REQUIRED FOR THE SUPPORTING OF THEIR PIPING, DUCTWORK, CONDUIT, TANKS, EQUIPMENT, ETC. ALL SUPPORTING STEEL FOR ITEMS ABOVE A SUSPENDED CEILING SHALL BE FROM BUILDING STRUCTURAL MEMBERS ONLY.
- ALL PIPING SHALL BE SUSPENDED WITH CLEVIS AND/OR TRAPEZE PIPE HANGERS. INSULATED PIPING SHALL REST ON STEEL OR WOOD (CHILLED WATER PIPING) PIPE COVERING PROTECTION SADDLES OR SHEET METAL INSULATION SHIELDS AS CALLED FOR IN THE SPECIFICATIONS AND/OR DETAILED ON THE DRAWINGS.
- ALL WATER SUPPLY AND RETURN PIPING SHALL BE INSULATED, INCLUDING ALL PIPING ABOVE CEILINGS, INSIDE EQUIPMENT, CABINETS, PIPE CHASES AND IN WALLS. SEE SPECIFICATIONS FOR TYPE AND THICKNESS OF INSULATION.
- ALL HOT WATER SUPPLY/RETURNS PIPING SHALL BE INSTALLED TO COMPENSATE FOR EXPANSION OF THE PIPE BY INSTALLING PIPE ANCHORS, GUIDES, EXPANSION JOINTS OR LOOPS AND PIPE OFFSETS AS REQUIRED BY FIELD CONDITIONS OR AS SHOWN ON THE DRAWINGS.
- PITCH ALL SUPPLY AND RETURN WATER LINES TO DRAIN COMPLETELY THROUGH LOWER EQUIPMENT, UNIONS, OR DRAIN VALVES. INSTALL A 1/2" DRAIN VALVE WITH 3/4" HOSE THREAD OUTLET IN ALL MAIN PIPING RUNS WHICH WOULD NOT BE ABLE TO DRAIN THRU A LOWER PIECE OF EQUIPMENT. ALL DRAIN VALVES TO BE BALL VALVES.
- INSTALL A MANUAL SHUT OFF COCK AND DIRT LEG ON EACH BRANCH GAS LINE CONNECTED TO GAS FIRED EQUIPMENT. ALL VENT LINES FROM EACH GAS REGULATOR SHALL BE GROUPED INTO A COMMON HEADER AND RUN UP THRU ROOF TO A TURNED DOWN ELBOW WITH GALVANIZED INSECT SCREEN OVER OPENING.
- RECESSED AND/OR SEMI-RECESSED CABINET UNIT HEATERS (CUH) SHALL BE MOUNTED A MINIMUM OF 8" ABOVE THE FLOOR AND HAVE A FOUR (4) SIDE FLANGED OVERLAP WALL GUARD FRAME.
- ALL ROOF MOUNTED EXHAUST FANS SHALL HAVE A BUILT IN DISCONNECT SWITCH, ALUMINUM BIRD SCREEN, MOTORIZED DAMPER OR MANUAL BACKDRAFT DAMPER (REFER TO SCHEDULE) AND SHALL BE MOUNTED ON AN ALUMINUM PREFABRICATED CURB WITH SOUND INSULATION ON THE INSIDE OF THE CURB. CURB HEIGHT SHALL BE A MINIMUM OF 18 INCHES ABOVE ROOF DECK.
- ALL DUCTWORK SIZES SHOWN ON THE DRAWINGS ARE INSIDE DIMENSIONS. WHERE DUCT LINING IS CALLED FOR CONTRACTOR SHALL INCREASE THE SIZE OF THE DUCT TO MAINTAIN THE MINIMUM INSIDE DIMENSIONS CALLED FOR ON THE DRAWINGS.
- MECHANICAL CONTRACTOR SHALL COORDINATE ALL SERVICE POINTS ON VAV BOXES WITH THE INSTALLATION OF NEW WORK IN THIS PROJECT AND NEW BUILDING CHARACTERISTICS TO MAKE SURE ACCESSIBILITY IS MAINTAINED.
- ALL DUCTWORK CONNECTIONS TO AIR MOVING EQUIPMENT SHALL BE MADE WITH FLEXIBLE DUCT CONNECTIONS ON THE INLET AND DISCHARGE OF ALL SUPPLY, RETURN AND EXHAUST FANS (EXCEPT ROOF MOUNTED EXHAUST FANS).
- ALL BUILT UP UNITS SHALL HAVE INTERNAL SPRING VIBRATION ISOLATORS. ALL SUSPENDED EXHAUST AND EXHAUST/RETURN FANS SHALL BE HUNG WITH OR SET ON SPRING VIBRATION ISOLATORS.
- INSTALL TURNING VANES IN ALL SQUARE DUCT ELBOWS. INSTALL MANUAL VOLUME DAMPERS IN EACH BRANCH DUCT AT CONNECTION TO MAIN DUCT AND IN EACH DUCT AFTER A BRANCH DUCT SPLIT.
- INSTALL A MINIMUM 12" X 12" ACCESS DOOR (INLET SIDE) AT EACH MOTORIZED DAMPER, FIRE DAMPER, SMOKE DAMPER, INLINE FAN, INTAKE AND EXHAUST FLENUMS AND AN ACCESS DOOR AT AIR SUPPLY UNIT FILTER SECTION.
- THE LOCATIONS SHOWN FOR ALL DIFFUSERS, REGISTERS AND GRILLES, ETC. ARE DIAGRAMMATIC. EXACT LOCATION SHALL BE DETERMINED FROM THE REFLECTED CEILING PLANS AND/OR ON THE JOB SITE BY THE ARCHITECT/ENGINEER REPRESENTATIVES.
- INSTALL CODE APPROVED FUSIBLE LINK FIRE DAMPERS IN ALL DUCTS WHICH PASS THROUGH FAN ROOM WALL, BOILER ROOM WALL, MECHANICAL ROOM WALL, AND ALL FLOORS OR AS INDICATED ON DRAWINGS. WHERE FIRE DAMPERS CANNOT BE CHECKED FROM A REGISTER OR GRILLE, INSTALL AN ACCESS DOOR IN THE DUCT NEXT TO THE DAMPER AND ACCESS PANEL IN ALL NEW ACCESSIBLE CEILINGS.
- UNLESS INDICATED OTHERWISE, THE ARCHITECT/ENGINEER MAKES NO REPRESENTATION AS TO WHETHER OR NOT ANY HAZARDOUS OR CONTAMINATED MATERIALS (INCLUDING BUT NOT LIMITED TO ASBESTOS, PCB'S, CONTAMINATED SOILS, ETC) ARE PRESENT WITHIN THE EXISTING BUILDING OR ON THE SITE. WORK SHOWN ON THE DRAWINGS AND/OR INDICATED IN THE SPECIFICATIONS SHALL NOT BE CONSTRUED TO CALL FOR CONTACT WITH ANY OF THESE MATERIALS. IF THESE MATERIALS ARE ENCOUNTERED OR SUSPECTED, THE CONTRACTOR SHALL NOT DISTURB THEM AND SHALL CONTACT THE ARCHITECT/ENGINEER IMMEDIATELY.
- CONTRACTOR SHALL STORE ALL MATERIALS AND EQUIPMENT SHIPPED TO THE SITE IN A PROTECTED AREA. IF MATERIAL IS STORED OUTSIDE OF THE BUILDING, IT MUST BE STORED OFF THE GROUND A MINIMUM OF SIX INCHES (6") SET ON 6 X 6 PLANKS AND/ OR WOOD PALLETS. ALL MATERIAL AND EQUIPMENT MUST BE COMPLETELY COVERED WITH WATERPROOF TARPIS OR VISQUIN. ALL PIPING AND DUCTWORK WILL HAVE THE ENDS CLOSED TO KEEP OUT DIRT AND OTHER DEBRIS. NO EQUIPMENT WILL BE ALLOWED TO BE STORED ON THE SITE UNLESS IT IS SITTING ON WOOD PLANKS AND COMPLETELY PROTECTED WITH WEATHERPROOF COVERS.
- SEE LARGE SCALE DRAWINGS (DETAILS) FOR ALL REQUIRED VALVES, FITTINGS, GAUGES, VENTS, THERMOMETERS WHICH ARE CONNECTED TO FINNED TUBE RADIATION (FTR), AIR HANDLING UNITS (AHU), CABINET UNIT HEATERS (CUH), SUSPENDED UNIT HEATERS (SUH), HOT AND CHILLED WATER COILS, EXPANSION TANKS (ET), AIR SEPARATORS (AS), PUMPS, ETC. ALL WORK SHOWN ON DETAILS SHALL BE BY INSTALLING CONTRACTOR UNLESS OTHERWISE NOTED.
- ALL AUTOMATIC MOTORIZED DAMPERS SHALL BE FURNISHED BY BAS CONTRACTOR (EXCEPT FOR DAMPERS FURNISHED WITH PACKAGED AIR HANDLING UNITS AND PROVIDED WITH POWER ROOF EXHAUST FANS) AND INSTALLED BY MECHANICAL CONTRACTOR. ALL DAMPER MOTORS FURNISHED AND INSTALLED BY BAS CONTRACTOR
- MECHANICAL CONTRACTOR SHALL PROVIDE ON SITE SCHOOLING OF OWNERS OPERATING PERSONNEL FOR ALL SYSTEMS AND EQUIPMENT INSTALLED UNDER HIS CONTRACT.
- BEFORE STARTING ANY SYSTEM INSTALLING, CONTRACTOR SHALL CONTACT EQUIPMENT MANUFACTURER TO VERIFY THAT EACH PIECE OF EQUIPMENT OR SYSTEM HAS BEEN CHECKED FOR PROPER LUBRICATION, DRIVE ROTATION, BELT TENSION, CONTROL SEQUENCE OR OTHER CONDITIONS WHICH MAY CAUSE DAMAGE TO THE EQUIPMENT OR SYSTEM.
- MECHANICAL CONTRACTOR TO FURNISH AND INSTALL ALL GAS REGULATORS ON THE LEAVING SIDE OF THE GAS METER. EACH GAS REGULATORS WILL HAVE A VENT PIPE WHICH TERMINATES 18" ABOVE THE ROOF WITH A GOOSENECK.
- MECHANICAL CONTRACTOR SHALL INSTALL ALL WELLS IN PIPING FOR MOUNTING OF BUILDING AUTOMATION SYSTEM CONTROLS AND MECHANICAL CONTRACTOR'S THERMOMETERS AND GAUGES. MECHANICAL CONTRACTOR WILL COORDINATE THE EXACT LOCATION OF BUILDING AUTOMATION SYSTEM CONTRACTOR'S CONTROLS WITH HIM PRIOR TO INSTALLING WELLS.
- MECHANICAL CONTRACTOR SHALL RUN INSULATED DRAIN PIPES FROM ALL HEATING/COOLING FAN COIL UNITS AND UNIT VENTILATORS. SEE DRAWINGS AND DETAILS FOR LOCATION OF TERMINATION OF DRAIN PIPING. ALL CONDENSATE DRAIN PIPES MUST BE PITCHED AWAY FROM THE DRAIN PAN. ALL CONDENSATE DRAIN PIPES WILL BE INSULATED FROM UNIT TO TERMINATION POINT.
- MECHANICAL CONTRACTOR SHALL INSTALL DRAIN PIPING FROM ALL BUILT-UP AIR HANDLING UNITS. DRAIN PIPE WILL BE RUN FROM UNIT DRAIN PAN TO NEAREST FLOOR DRAIN.
- THE MECHANICAL CONTRACTOR TO PROVIDE 1/4 INCH SCALE PIPING AND DUCTWORK DRAWINGS FOR COORDINATION WITH OTHER TRADES. DRAWINGS TO INDICATE DIMENSIONS AND ELEVATIONS OF ALL PIPING AND DUCTWORK. DRAWINGS TO ALSO INCLUDE ALL WALL/FLOOR/ROOF OPENINGS.
- MECHANICAL CONTRACTOR TO PROVIDE SCHEDULE OF CURB INSTALLATION/REMOVAL ON EXISTING ROOF AREAS TO CONTRACTOR FIVE (5) WORKING DAYS IN ADVANCE. ANY REVISIONS TO THIS SCHEDULE RESULTING IN UN-PATCHED ROOF TIE-INS AND DAMAGE TO EXISTING CONDITIONS SHALL BE REPAIRED BY MECHANICAL CONTRACTOR AT NO ADDITIONAL COST TO THE OWNER.
- ALL PIPE PASSING THRU WALLS SHALL HAVE A GALVANIZED SHEET METAL OR SCHEDULE 40 STEEL PIPE SLEEVE INSTALLED AROUND THE PIPE AND PIPE INSULATION. SEE SLEEVE DETAILS THESE DRAWINGS.
- INSTALL A SHEET METAL SLEEVE AROUND ANY DUCTWORK WHICH GOES THROUGH WALL CONSTRUCTION. PACK FIBERGLAS INSULATION AROUND SLEEVE AND DUCT AND CAULK WITH FIRE SEAL CAULKING.
- WHEN INSTALLING EXPANSION JOINTS, CONTRACTOR SHALL INSTALL A PIPE ANCHOR AT EACH END OF RUN AND PIPE GUIDES A MINIMUM OF EVERY TWENTY-FIVE (25) FEET OR AS CALLED FOR ON THE DRAWINGS. MOUNT THE FIRST PIPE GUIDE LOCATED ON EACH SIDE OF THE EXPANSION JOINT A MINIMUM OF FOUR (4) PIPE DIAMETERS FROM THE EXPANSION JOINT.
- THE DRAWINGS, SCHEDULES AND SPECIFICATIONS HAVE BEEN PREPARED USING ONE MANUFACTURER FOR EACH PIECE OF EQUIPMENT AS THE BASIS FOR DIMENSIONAL DESIGN. IF THE CONTRACTOR PURCHASES EQUIPMENT LISTED AS A SPECIFIED ACCEPTABLE MANUFACTURER BUT IS NOT THE SCHEDULED MANUFACTURER USED FOR THE BASE DESIGN, THE CONTRACTOR SHALL BE RESPONSIBLE FOR CHECKING ALL THE DIMENSIONS OF THE EQUIPMENT TO VERIFY THAT IT WILL FIT IN THE SPACE SHOWN ON THE DRAWINGS. MINOR DEVIATIONS IN DIMENSIONS WILL BE PERMITTED PROVIDED THE RATINGS MEET THOSE SHOWN ON THE DRAWINGS AND EQUIPMENT WILL PHYSICALLY FIT INTO THE SPACE ALLOCATED WITH SUITABLE ACCESS AROUND EQUIPMENT FOR OPERATION AND MAINTENANCE ON THE EQUIPMENT.
- CONTRACTOR AND/OR MANUFACTURER SHALL VERIFY THAT THE CHARACTERISTICS OF THE EQUIPMENT HE SUBMITS FOR REVIEW MEETS THE CAPACITY AND DUTY SPECIFIED.
- WHEN EQUIPMENT IS SUBMITTED FOR REVIEW AND DOES NOT MEET THE PHYSICAL SIZE OR ARRANGEMENT OF THAT SCHEDULED AND SPECIFIED, CONTRACTOR SHALL PAY FOR ALL ALTERATIONS REQUIRED TO ACCOMMODATE SUCH EQUIPMENT AT NO ADDITIONAL COST TO OWNER. CONTRACTOR WILL ALSO PAY ALL COSTS FOR ADDITIONAL WORK REQUIRED BY OTHER CONTRACTORS, OWNER, ARCHITECT OR ENGINEER TO MAKE CHANGES WHICH WOULD ALLOW THE EQUIPMENT TO FIT IN THE SPACE AND FUNCTION AS INTENDED.




AREA OF WORK
NOT IN SCOPE OF WORK

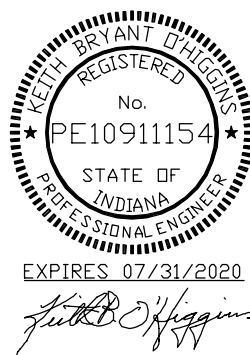

MEFFCO CONSULTANT
(P) 630338396




DUNELAND SCHOOL CORPORATION
2020 NURSE'S OFFICE RENOVATIONS AT:
BAILLY ELEMENTARY SCHOOL
800 S 5TH STREET, CHESTERTON, INDIANA 46304

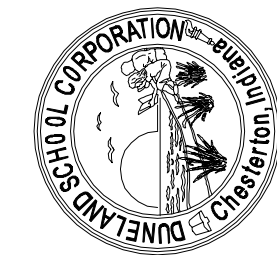

REVISIONS
PROJECT NUMBER: 20-006
PROJECT MANAGER: YS
DESIGN BY: OAS
ISSUED FOR PERMIT: 04/07/2020
PARTIAL EXISTING FLOOR PLAN
MECHANICAL

MO.10

PLotted BY: CAR. FUGER DATE PLOTTED: 4/7/2020 2:44 AM FILE PATH AND NAME: P:\13-D-1 ISS-Bldg. Elementary School Nurse Office Renovation\13-D-1 M1.10

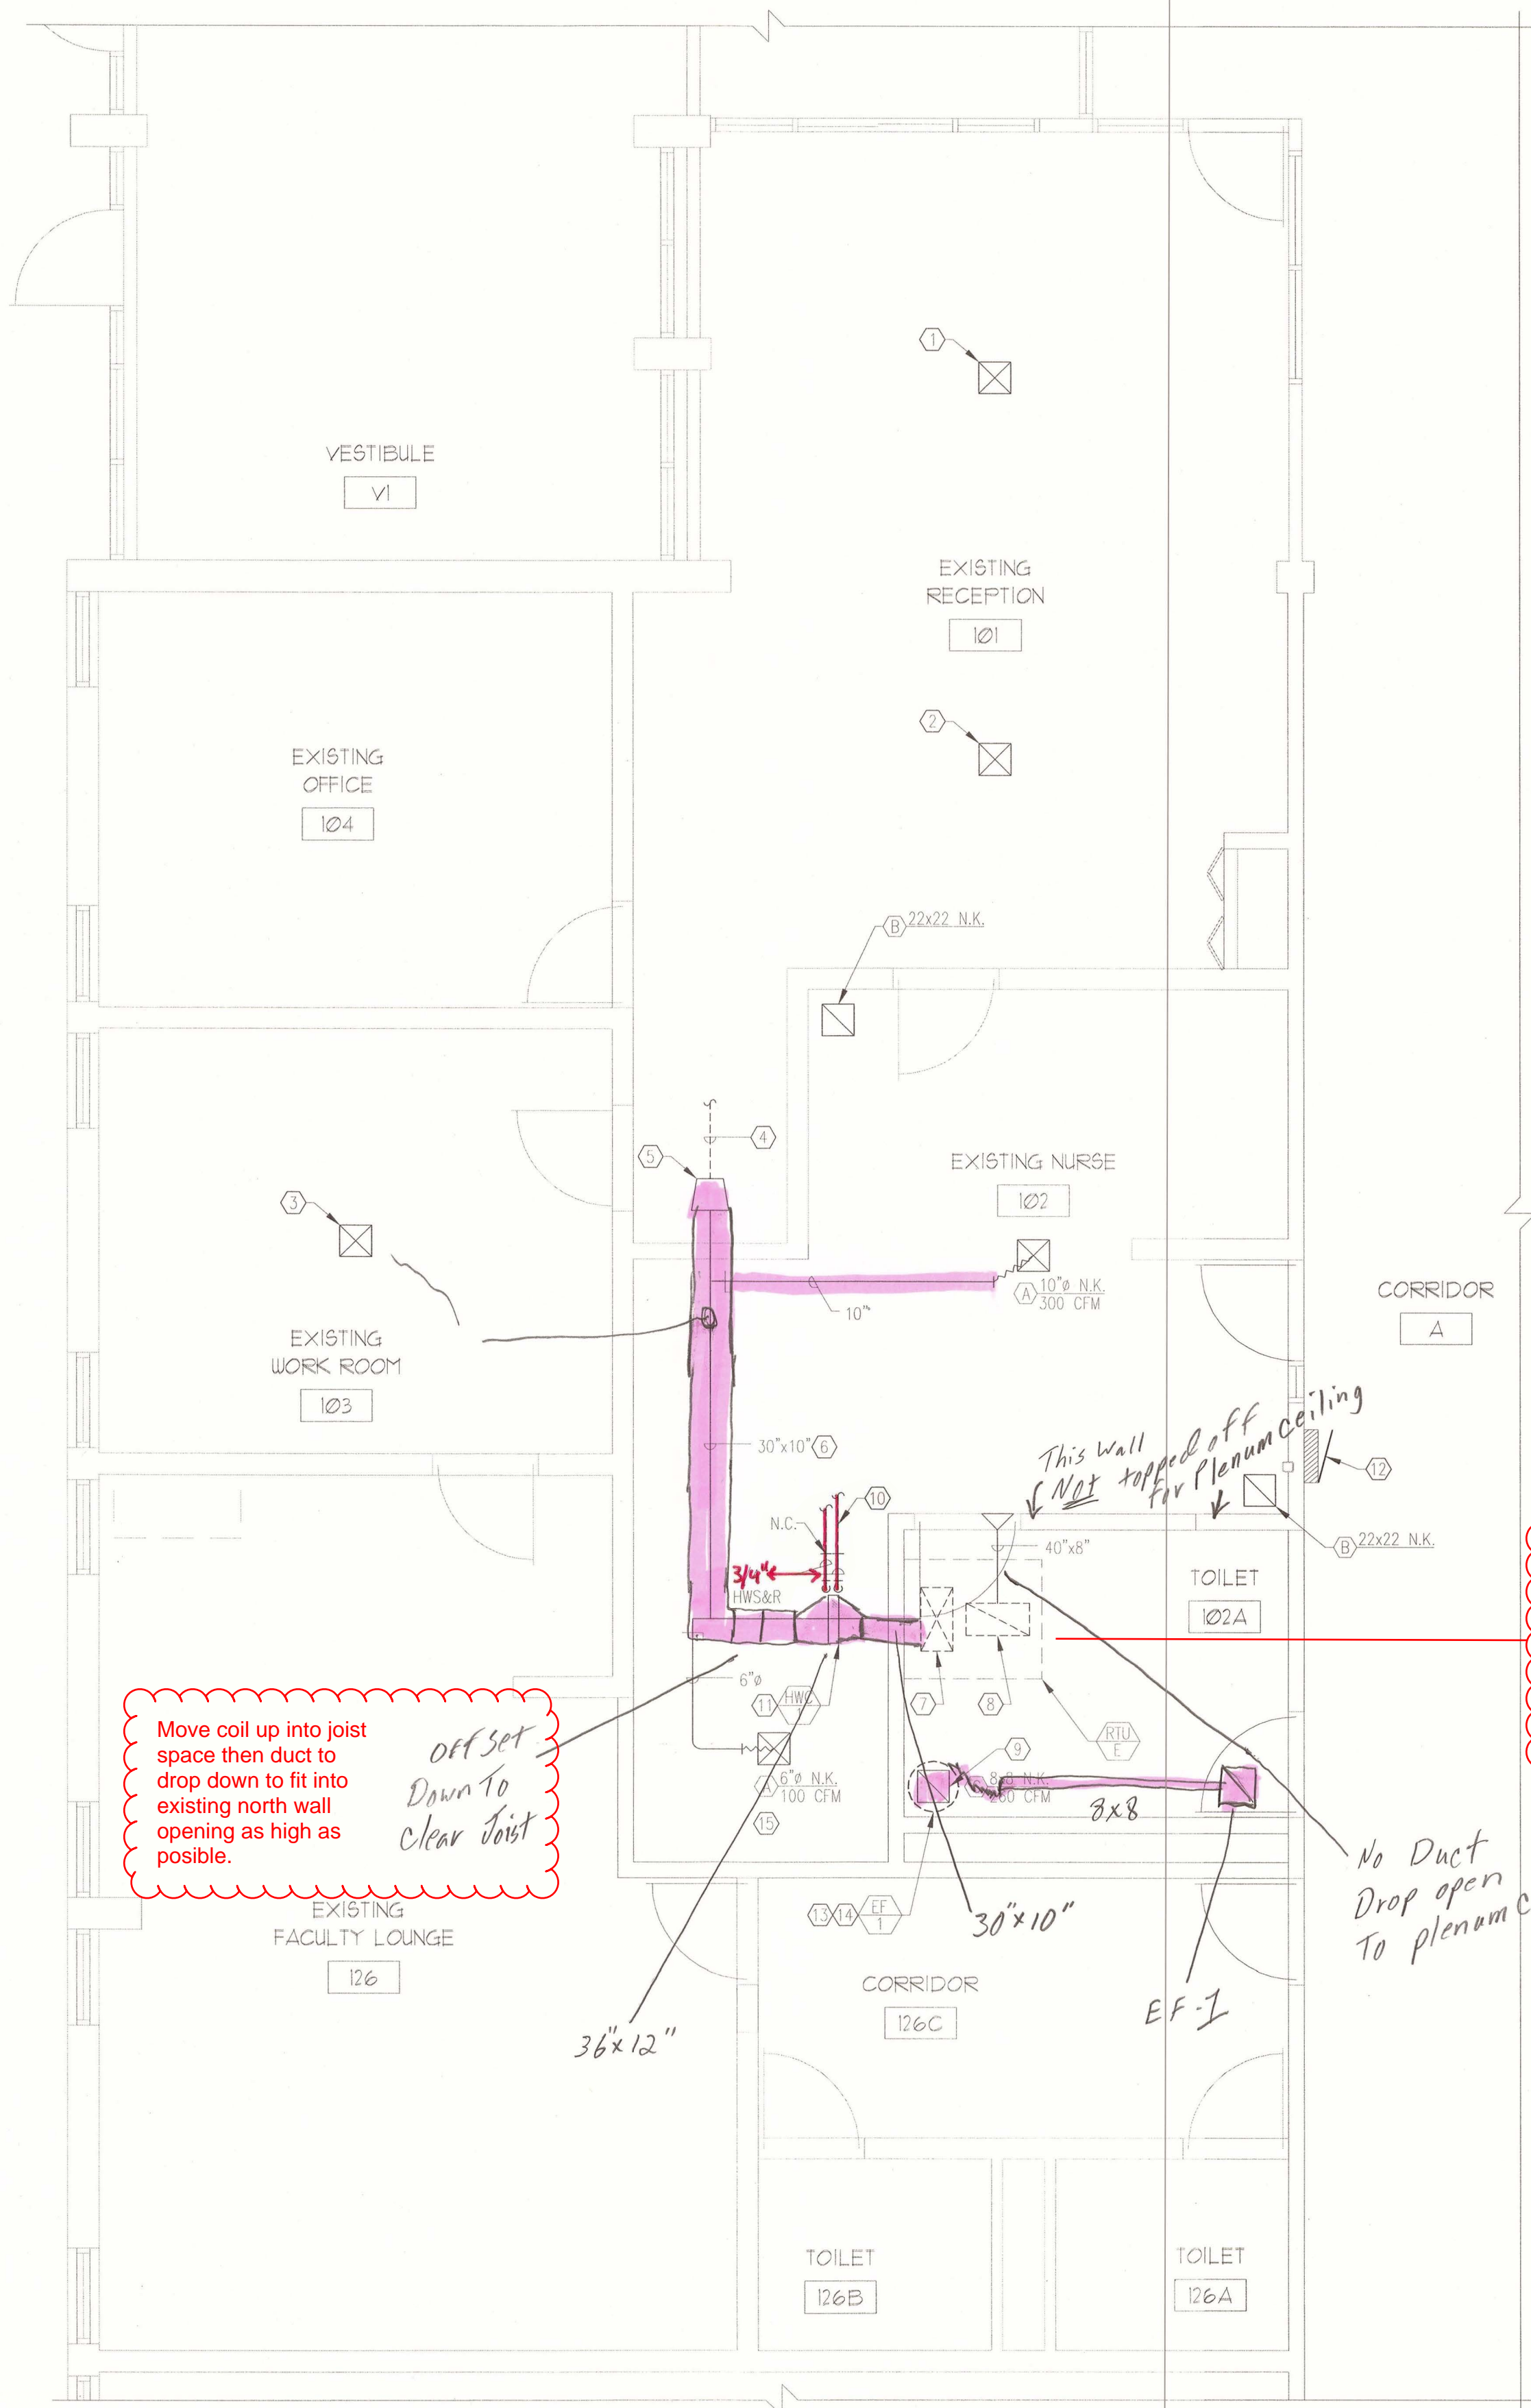

1 PARTIAL FLOOR PLAN - MECHANICAL
1/4" = 1'-0"

DIFFUSER, GRILLE AND REGISTER							NECK SIZE AIR QTY. (CFM)
TAG	MANUFACTURER	MODEL NUMBER	TYPE	SERVICE	MATERIAL	MAXIMUM NC	NOTES
A	TITUS	TMA	LAY-IN	SUPPLY	ALUMINUM	30	1,6
B	TITUS	50F	LAY-IN	RETURN	ALUMINUM	30	5
C	TITUS	35ORS	LAY-IN	EXHAUST	ALUMINUM	30	1,6
NOTES:							
1. OFF-WHITE BAKED ENAMEL FINISH			5. 1/2"x1/2"x1" GRID				
2. FINISH SELECTED BY ARCHITECT			6. OPPOSED BLADE DAMPER				
3. FACE ADJUSTABLE AIR SCOOP DAMPER			7. CONCEALED SURFACE MOUNTED FASTENING				
4. ANODIZED FINISH							

HOT WATER COIL SCHEDULE													
TAG	LOCATION	SERVICE	MANUFACTURER	SIZE (IN.)	ROWS	FINS PER INCH	FACE VELOCITY (FPM)	TOTAL MBH	CFM	MAX. AIR PRESSURE DROP (IN.)	EAT (°F)	LAT (°F)	CFM
HWC-1	NURSE 102	RTU-E	CARRIER	36 x 12	2	14	767	175	2,300	0.57	40.0	95.1	8.9
NOTES:													
1. PROVIDE ACCESS DOOR ON INLET AND OUTLET OF COIL FOR INSPECTION/CLEANING.													
2. FIELD VERIFY EXACT COIL SIZE PRIOR TO ORDERING.													
3. COIL TO BE DRAINABLE.													
4. SEE SPECIFICATIONS AND DETAILS FOR ADDITIONAL REQUIREMENTS.													

MECHANICAL KEY NOTES:	
1	EXISTING DIFFUSER TO BE BALANCED AT 400CFM.
2	EXISTING DIFFUSER TO BE BALANCED AT 300CFM.
3	EXISTING DIFFUSER TO BE BALANCED AT 600CFM.
4	EXISTING 26"x14" SUPPLY DUCT.
5	TIE NEW 30"x10" (ID) TO EXISTING 26"x14" (OD).
6	NEW 30"x10" DUCT TOP TO BE TIGHT TO UNDERSIDE OF JOISTS TO ENABLE CEILING TO BE RAISED.
7	MODIFY EXISTING SUPPLY DROP TO TRANSITION TO 30"x10" DUCT. TOP OF DUCT TO BE TIGHT TO UNDERSIDE OF JOIST.
8	MODIFY EXISTING RETURN DROP TO TRANSITION TO 40"x8" DUCT TIGHT TO BOTTOM OF JOIST. RETURN TO BE OPEN TO CEILING PLENUM.
9	8"x8" EXHAUST DUCT UP THRU ROOF TO EF-1.
10	TIE NEW 3/4" HWS & R INTO EXISTING; ABOVE CEILING AND RUN TO NEW HWC-1.
11	NEW HOT WATER HEATING COIL HWC-1. EXISTING CONTROLS TO CONTROL HOT WATER COIL AS PREVIOUSLY PROGRAMMED. BOTTOM OF DUCT SHALL BE FLAT. TOP OF DUCT TO RISE INTO JOIST SPACE FOR COIL INSTALLATION.
12	RELOCATED JCI CONTROL PANEL/ BOX. INSTALL ABOVE CEILING IN CORRIDOR. EXTEND ALL WIRING/ CABLE AS REQUIRED. CONTROLS TO BE BY JCI, CALUMET CITY, IL. CONTACT MARY PULLO @ 708-828-3421; NO SUBSTITUTIONS.
13	PROVIDE ON-OFF CONTROL OF EF-1 THROUGH JCI DDC CONTROL SYSTEM. PROGRAM TO WATCH EXISTING EF CONTROL STRATEGY.
14	FURNISH AND INSTALL EF-1 DOWN BLAST ROOF EXHAUST FAN ON 18" MANUFACTURER'S CURB. MANUFACTURER: GREENHECK MODEL: GDRD-10 CAPACITY: 2500CFM @ 0.375"SP ELECTRICAL: 120V, 1PH, 1/10HP ACCESSORIES: A. GRAVITY BACK DRAFT DAMPER B. FACTORY DISCONNECT SWITCH C. 18" CURB
15	COORDINATE FINAL LOCATION OF THIS DIFFUSER WITH LIGHTING AND CURTAIN TRACK MOUNTING ON CEILING.

CHANGE ORDER INFORMATION:
Change Order Number: 001

Date: August 6, 2020

MEP Revisions at Nurse Area

AS-BUILT

KEYPLAN
NOT TO SCALE

AREA OF WORK
NOT IN SCOPE OF WORK

PROJECT NUMBER: 10-006
PROJECT MANAGER: YG
DRAWN BY: OLS
ISSUED FOR PROPOSAL: 04/07/2020
PARTIAL FLOOR PLAN - MECHANICAL


REGISTERED PROFESSIONAL ENGINEER
No. PE10911154
STATE OF ILLINOIS
EXPIRES: 07/31/2020
J. B. Hoffman

M1.10

FILE PATH AND NAME: P:\139-D-1 DSC Bldg Elementary School Nurse Office Renovation\139-D-1 D-1 D10 existing first floor plan

DATE PLOTTED: 4/6/2020 5:30 PM

PLOTTED BY: CARL FUGEL

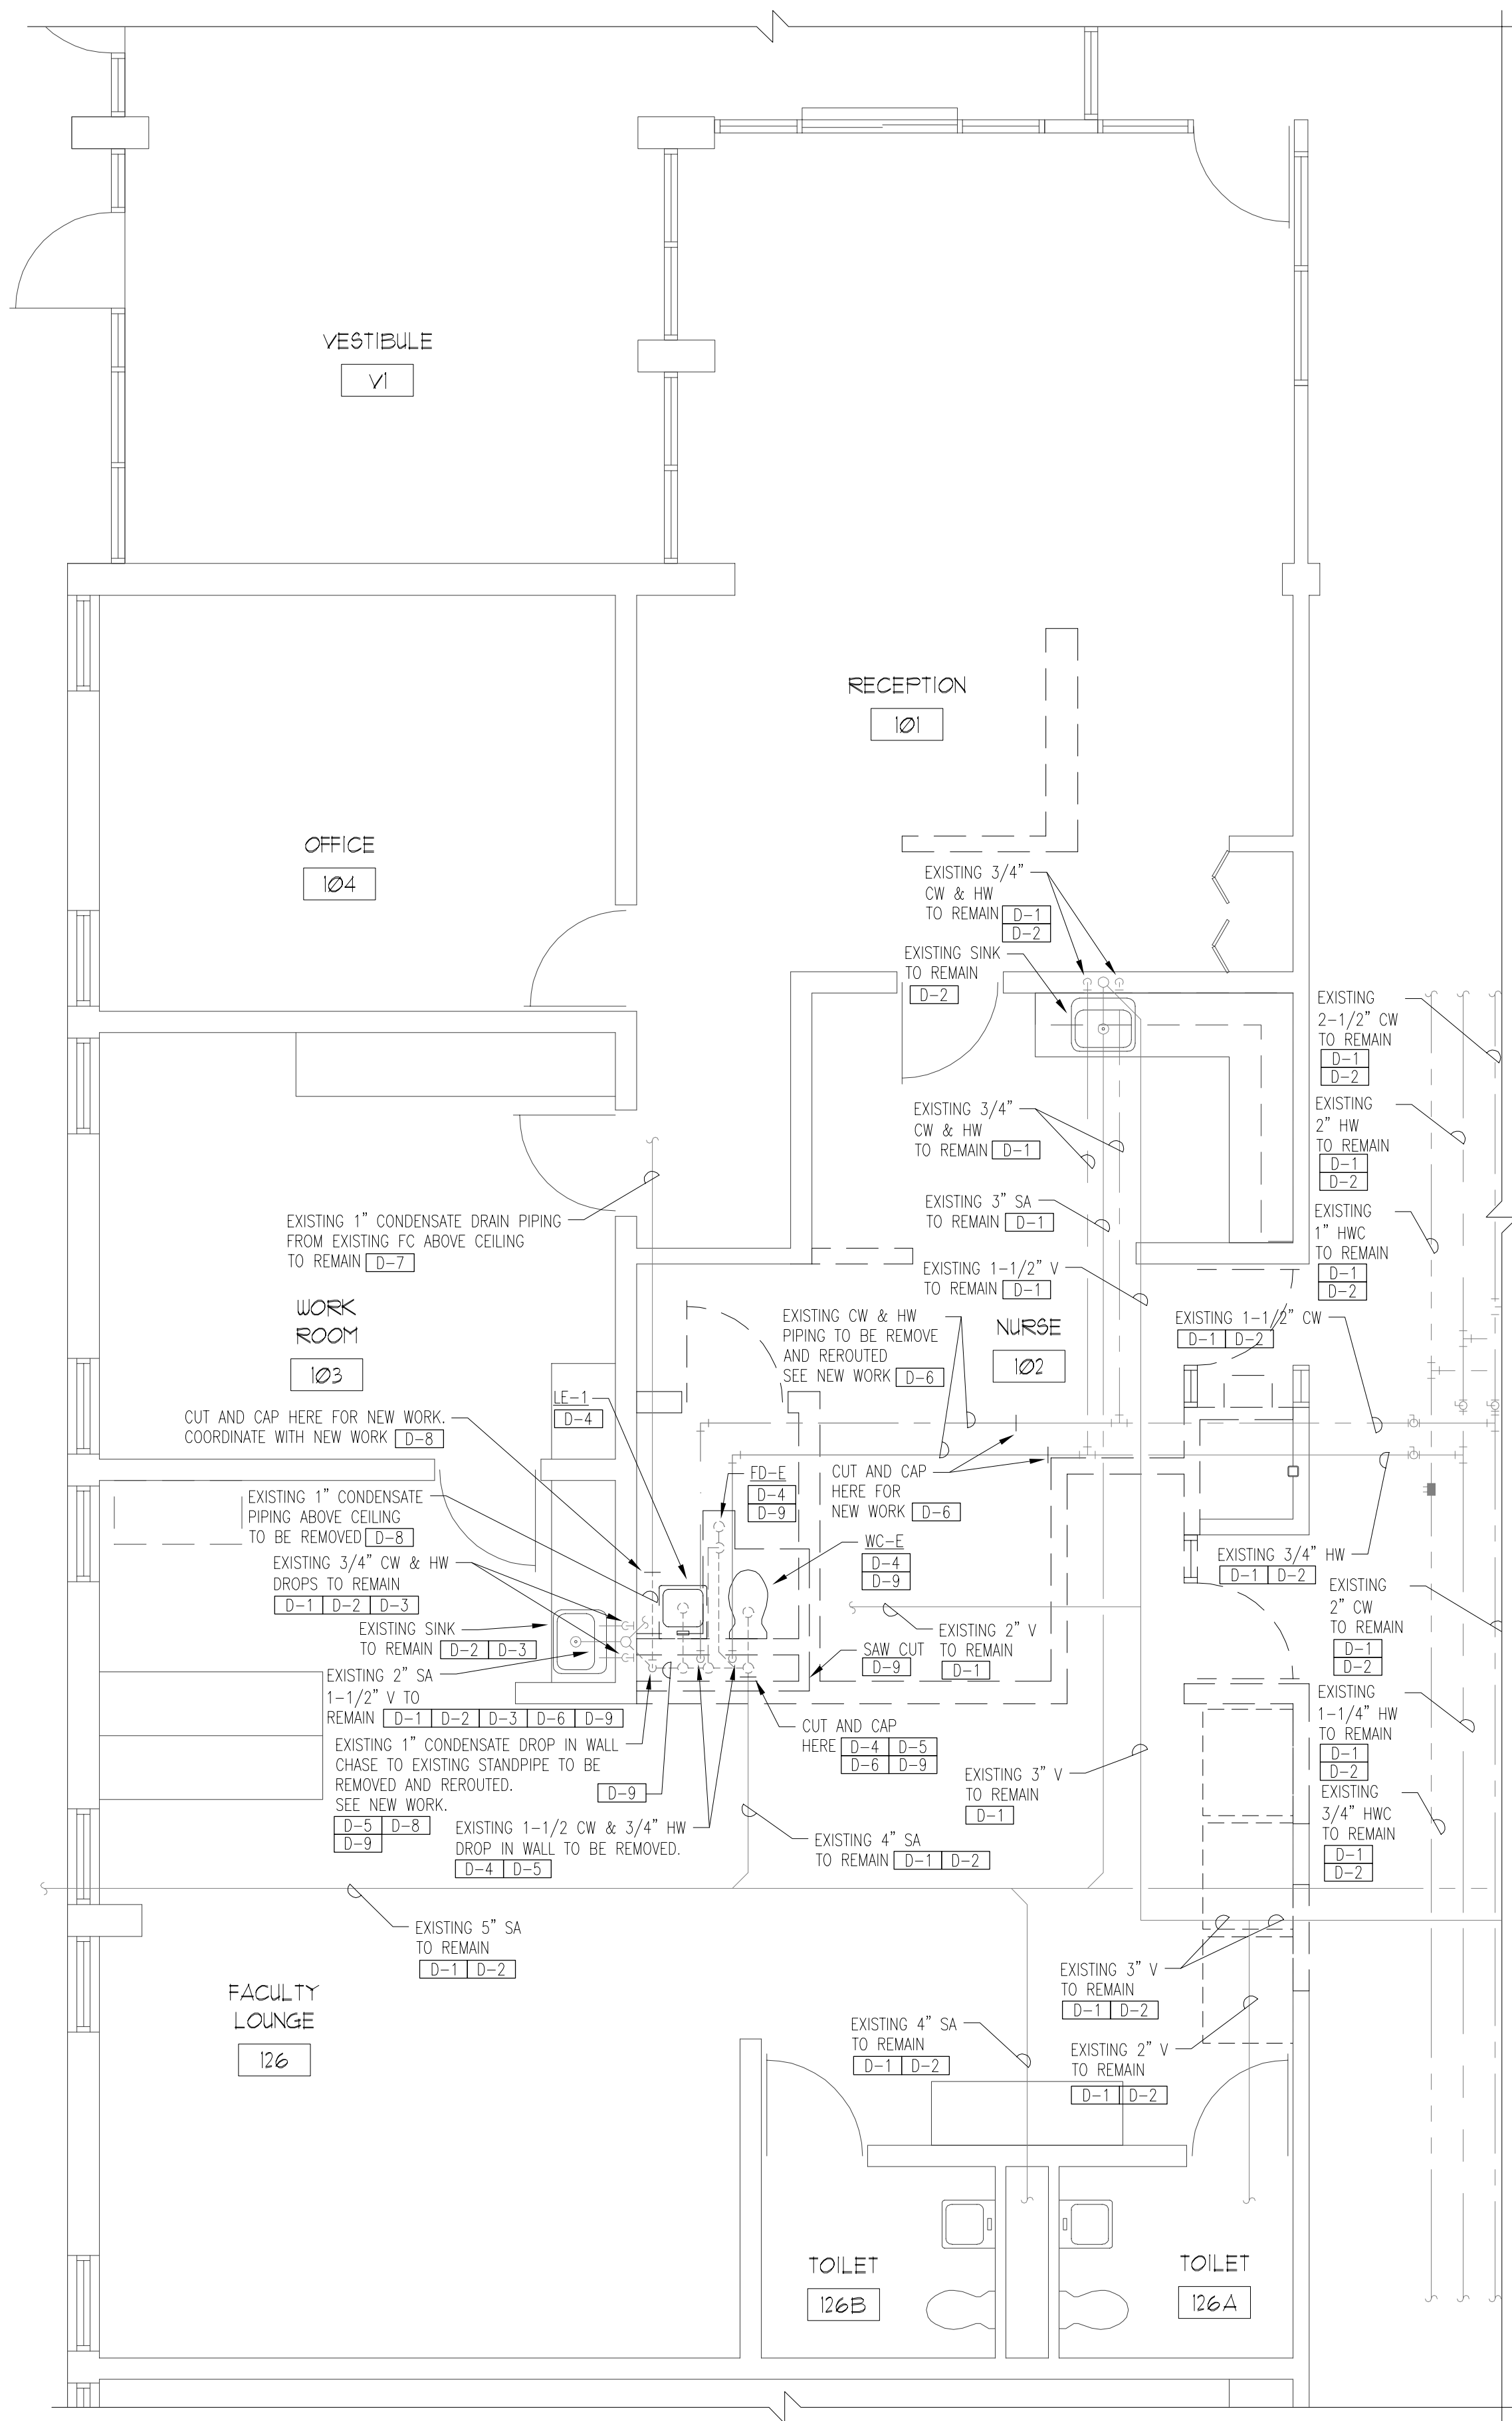

GENERAL NOTES

1. CONTRACTOR TO INSULATE ALL NEW PIPING AND CONNECTIONS PER INDIANA ENERGY CONSERVATION CODE.
2. ALL NEW DOMESTIC WATER PIPING TO BE DISINFECTED PER THE INDIANA PLUMBING CODE AND AHJ.
3. CONTRACTOR TO FIELD VERIFY LOCATION OF ALL SANITARY, VENT, AND WATER PIPING PRIOR TO WORK.
4. CONTRACTOR TO VERIFY NO CONDUIT OR PIPING ARE IN SAW CUT AREAS PRIOR TO SAW CUTTING FLOORS OR WALLS.
5. CONTRACTOR IS RESPONSIBLE FOR ANY CEILING, WALL, OR FLOOR REMOVAL / REPLACEMENT REQUIRED BY NEW WORK. PATCH TO MATCH.
6. CONTRACTOR IS RESPONSIBLE FOR ALL CUTTING, PATCHING, AND PAINTING FOR INSTALLATION OF NEW WORK. SEE ARCHITECTURAL FOR MORE INFORMATION.
7. ALL PLUMBING, NEW AND EXISTING, AFFECTED BY THIS WORK MUST BE COMPLIANT TO INDIANA PLUMBING CODE AND AHJ. IN THE EVENT OF CONFLICT BETWEEN CODES AND DRAWINGS, THE CODES SHALL BE FOLLOWED.
8. CONCRETE FLOOR SLAB NEEDS TO BE REMOVED AS REQUIRED TO PROVIDE WORK INDICATED - FOR BOTH EXISTING AND NEW DRAWINGS.
9. ALL NEW PIPING MUST BE COORDINATED WITH MECHANICAL, ELECTRICAL, FIRE PROTECTION, ARCHITECTURAL, STRUCTURAL, CIVIL, AND EQUIPMENT.
10. ENSURE NO DEAD ENDS REMAIN IN SANITARY, WATER, OR VENT SYSTEM AFTER PIPING HAS BEEN REMOVED. ENSURE COMPLIANCE TO INDIANA PLUMBING CODE AND AHJ.
11. ALL PLUMBING VENT TERMINALS SHALL BE A MINIMUM OF 12'-0" AWAY FROM ANY INTAKE AS PER INDIANA PLUMBING CODE AND AHJ.

DEMOLITION NOTES:

- D-1** CONTRACTOR IS TO LOCATE AND IDENTIFY EXISTING SA, VENT, CW, HW, HWC PIPING BEFORE START OF WORK. IDENTIFY PIPING LOCATIONS, DROPS, CONNECTION, VALVES, SIZES, CONDITION, AND DIRECTION OF FLOW.
- D-2** EXISTING TO REMAIN.
- D-3** EXISTING FIXTURE TO REMAIN. EXISTING SA AND VENT TO REMAIN. CAP EXISTING SA FOR RECONNECTION TO NEW. EXISTING CW & HW DROPS IN WALL ARE TO REMAIN. TIE NEW CW & HW INTO EXISTING DROPS IN WALL. SEE NEW WORK.
- D-4** EXISTING FIXTURES ARE TO BE REMOVED IN THEIR ENTIRETY. CUT AND CAP SA BELOW FLOOR. PATCH FLOOR TO MATCH. CUT AND CAP VENT TO MAIN. CUT AND CAP CW & HW PIPING BACK TO AREA INDICATED. ENSURE NO DEAD ENDS EXIST. ENSURE COMPLIANCE TO INDIANA PLUMBING CODE AND AHJ.
- D-5** REMOVE ALL EXISTING SA, VENT, CW, & HW PIPING IN WALLS TO BE REMOVED.
- D-6** REMOVE EXISTING SA, VENT, CW, OR HW TO AREA INDICATED. COORDINATE WITH NEW WORK. ENSURE NO DEAD ENDS EXIST.
- D-7** EXISTING CONDENSATE PIPING ABOVE CEILING TO REMAIN. VERIFY LOCATION SIZE AND CONDITION. CAP FOR RECONNECTION TO NEW.
- D-8** EXISTING CONDENSATE PIPING AND DROP IN WALL CASE TO STAND PIPE IS TO BE REMOVED AND RELOCATED. COORDINATE WITH NEW WORK. SEE NEW WORK.
- D-9** PLUMBING CONTRACTOR TO VERIFY LOCATION OF EXISTING SANITARY / STORM / VENT / CONDUIT OR OTHER PIPING UNDER FLOOR PRIOR TO FLOOR CUTTING. COORDINATE ALL FLOOR CUTTING WITH EQUIPMENT AND OWNER.

1 PARTIAL EXISTING FLOOR PLAN - PLUMBING
1/4" = 1'-0"




KEY PLAN
NOT TO SCALE

AREA OF WORK
NOT IN SCOPE OF WORK




P0.10

DUNELAND SCHOOL CORPORATION
2020 NURSE'S OFFICE RENOVATIONS AT:
BAILLY ELEMENTARY SCHOOL
800 S 5TH STREET, CHESTERTON, INDIANA 46304

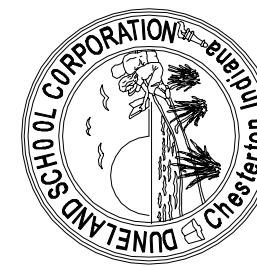


PROJECT NUMBER: 10.000
PROJECT MANAGER: YAG
DRAWN BY: OAS
USED FOR PROPOSAL: 04/07/2020
PARTIAL EXISTING FLOOR PLAN - PLUMBING

MEP/FE CONSULTANT
P 620238756

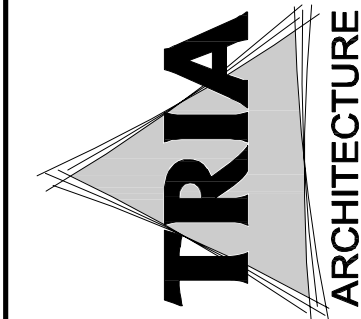

FILE PATH AND NAME: P:\139-D-1 DSC-Bailey Elementary School Nurse Office Renovation\139-D-1 P110 new first floor.dgn
DATE PLOTTED: 4/6/2020 5:31 PM
PLOTTED BY: CARL FUGEL

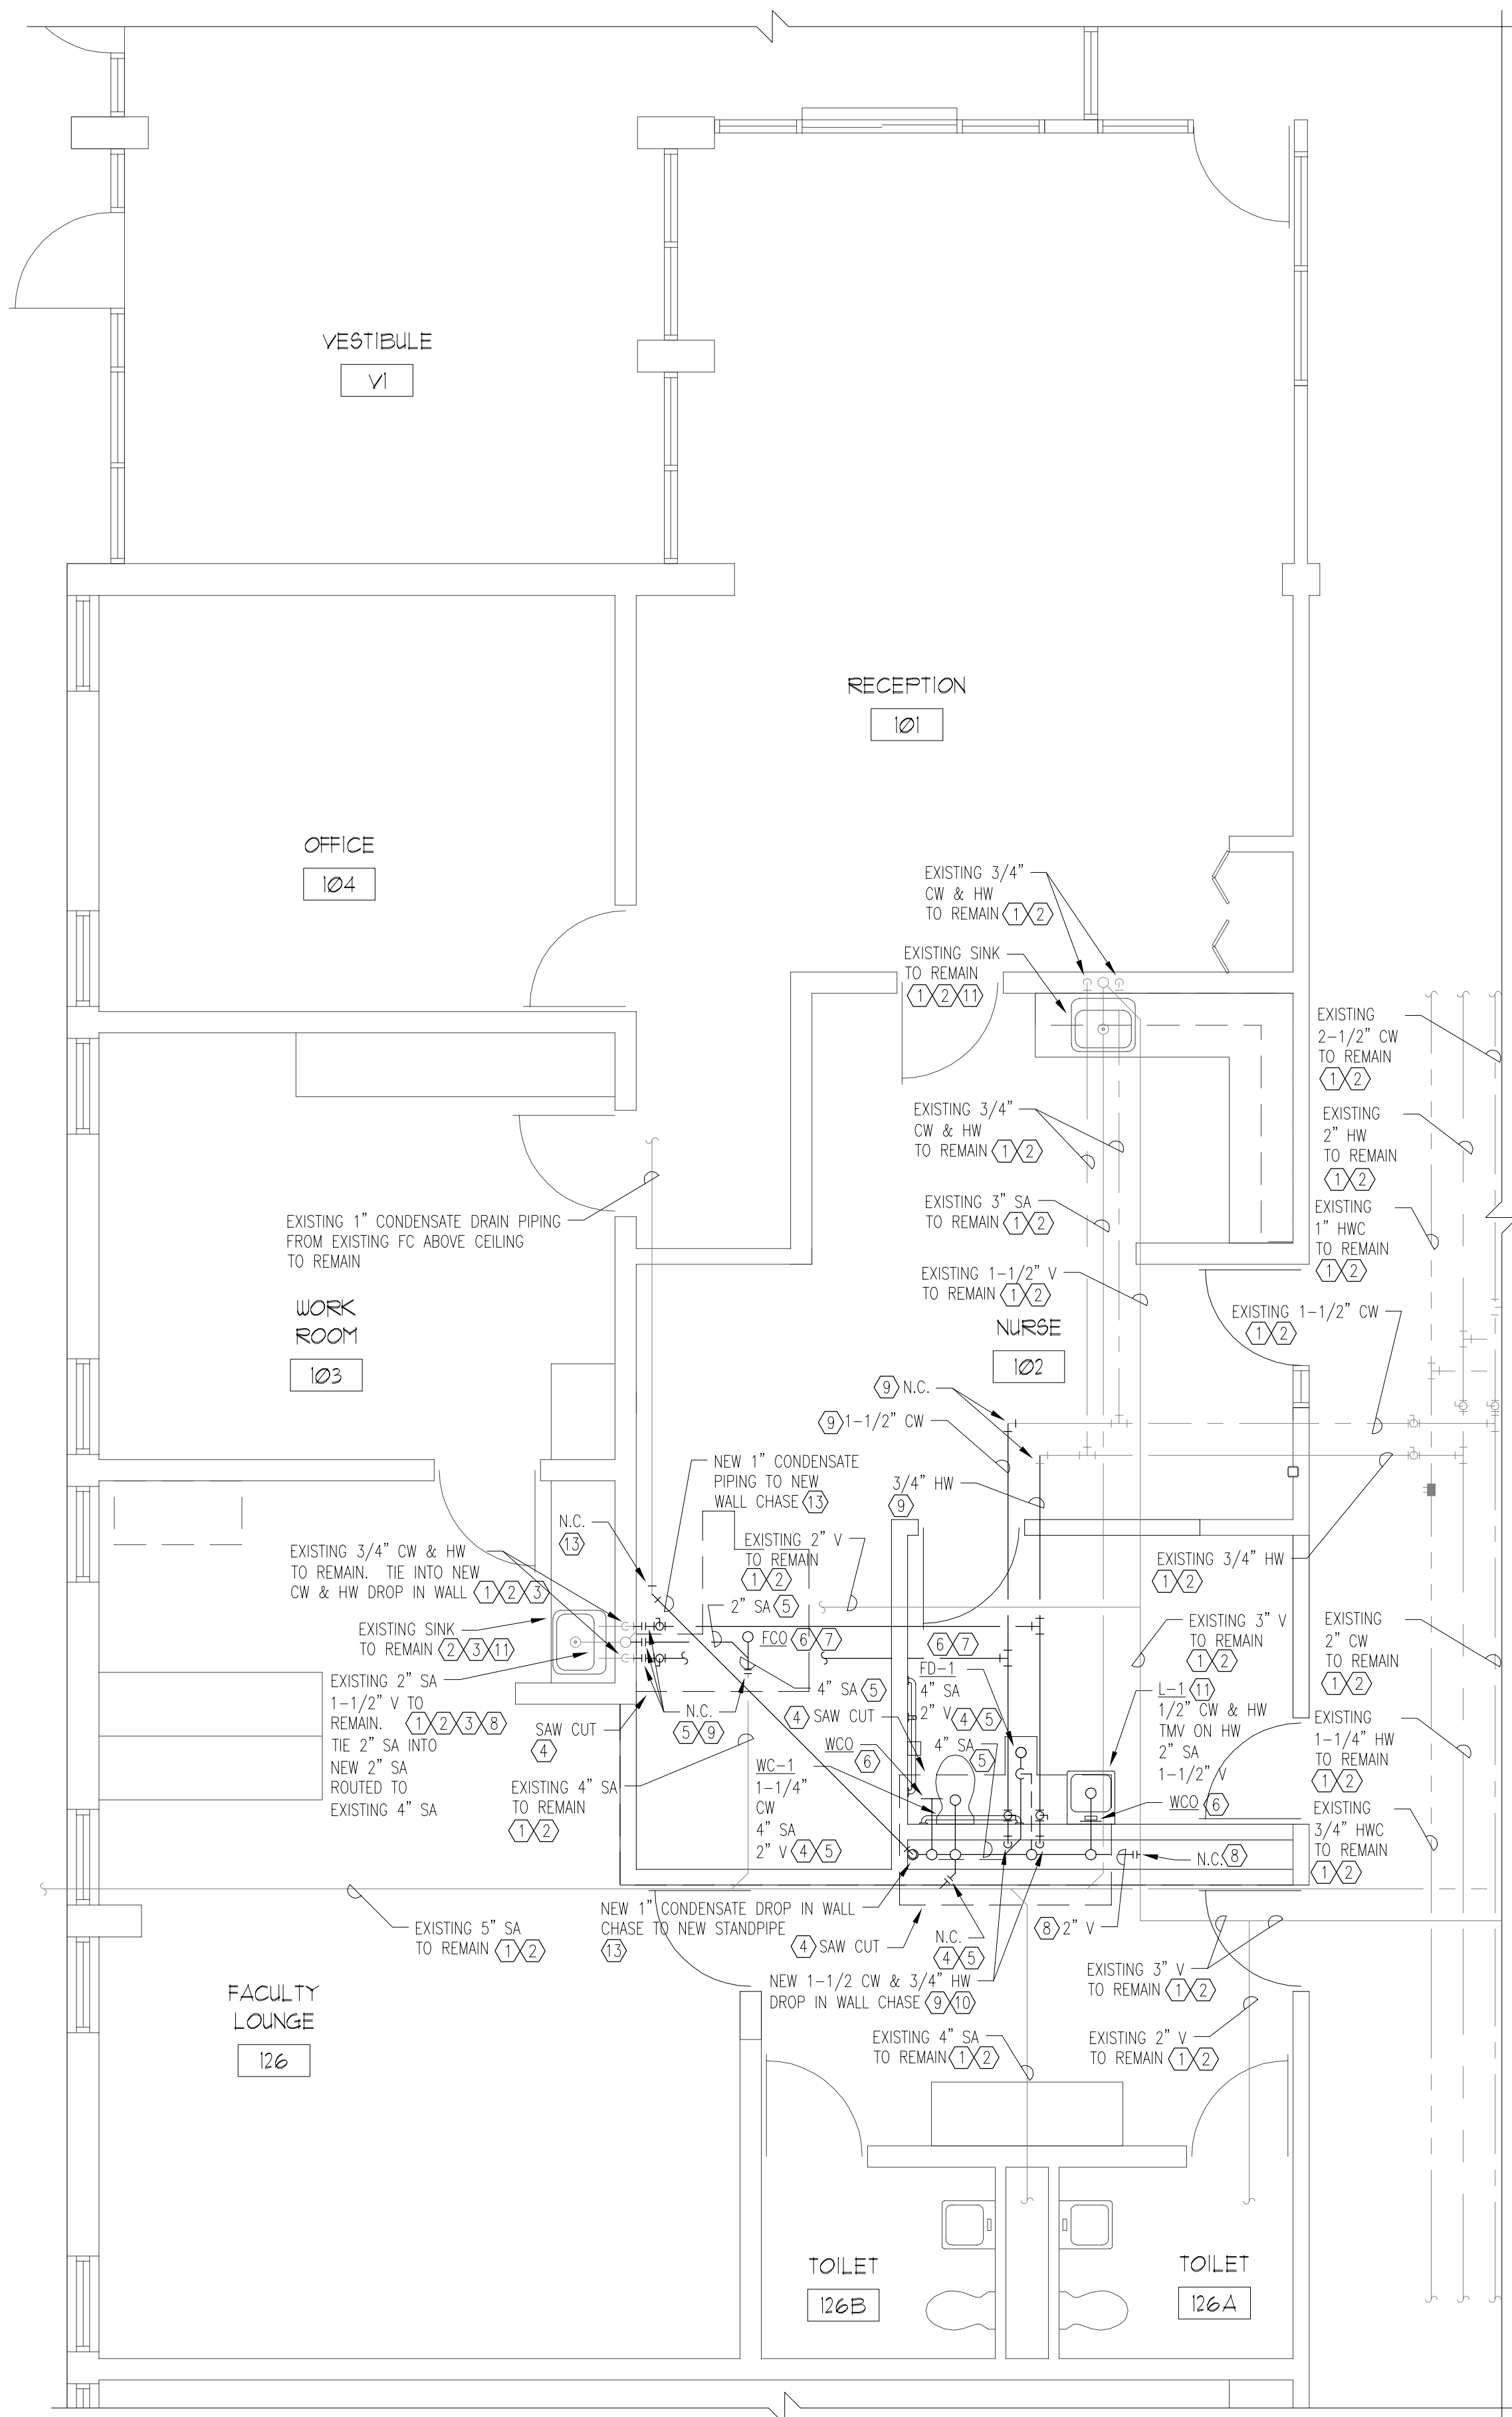

GENERAL NOTES

1. CONTRACTOR TO INSULATE ALL NEW PIPING AND CONNECTIONS PER INDIANA ENERGY CONSERVATION CODE.
2. ALL NEW DOMESTIC WATER PIPING TO BE DISINFECTED PER THE INDIANA PLUMBING CODE AND AHJ.
3. CONTRACTOR TO FIELD VERIFY LOCATION OF ALL SANITARY, VENT, AND WATER PIPING PRIOR TO WORK.
4. CONTRACTOR TO VERIFY NO CONDUIT OR PIPING ARE IN SAW CUT AREAS PRIOR TO SAW CUTTING FLOORS OR WALLS.
5. CONTRACTOR IS RESPONSIBLE FOR ANY CEILING, WALL, OR FLOOR REMOVAL / REPLACEMENT REQUIRED BY NEW WORK. PATCH TO MATCH.
6. CONTRACTOR IS RESPONSIBLE FOR ALL CUTTING, PATCHING, AND PAINTING FOR INSTALLATION OF NEW WORK. SEE ARCHITECTURAL FOR MORE INFORMATION.
7. ALL PLUMBING, NEW AND EXISTING, AFFECTED BY THIS WORK MUST BE COMPLIANT TO INDIANA PLUMBING CODE AND AHJ. IN THE EVENT OF CONFLICT BETWEEN CODES AND DRAWINGS, THE CODES SHALL BE FOLLOWED.
8. CONCRETE FLOOR SLAB NEEDS TO BE REMOVED AS REQUIRED TO PROVIDE WORK INDICATED - FOR BOTH EXISTING AND NEW DRAWINGS.
9. ALL NEW PIPING MUST BE COORDINATED WITH MECHANICAL, ELECTRICAL, FIRE PROTECTION, ARCHITECTURAL, STRUCTURAL, CIVIL, AND EQUIPMENT.
10. ENSURE NO DEAD ENDS REMAIN IN SANITARY, WATER, OR VENT SYSTEM AFTER PIPING HAS BEEN REMOVED. ENSURE COMPLIANCE TO INDIANA PLUMBING CODE AND AHJ.
11. ALL PLUMBING VENT TERMINALS SHALL BE A MINIMUM OF 12'-0" AWAY FROM ANY INTAKE AS PER INDIANA PLUMBING CODE AND AHJ.

KEYED NOTES:


- ① CONTRACTOR IS TO LOCATE AND IDENTIFY EXISTING SA, VENT, CW, HW, HWC PIPING BEFORE START OF WORK. IDENTIFY PIPING LOCATIONS, DROPS, CONNECTION, VALVES, SIZES, CONDITION, AND DIRECTION OF FLOW.
- ② EXISTING TO REMAIN.
- ③ EXISTING FIXTURE TO REMAIN. EXISTING SA AND VENT TO REMAIN. RECONNECT EXISTING SA TO NEW SA. TIE NEW CW & HW INTO EXISTING DROPS IN WALL. WALL MAY NEED TO BE OPENED UP FOR PIPING AND CONNECTIONS. PATCH WALL TO MATCH AND FINISH TO ARCHITECTURAL.
- ④ PLUMBING CONTRACTOR TO VERIFY LOCATION OF EXISTING SANITARY / STORM / VENT / CONDUIT OR OTHER PIPING UNDER FLOOR PRIOR TO FLOOR CUTTING. COORDINATE ALL FLOOR CUTTING WITH EQUIPMENT AND OWNER.
- ⑤ APPROXIMATE LOCATION OF NEW SANITARY PIPING. COORDINATE LOCATION WITH EQUIPMENT, ARCHITECTURAL, STRUCTURAL AND OWNER. CONTRACTOR TO LOCATED EXISTING SANITARY UNDERGROUND AND TIE NEW SANITARY INTO EXISTING. TELEWISE FLOOR AND SAW CUT FLOOR AS REQUIRED.
- ⑥ COORDINATE LOCATION OF WALL CLEANOUTS, FLOOR CLEANOUTS, AND FLOOR DRAINS WITH MECHANICAL, ELECTRICAL, ARCHITECTURAL, STRUCTURAL, EQUIPMENT, AND OWNER.
- ⑦ ALL FLOOR DRAIN COVERS AND FLOOR CLEANOUT COVERS SHALL BE INSTALLED FLUSH TO FINISHED FLOOR.
- ⑧ TIE NEW VENT PIPING INTO EXISTING VENT PIPING. COORDINATE VENT PIPING WITH MECHANICAL, ELECTRICAL, FIRE PROTECTION, ARCHITECTURAL, STRUCTURAL, AND EQUIPMENT. FIELD VERIFY TIE-IN LOCATION.
- ⑨ NEW CW & HW PIPING. TIE INTO EXISTING CW & HW. DROP NEW CW & HW IN NEW WALL CHASE. COORDINATE NEW PIPING WITH MECHANICAL, ELECTRICAL, FIRE PROTECTION, ARCHITECTURAL, STRUCTURAL, AND EQUIPMENT.
- ⑩ TIE NEW FIXTURES INTO NEW CW & HW DROP IN NEW WALL CHASE.
- ⑪ PROVIDE TMV ON HW FOR SINKS AND LAVS.
- ⑫ EXISTING CONDENSATE PIPING ABOVE CEILING TO REMAIN. VERIFY LOCATION SIZE AND CONDITION. CAP FOR RECONNECTION TO NEW.
- ⑬ NEW CONDENSATE PIPING AND DROP IN WALL CASE TO STAND PIPE. COORDINATE WITH MECHANICAL, ELECTRICAL, FIRE PROTECTION, ARCHITECTURAL, STRUCTURAL, AND EQUIPMENT.

**As-Build Drawing
Plumbing
Circle R Mechanical**




KEY PLAN
NOT TO SCALE

AREA OF WORK
NOT IN SCOPE OF WORK

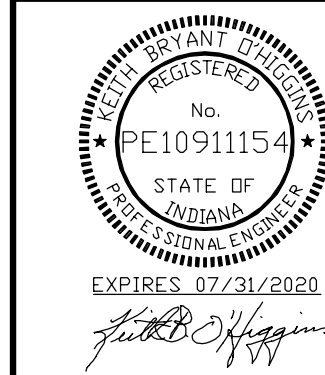


DUNELAND SCHOOL CORPORATION
2020 NURSE'S OFFICE RENOVATIONS AT:
BAILLY ELEMENTARY SCHOOL
800 S 5TH STREET, CHESTERTON, INDIANA 46304

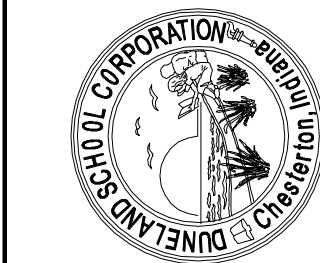


PROJECT NUMBER: 10-006
PROJECT MANAGER: M.G.
DESIGN BY: OAS
ISSUED FOR PROPOSAL: 04/07/2020
PARTIAL NEW FLOOR PLAN - PLUMBING

P1.10

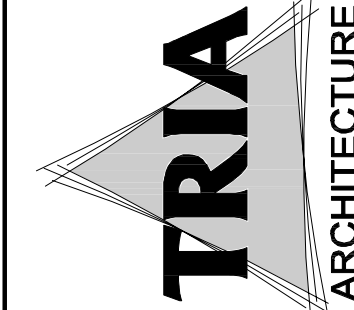



MEP/FP CONSULTANT
P 620538786



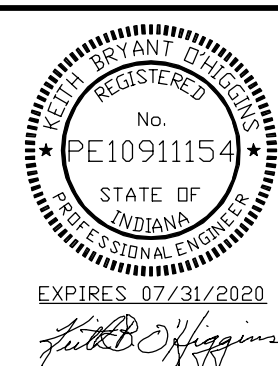

PROJECT NUMBER: 10-006
PROJECT MANAGER: MG
DRAWN BY: OAS
ISSUED FOR PROPOSAL:
04/07/2010
RISER DIAGRAM -
PLUMBING

P2.00

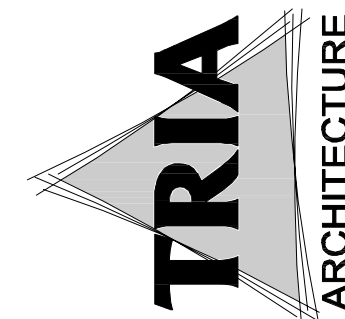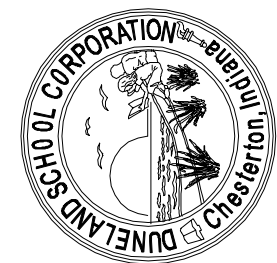

GENERAL NOTES - ALL CONTRACTORS

- A. DRAWINGS ARE GENERALLY DIAGRAMMATIC. ROUTING OF PIPING, DUCTWORK, CONDUITS, RACEWAYS, ETC., AS SHOWN ON DRAWINGS, DOES NOT INTEND TO SHOW EVERY RISE, DROP, OFFSET, FITTING, NOR EVERY STRUCTURAL ELEMENT THAT MAY BE ENCOUNTERED DURING THE INSTALLATION OF THIS WORK. EACH CONTRACTOR SHALL MAKE ANY REQUIRED CHANGES FROM THE GENERAL ROUTING SHOWN ON THESE DRAWINGS, SUCH AS OFFSETS, BENDS OR CHANGES IN ELEVATION DUE TO COORDINATION WITH THE WORK OF OTHER TRADES AND BUILDING CONSTRUCTION. ALL CHANGES SHALL BE MADE WITHOUT ADDITIONAL COST TOT HE OWNER OR DELAY IN COMPLETION DATE OF THE PROJECT.
- B. IT IS INTENDED THAT EQUIPMENT SHALL BE LOCATED SYMMETRICALLY WITH THE ARCHITECTURAL ELEMENTS OF THE BUILDING, NOTWITHSTANDING THE FACT THAT LOCATIONS INDICATED BY THESE DRAWINGS MAY BE DISTORTED FOR CLARNESS OF PRESENTATION.
- C. CONTRACTOR SHALL CHECK DRAWINGS OF OTHER TRADES TO VERIFY THAT SPACES IN WHICH THEIR WORK WILL BE INSTALLED ARE CLEAR OF OBSTRUCTIONS. WORK SHALL BE INSTALLED TO MAINTAIN MAXIMUM HEADROOM AND SPACE CONDITION AT ALL POINTS IN THE BUILDING. WHERE HEADROOM OR SPACE CONDITIONS APPEAR INADEQUATE, CONTRACTOR SHALL NOTIFY ARCHITECT/ENGINEER BEFORE PROCEEDING WITH THE INSTALLATION OF THEIR WORK.
- D. CONTRACTOR SHALL FURNISH OTHER TRADES ADVANCE INFORMATION AND/OR SHOP DRAWINGS ON LOCATIONS AND SIZES OF PIPING, DUCTWORK, CONDUIT, RACEWAYS, EQUIPMENT, FRAMES, BOXES, SLEEVES AND OPENINGS, ETC. NEEDED FOR THEIR WORK TO PERMIT OTHER TRADES AFFECTED TO INSTALL THEIR WORK PROPERLY AND WITHOUT DELAY.
- E. WHERE THERE IS EVIDENCE THAT WORK OF ONE TRADE WILL INTERFERE WITH WORK OF OTHER TRADES, ALL TRADES SHALL MEET ON JOB SITE TO WORK OUT SPACE CONDITIONS AND MAKE SATISFACTORY ADJUSTMENTS TO INSTALLATION OF THE NEW WORK. CONTRACTORS SHALL VERIFY EXACT LOCATIONS OF ALL DEVICES AND EQUIPMENT WITH FIELD CONDITIONS, SHOP DRAWINGS, AND WORK OF OTHER TRADES PRIOR TO ROUGH-IN. EACH CONTRACTOR SHALL BE RESPONSIBLE, AT THEIR OWN EXPENSE, FOR THE REMOVAL AND REINSTALLATION OF ANY PART OF THEIR WORK IF SAME WAS INSTALLED WITHOUT CONSULTING WITH OTHER TRADES BEFORE INSTALLING THEIR WORK.
- F. CONTRACTOR SHALL PROVIDE SLEEVES IN BEAMS, FLOORS, COLUMNS AND WALLS AS SHOWN ON THE DRAWINGS, AS REQUIRED BY JOB SITE CONDITIONS, AND/OR AS SPECIFIED, WHEN INSTALLING THEIR WORK. ALL BEAMS AND COLUMNS WHICH ARE REQUIRED TO BE SLEEVED SHALL BE CUT AND REINFORCED AS REQUIRED BY FIELD CONDITIONS AND LOCATIONS AND SIZES SHALL BE CHECKED AND APPROVED BY ARCHITECT BEFORE CONTRACTOR CUTS AND STRUCTURAL BUILDING MEMBER.
- G. THE SEQUENCE FOR THE INSTALLATION OF ALL WORK SHALL BE COORDINATED BETWEEN ALL CONTRACTORS ON THE PROJECT AND IN STRICT ACCORDANCE WITH ARCHITECT/ENGINEER AND OWNERS STIPULATION AS CALLED FOR IN THE SPECIFICATION AND/OR AS DIRECTED.
- H. CONTRACTOR SHALL REFER TO THE ARCHITECTURAL AND STRUCTURAL CONTRACT DRAWINGS (BEFORE SUBMITTING THEIR BIDS) TO FAMILIARIZE THEMSELVES WITH THE EXTENT OF THE GENERAL CONTRACTORS WORK, CEILING HEIGHTS AND CLEARANCE FOR INSTALLING THEIR WORK.
- I. CONTRACTOR SHALL BE RESPONSIBLE AND PAY FOR ALL CORING, CUTTING, PATCHING, REPAIRING, REFINISHING AND REMOVAL/REPLACEMENT OF NEW OR EXISTING BUILDING CONSTRUCTION REQUIRED TO ACCOMMODATE THE INSTALLATION OR REMOVAL OF THEIR WORK. ALL PATCHING, REPAIRING AND REFINISHING WORK SHALL BE PERFORMED BY THOSE REGULARLY INVOLVED IN THAT TRADE AND SHALL MATCH THE ADJACENT CONSTRUCTION AS CLOSELY AS POSSIBLE. CARE SHALL BE TAKEN SO AS NOT TO DAMAGE ANY EXISTING BUILDING CONSTRUCTION OR ITEMS THAT ARE TO REMAIN. ANY EXISTING BUILDING CONSTRUCTION OR ITEMS THAT ARE TO REMAIN. ANY EXISTING FINISHES THAT ARE DAMAGED DURING THE INSTALLATION OF NEW WORK OR REMOVAL OF EXISTING WORK SHALL BE REPAIRED, REPLACED AND PAID FOR BY THE INSTALLING CONTRACTOR, TO THE SATISFACTION OF THE ARCHITECT AND OWNER. REFER TO ARCHITECTURAL DRAWINGS FOR EXISTING BUILDING CONSTRUCTION THAT IS TO REMAIN AND, THEREFORE, SUBJECT TO PATCHING, REPAIRING, REFINISHING, AND REMOVAL/REPLACEMENT.
- J. SOME OF THE EXISTING ITEMS AND EQUIPMENT SCHEDULED TO BE REMOVED SHALL BE TURNED OVER TO THE OWNER. ANY ITEMS THAT THE OWNER WANTS TO RETAIN SHALL BE REMOVED CAREFULLY SO AS NOT TO DAMAGE THEM. ALL OTHER ITEMS TO BE REMOVED SHALL BECOME THE PROPERTY OF THE CONTRACTOR AND REMOVED FROM THE SITE.
- K. CONTRACTOR SHALL BE RESPONSIBLE FOR THEIR OWN CLEAN-UP DURING CONSTRUCTION. IF CONTRACTOR FAILS TO PROVIDE SUCH CLEAN-UP, THE ARCHITECT/ENGINEER WILL DIRECT ANOTHER CONTRACTOR TO PERFORM THE CLEAN-UP AND THE NEGLIGENT CONTRACTOR SHALL PAY THE ASSOCIATED BACK-CHARGES AS DEEMED APPROPRIATE BY THE ARCHITECT/ENGINEER.
- L. CONTRACTOR SHALL INSTALL ALL AUXILIARY SUPPORTING STEEL AS REQUIRED FOR THE SUPPORTING OF THEIR PIPING, DUCTWORK, CONDUIT, TANKS, EQUIPMENT, ETC. ALL SUPPORTING STEEL FOR ITEMS ABOVE A SUSPENDED CEILING SHALL BE FROM BUILDING STRUCTURAL MEMBERS ONLY.
- M. IT IS MANDATORY THAT THE COMPLETE EXISTING BUILDING REMAIN IN CONTINUOUS AND NON-INTERRUPTED OPERATION DURING REMODELING/ALTERING OF SAID EXISTING BUILDING. THE SPECIFIC AREA(S) BEING REMODELED/ALTERED AT ANY SCHEDULED TIME ARE OBVIOUSLY EXCLUSIVE OF THIS STATEMENT. SERVICES TO EXISTING BUILDING SHALL BE KEPT IN CONTINUOUS OPERATION INCLUDING POWER, SIGNAL SYSTEMS, LIGHTING, TELEPHONE, HEATING, COOLING, VENTILATING, TEMPERATURE CONTROL, SEWERS AND HOT AND COLD WATER. ANY ABSOLUTELY NECESSARY INTERRUPTION OF THESE SERVICES TO ACCOMPLISH CONTRACT WORK SHALL BE ARRANGED THROUGH THE ARCHITECT WITH THE OWNER A MINIMUM OF TEN (10) WORKING DAYS IN ADVANCE. SUCH INTERRUPTIONS SHALL BE KEPT TO AN ABSOLUTE MINIMUM AS FAR AS TIME INTERVAL IS INVOLVED AND TEMPORARY SERVICES SHALL BE FURNISHED AND INSTALLED UNDER THIS CONTRACT WHERE NECESSARY TO ACCOMPLISH THIS PURPOSE. TEMPORARIES SHALL BE REMOVED BY THE CONTRACTOR ONLY AFTER NEW PERMANENT SERVICES ARE INSTALLED AND FULLY OPERATIONAL.
- N. UNLESS INDICATED OTHERWISE, THE ARCHITECT/ENGINEER MAKES NO REPRESENTATION AS TO WHETHER OR NOT ANY HAZARDOUS OR CONTAMINATED MATERIALS (INCLUDING BUT NOT LIMITED TO ASBESTOS, PCB'S, CONTAMINATED SOILS, ETC.) ARE PRESENT WITHIN THE EXISTING BUILDING OR ON THE SITE. WORK SHOWN ON THE DRAWINGS AND/OR INDICATED IN THE SPECIFICATIONS SHALL NOT BE CONSTRUED TO CALL FOR CONTACT WITH ANY OF THESE MATERIALS. IF THESE MATERIALS ARE ENCOUNTERED OR SUSPECTED, THE CONTRACTOR SHALL NOT DISTURB THEM AND SHALL CONTACT THE ARCHITECT/ENGINEER IMMEDIATELY.
- O. CONTRACTOR SHALL STORE ALL MATERIALS AND EQUIPMENT SHIPPED TO THE SITE IN A PROTECTED AREA. IF MATERIAL IS STORED OUTSIDE OF THE BUILDING, IT MUST BE STORED OFF THE GROUND A MINIMUM OF SIX INCHES (6") SET ON 6 X 6 PLANKS AND/OR WOOD PALLETS. ALL MATERIAL AND EQUIPMENT MUST BE COMPLETELY COVERED WITH WATERPROOF TARPS OR VISQUIN. ALL PIPING AND DUCTWORK WILL HAVE THE ENDS CLOSED TO KEEP OUT DIRT AND OTHER DEBRIS. NO EQUIPMENT WILL BE ALLOWED TO BE STORED ON THE SITE UNLESS IT IS SITTING ON WOOD PLANKS AND COMPLETELY PROTECTED WITH WEATHERPROOF COVERS.

- P. THE DRAWINGS, SCHEDULES AND SPECIFICATIONS HAVE BEEN PREPARED USING ONE MANUFACTURER FOR EACH PIECE OF EQUIPMENT AS THE BASIS FOR DIMENSIONAL DESIGN. IF THE CONTRACTOR PURCHASES EQUIPMENT LISTED AS A SPECIFIED **ACCEPTABLE MANUFACTURER** BUT IS NOT THE SCHEDULED MANUFACTURER USED FOR THE BASE DESIGN, THE CONTRACTOR SHALL BE RESPONSIBLE FOR CHECKING ALL THE DIMENSIONS OF THE EQUIPMENT TO VERIFY THAT IT WILL FIT IN THE SPACE SHOWN ON THE DRAWINGS. MINOR DEVIATIONS IN DIMENSIONS WILL BE PERMITTED, PROVIDED THE RATINGS MEET THOSE SHOWN ON THE DRAWINGS AND EQUIPMENT WILL PHYSICALLY FIT INTO THE SPACE ALLOCATED WITH SUITABLE ACCESS AROUND EQUIPMENT FOR OPERATION AND MAINTENANCE ON THE EQUIPMENT.
- Q. CONTRACTOR AND/OR MANUFACTURER SHALL VERIFY THAT THE CHARACTERISTICS OF THE EQUIPMENT HE SUBMITS FOR REVIEW MEETS THE CAPACITY AND DUTY SPECIFIED.
- R. WHEN EQUIPMENT IS SUBMITTED FOR REVIEW AND DOES NOT MEET THE PHYSICAL SIZE OR ARRANGEMENT OF THAT SCHEDULED AND SPECIFIED, CONTRACTOR SHALL PAY FOR ALL ALTERATIONS REQUIRED TO ACCOMMODATE SUCH EQUIPMENT AT NO ADDITIONAL COST TO OWNER. CONTRACTOR WILL ALSO PAY ALL COSTS FOR ADDITIONAL WORK REQUIRED BY OTHER CONTRACTORS, OWNER, ARCHITECT OR ENGINEER TO MAKE CHANGES WHICH WOULD ALLOW THE EQUIPMENT TO FIT IN THE SPACE AND FUNCTION AS INTENDED.
- S. CONTRACTOR SHALL FIELD VERIFY THE SIZE OF EXISTING OPENINGS, WINDOWS, DOORS, CORRIDORS, ROOMS, ETC. FOR ACCESS OF THE NEW EQUIPMENT INTO, OR REMOVAL OF EXISTING EQUIPMENT FROM THE BUILDING. IF OPENINGS ARE TOO SMALL FOR ACCESS THEN CONTRACTOR SHALL, AT HIS OWN EXPENSE, PROVIDE NEW OR ENLARGED OPENINGS AND RESTORE SAME TO ORIGINAL SIZE AND CONDITION. CONTRACTOR MAY ELECT TO ORDER THE EQUIPMENT DISASSEMBLED AND/OR WITH SPLIT HOUSING FOR ENTRANCE INTO THE EXISTING SPACE OR BUILDING. CONTRACTOR SHALL REASSEMBLE EQUIPMENT AFTER IT IS IN THE SPACE AT HIS OWN EXPENSE.

GENERAL NOTES - PLUMBING

- A. ALL WATER SUPPLY AND RETURN PIPING SHALL BE SUSPENDED WITH CLEVIS AND/OR TRAPPEZ PIPE HANGERS. INSULATED PIPING SHALL REST ON STEEL OR WOOD. PIPE COVERING PROTECTION SADDLES OR SHEET METAL INSULATION SHIELDS AS CALLED FOR IN THE SPECIFICATIONS AND/OR DETAILED ON THE DRAWING.
- B. ALL WATER SUPPLY AND RETURN PIPING SHALL BE INSULATED, INCLUDING ALL PIPING ABOVE CEILINGS, INSIDE EQUIPMENT, CABINETS, PIPE CHASES AND IN WALLS. SEE SPECIFICATIONS FOR TYPE AND THICKNESS OF INSULATION.
- C. ALL HOT WATER SUPPLY AND RECIRCULATING PIPING SHALL BE INSTALLED TO COMPENSATE FOR EXPANSION OF THE PIPE BY INSTALLING PIPE ANCHORS, GUIDES, EXPANSION JOINTS OR LOOPS AND PIPE OFFSETS AS REQUIRED BY FIELD CONDITIONS OR AS SHOWN ON THE DRAWINGS.
- D. ALL PIPING PASSING THRU FLOOR CONSTRUCTION SHALL HAVE A SCHEDULE 40 STEEL PIPE SLEEVE INSTALLED AROUND PIPE ONLY. ALL PIPE PASSING THRU WALLS SHALL HAVE A GALVANIZED SHEET METAL OR SCHEDULE 40 STEEL SLEEVE INSTALLED AROUND THE PIPE AND PIPE INSULATION. SEE SLEEVE DETAILS THESE DRAWINGS.
- E. PITCH ALL SUPPLY AND RETURN WATER LINES TO DRAIN COMPLETELY THROUGH LOWER EQUIPMENT FIXTURES, UNIONS, OR DRAIN VALVES. INSTALL A 1/2" DRAIN VALVE WITH 3/4" HOSE THREAD AND VACUUM BREAKER OUTLET IN ALL MAIN PIPING RUNS WHICH WOULD NOT BE ABLE TO DRAIN THRU A LOWER PIECE OF EQUIPMENT.
- F. ALL VENT AND WASTE PIPING SIZES ARE MINIMUM. ADDITIONAL VENTS SHALL BE ADDED AND/OR PIPE SIZE INCREASED AS REQUIRED BY APPLICABLE CODES, STATUTES AND REGULATIONS, ETC. WITHOUT ADDITIONAL COST TO THE OWNER.
- G. UNUSED OPENINGS IN SEWERS, MANHOLES, ETC. SHALL BE CAPPED; THOSE IN PIPING SHALL BE CAPPED OR PLUGGED; STRUCTURAL MEMBERS AND SUPPORTS SHALL NOT BE CUT UNLESS AUTHORIZED BY ARCHITECT IN WRITING.
- H. CERTAIN ABBREVIATIONS OR SYMBOLS, WHEN APPLIED TO PRESENT (OR EXISTING) LINE, DEVICE OR EQUIPMENT, SHALL HAVE THE FOLLOWING MEANINGS.
- NC NEW CONNECTION TO PRESENT PIPING, DEVICE, MANHOLE, SEWER, DUCT, WIRING, EQUIPMENT, ETC. INSTALL, TEST, COVER, PAINT, ETC. SAME AS NEW WORK. IF IN SEWER MANHOLE, PROVIDE FLOW CHANNEL IN BOTTOM.
- VL VERIFY EXACT LOCATION, SIZE, INVERT, ETC. IN FIELD. THIS NOTE APPLIES TO ALL PRESENT OR EXISTING UTILITIES AND CONSTRUCTION WHETHER CALLED FOR OR NOT.

PLUMBING ABBREVIATIONS

NOTE: NOT ALL ABBREVIATIONS SHOWN MAY BE REQUIRED FOR THIS PROJECT.

AC	ABOVE CEILING	PRV	PRESSURE RELIEF VALVE
BV	BALL VALVE	PS	PIPE SLEEVE
BBA	BETWEEN BEAMS ABOVE	RCO	RISER CLEANOUT
BFP	BACKFLOW PREVENTER	SH	SHOWER
BF	BALANCING FITTING	SK	SINK
CI	CAST IRON	SS	SERVICE SINK
CIU	CAST IRON PIPE UNDERGROUND	SSR	SERVICE SINK RECEPTOR
CK	CHECK VALVE	TB	THRUST BLOCK
CO	CLEANOUT	TFA	TO FLOOR ABOVE
CTB	CLOSE TO BOTTOM OF BEAM	TFB	TO FLOOR BELOW
CTC	CLOSE TO CEILING	TMV	THERMOSTATIC MIXING VALVE
DF	DRINKING FOUNTAIN	UR	URINAL
DIP	DUCTILE IRON PIPE	UV	UNDERFLOOR VENT
EW	ELECTRIC WATER COOLER	V42"	VENT LINE RUN OR CONNECTED ABOVE FLOOR BY 42"
FBO	FURNISHED BY OTHERS	VB	VACUUM BREAKER
FCO	FLOOR CLEANOUT	VTR	VENT THROUGH ROOF
FFA	FROM FLOOR ABOVE	W	WASTE
FFB	FROM FLOOR BELOW	WC	WATER CLOSET
GV	GATE VALVE	WCO	WALL CLEANOUT
HV	HOSE VALVE	WH	WALL HYDRANT
INV.	INVERT ELEVATION	WT	WATER THERMOMETER
LAV	LAVATORY	YCO	YARD CLEANOUT

PLUMBING SYMBOLS

NOTE: NOT ALL SYMBOLS SHOWN MAY BE REQUIRED FOR THIS PROJECT.


---	CW	---	COLD WATER SUPPLY
---	HW	---	HOT WATER SUPPLY
---	HWC	---	HOT WATER CIRCULATING
---	CPW	---	CITY PRESSURE COLD WATER
---	WM	---	WATER MAIN
---	SA	---	SUSPENDED SANITARY SEWER
---	ST	---	SUSPENDED STORM SEWER
---	SA	---	UNDERGROUND SANITARY SEWER
---	V	---	SUSPENDED VENT PIPING
---	PD	---	PUMPED DISCHARGE
---		---	LINE ARROW INDICATES DIRECTION OF FLOW
---	PITCH	---	PITCH OF PIPE (DOWN)
---		---	PIPE ELBOW (TURNED UP)
---		---	PIPE ELBOW (TURNED DOWN)
---		---	PIPE TEE DOWN (DROP)
---		---	PIPE TEE UP TO FLOOR ABOVE (RISE)
---		---	PIPE TEE UP OR ANGLE
---		---	PIPE TEE DOWN OR ANGLE
---		---	PIPE TEE HORIZONTAL
---		---	90° ELBOW IN HORIZONTAL PIPE RUN
---		---	ANGLE ELBOW IN HORIZONTAL PIPE RUN
---	NC	---	NEW CONNECTION
---	GV	---	GATE VALVE
---	CK	---	CHECK VALVE
---	BV	---	BALL VALVE
---	BF	---	BALANCING FITTING
---	CS	---	CIRCUIT BALANCING VALVE W/BALANCING PORTS
---	D	---	DRAIN VALVE WITH 3/4" HOSE THREADED OUTLET
---	EJ	---	PIPE EXPANSION JOINT
---		---	PIPE ANCHOR
---		---	PIPE FLEXIBLE CONNECTION
---	PG	---	PIPE ALIGNMENT GUIDE
---	PS	---	PIPE SLEEVE
---	UN	---	PIPE UNION
---	STR	---	STRAINER
---		---	ECCENTRIC REDUCER OR INCREASER
---	PG	---	PRESSURE GAUGE AND NEEDLE VALVE
---	WT	---	WATER THERMOMETER (WITH PIPE WELL)
---		---	THERMOMETER WELL
---	C	---	CLEANOUT IN SUSPENDED CEILING
---	FCO	---	FLOOR CLEANOUT
---	FD	---	FLOOR DRAIN (ROUND)
---	HV	---	HOSE VALVE

P-1	PLUMBING STACK No.	RISER DIAGRAM TAG
	RISER DIAGRAM DRAWING No.	

PLUMBING FIXTURE SCHEDULE					
FIXTURE TAG	FIXTURE		TRIM		NOTES:
	MANUFACTURER	MODEL	MANUFACTURER	MODEL	
FCO	J.R. SMITH	MODEL 4021-U	-	-	LACQUERED CAST IRON, TWO PIECE BODY WITH DOUBLE DRAINAGE FLANGE, BRASS GASKETED PLUG AND ACCESSIBLE NICKLE-BRONZE ROUND VANDAL PROOF SERRATED COVER IN UNFINISHED AREAS AND ROUND WITH DEPRESSED COVER TO ACCEPT FLOOR FINISH WITH CARPET MARKERS IN CARPETED FLOOR AREAS.
FD-1	J.R. SMITH	MODEL 2010-A-6-NB	-	-	LACQUERED CAST IRON TWO PIECE BODY WITH DOUBLE DRAINAGE. 6" INCH DIAMETER HEAVY-DUTY NICKEL BRONZE SECURED SQUARE HOLE STRAINER, SEDIMENT BUCKET, VANDAL RESISTANT FASTENERS AND NOT FLASHED.
L-1	KOHLER	KINGSTON K-2005	KOHLER	CORALAIS K-15199-4NDRA	WHITE VITREOUS CHINA, HANDICAPPED WALL HUNG LAVATORY 21-1/4" X 18-1/8" WITH 5" HIGH BACK, 4" CENTERS. MOUNT AT HEIGHT AS INDICATED ON ARCHITECTURAL. ENSURE ADA COMPLIANCE. CHROME PLATED VANDAL RESISTANT COMBINATION SUPPLY FITTING WITH OFFSET GRID STRAINER AND TAILPIECE, CHROME PLATED 17 GAUGE P-TRAP (INSTALLED PARALLEL TO WALL), FAUCET: CORALAIS K-15199-4NDRA SINGLE HANDLE ADA FACUET WITH 0.5 GPM VANDAL RESISTANT AERATOR. PROVIDE 1-1/4" 17 GAUGE BRASS P-TRAP WITHOUT CLEANOUT IN P-TRAP, STRAINER, 17 GAUGE OFFSET DRAIN, CHROME PLATED FLEXIBLE WATER SUPPLIES, QUARTER TURN G2 ANGLE STOPS, TMV, AND OFFSET DRAIN. PROVIDE TMV WATTS LFUSG-B-M2. PROVIDE UNDER SINK PROTECTIVE PIPE COVERING BY TRUBRO FOR P-TRAP, TAIL PEECE, ANGLE STOPS, SUPPLY TUBING, AND TMV AND OFFSET DRAIN. PROVIDE CARRIER. COLOR BY ARCHITECT. NO SUBSTITUTIONS.
TMV	WATTS	LFUSG-B-M2	-	-	LEAD FREE LFUSG-B-M2 THERMOSTATIC MIXING VALVE FOR LAVATORY L-1 AND EXISTING SINKS INDICATED ON SHEET P1.10 - EXISTING SINK IN NURSES 102 AND EXISTING SINK IN FACULTY LOUNGE 126.
WC-1	AMERICAN STANDARD	2257.101 AFWALL	SLOAN	ROYAL 111 SMO-1.28	WALL HUNG WATER CLOSET, ADA COMPLAINT, AFWALL, MILLENNIUM FLOWISE ELONGATED BOWL, VITREOUS CHINA, EVERCLEAN SURFACE. THIS MODEL NUMBER FOR ELONGATED BOWL AND TOP SPUD ONLY. PROVIDE AMERICAN STANDARD BOLT CAP COVERS. PROVIDE WITH BEMIS SEAT MODEL 2155-C1, ANTI-MICROBIAL SEAT WITHOUT COVER, SLOAN ROYAL 111 SMO-1.28 SINGLE FLUSH EXPOSED SENSOR FLUSHOMETER 1.28 GPF, BATTERY POWERED. PROVIDE HANGER. NO SUBSTITUTIONS.
WCO	J.R. SMITH	MODEL 4532-U	-	-	LINE TYPE WITH LACQUERED CAST IRON BODY AND ROUND BRASS GASKETED PLUG AND ROUND STAINLESS STEEL ACCESS COVER SECURED WITH VANDAL PROOF FASTNER.
NOTES: -					




- AREA OF WORK
- NOT IN SCOPE OF WORK

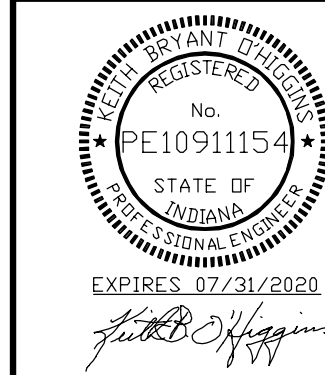

MEP/FP CONSULTANT
P 620338786




DUNELAND SCHOOL CORPORATION
2020 NURSE'S OFFICE RENOVATIONS AT:
BAILLY ELEMENTARY SCHOOL
800 S 5TH STREET, CHESTERTON, INDIANA 46304

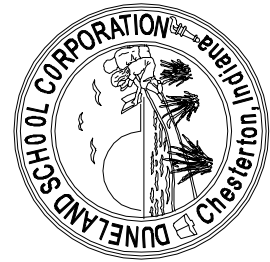

PROJECT NUMBER: 10-006	REVISIONS:
PROJECT MANAGER: YAG	
DRAWN BY: OAS	
USED FOR PROPOSAL: 04/07/2020	
ABBREVIATIONS, NOTES, SCHEDULES AND SYMBOLS - PLUMBING	

P3.00

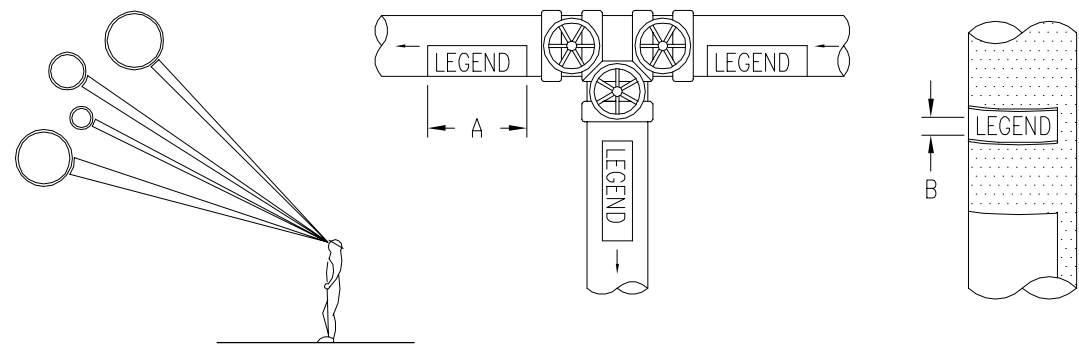


NOTE:
IDENTIFICATION MARKERS OR STRIPS TO BE PLACED ON ALL EXPOSED COVERED AND UNCOVERED PIPES AT 50'-0" INTERVALS AND AT ALL VALVES AND BRANCHES AND ON BOTH SIDES OF WALLS WHERE PIPES PASS THROUGH SAME. ARROWS OF SAME COLOR AS IDENTIFICATION MARKERS SHALL ALSO BE PLACED ON PIPES POINTING AWAY FROM MARKER INDICATING DIRECTION OF FLOW.

SIZE OF LEGEND LETTERS		
OUTSIDE DIAMETER OF PIPE OR COVERING	LENGTH OF COLOR FIELD A	SIZE OF LETTERS B
3/4" TO 1-1/4"	8"	1/2"
1-1/2" TO 2"	8"	3/4"
2-1/2" TO 6"	12"	1-1/4"
8" TO 10"	24"	2-1/2"
OVER 10"	32"	3-1/2"

SERVICE	BACKGROUND OR COLOR BAND	IDENTIFICATION MARKER
CITY WATER	GREEN	WHITE ON GREEN
DOMESTIC COLD WATER	GREEN	WHITE ON GREEN
DOMESTIC HOT WATER	YELLOW	BLACK ON YELLOW
FIRE PROTECTION (SPRINKLER)	RED	WHITE ON RED
NATURAL GAS	YELLOW	BLACK ON YELLOW
SANITARY DRAIN	GREEN	WHITE ON GREEN
STORM WATER	GREEN	WHITE ON GREEN

1 TYPICAL PIPE IDENTIFICATION MARKERS


NO SCALE

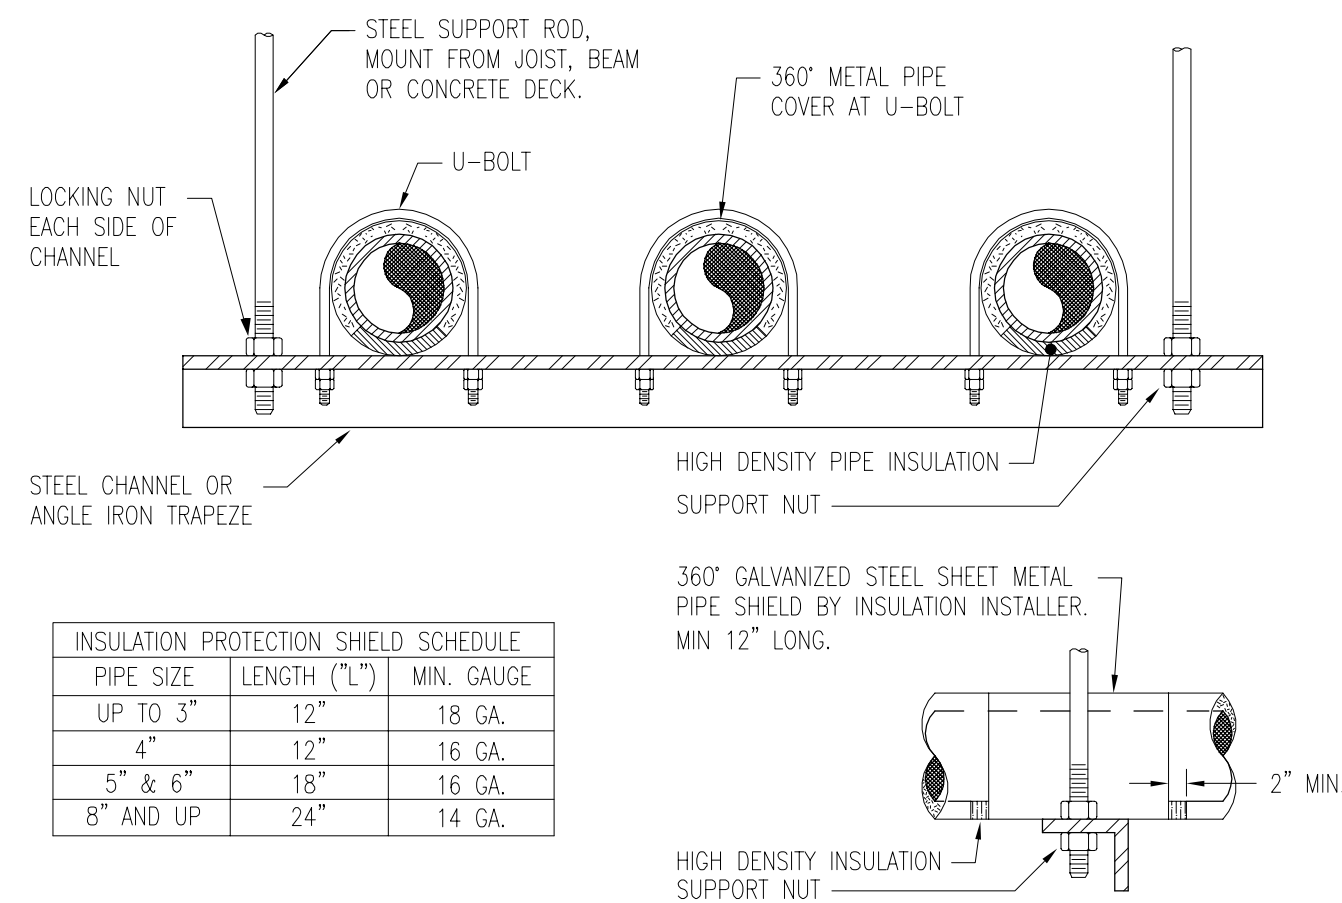

INSULATION PROTECTION SHIELD SCHEDULE		
PIPE SIZE	LENGTH ("L")	MIN. GAUGE
UP TO 3"	12"	18 GA.
4"	12"	16 GA.
5" & 6"	18"	16 GA.
8" AND UP	24"	14 GA.

2 PIPE COVERING PROTECTION SHIELDS AND TRAPEZE HANGER DETAIL



NO SCALE

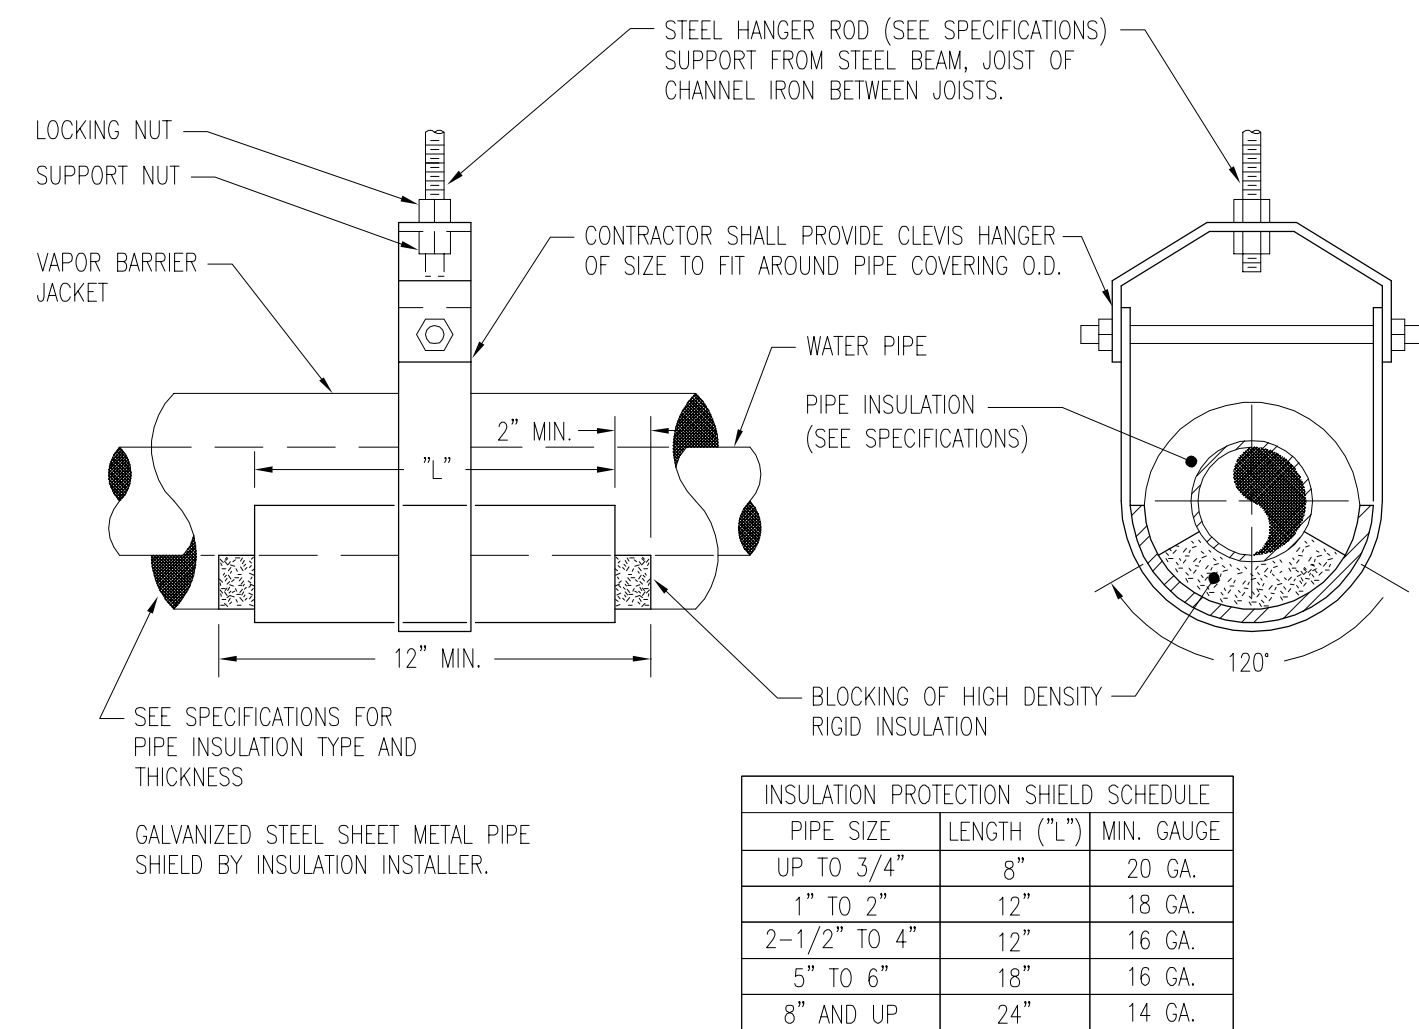

INSULATION PROTECTION SHIELD SCHEDULE		
PIPE SIZE	LENGTH ("L")	MIN. GAUGE
UP TO 3/4"	8"	20 GA.
1" TO 2"	12"	18 GA.
2-1/2" TO 4"	12"	16 GA.
5" TO 6"	18"	16 GA.
8" AND UP	24"	14 GA.

3 PIPE COVERING PROTECTION SHIELDS AND CLEVIS HANGER DETAIL


NO SCALE

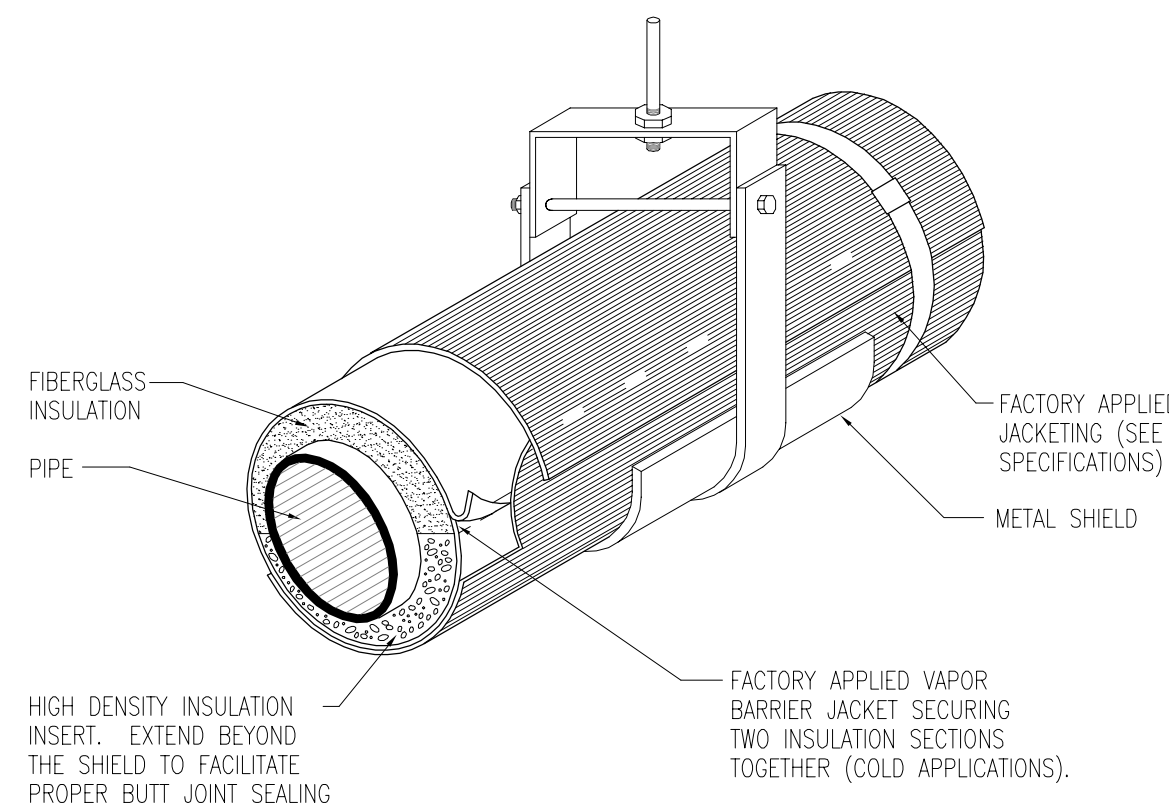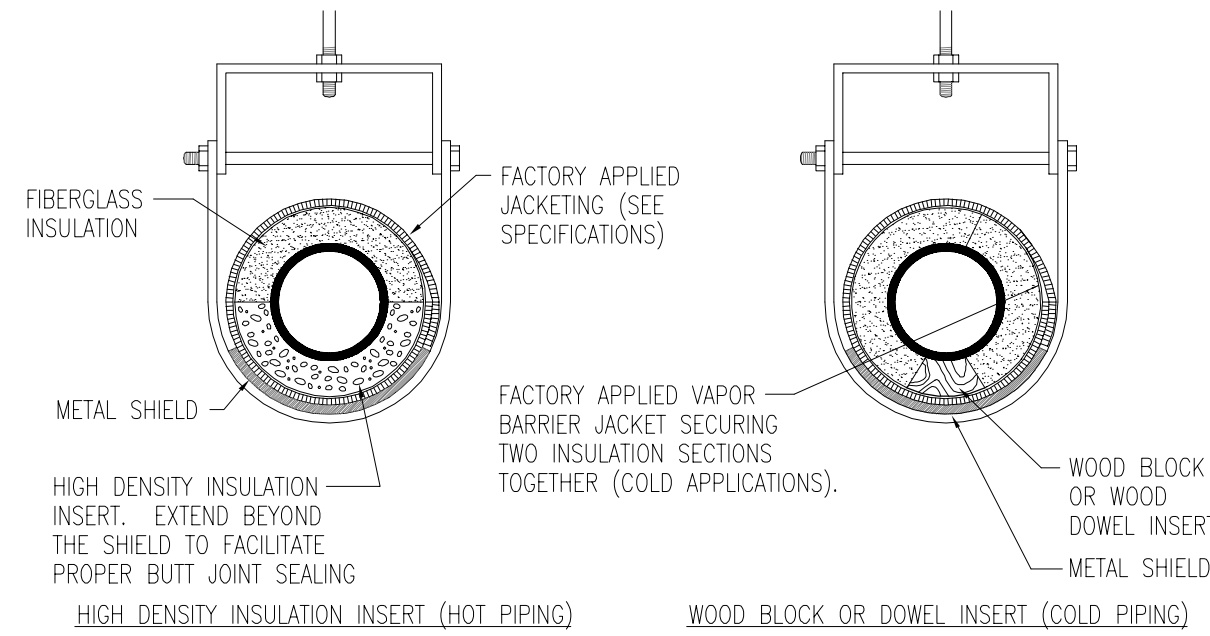

4 CLEVIS HANGER HIGH DENSITY INSERT DETAIL

NO SCALE


NOTE:
NO HORIZONTAL PIPE HANGERS TO BE SPACED FURTHER THAN 10'-0" APART.

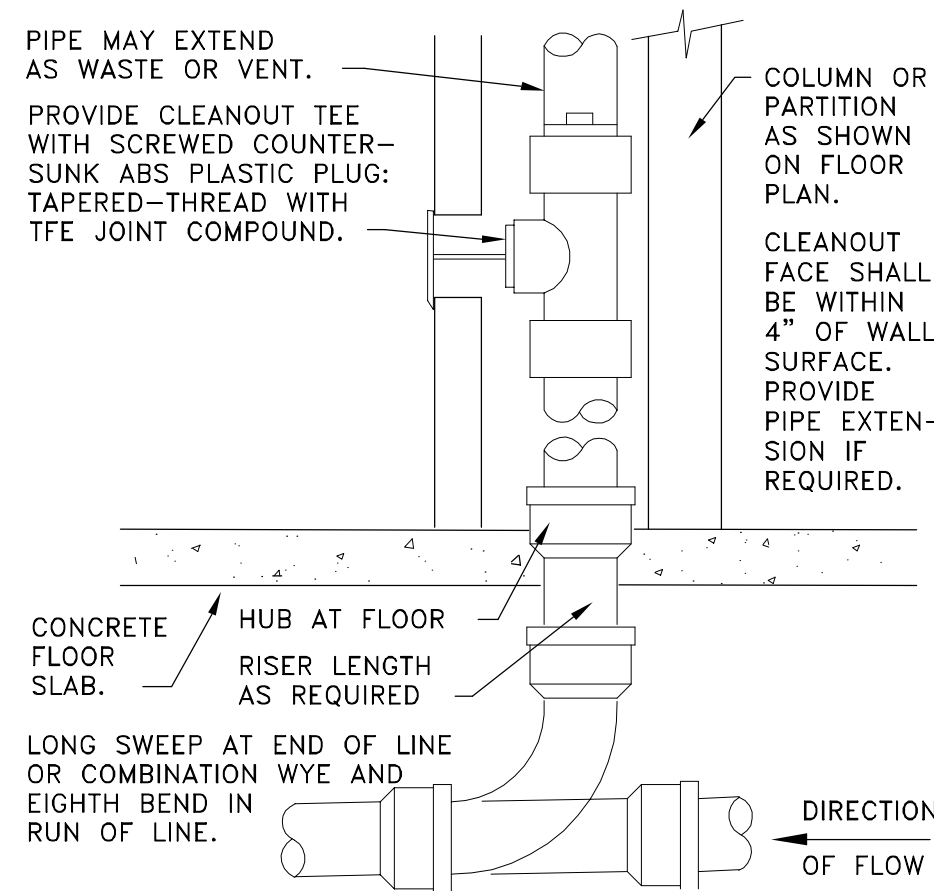

PROVIDE WCO WHERE SHOWN ON PLAN, AND ON SANITARY WASTE BRANCHES NOT SERVED WITH A FLOOR CLEANOUT: LOCATE ABOVE FIXTURE FLOOD RIM WITHIN 4' OF FLOOR.

5 WALL CLEAN OUT DETAIL


NO SCALE

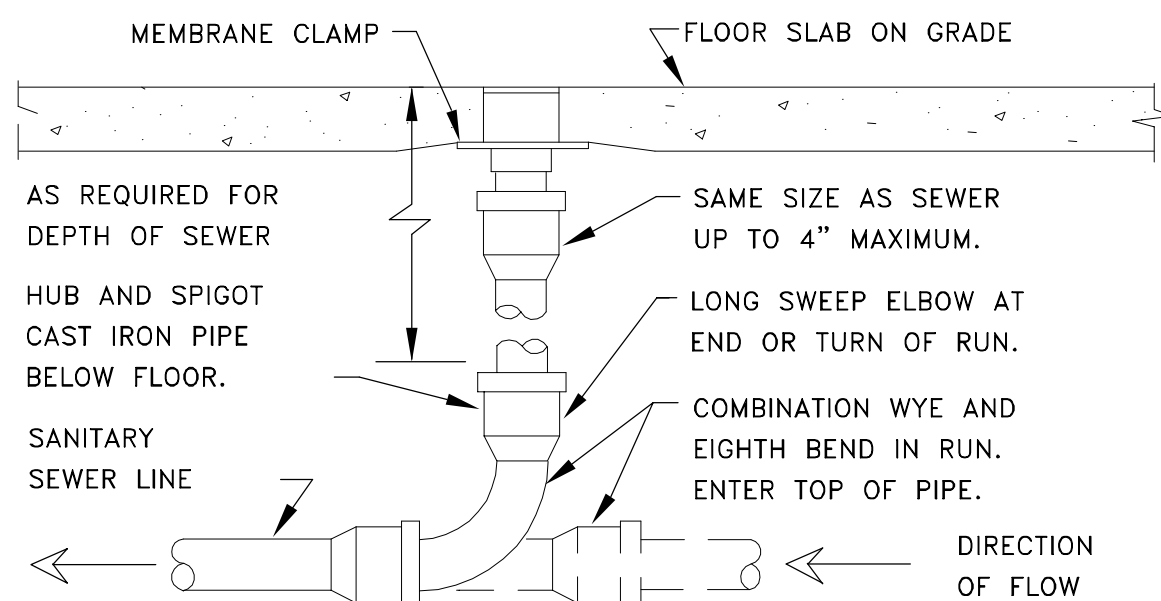

LOCATE AT BUILDING EXIT, AT ENDS OF RUNS, AT TURNS OF PIPE GREATER THAN 45 DEGREES, AT 90° INTERVALS ON STRAIGHT RUNS, AND/OR WHERE SHOWN ON PLANS. LOCATE CLEANOUTS WHERE THERE IS 18" CLEAR AROUND.

6 FLOOR CLEAN OUT DETAIL

NO SCALE

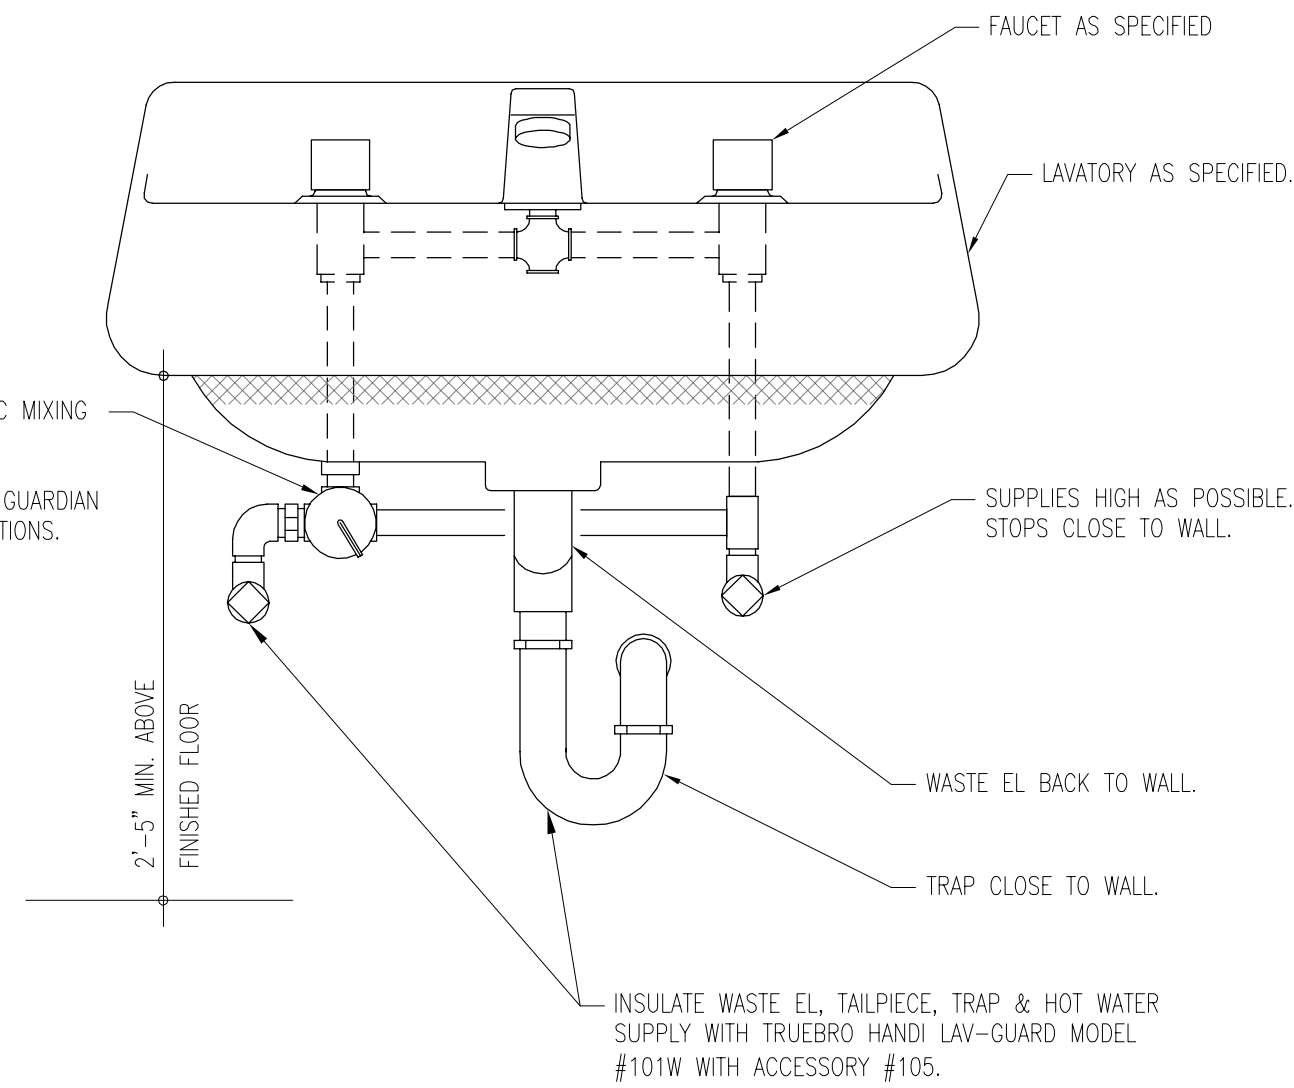


7 LAVATORY AND SINK DETAIL

NO SCALE

CHANGE ORDER INFORMATION:
Change Order Number: 001

Date: August 6, 2020

Upgrade nurse toilet room plumbing
fixtures to hands free
Touch-free, programmable faucet with above-deck electronics
MEP Revisions at Nurse Area

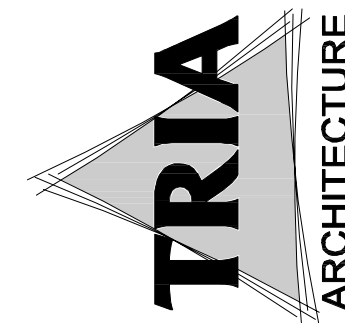

MEP/FP CONSULTANT
P/E 62033878





DOAS

DUNELAND SCHOOL CORPORATION
2020 NURSE'S OFFICE RENOVATIONS AT:
BAILLY ELEMENTARY SCHOOL
800 S 5TH STREET, CHESTERTON, INDIANA 46304



PROJECT NUMBER: 10-006
PROJECT MANAGER: MGS
DESIGN BY: OAS
ISSUED FOR PROPOSAL: 04/07/2020
DETAILS - PLUMBING

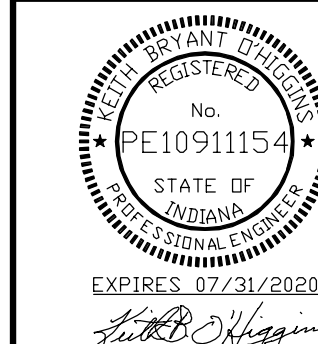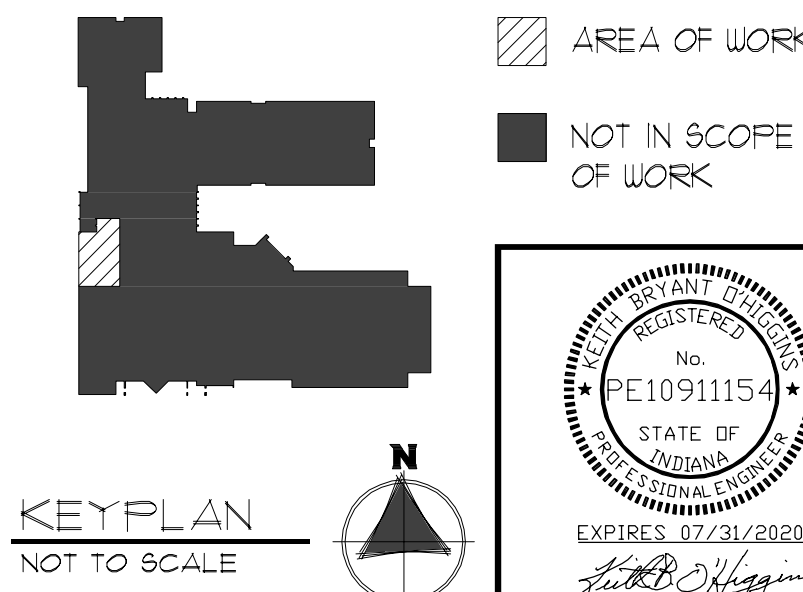


P4.00

PLOTTED BY: CARL EUGEL DATE PLOTTED: 4/7/2020 7:52 AM FILE PATH AND NAME: PA\139-D-1 DSC-Bail Elementary School Nurse Office Renovation\E139-D-1 E0.10

1 PARTIAL EXISTING FLOOR PLAN - ELECTRICAL

1/4" = 1'-0"


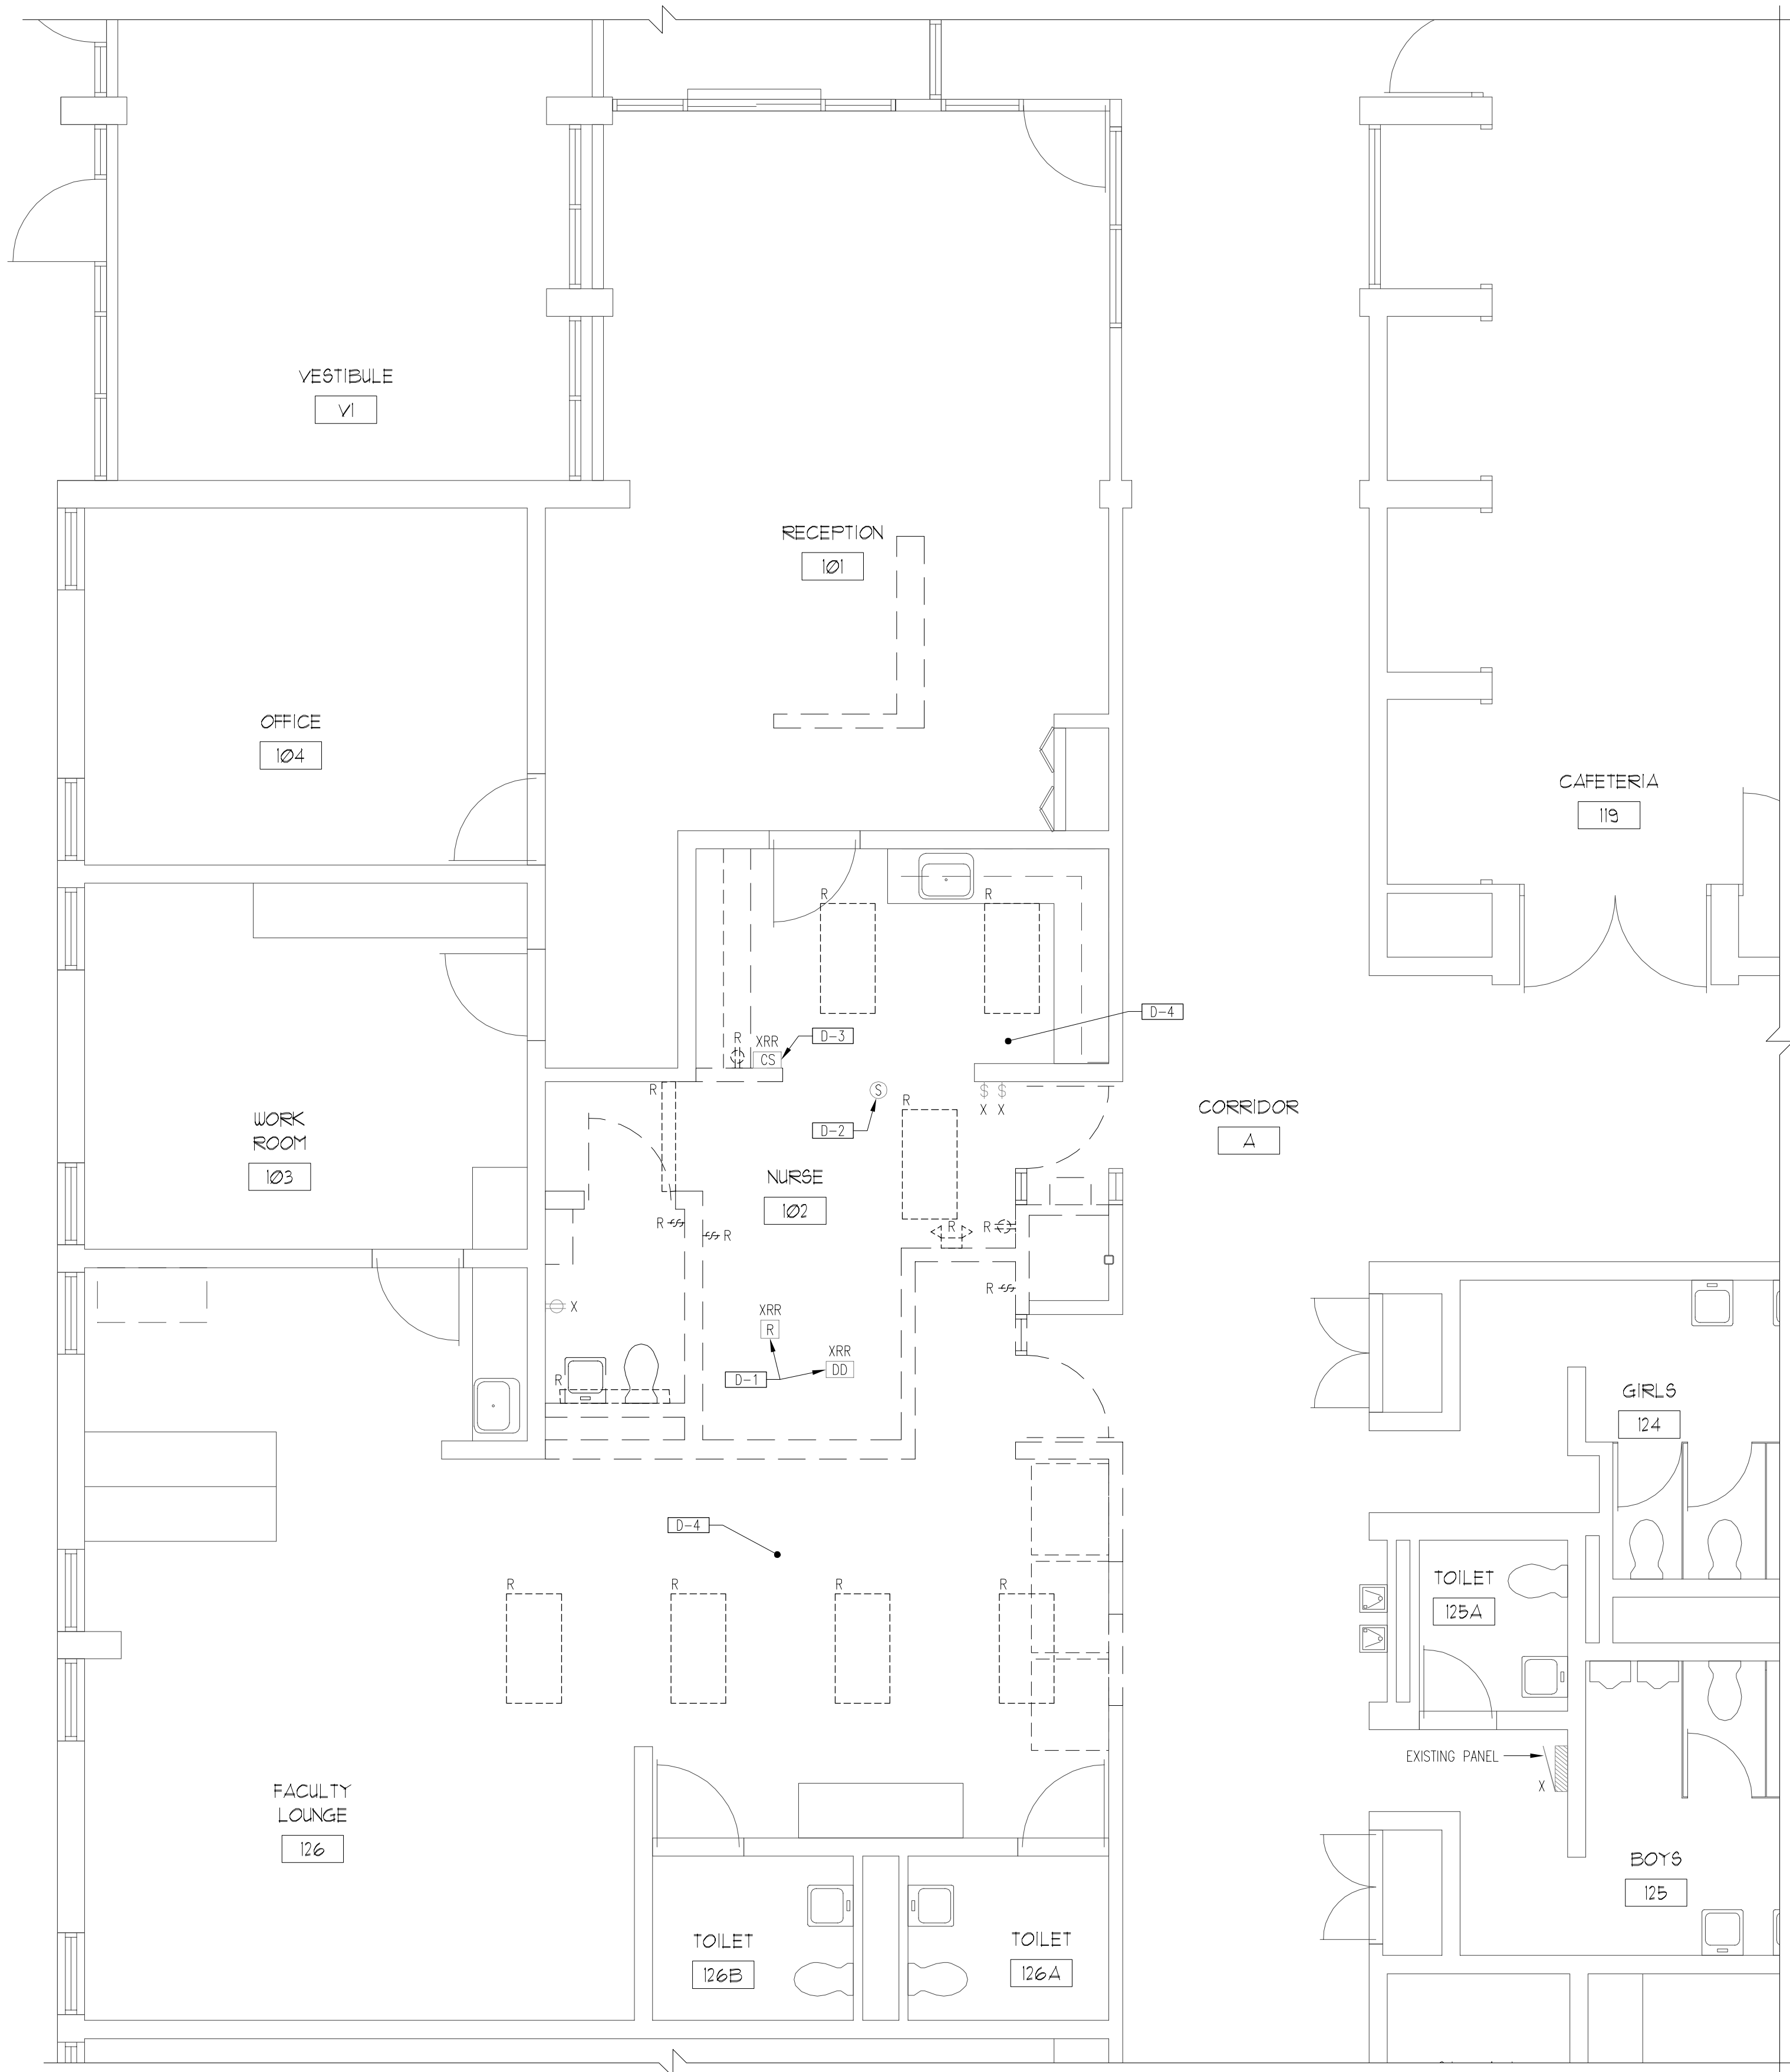


ELECTRICAL DEMOLITION SYMBOLS	
SYM BOL	DESCRIPTION
R	EXISTING ELECTRICAL EQUIPMENT OR OUTLET TO BE REMOVED.
X	EXISTING ELECTRICAL EQUIPMENT OR OUTLET TO REMAIN.
XN	EXISTING ELECTRICAL EQUIPMENT OR OUTLET RELOCATED (NEW LOCATION).
XRR	EXISTING ELECTRICAL EQUIPMENT OR OUTLET TO BE REMOVED, RELOCATED AND JUNCTION BOX REMOVED OR CAPPED AS REQUIRED

ELECTRICAL DEMOLITION NOTES:	
D-1	DUCT SMOKE DETECTOR AND KEYED DUCT DETECTOR RELAY TO BE REMOVED, STORED AND REINSTALLED IN NEW DUCTWORK.
D-2	EXISTING SPEAKER AND WIRE TO BE PROTECTED DURING CONSTRUCTION AND RELOCATED PER NEW WORK PLAN.
D-3	CALL SWITCH TO BE REMOVED AND BE RELOCATED PER NEW WORK PLAN.
D-4	EXISTING LIGHTING CIRCUITS IN THIS AREA TO REMAIN FOR CONNECTION TO NEW LIGHTING.




AREA OF WORK
 NOT IN SCOPE OF WORK

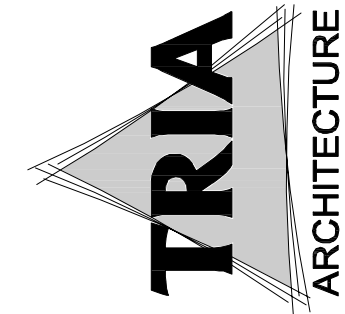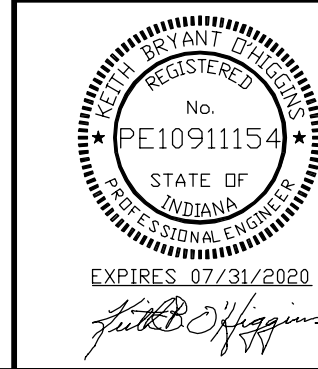


MEFPF CONSULTANT
 (P) 6303381996
 IDAS
 INDIANA DESIGN & ARCHITECTURE LLC
 10000 N. STATE ST. SUITE 200
 CHICAGO, IL 60640

DUNELAND SCHOOL CORPORATION
 2020 NURSE'S OFFICE RENOVATIONS AT:
 BAILLY ELEMENTARY SCHOOL
 800 S 5TH STREET, CHESTERTON, INDIANA 46304

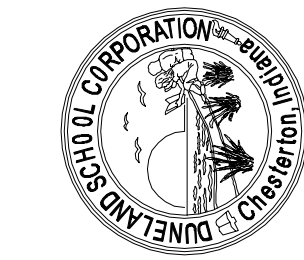

REVISIONS	
PROJECT NUMBER: 20-006	
PROJECT MANAGER: YG	
DESIGNER: OAS	
ISSUED FOR PROPOSAL: 04/07/2020	
PARTIAL EXISTING FLOOR PLAN	
ELECTRICAL	

E0.10

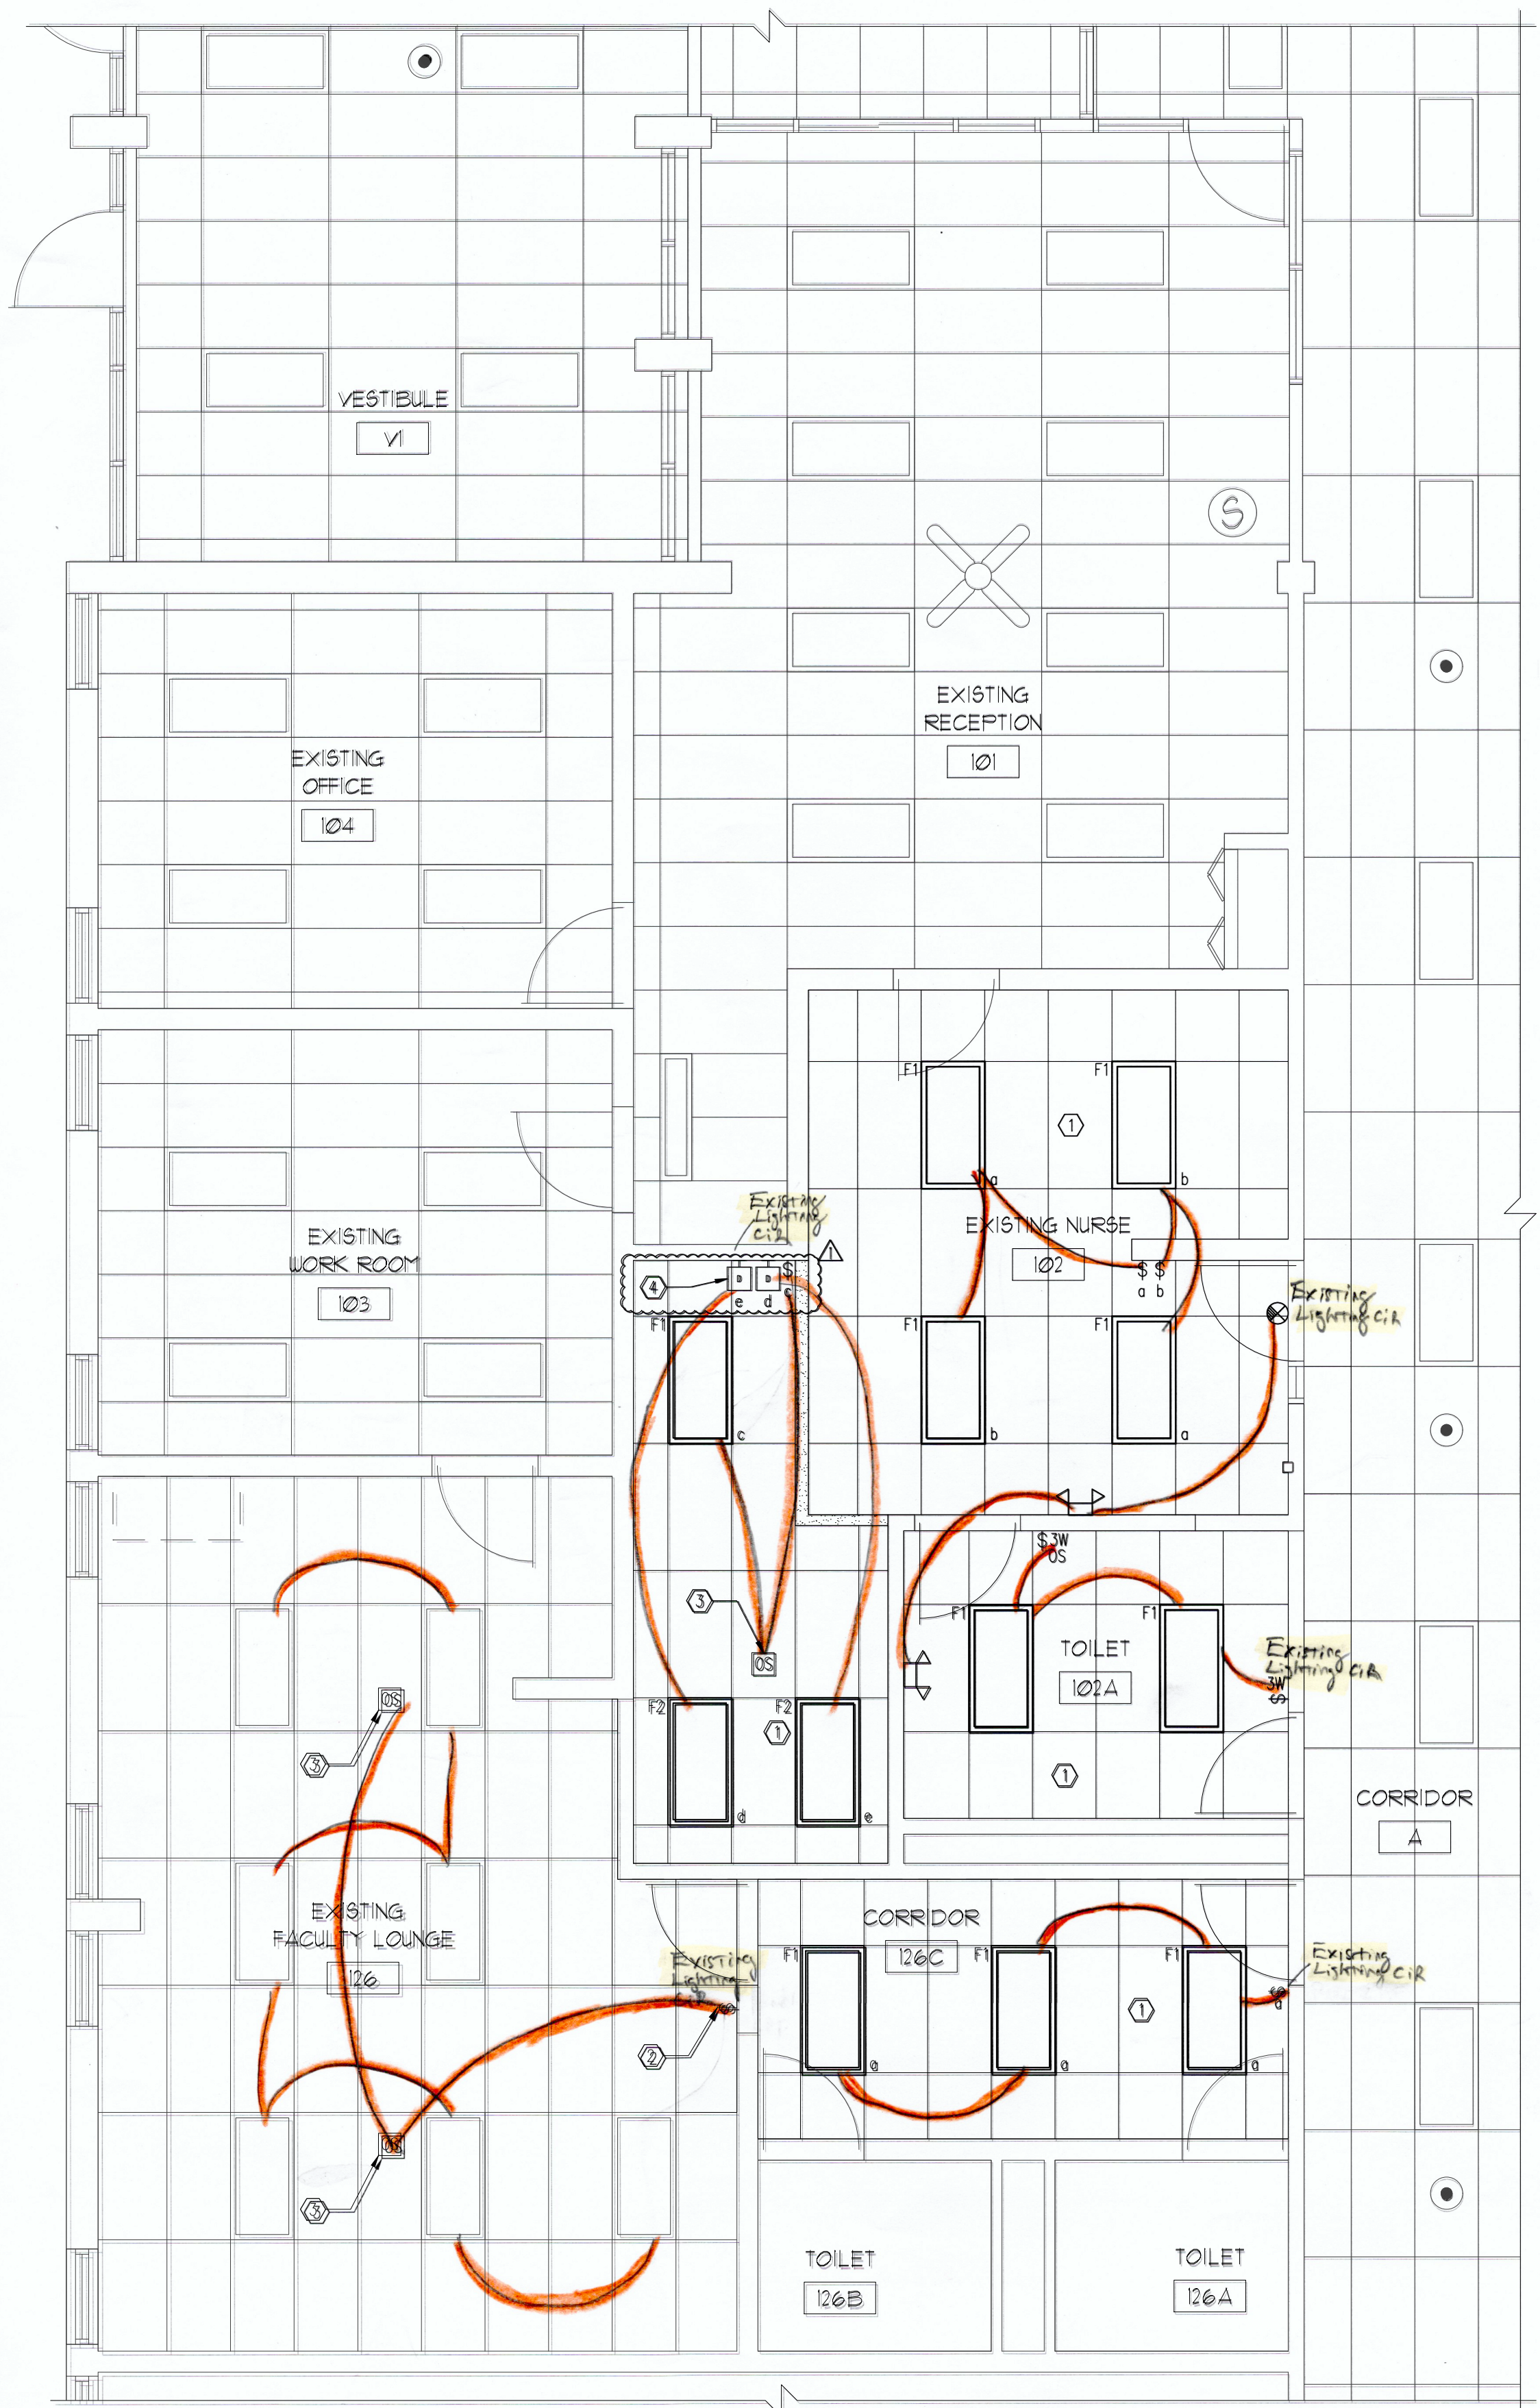

1 PARTIAL FLOOR PLAN - LIGHTING - ELECTRICAL
1/4" = 1'-0"

- ELECTRICAL KEY NOTES:**
- ① NEW LIGHTS TO CONNECT TO EXISTING LIGHTING CIRCUITS. REWORK SWITCH LEGS AS SHOWN.
 - ② FURNISH AND INSTALL NEW SWITCH LEG FOR LIGHTING IN FACULTY LOUNGE 126.
 - ③ FURNISH AND INSTALL OCCUPANCY SENSOR TO CONTROL LIGHTING IN THIS SPACE.
 - ④ FURNISH AND INSTALL DIMMER COMPATIBLE WITH LIGHT FIXTURE REQUIREMENTS.

LIGHTING FIXTURE SCHEDULE							
TYPE	LAMP TYPE	MOUNTING	ACCEPTABLE MANUFACTURER AND CATALOG NUMBER	VOLTS	INPUT WATTS	DESCRIPTION	REMARKS
F1	LED	RECESSED LAY-IN	LITHONIA #CPX2X44000LM35KM2 OR APPROVED EQUAL	120	40	2'x4' LED FLAT PANEL FIXTURE	
F2	LED	RECESSED LAY-IN	LITHONIA #CPX2X44000LM35KM2 OR APPROVED EQUAL	120	40	2'x4' LED FLAT PANEL FIXTURE	FIXTURE TO BE DIMMABLE
⊗	LED	CEILING	LITHONIA #LE-S-W-I-R-ELN DUAL-LITE SESRW OR EQUAL BY SURE-LITES	120	N/A	SINGLE FACE EXIT SIGN WITH 6" RED LETTERS CAST ALUMINUM BODY, 90 MINUTE NI-CAD BATTERY BACK UP	FURNISH WITH ARROWS AS REQUIRED BY CODE, QUICK SHIP REQUIRED
⬆	MR16	CEILING	LITHONIA #ELM2-LED COMPASS #CU2-X OR EQUAL BY SURE-LITES	120	N/A	EMERGENCY BATTERY UNIT WITH DUAL LED HEADS AND 90 MINUTE BATTERY BACKUP	

LARSON DANIELSON
Construction Company, Inc.

Request for information

To: Margaret Gory
TRIA ARCHITECTURE
801 MACLINTOCK DRIVE, STE 100
BURN RIDGE, IL 60627
Ph: (830)450-4000
E-Mail: mgory@tria-arch.com

RTI #: 6
Date: 6/19/2020
L-D Job #: 56-021
Project: DUNELAND SCH-2020 NURSES OFF.

CC:
Subject: Emergency Lights

Drawing:
Cost Impact: None


Spec Section:
Schedule Impact: None

Request:
Please clarify the mounting of the emergency lights. Print show wall mount and the approved fixture is ceiling mount. Please advise whether or not we will proceed with wall mounting.

Date Required: 6/22/2020

Requested by: Jonathan Engstrom
LARSON DANIELSON CONST. CO. INC.

Response:
The approved emergency lights are a 120VAC 120W LED wall mounted fixture.

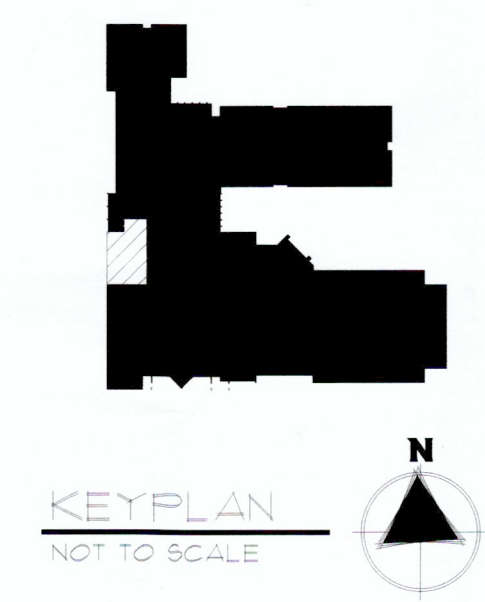

TRIA ARCHITECTURE
1111 N. 10TH STREET
CHICAGO, IL 60610
PH: 312.467.1234
WWW.TRIA-ARCH.COM

DUNELAND SCHOOL CORPORATION
2020 NURSE'S OFFICE RENOVATIONS AT:
BAILLY ELEMENTARY SCHOOL
800 S 5TH STREET, CHESTERTON, INDIANA 46304

REVISIONS:
PROJECT NUMBER: 10-000
PROJECT NAME: NO. 045
DRAWN BY: 045
DATE: 04/07/2020
ISSUED FOR PROPOSAL


PARTIAL FLOOR PLAN -
LIGHTING -
ELECTRICAL

E1.10


CHANGE ORDER INFORMATION:
Change Order Number: 001

Date: August 6, 2020

MEP Revisions at Nurse Area

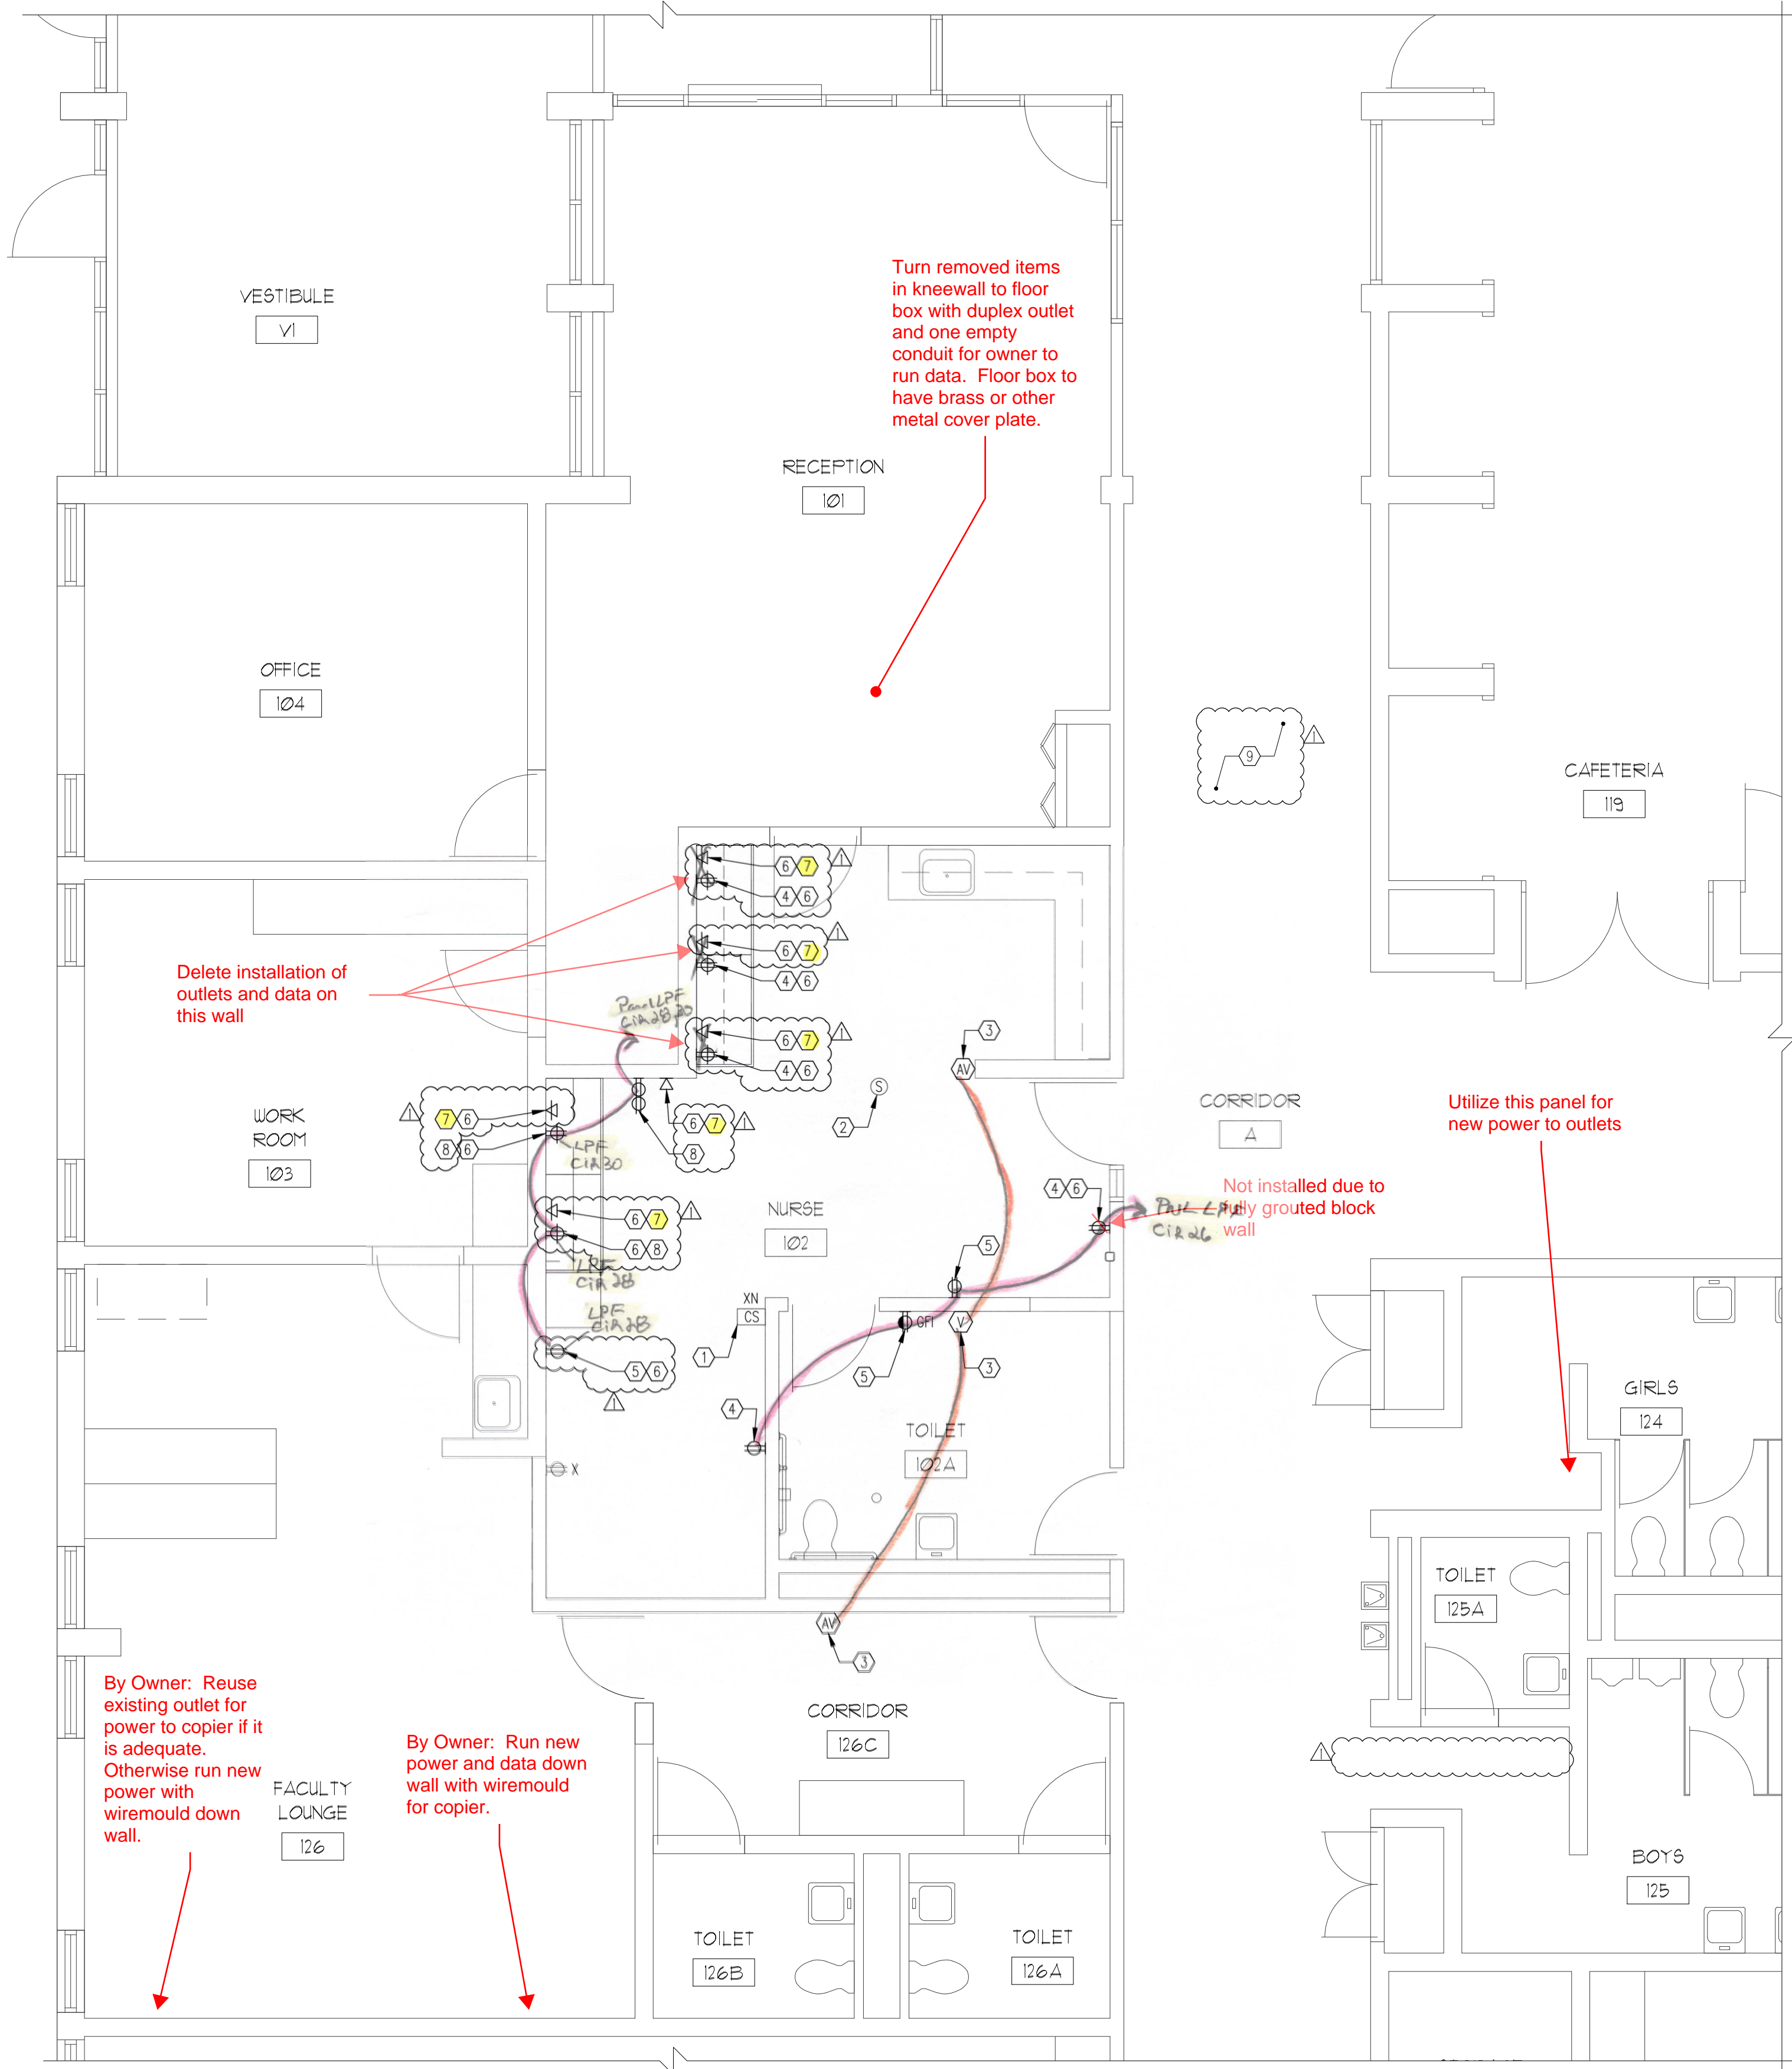

1 PARTIAL FLOOR PLAN - POWER - ELECTRICAL
1/4" = 1'-0"

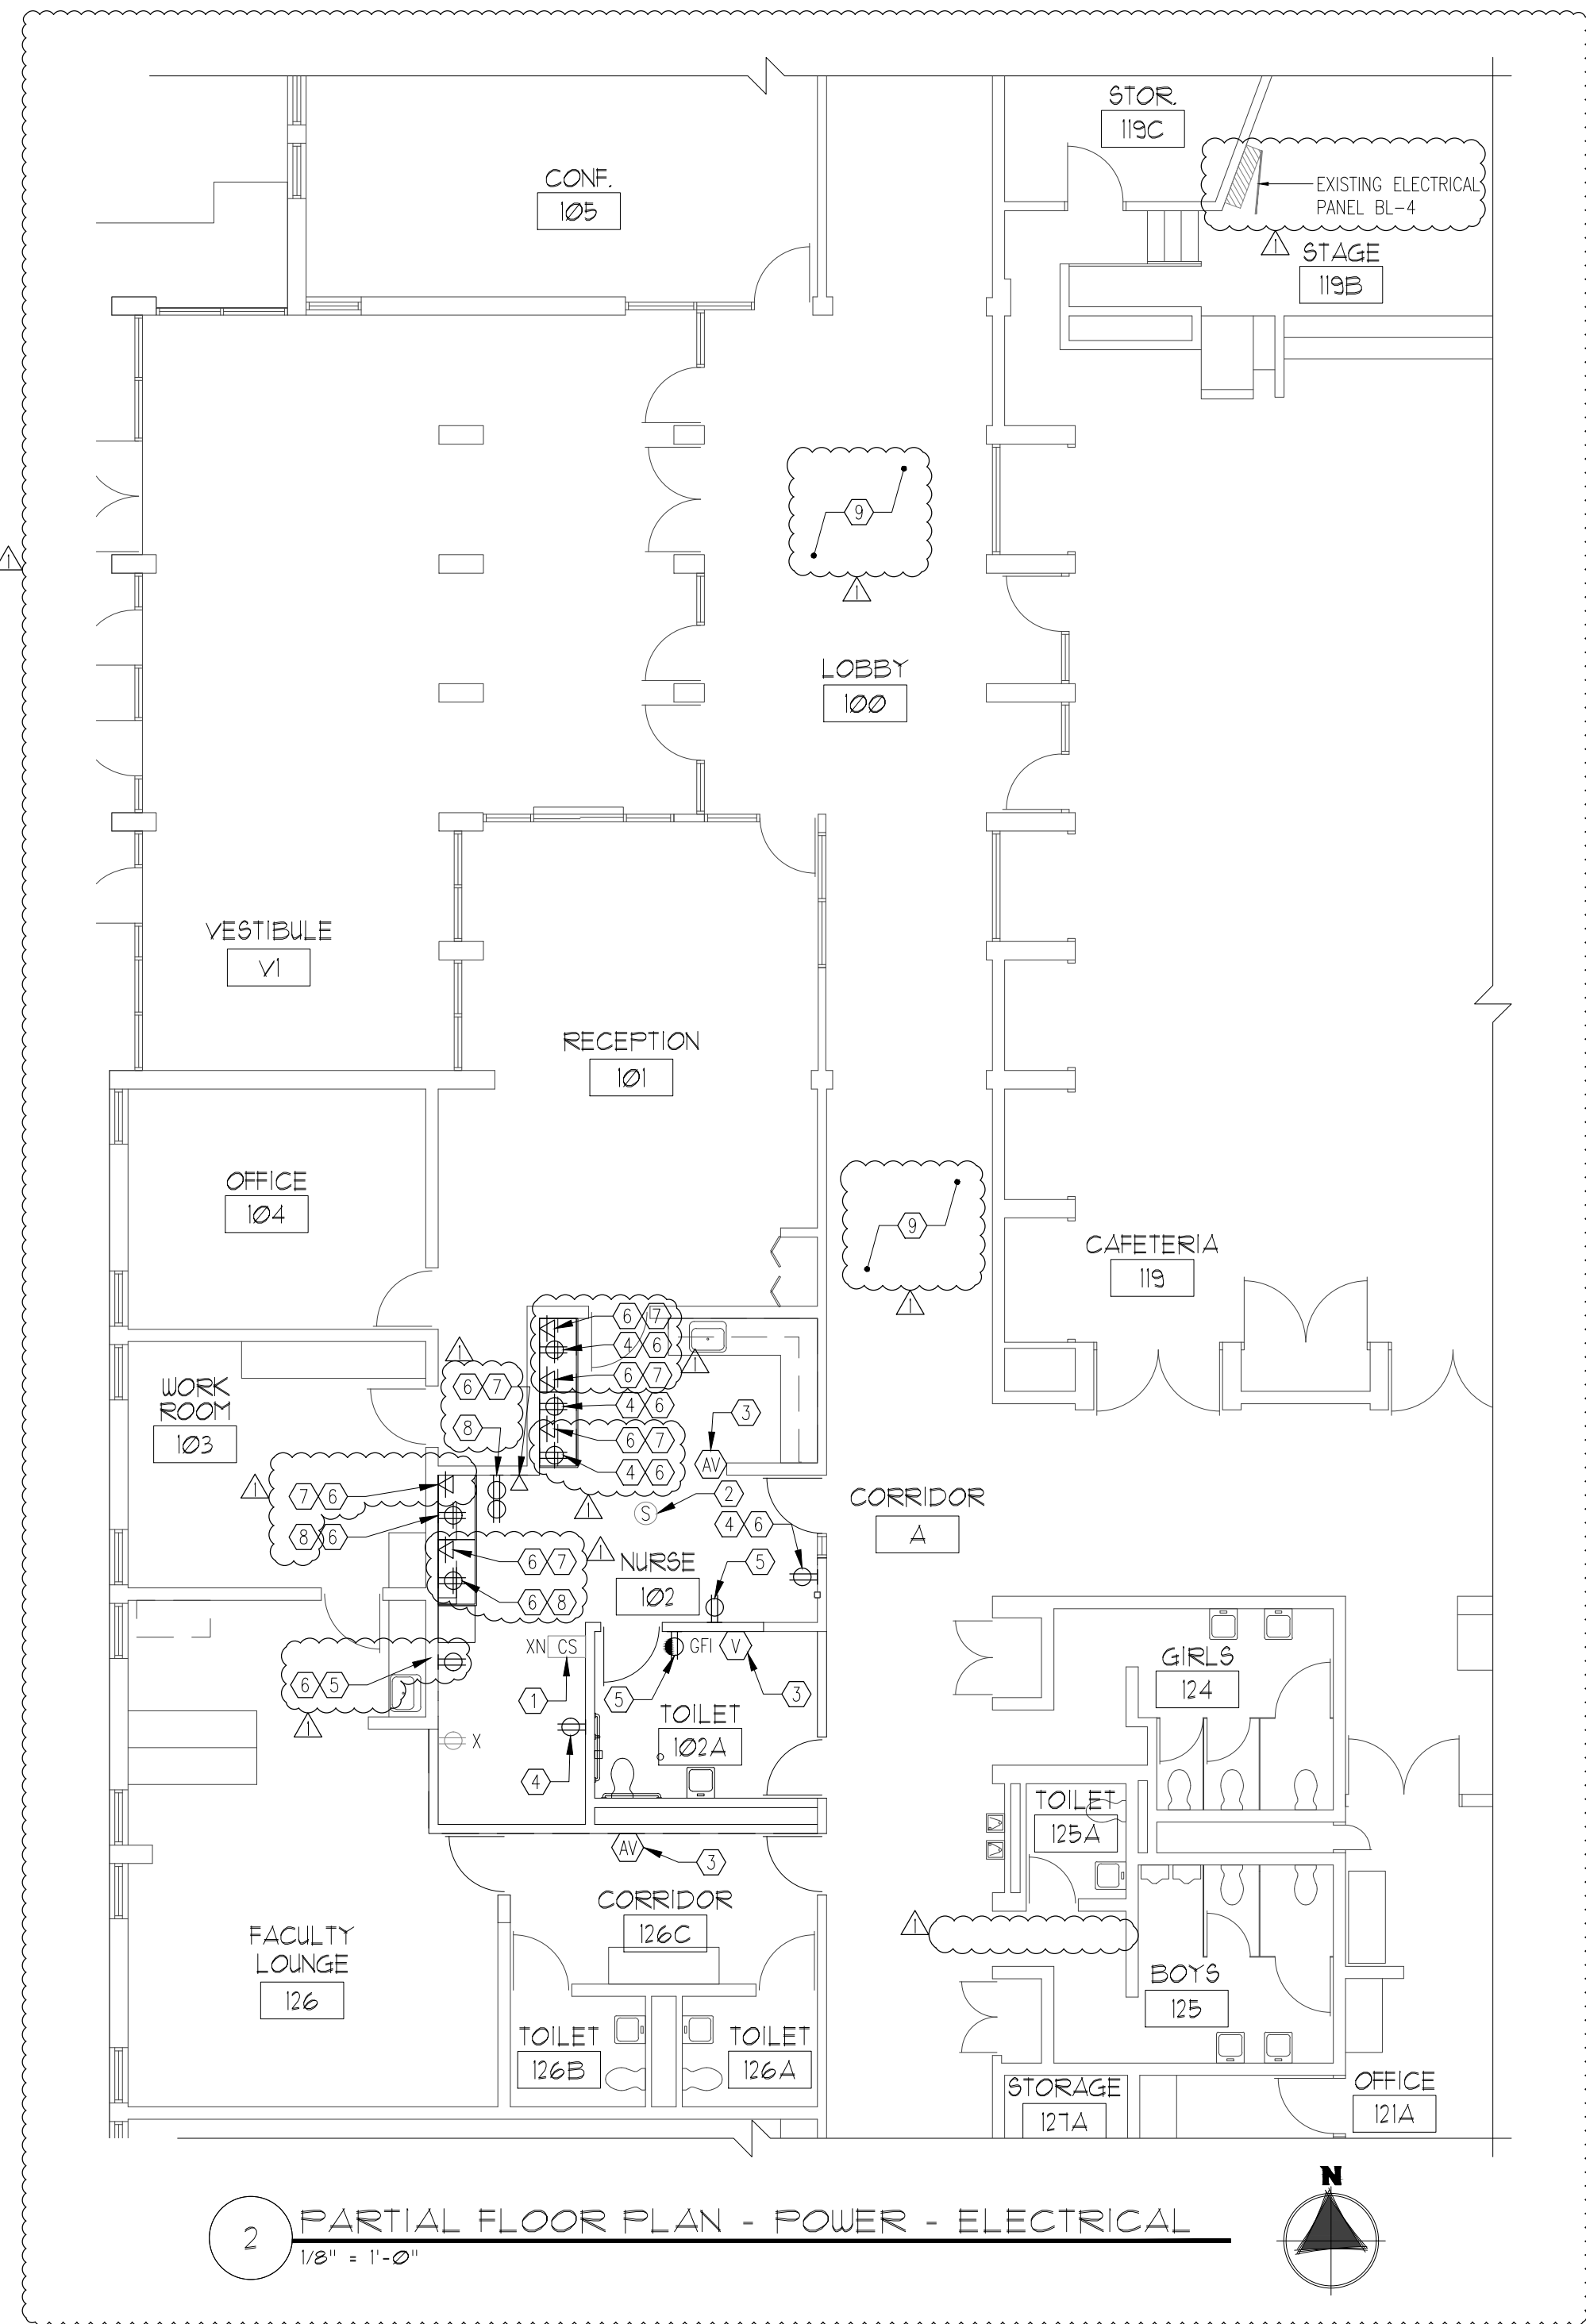

2 PARTIAL FLOOR PLAN - POWER - ELECTRICAL
1/8" = 1'-0"

ELECTRICAL KEY NOTES:

- 1 RELOCATED CALL SWITCH "CS". TIE BACK INTO PA/ INTERCOM SYSTEM.
- 2 RELOCATED SPEAKER. ENSURE EXISTING WIRING IS IN TACT AND SPEAKER IS OPERATIONAL.
- 3 NEW FIRE ALARM DEVICE. DEVICE TO BE OF SAME MANUFACTURER OF EXISTING FIRE ALARM SYSTEM. PROVIDE ALL WIRING PROGRAMMING AND TESTING REQUIRED TO ADD DEVICE.
- 4 NEW POWER CIRCUIT FROM PANEL BL-4, CIRCUIT 26. FURNISH AND INSTALL 20A, 1P CB. WIRING TO BE 2#12, 1#12G, 3/4" C.
- 5 NEW POWER CIRCUIT FROM PANEL BL-4, CIRCUIT 28. FURNISH AND INSTALL 20A, 1P CB. WIRING TO BE 2#12, 1#12G, 3/4" C.
- 6 CUT AND CHANNEL EXISTING WALL TO RECESS NEW BOX AND CONDUIT. PATCH WALL TO MATCH EXISTING.
- 7 NEW DATA CONDUIT DROP AND BOX RECESSED IN WALL. CONDUIT TO TERMINATE ± 6" ABOVE CEILING.
- 8 NEW POWER CIRCUIT FROM PANEL BL-4, CIRCUIT 30. FURNISH AND INSTALL 20A, 1P CB. WIRING TO BE 2#12, 1#12G, 3/4" C.
- 9 CONTRACTOR IS RESPONSIBLE FOR LAY-IN CEILING TILE REMOVAL AND REPLACEMENT FOR CONDUIT INSTALLATION TO PANEL BL-4 IF TILES ARE DAMAGED IN THIS PROCESS THEY SHALL BE REPLACED AT NO ADDITIONAL COST TO THE OWNER.

LARSON DANIELSON
Construction Company, Inc.


Project: 20-006
Project Manager: TGS
Drawn By: TGS
Issued For Proposal: 04/07/2020
Partial Floor Plan - POWER - ELECTRICAL

Request for Information


Project: 20-006
Project Manager: TGS
Drawn By: TGS
Issued For Proposal: 04/07/2020
Partial Floor Plan - POWER - ELECTRICAL

Request for Information

Project: 20-006
Project Manager: TGS
Drawn By: TGS
Issued For Proposal: 04/07/2020
Partial Floor Plan - POWER - ELECTRICAL

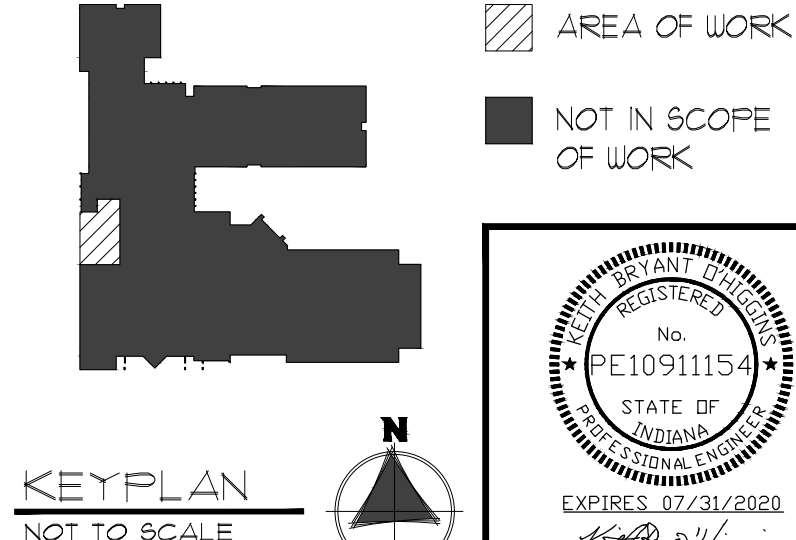


KEYPLAN
NOT TO SCALE

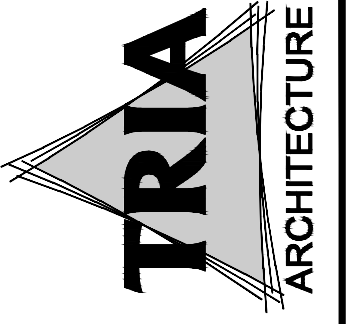

MEPFF CONSULTANT
P: 630.338.9996
F: 630.338.9996



DUNELAND SCHOOL CORPORATION
2020 NURSE'S OFFICE RENOVATIONS AT:
BAILLY ELEMENTARY SCHOOL
800 S 5TH STREET, CHESTERTON, INDIANA 46304

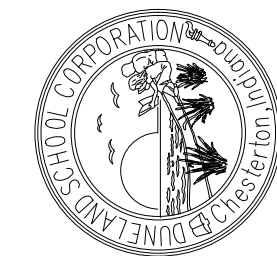

PROJECT NUMBER: 20-006	REVISIONS: 04/07/2020
PROJECT MANAGER: TGS	DATE: 04/07/2020
DRAWN BY: TGS	ISSUED FOR PROPOSAL: 04/07/2020
ISSUED FOR PROPOSAL: 04/07/2020	PARTIAL FLOOR PLAN - POWER - ELECTRICAL

E2.10

Bailly Elem School Nurse Renov Duneland

DRAWING ISSUE:
SUBMITTALS
AS BUILT

REV-0

DATE:
5/22/2020
8/5/2020

As-Built
8/5/2020



Creating a better climate for business.

- Environmental Control System
- Facility Management System
- Air and Water System Balancing
- Fire Management System
- Security System
- Lighting Services
- Instrumentation System Installation
- Building Operations Management
- Energy Conservation Control
- Training Programs
- Performance Contracting
- Planned Service Agreements

Air Conditioning
Heating
Diagnostic Services
Coil Cleaning
Refrigeration
Automatic Temperature Controls
Facility Management Systems
Fire Management
Security Management
Building Operations and Management
Water Treatment
Electrical Equipment
Emergency Generator / Lighting Equipment
Industrial Controls / Recording / Indication Equipment

PROJECT TITLE
Bailly Elem School Nurse Renov Duneland

ARCHITECT

Phone:

ENGINEER

Phone:

MECHANICAL CONTRACTOR
Circle "R" Mechanical, Inc
6620 Shepherd Ave
Portage, IN 46368
Phone: (219) 406-3009

ELECTRICAL CONTRACTOR
Hyre Electric Address
2655 Garfield Ave
Highland IN 46322

REFERENCE DRAWING

NO.

REVISION-LOCATION

ECN

DATE

BY

Johnson Controls

Branch Information
Johnson Controls, Inc.
1500 Huntington Drive
Calumet City, IL 60409-5402
Phone: (708) 474-1717
Fax: (708) 474-6551

SALES ENGINEER
Mary Pullo

PROJECT MANAGER
Jeffrey Loupee

APPLICATION ENGINEER
Qusai Alqadi

DATE
8/5/2020

CONTRACT NUMBER
0N02-0154

LEGEND

S

20

Main Air Supply Tube at 20 PSIG

D-N

15-20

Dual Air Supply Tube at 15/20 PSIG
Day=15, Night=20

S

80

High Pressure Air Supply Tube at 80 PSIG

Air line or Electrical Wire

Connected Lines or Wires

I

Crossing Lines or Wires, Not Connected

X

In-Line Restrictor

7

Pneumatic Tube indicating Tube Number

2/18

Wire Symbol indicating: number of wires and size (E.G. 2 #18 wires)

3

2/18

Wire Symbol indicating: Cable Destination (DA-T), Cable number (3), Number of wires and size (E.G. 2 #18 wires)

1

Electrical Wire Terminal with Appropriate Number

Item Located on Panel Face

1

Drawing Revision Symbol with Appropriate Number

Opposed Blade Damper

Parallel Blade Damper

Filter

Air Flow Measuring Station

Humidifier

Fan

Pump

H
C

Heating or Cooling Coil

Ductwork or Piping with Flow Direction Shown

Gage

Device

Bulb Type Temperature Sensing Element Located under Shield in Outside air

Humidity Sensing Element Located under Shield in Outside air

Bulb Type Temperature Sensing Element Located inside Separable Socket/Well

Strap-on Bulb Type Temperature Sensing Element

Combination Bulb Type Temperature Sensing Element and Humidity Sensor (Duct Mount)

Bulb Type Temperature Sensing Element

Pressure Sensing Device

Paddle Type Flow Switch

Vapor Tension Temperature Sensing Element (Hi Limit)

Vapor Tension Temperature Sensing Element (Low Limit)

Current Sensing Switch or Combination Current Sensing switch & Command Relay


Duct Detector (Smoke, CO, CO2)

2-Way Valve with Actuator

3-Way Valve with Actuator

DRAWING INDEX

Drawing	Description
00.00-00	Title Page
00.01-00	Drawing Index
00.02-00	Standard Hardware Naming Conventions
00.03-00	Standard Software Naming Conventions
02.00-00	Misc Controls
02.01-00	Misc Point Schedule 1
VS-1	Valve Schedule

Drawing Title Valve Schedule							
		REFERENCE DRAWING		NO.	REVISION-LOCATION		ECN
Sales Engineer	Project Manager	Application Engineer	DRAWN		APPROVED		
Mary Pullo	Jeffrey Loupee	Qusai Alqadi	BY	DATE	BY	DATE	
Project Title Bailly Elem School Nurse Renov Duneland				Branch Information Johnson Controls, Inc. 1500 Huntington Drive Calumet City, IL 60409-5402 Phone: (708) 474-1717 Fax: (708) 474-6551		CONTRACT NUMBER	
						0N02-0154	
						DRAWING NUMBER	
						VS-1	

STANDARD HARDWARE NAMING CONVENTIONS

AIR HANDLING UNIT PREFIXES

Devices (both Input & Output)

SF	Supply Fan
RF	Return Fan
EF	Exhaust Fan
OF	Outside Fan
SFn	Supply Fan n (n=1,2)
RFn	Return Fan n (n=1,2)
EFn	Exhaust Fan n (n = 1-9)

OAD	OA Damper
MOAD	Min Damper
RAD	RA Damper
MAD	MA Damper
DAD	DA Damper
SAD	SA Damper
EAD	EA Damper
FBD	F & B Damper

Analog Inputs

OA	Outside Air
MOA	Min OA
RA	Return Air
MA	Mixed Air
DA	Discharge Air
SA	Supply Air
SA1	Supply Air 1
SA2	Supply Air 2
EA	Exhaust Air
RM	Room
ZN	Zone
ZNn	Zone n (n = 1-9)
PH	Preheat
CD	Cold Deck
HD	Hot Deck
CC	Cooling Coil
HC	Heating Coil
DTC	Dual Temp Coil
CZN	Coldest Zone
WZN	Warmest Zone

Binary Inputs

FILT	Filter
PFILT	PreFilter
FFILT	Final Filter
HFILT	HEPA Filter
LT	Low Temp
HT	High Temp
LSP	Low Static Pressure
HSP	High Static Pressure
HHL	Humidity Hi Limit
SFVSD	Supply Fan VSD
RFVSD	Return Fan VSD
EFVSD	Exhaust Fan VSD
OFVSD	OA Fan VSD

Analog and Binary Outputs

CLG	Cooling
HTG	Heating
RH	Reheat
RHn	Reheat n (n = 1-9)
PH	Preheat
PC	Precool
DTC	Dual Temp Coil
HR	Heat Recovery
HUM	Humidifier
HRP	Heat Recovery Pump
PHP	Preheat Pump
HP	Heating Pump
CP	Cooling Pump
DTP	Dual Temp Pump
CLGn	Clg Stage n (n = 1-9)
HTGn	Htg Stage n (n = 1-9)
ZNn	Zone n (n = 1-9)

Devices (both Input & Output)

CH	Chiller
CHn	Chiller n (n = 1-9)
BLR	Boiler
BLRn	Boiler n (n = 1-9)
CT	Cooling Tower
CTn	Cooling Tower n (n = 1-9)
CTVS	Cooling Tower Vibration Switch
CTnVS	Cooling Tower n (n = 1-9) Vibration Switch
CTnD	Cooling Tower n (n = 1-4) Damper
CTnL	Cooling Tower n (n = 1-4) Lo Speed
CTnH	Cooling Tower n (n = 1-4) Hi Speed
CTnC1L	Cooling Tower n (n = 1-4) Cell 1 Lo Speed
CTnC1H	Cooling Tower n (n = 1-4) Cell 1 Hi Speed
CTnC2L	Cooling Tower n (n = 1-4) Cell 2 Lo Speed
CTnC2H	Cooling Tower n (n = 1-4) Cell 2 Hi Speed

P	Pump
Pn	Pump n (n = 1-9)
CHP	Chilled Water Pump
CHPn	Chilled Water Pump n (n = 1-9)
PCHP	Primary Chilled Water Pump
PCHPn	Primary Chilled Water Pump n (n = 1-9)
SCHP	Secondary Chilled Water Pump
SCHPn	Secondary Chilled Water Pump n (n = 1-9)
CWP	Condenser Water Pump
CWPn	Condenser Water Pump n (n = 1-9)
HWP	Hot Water Pump
HWPn	Hot Water Pump n (n = 1-9)
PHWP	Primary HW Pump
PHWPn	Primary HW Pump n (n = 1-9)
SHWP	Secondary HW Pump
SHWPn	Secondary HW Pump n (n = 1-9)
DHWP	Domestic HW Pump
DHWPn	Domestic HW Pump n (n = 1-4)
DWP	Domestic Water Pump
DWPn	Domestic Water Pump n (n = 1-4)
CHISO	Chilled Water Isolation Valve
CWISO	Condenser Water Isolation Valve
CWnISO	Condenser Water n (n = 1-9) Isolation Valve
CTISO	Cooling Tower Isolation Valve
CTnISO	Cooling Tower n (n = 1-9) Isolation Valve
CHISO	Chiller Isolation Valve
CHnISO	Chiller n (n = 1-9) Isolation Valve
BISO	Boiler Isolation Valve
BnISO	Boiler n (n = 1-9) Isolation Valve
HXISO	Heat Exchanger Isolation Valve
HXnCHI	Heat Exchanger n (n = 1-4) CHW Isolation Valve
HXnCWI	Heat Exchanger n (n = 1-4) CWW Isolation Valve
HXnHWI	Heat Exchanger n (n = 1-4) HW Isolation Valve

Analog Inputs

PCHS	Primary CH Supply
PCHR	Primary CH Return
CHS	Chilled Water Supply
CHR	Chilled Water Return
CWS	Cond Water Supply
CWR	Cond Water Return
SCHS	Secondary CH Supply
SCHR	Secondary CH Return
DTS	Dual Temp Supply
DTR	Dual Temp Return
TCHS	Tertiary CH Supply
TCHR	Tertiary CH Return
PHWS	Primary HW Supply
PHWR	Primary HW Return
HWS	Hot Water Supply
HWR	Hot Water Return
SHWS	Secondary HW Supply
SHWR	Secondary HW Return
ITS	Ice Tank Supply
ITR	Ice Tank Return
STM	Steam

CENTRAL PLANT PREFIXES

Analog Inputs (continued)

HXnCHS	Heat Exchanger n (n = 1-4) CHS
HXnCHR	Heat Exchanger n (n = 1-4) CHR
HXnCWS	Heat Exchanger n (n = 1-4) CWS
HXnCWR	Heat Exchanger n (n = 1-4) CWR
HXnHWS	Heat Exchanger n (n = 1-4) HWS
HXnHWR	Heat Exchanger n (n = 1-4) HWR
HXnSTM	Heat Exchanger n (n = 1-4) STM
HXnPW	Heat Exchanger n (n = 1-4) Process
HXnDHW	Heat Exchanger n (n = 1-4) Domestic HW

CHCHS	Chiller CH Supply
CHCHR	Chiller CH Return
CHCWS	Chiller CW Supply
CHCWR	Chiller CW Return

CnCHS	Chiller n (n = 1-9) CH Supply
CnCHR	Chiller n (n = 1-9) CH Return
CnCWS	Chiller n (n = 1-9) CW Supply
CnCWR	Chiller n (n = 1-9) CW Return

TnBSN	Tower n (n = 1-9) Basin
-------	-------------------------

BnHWS	Boiler n (n = 1-9) HW Supply
BnHWR	Boiler n (n = 1-9) HW Return

HPS	High Pressure Steam
MPS	Medium Pressure Steam
LPS	Low Pressure Steam

HTHW	High Temp Hot Water
MTHW	Medium Temp Hot Water

DW	Domestic Water
DHW	Domestic Hot Water

EM	Electric Meter
EMn	Electric Meter n (n = 1-4)

GM	Gas Meter
GMn	Gas Meter n (n = 1-4)

Binary Inputs

SPVSD	Secondary CHW Pump VSD
SPnVSD	Secondary CHW Pump n (n = 1-9) VSD
SPVSD	Secondary HW Pump VSD
SPnVSD	Secondary HW Pump n (n = 1-9) VSD
TVIB	Tower Vibration
LW	Low Water
BFF	Boiler Flame Failure
BnFF	Boiler n (n = 1-9) Flame Failure

Analog and Binary Outputs

CTBYP	Cooling Tower Bypass Valve
CTnBYP	Cooling Tower n (n = 1-9) Bypass Valve
HX	Heat Exchanger Valve
HXn	Heat Exchanger n (n = 1-9) Valve

SUFFIXES

Binary Outputs

-C	Command	Off/On
-EN	Enable	Dis/Ena
-OP	Open	Off/On
-CL	Close	Off/On

Analog Outputs


-O	Output	%
-O1	Output 1	%
-O2	Output 2	%

Binary Inputs

-S	Status	Off/On
-A	Alarm	Normal/Alarm
-ES	End Switch	Close/Open
-FS	Flow Switch	Off/On
-SD	Smoke Detector	Normal/Alarm
-S	Status	Clean/Dirty

Analog Inputs

-T	Temp	Deg F
-H	Humidity	% RH
-WB	Wetbulb	Deg F
-Q	Air Quality	PPM
-L	Level	% Full
-P	Static Pressure	In WC
-DP	Diff Pressure	In WC
-VP	Velocity Pressure	In WC
-E	Enthalpy	BTU/Lb
-DEW	Dewpoint	Deg F
-F	Flow	CFM
-F	Flow	GPM
-F	Flow	Lb/Hr
-%	Speed	%
-I	Amps	Amps
-V	Volts	Volts
-KW	Kilowatts	KW
-W	Watts	Watts
-TON	Tons	Tons
-CO	CO	PPM
-CO2	CO2	PPM
-HP	Horsepower	HP
-P	Pressure	psi
-DP	Diff Pressure	psi
-POS	Position	%
-BTU	BTUs	BTU

Drawing Title Standard Hardware Naming Conventions							
		REFERENCE DRAWING		NO.	REVISION-LOCATION		ECN
Sales Engineer	Project Manager	Application Engineer	DRAWN		APPROVED		
Mary Pullo	Jeffrey Loupee	Qusai Alqadi	BY	DATE	BY	DATE	
Project Title Bailly Elem School Nurse Renov Duneland				Branch Information Johnson Controls, Inc. 1500 Huntington Drive Calumet City, IL 60409-5402 Phone: (708) 474-1717 Fax: (708) 474-6551		CONTRACT NUMBER 0N02-0154	
DRAWING NUMBER 00.02-00							

STANDARD SOFTWARE NAMING CONVENTIONS

AIR HANDLING UNIT PREFIXES

Setpoints

DAT	Discharge Air Temperature
SAT	Supply Air Temperature
DAP	Discharge Air Static Pressure
SAP	Supply Air Static Pressure
RAP	Return Air Static Pressure
DAH	Discharge Air Humidity
MAT	Mixed Air Temperature
RAT	Return Air Temperature
RAH	Return Air Humidity
RMT	Room Temperature
RMH	Room Humidity
ZNT	Zone Temperature
ZNH	Zone Humidity
MALT	Mixed Air Low Temperature
HDT	Hot Deck Temperature
CDT	Cold Deck Temperature
CDLT	Cold Deck Low Temperature
PHT	Preheat Temperature
PCT	PreCool Temperature
ACLG	Actual Cooling
AHTG	Actual Heating
ASCLG	Actual Supply Cooling
ACDT	Actual Cold Deck Temperature
ASHTG	Actual Supply Heating
AHDT	Actual Hot Deck Temperature
OCLG	Occupied Cooling
OHTG	Occupied Heating
UCLG	Unoccupied Cooling
UHTG	Unoccupied Heating
ZNCLG	Zone Cooling
ZNHTG	Zone Heating
BBHTG	Baseboard Heating
FTHTG	Fin Tube Heating
SAF	Supply Air Flow
RAF	Return Air Flow
OAF	Outside Air Flow
EAF	Exhaust Air Flow
DAF	Discharge Air Flow
MOAF	Minimum Outside Air Flow
SAH	Supply Air Humidity
ZNnT	Zone n (n = 1-9) Temperature
ZNnH	Zone n (n = 1-9) Humidity
HDH	Hot Deck Humidity

Reset Parameters

SAT	Supply Air Temperature
HDT	Hot Deck Temperature
CDT	Cold Deck Temperature
ZNT	Zone Temperature
OAT	Outside Air Temperature

Modes

ECON	Economizer Mode
------	-----------------

CENTRAL PLANT PREFIXES

Devices (both Input & Output)

CH	Chiller
CHn	Chiller n (n = 1-9)
BLR	Boiler
BLRn	Boiler n (n = 1-9)
CT	Cooling Tower
CTn	Cooling Tower n (n = 1-9)
P	Pump
Pn	Pump n (n = 1-9)
CHP	Chilled Water Pump
CHPn	Chilled Water Pump n (n = 1-9)
PCHP	Primary Chilled Water Pump
PCHPn	Primary Chilled Water Pump n (n = 1-9)
SCHP	Secondary Chilled Water Pump
SCHPn	Secondary Chilled Water Pump n (n = 1-9)
CWP	Condenser Water Pump
CWPn	Condenser Water Pump n (n = 1-9)
HWP	Hot Water Pump
HWPn	Hot Water Pump n (n = 1-9)
PHWP	Primary HW Pump
PHWPn	Primary HW Pump n (n = 1-9)
SHWP	Secondary HW Pump
SHWPn	Secondary HW Pump n (n = 1-9)

Setpoints

CHDL	Chiller Demand Limit
CHnDL	Chiller n (n = 1-9) Demand Limit
PCHST	Primary CH Supply Temperature
PCHRT	Primary CH Return Temperature
CHST	Chilled Water Supply Temperature
CHRT	Chilled Water Return Temperature
CWST	Cond Water Supply Temperature
CWRT	Cond Water Return Temperature
SCHST	Secondary CH Supply Temperature
SCHRT	Secondary CH Return Temperature
DTST	Dual Temperature Supply Temperature
DTRT	Dual Temperature Return Temperature
TCHST	Tertiary CH Supply Temperature
TCHRT	Tertiary CH Return Temperature
PHWST	Primary HW Supply Temperature
PHWRT	Primary HW Return Temperature
HWST	Hot Water Supply Temperature
HWRT	Hot Water Return Temperature
SHWST	Secondary HW Supply Temperature
SHWRT	Secondary HW Return Temperature
HXnCHST	Heat Exchanger n (n = 1-4) CHS Temperature
HXnCWS	Heat Exchanger n (n = 1-4) CWS Temperature
HXnHWS	Heat Exchanger n (n = 1-4) HWS Temperature
CHCHST	Chiller CH Supply Temperature
CHnCHST	Chiller n (n = 1-9) CH Supply Temperature
CHCWST	Chiller CW Supply Temperature
CHnCWST	Chiller n (n = 1-9) CH Supply Temperature
BnHWST	Boiler n (n = 1-9) HW Supply Temperature

Reset Parameters

HWST	Hot Water Supply Temperature
SHWST	Secondary HW Supply Temperature
CHST	Chilled Water Supply Temperature

TERMINAL BOX PREFIXES

Setpoints

AZNT	Actual Zone Temperature
OCCFM	Occupied CFM
UNCFM	Unoccupied CFM
WUCFM	Warmup CFM
OCSAC	Occupied Supply Air CFM
UNSAC	Unoccupied Supply Air CFM
WUSAC	Warmup Supply Air CFM
OCRAC	Occupied Return Air CFM
UCRAC	Unoccupied Return Air CFM
WURAC	Warmup Return Air CFM
OCEAC	Occupied Exhaust Air CFM
UNEAC	Unoccupied Exhaust Air CFM
WUEAC	Warmup Exhaust Air CFM
OCLGC	Occupied Cooling CFM
UCLGC	Unoccupied Cooling CFM
OHTGC	Occupied Heating CFM
UCLGC	Unoccupied Cooling CFM
OBMNC	Occupied Base Board Minimum CFM
UBMNC	Unoccupied Base Board Minimum CFM
OBMXC	Occupied Base Board Maximum CFM
UBMXC	Unoccupied Base Board Maximum CFM
OCDMN	Occupied Cold Deck Minimum CFM
UCDMN	Unoccupied Cold Deck Minimum CFM
OCDMX	Occupied Cold Deck Maximum CFM
UCDMX	Unoccupied Cold Deck Maximum CFM
OHDMN	Occupied Hot Deck Minimum CFM
UHDMN	Unoccupied Hot Deck Minimum CFM
OHDMX	Occupied Hot Deck Maximum CFM
UHDMX	Unoccupied Hot Deck Maximum CFM
OCMNC	Occupied Cooling Minimum CFM
UCMXC	Unoccupied Cooling Maximum CFM
OHMNC	Occupied Hot Deck Minimum CFM
UHMXC	Unoccupied Hot Deck Maximum CFM
WCMNC	Warmup Cooling Minimum CFM
WCMXC	Warmup Cooling Maximum CFM
WHMNC	Warmup Heating Minimum CFM
WHMXC	Warmup Heating Maximum
WCDMN	Warmup Cold Deck Minimum CFM
WCDMX	Warmup Cold Deck Maximum CFM
WHDMN	Warmup Hot Deck Minimum CFM
WHDMX	Warmup Hot Deck Maximum CFM

SUFFIXES

Analog Outputs

-SP	Setpoint	Setp
-RB	Reset Band	Setp
-LL	Low Limit	Setp
-HL	High Limit	Setp

Analog Inputs


-SP	Setpoint	Setp
-----	----------	------

Analog Datapoints

-SQ	Sequence	of X
-Z	PID Controller	

Binary Datapoints



-SQ	Sequence	1/2
-----	----------	-----

Drawing Title Standard Software Naming Conventions							
		REFERENCE DRAWING		NO.	REVISION-LOCATION		ECN
Sales Engineer	Project Manager	Application Engineer	DRAWN		APPROVED		
Mary Pullo	Jeffrey Loupee	Qusai Alqadi	BY	DATE	BY	DATE	
Project Title Bailly Elem School Nurse Renov Duneland				Branch Information		CONTRACT NUMBER	
				Johnson Controls, Inc. 1500 Huntington Drive Calumet City, IL 60409-5402 Phone: (708) 474-1717 Fax: (708) 474-6551		0N02-0154	
				DRAWING NUMBER			
						00.03-00	


MISC CONTROLS

BILL OF MATERIALS

Designation	Qty	Part Number	Description
PANEL	1	EXISTING PANEL	
CONTROLLER	1	MS-FEC2611-0	EXISTING CONTROLLER
Field Devices:			
EF-C, -S	1	H120	CSR, N.O., 24V, FRAC HP, N.O., SERIES
RH-O	1	SEE VALVE SCHEDULE	

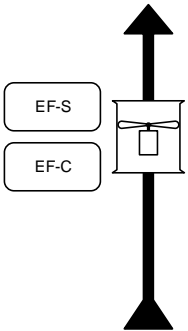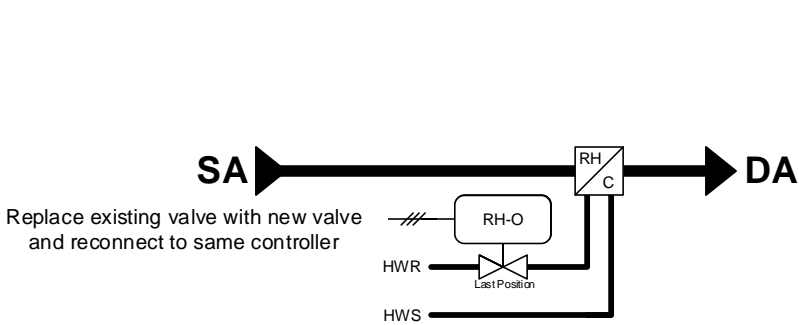

EXHAUST FAN MOTOR WIRING

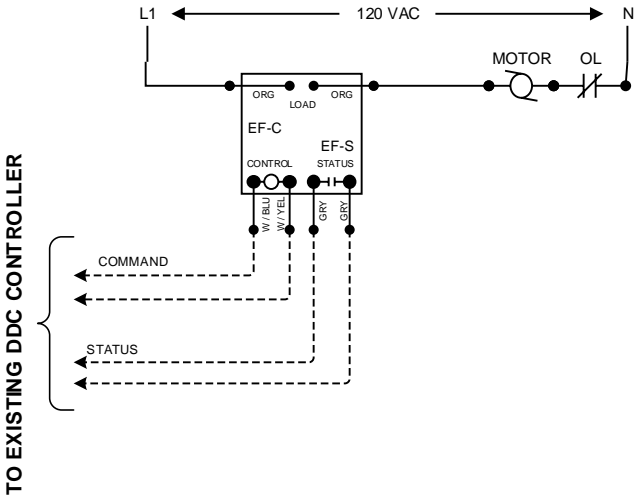


- xxxxxx

SOLID BOX = FIELD DEVICE REQUIRED
(DESIGNATED AS EITHER FIELD OR PANEL IN BOM)
- xxxxxx


DASHED BOX = FIELD CONNECTION POINT ONLY
(DESIGNATED AS OTHER IN BOM)
- xxxxxx

DOTTED BOX = SOFTWARE MAPPED POINT
(DESIGNATED AS OTHER IN BOM)

Drawing Title Misc Controls						
		REFERENCE DRAWING	NO.	REVISION-LOCATION	ECN	DATE
Sales Engineer	Project Manager	Application Engineer	DRAWN	APPROVED		
Mary Pullo	Jeffrey Loupee	Qusai Alqadi	BY	DATE	BY	DATE
Project Title Bailly Elem School Nurse Renov Duneland				Branch Information Johnson Controls, Inc. 1500 Huntington Drive Calumet City IL 60409-5402 Phone: (708) 474-1717 Fax: (708) 474-6551		CONTRACT NUMBER 0N02-0154
				DRAWING NUMBER 02.00-00		

VALVE SCHEDULE

Tag					Valve Information																Actuator Information	
Item	System	Service	Qty.	Ref. Dwg.	<div>Select</div>	Valve Family	Configuration	Fail Position	Inlet Pipe Size (in)	Valve Size (in)	Medium	Flow (gpm or lbs/hr)	Design Delta P (psi)	Valve Delta P (psi)	Design Coefficient (Cv)	Valve Coefficient (Cv)	Design Close Off (psi)	Valve Close Off (psi)	Trim Material	Connection	Code Number	Actuator Control
					Code Number																	
1	RHC	RH-O	1		VG1245AG+943GGA	Ball Valve	2-Way	Valve Closed	3/4	1/2	Water	8.9	4.0	3.6	4.5	4.7	200.0	200.0	Stainless Steel	Threaded	VA9203-GGA-2Z	0-10VDC PROP

Drawing Title Valve Schedule							
		REFERENCE DRAWING	NO.	REVISION-LOCATION	ECN	DATE	BY
Sales Engineer	Project Manager	Application Engineer		DRAWN		APPROVED	
Mary Pullo	Jeffrey Loupee	Qusai Alqadi	BY	DATE	BY	DATE	
Project Title Bailly Elem School Nurse Renov Duneland				Branch Information Johnson Controls, Inc. 1500 Huntington Drive Calumet City, IL 60409-5402 Phone: (708) 474-1717 Fax: (708) 474-6551		CONTRACT NUMBER 0N02-0154	
						DRAWING NUMBER VS-1	