


Notes: MCP fed from panel 25HX in upstairs Mech room. Cir 25,27,29
 East wall Φ 's fed from panel 25L2 in upstairs Mech room. Cir 3
 Sump pump in pit fed from panel 25L2 in upstairs Mech room. Cir 1

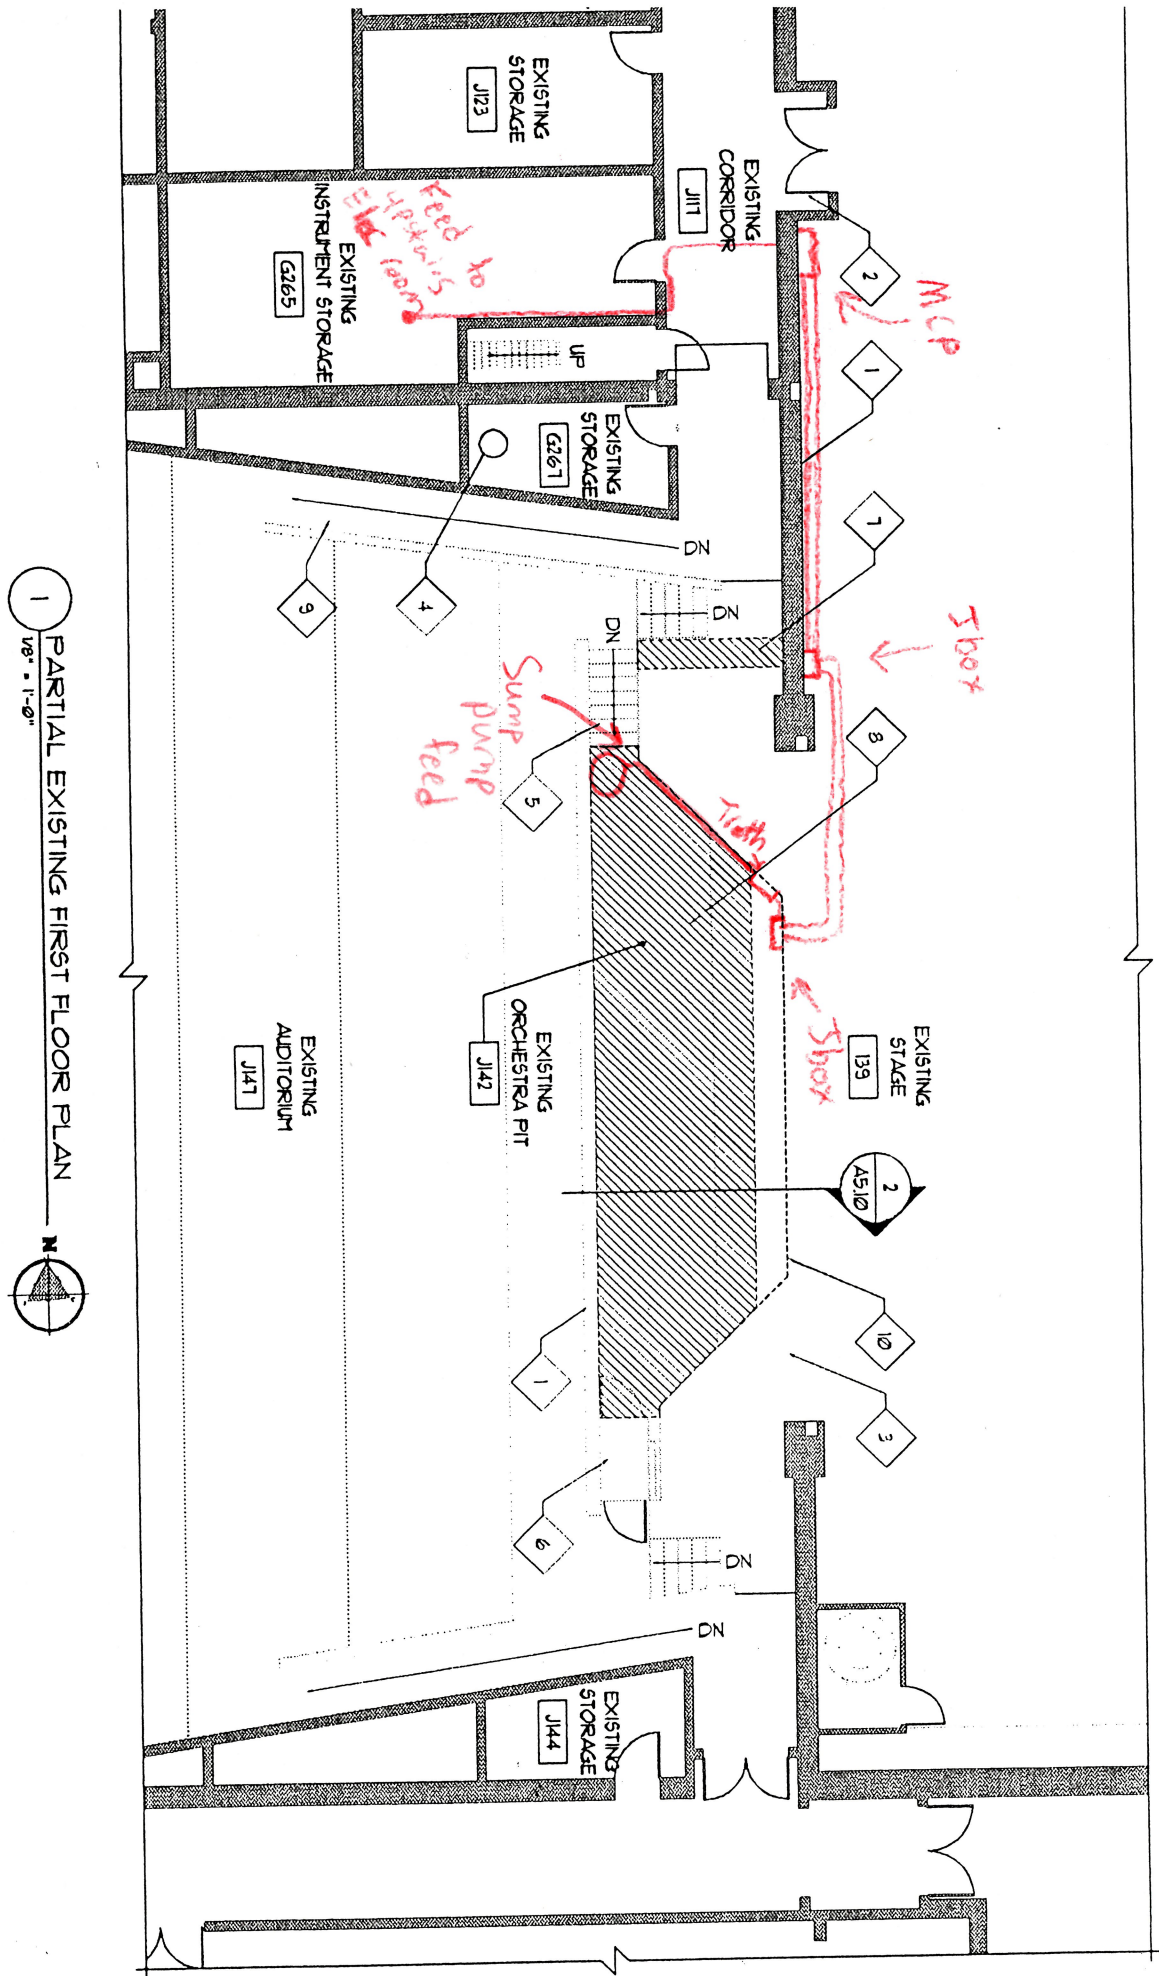

1 PARTIAL EXISTING FIRST FLOOR PLAN
 1/8" = 1'-0"