


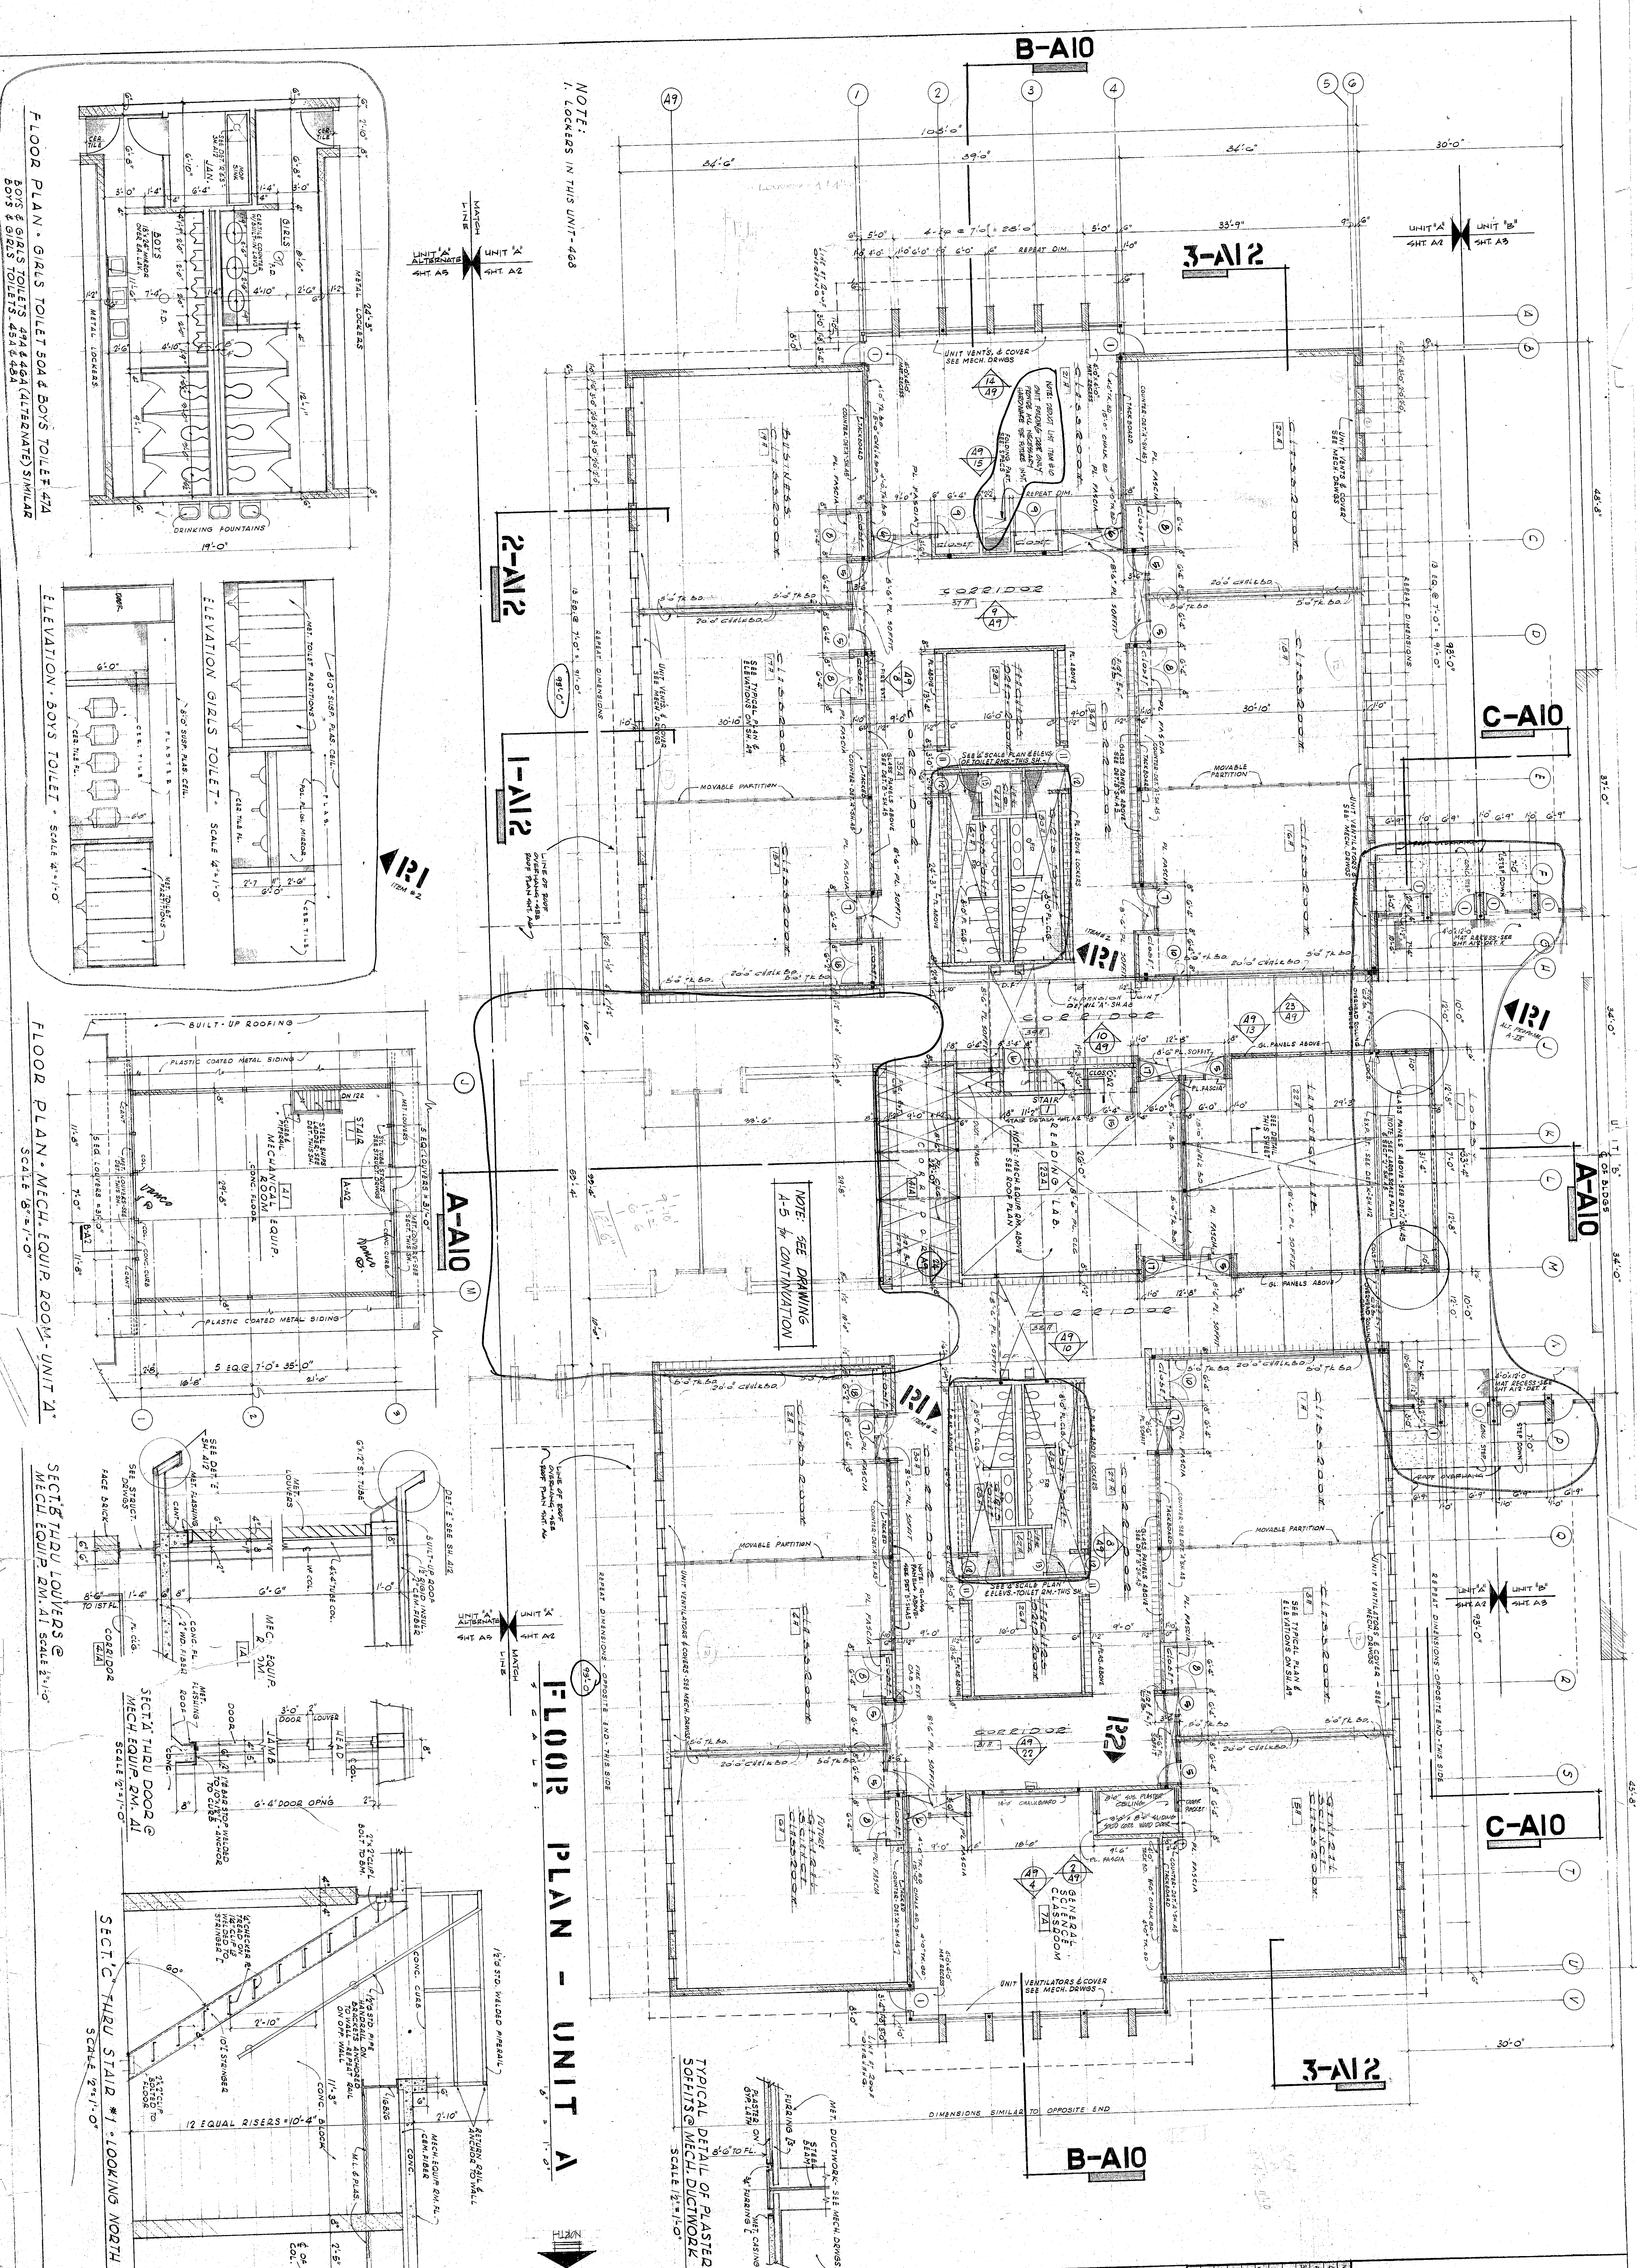

NO	PRINTS & DISTRIBUTION	BY	DATE

[illegible]

WESTCHESTER
TO W N S H I F
JUNIOR HIGH
SCHOOL
FIFTH STREET
CHESTERTON INDIAN
FOR
THE
WESTCHESTER TOWNSHIP
SCHOOL BUILDING C

THE
Perkins
& Will
PARTNERSHIP

ARCHITECTS

1100 NORTH LAKE SHORE
CHICAGO, ILLINOIS 60606
PHONE 312-321-9000

ARCHITECTURA

DRAWN BY
PROJECT NO. 2169003
DATE 12/2/83
CHECKED BY SUPERVISOR
DEPT. HEAD, SUPERVISOR

A

