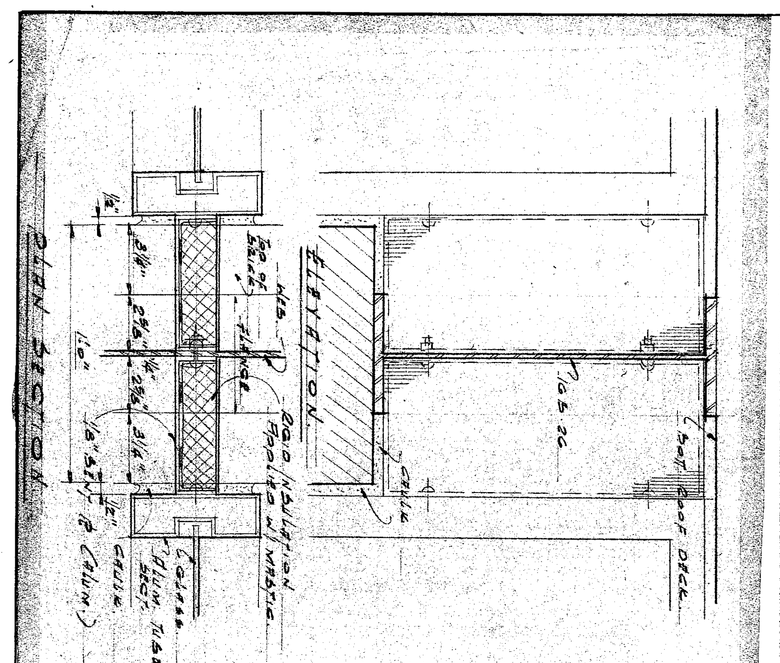

DETAIL - FILLER PANELS & BMS. @ ENTRIES
SCALE 3" = 1'-0"
SUPPLEMENTARY DRWG. NO. 1
WESTCHESTER JR HIGH SCHOOL
CHESTERTON, INDIANA
THE PERKINS & WILL PARTNERSHIP
CHICAGO, ILLINOIS
JOB. NO. 21690-3 7/7/65

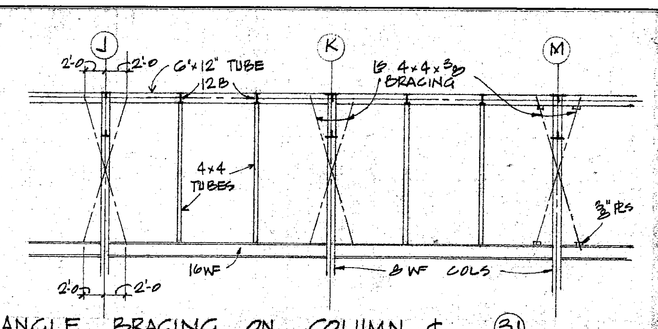

ANGLE BRACING ON COLUMN ℄ 31

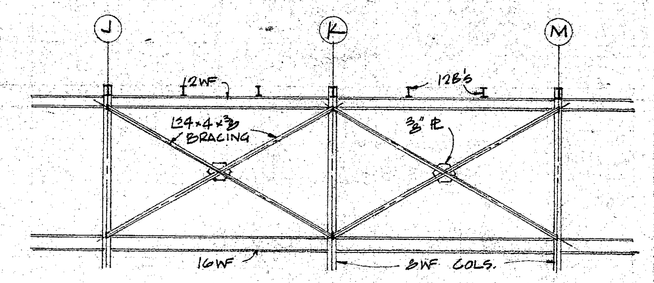

ANGLE BRACING ON COLUMN ℄ 26

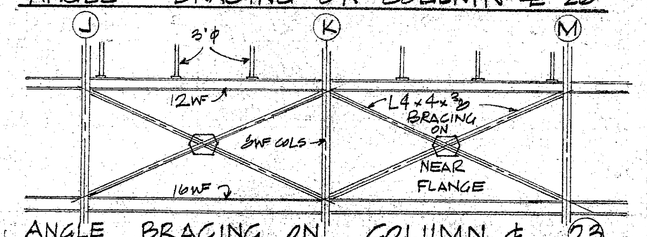

ANGLE BRACING ON COLUMN ℄ 23

SUPPLEMENTARY DRWG NO. 4 SCALE 3/8" = 1'-0
WESTCHESTER J.H.S. the PERKINS & WILL PARTNERSHIP
CHESTERTON, ILLINOIS # 21690-4 7-14-65 CHICAGO, ILLINOIS

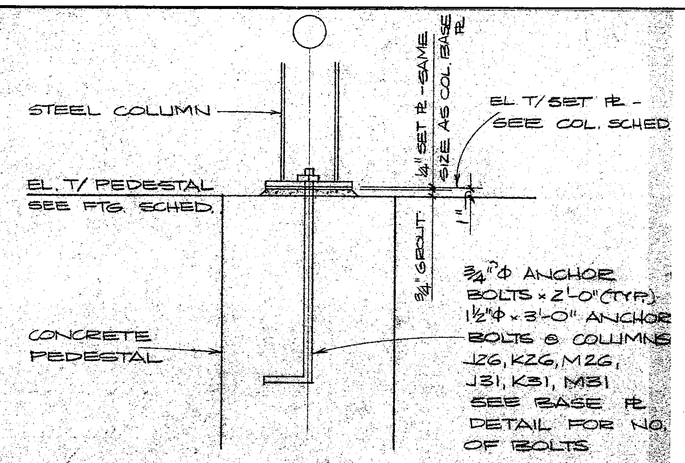

TYPICAL COL. BASE PL DETAIL
SCALE: 1" = 1'-0"

SUPPLEMENTARY DRWG. NO. 5
WESTCHESTER JR. HIGH SCHOOL
CHESTERTON, INDIANA
THE PERKINS & WILL PARTNERSHIP
CHICAGO, ILLINOIS
JOB NO. 21690-4 7/14/65

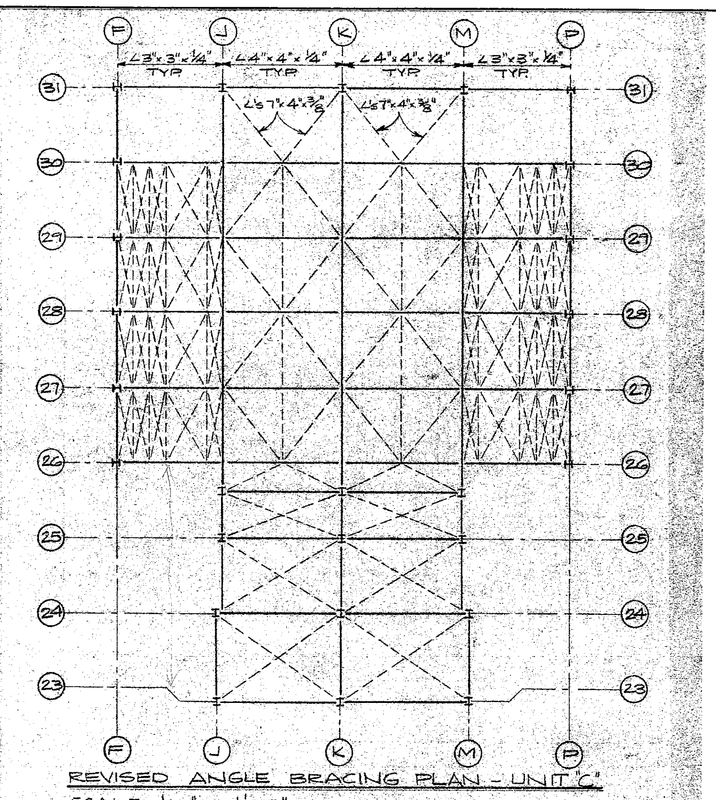

REVISED ANGLE BRACING PLAN - UNIT "C"
SCALE 1/16" = 1'-0"
SUPPLEMENTARY DRWG. NO. 6
WESTCHESTER JR. HIGH SCHOOL
CHESTERTON INDIANA
THE PERKINS & WILL PARTNERSHIP
CHICAGO ILLINOIS
JOB NO. 21690-4 7/14/65

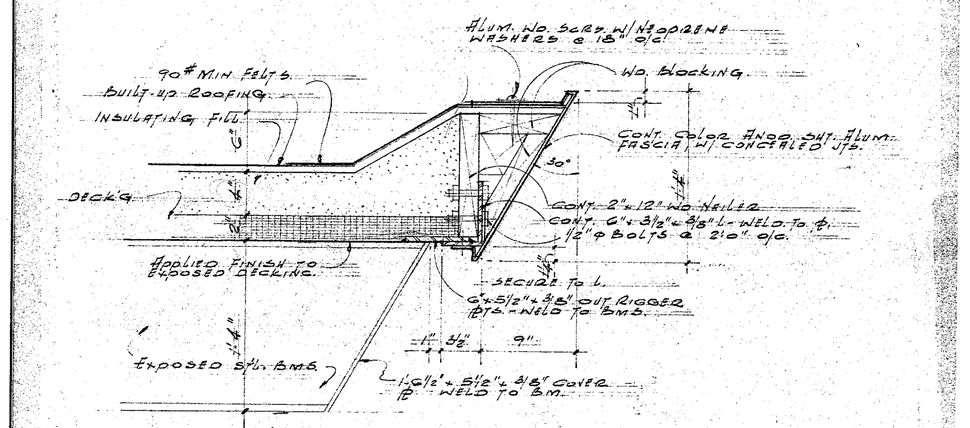

DETAIL SECTION
REVISED FASCIA MATERIAL & METHOD OF ATTACHMENT
SCALE 1 1/2" = 1'-0"
SUPPLEMENTARY DRWG # 2 ADDENDA # 1 7/7/65 E.G.
WESTCHESTER JR HIGH SCHOOL
CHESTERTON, INDIANA
THE PERKINS & WILL PARTNERSHIP
CHICAGO, ILLINOIS

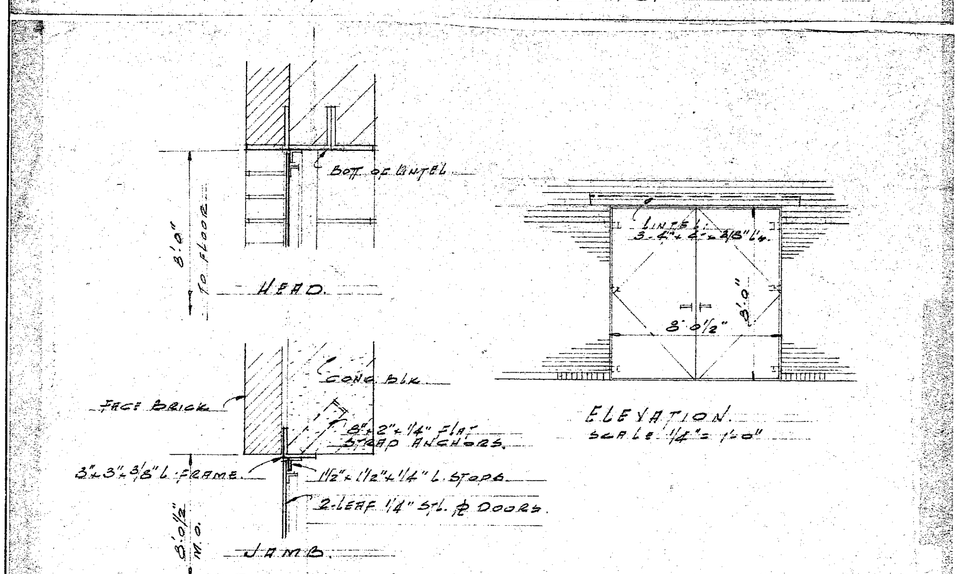

DETAILS - ACCESS DOORS TO BOILER RM.
SCALE 1/2" = 1'-0"

WESTCHESTER JR. HIGH SCHOOL - JOB. NO. 21690-3.
SUPPLEMENTARY DRWG. NO. 3 7-7-65
SUPPLEMENTARY. E.G.

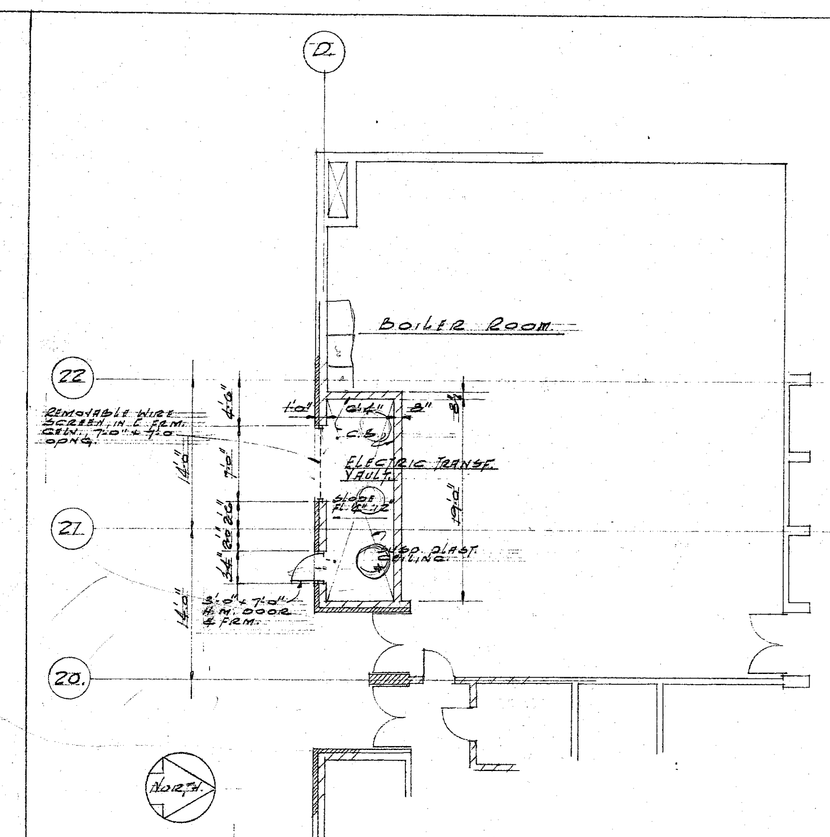

PARTIAL PLAN - BOILER RM.
SHOWING TRANSFORMER VAULT
SCALE 1/8" = 1'-0"

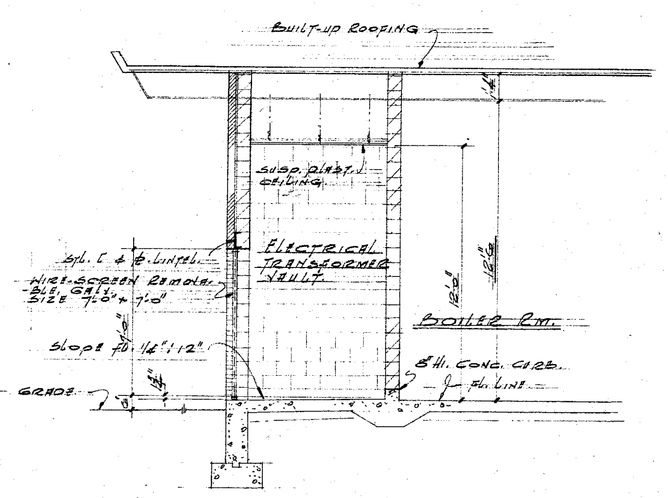

SECTION @ "A-1"
SCALE 1/8" = 1'-0"

ELECTRIC TRANSFORMER VAULT
SUPPLEMENTARY DRAWING NO. 5
Job No. 21690-4 7/2/65 E.G.
WESTCHESTER TOWNSHIP JR. H. SCHOOL
CHESTERTON INDIANA
THE PERKINS & WILL PARTNERSHIP
CHICAGO, ILLINOIS

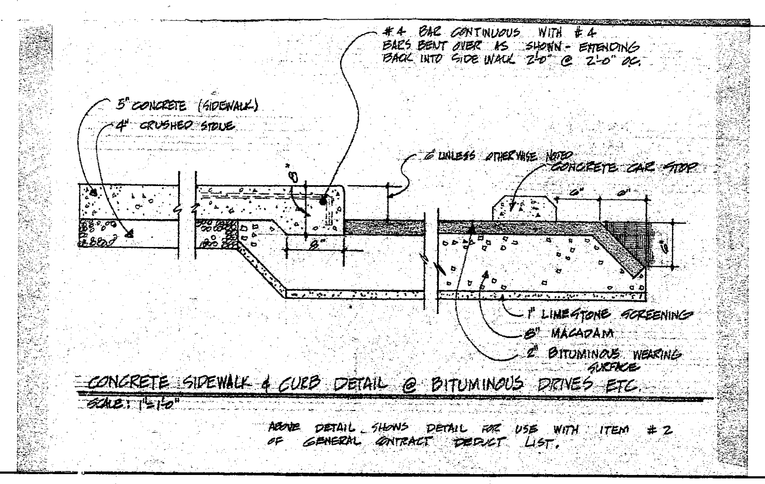

CONCRETE SIDEWALK & CURB DETAIL @ BITUMINOUS DRIVES ETC.
SCALE: 1" = 1'-0"


NO	PRINTS & DISTRIBUTION	BY	DATE
I	BLDG. COMM. APPROVAL	JJC	11-10-65
I	MR. NELSON'S REVIEW	JJC	11-15
II	8-6C, 2-STEMP, 1-PMW	JJC	11-16

NO	REVISIONS - THUS △	BY	DATE

WESTCHESTER TOWNSHIP JUNIOR HIGH SCHOOL
FIFTH STREET
CHESTERTON INDIANA
FOR THE
WESTCHESTER TOWNSHIP SCHOOL BUILDING CORP.

THE Perkins & Will PARTNERSHIP
ARCHITECTS
309 West Jackson Blvd
Chicago Illinois 60606
Phone 312-427-9300

CHESTER L. STEMP & ASSOCIATES
ASSOCIATE ENGINEERS
132 North Calumet Road
Chesterton, Indiana 46304
Phone 219-926-1790

DATE NOV. 1, 1965
PROJECT NO. 21960
DRAWN BY
CHECKED BY CLEMENCY
DEPT. HEAD THEMAN
PROJ. ARCH. BENGELS

A-14

65-P-14