

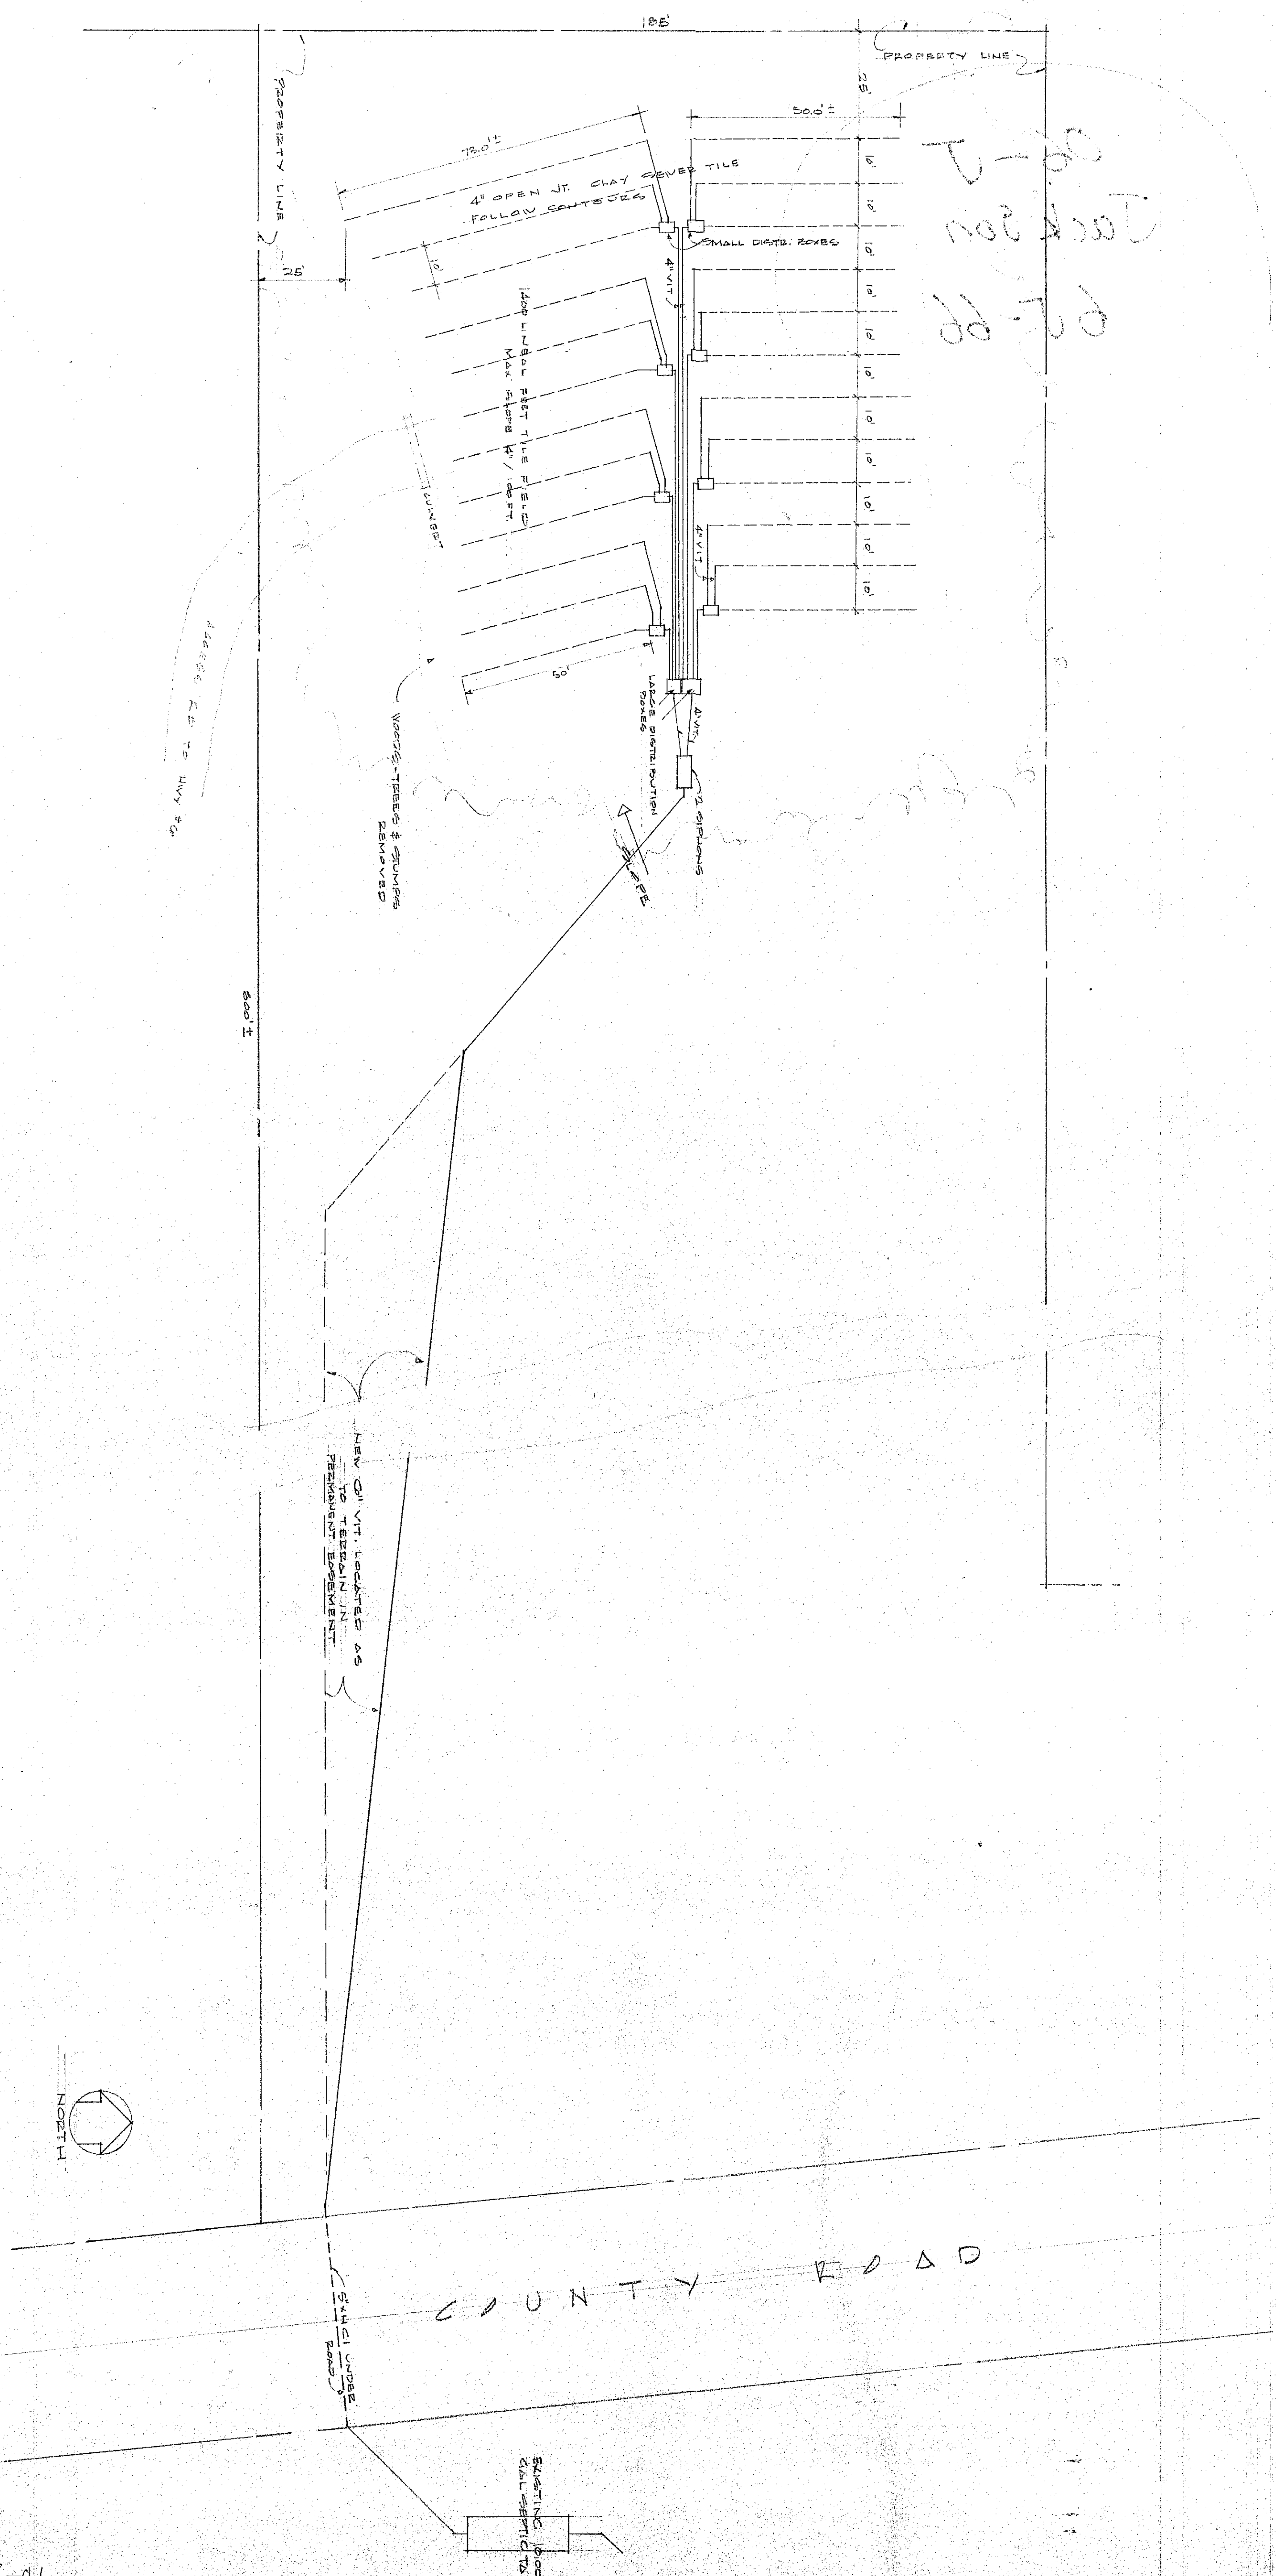


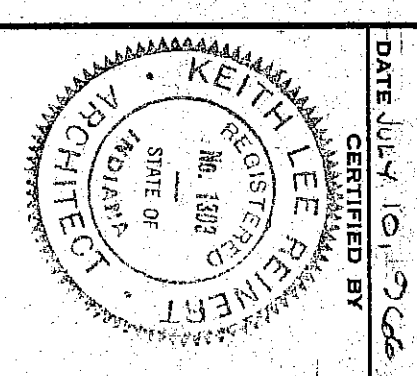

66-200
not shown
66-200

SITE PLAN

SCALE: 1" = 20'

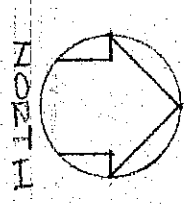

CERTIFIED BY: KEITH L. REINERT
TITLE: FIELD
JACKSON TWP SCHOOLS
SHEET 2 OF 2
PORTER COUNTY, INDIANA
KEITH L. REINERT, AIA
FRANK SCHUTT ASSOCIATES
ARCHITECTS & PLANNERS
THIRD & WISCONSIN ST. HOBART, IND.

66-C-01