


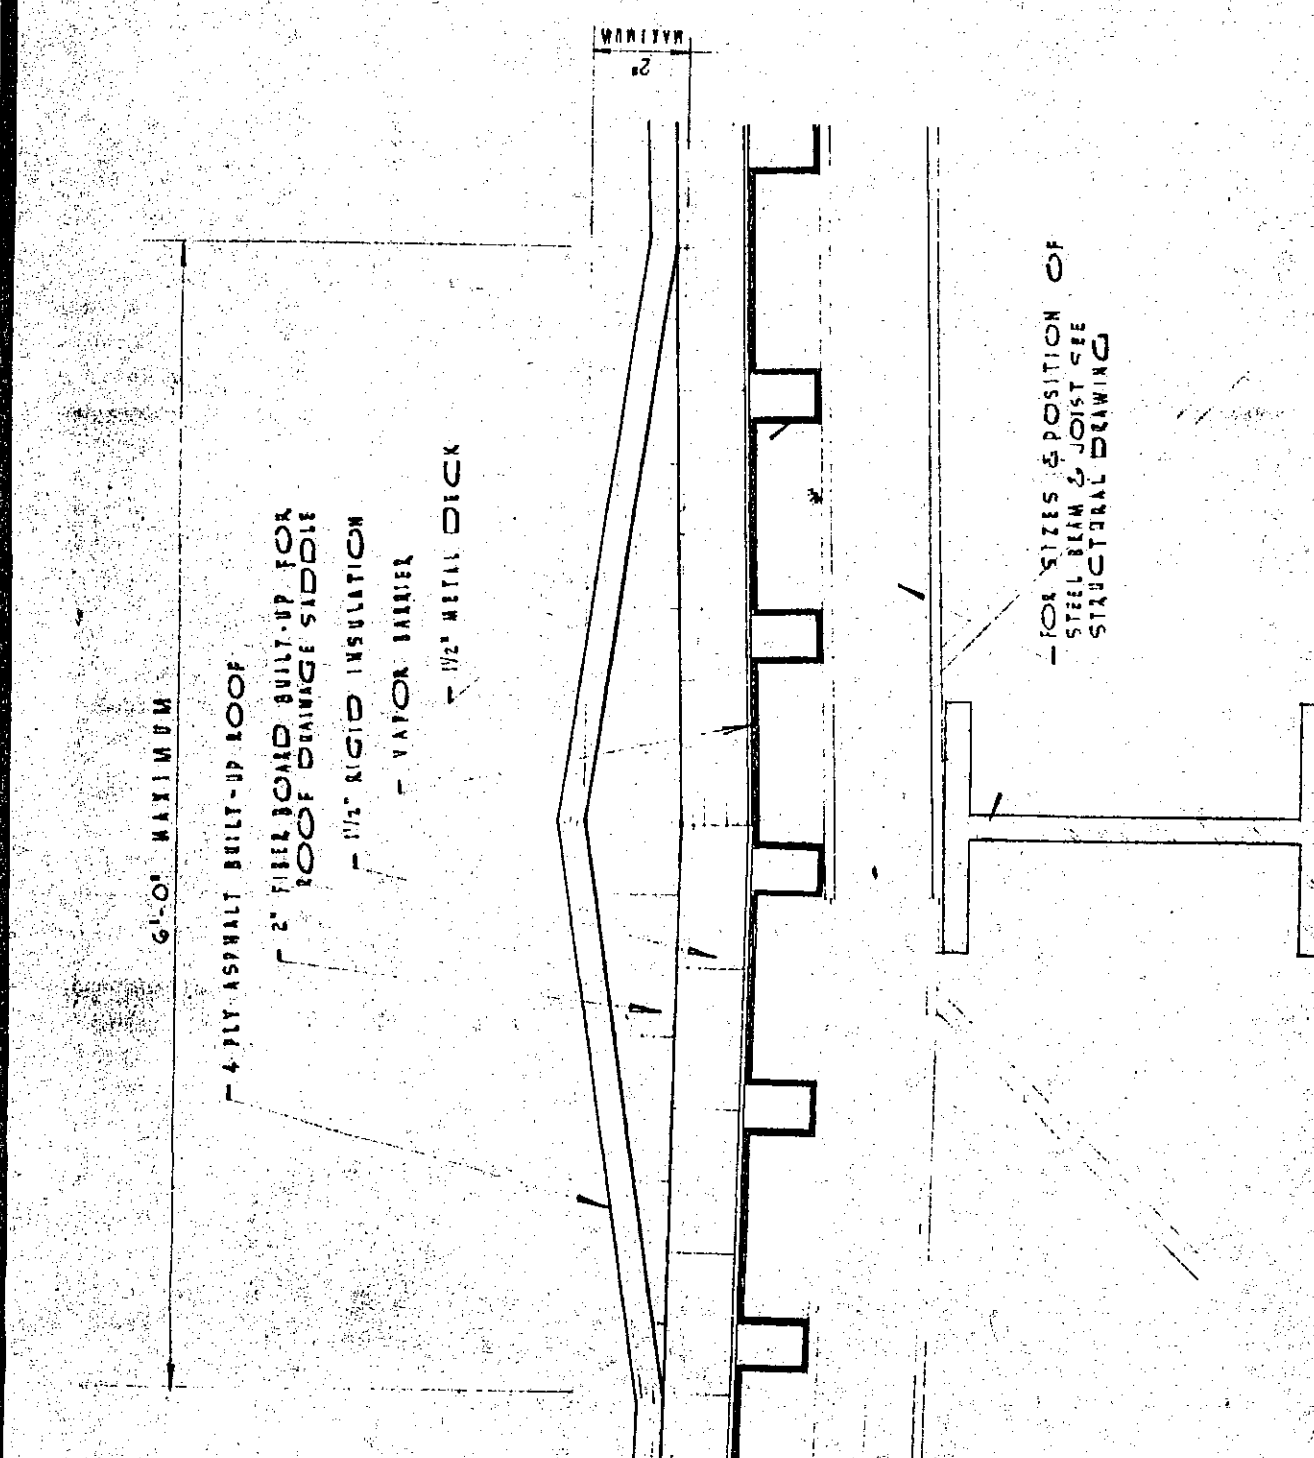


ROOF PLAN
SCALE: 1/8" = 1'-0"




ROOF PLAN
SCALE: 1/8" = 1'-0"

EXISTING FLAT ROOF

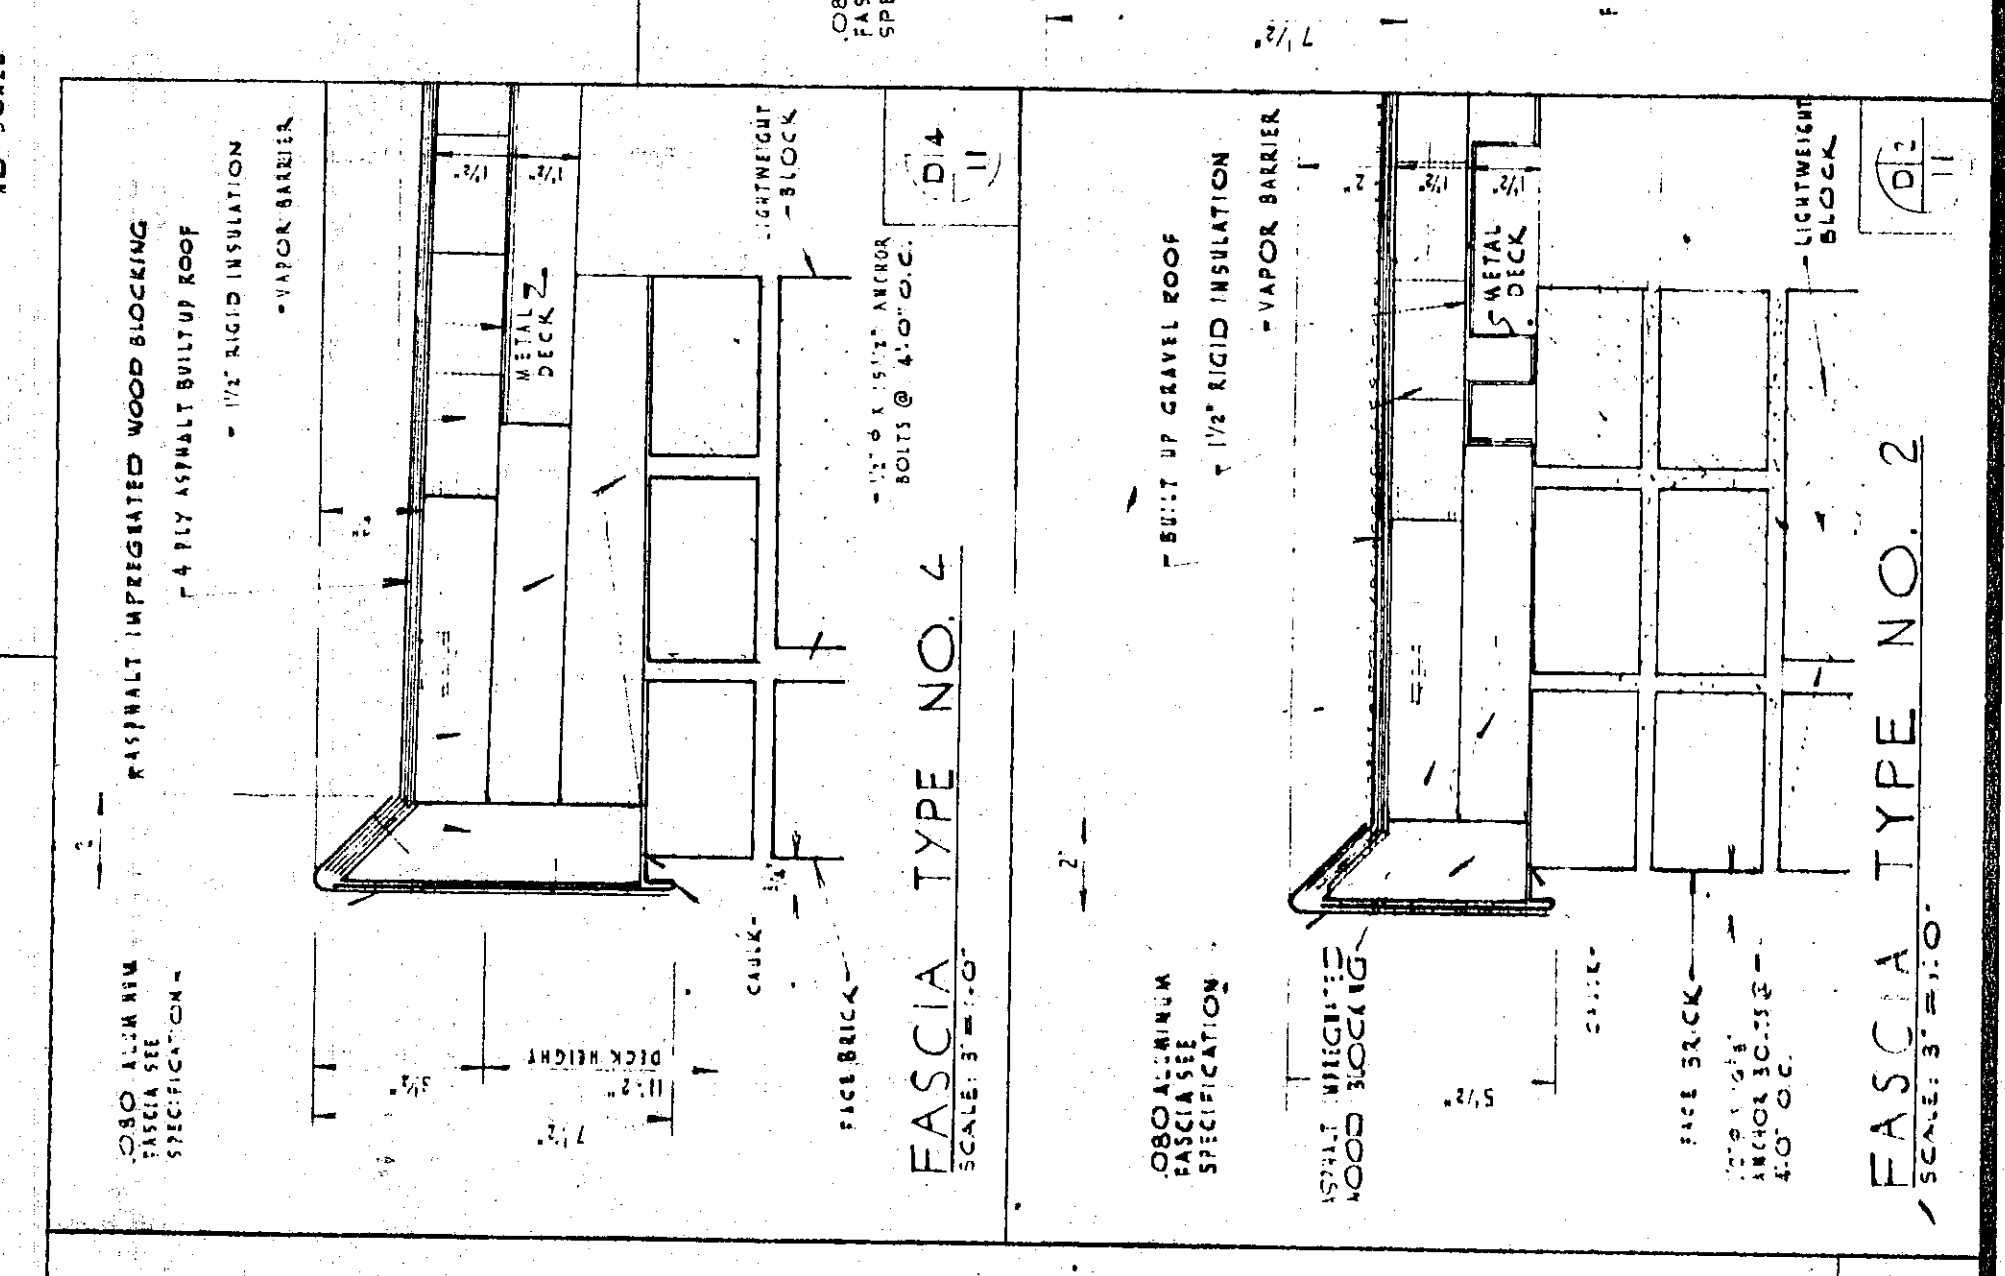



FASCIA TYPE NO. 2

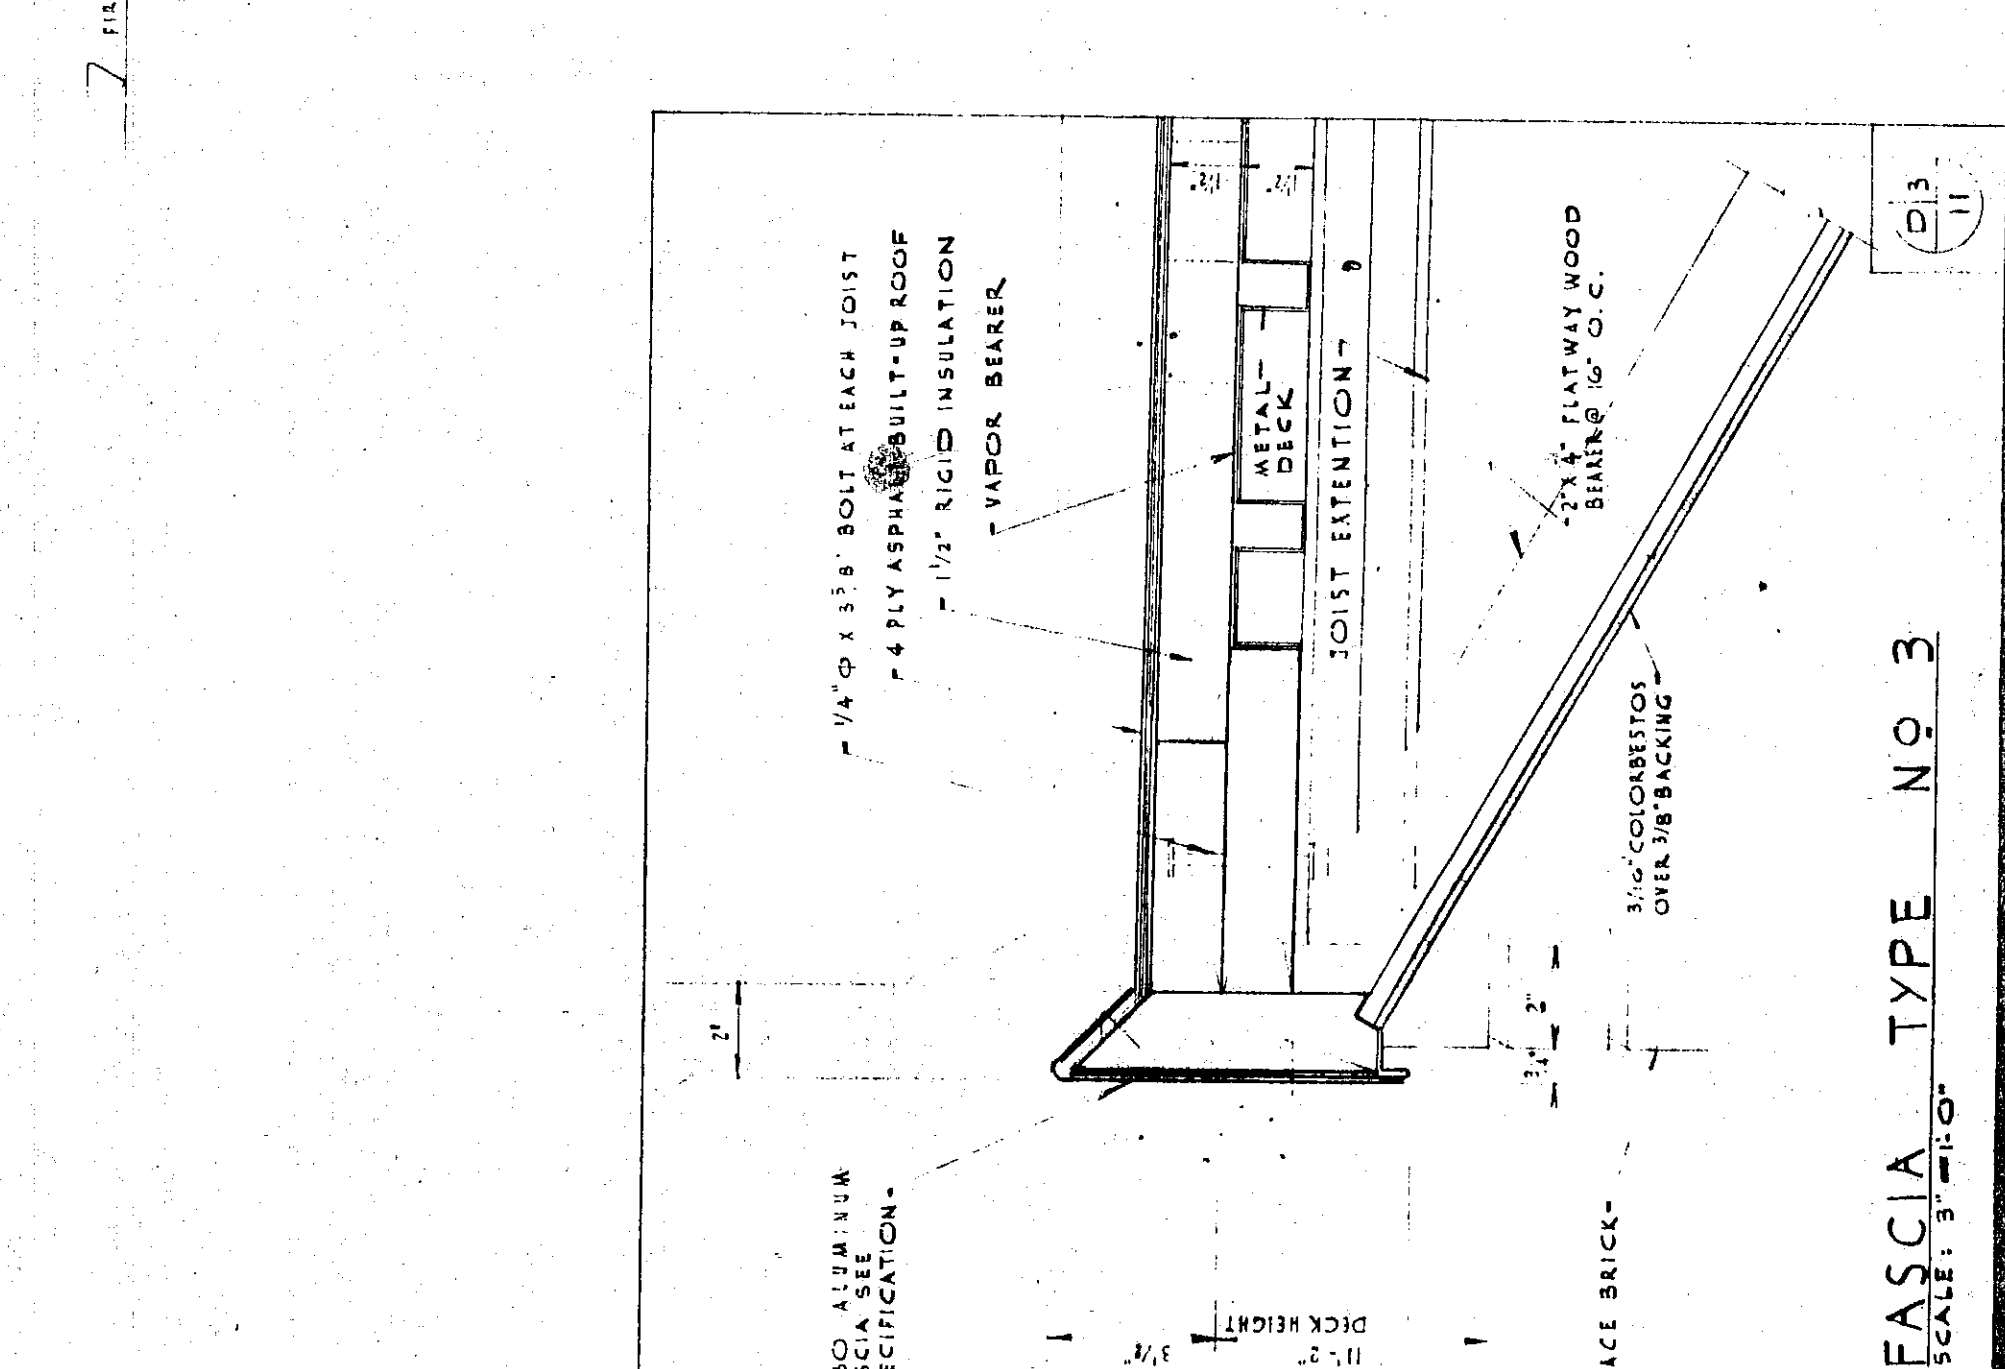


FASCIA TYPE NO. 3



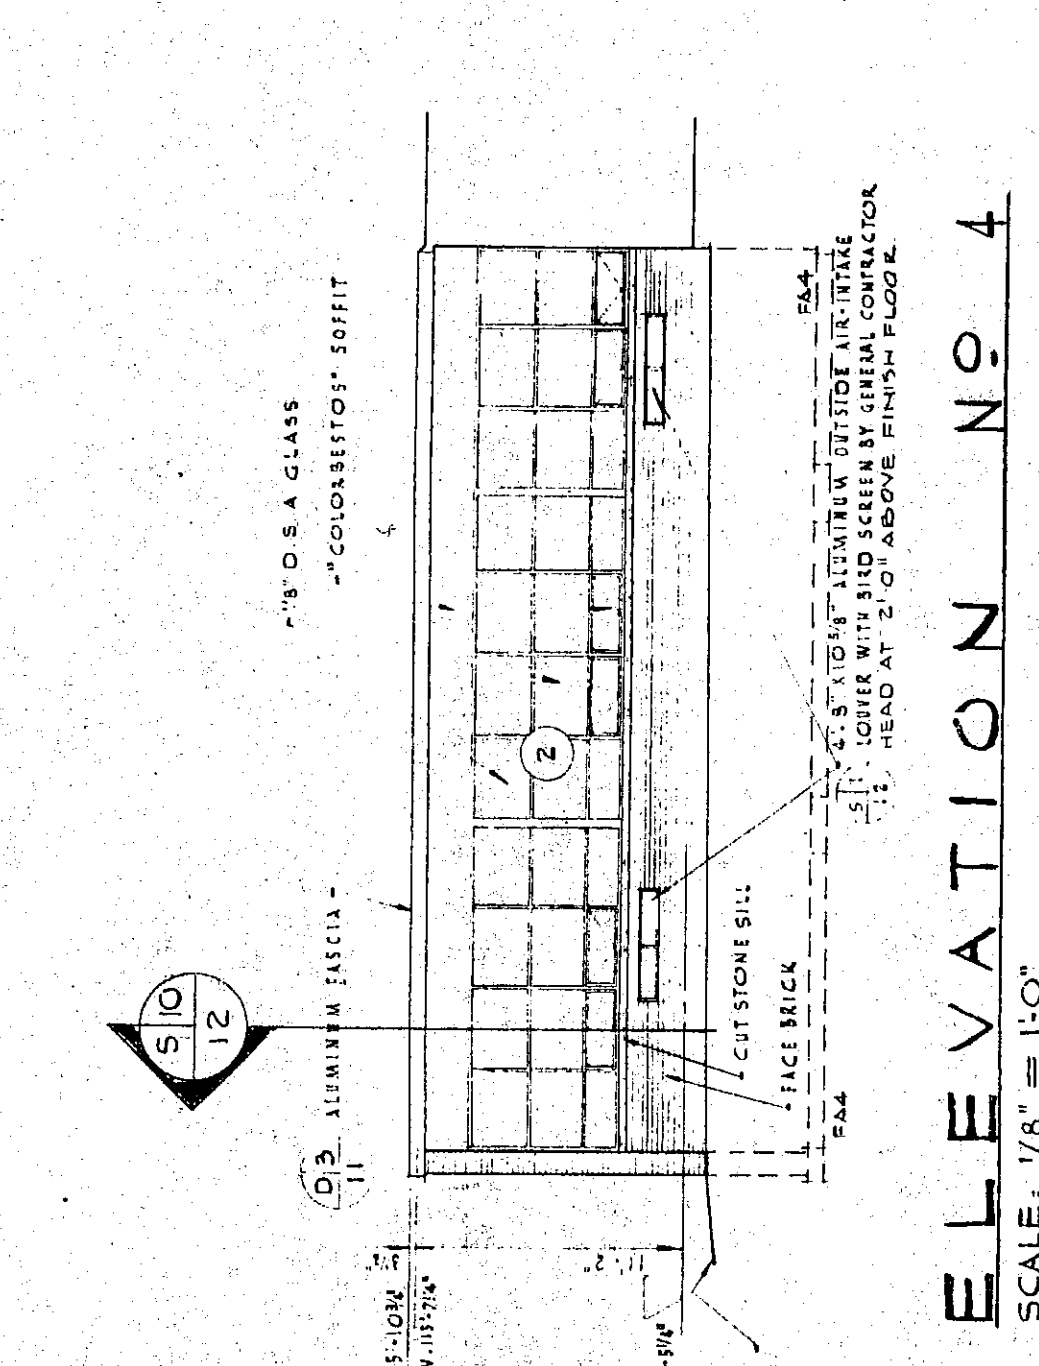


ELEVATION NO. 4
SCALE: 1/8" = 1'-0"

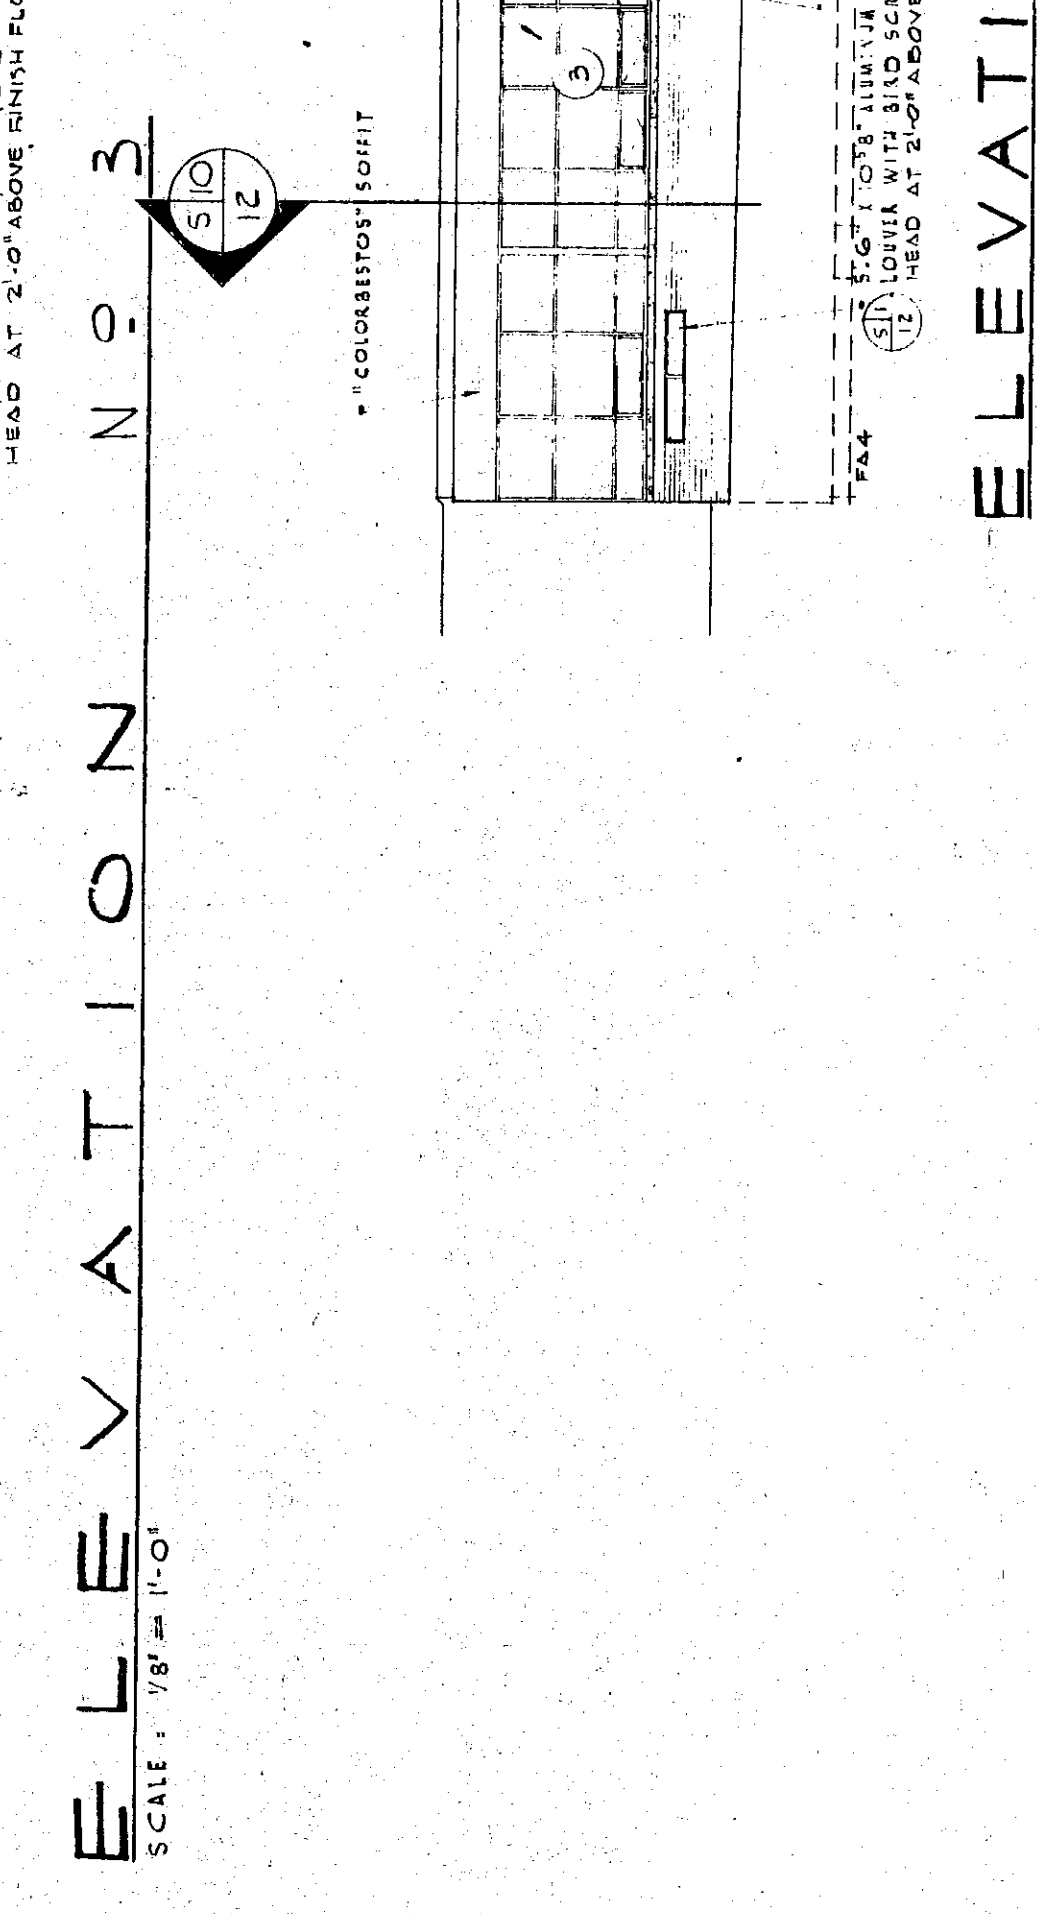


ELEVATION NO. 3
SCALE: 1/8" = 1'-0"

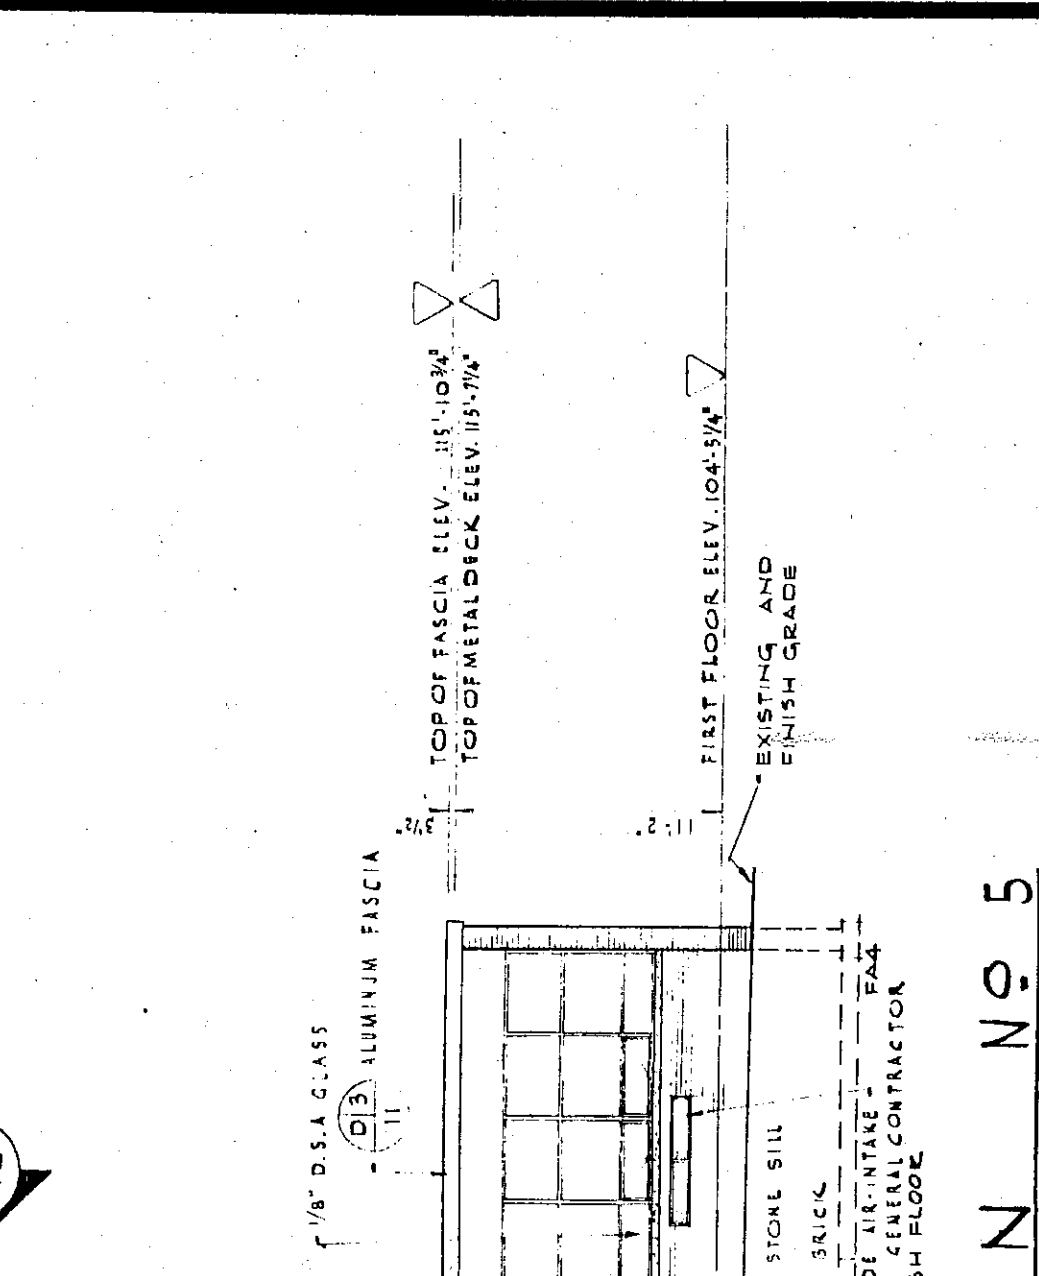

ELEVATION NO. 2
SCALE: 1/8" = 1'-0"

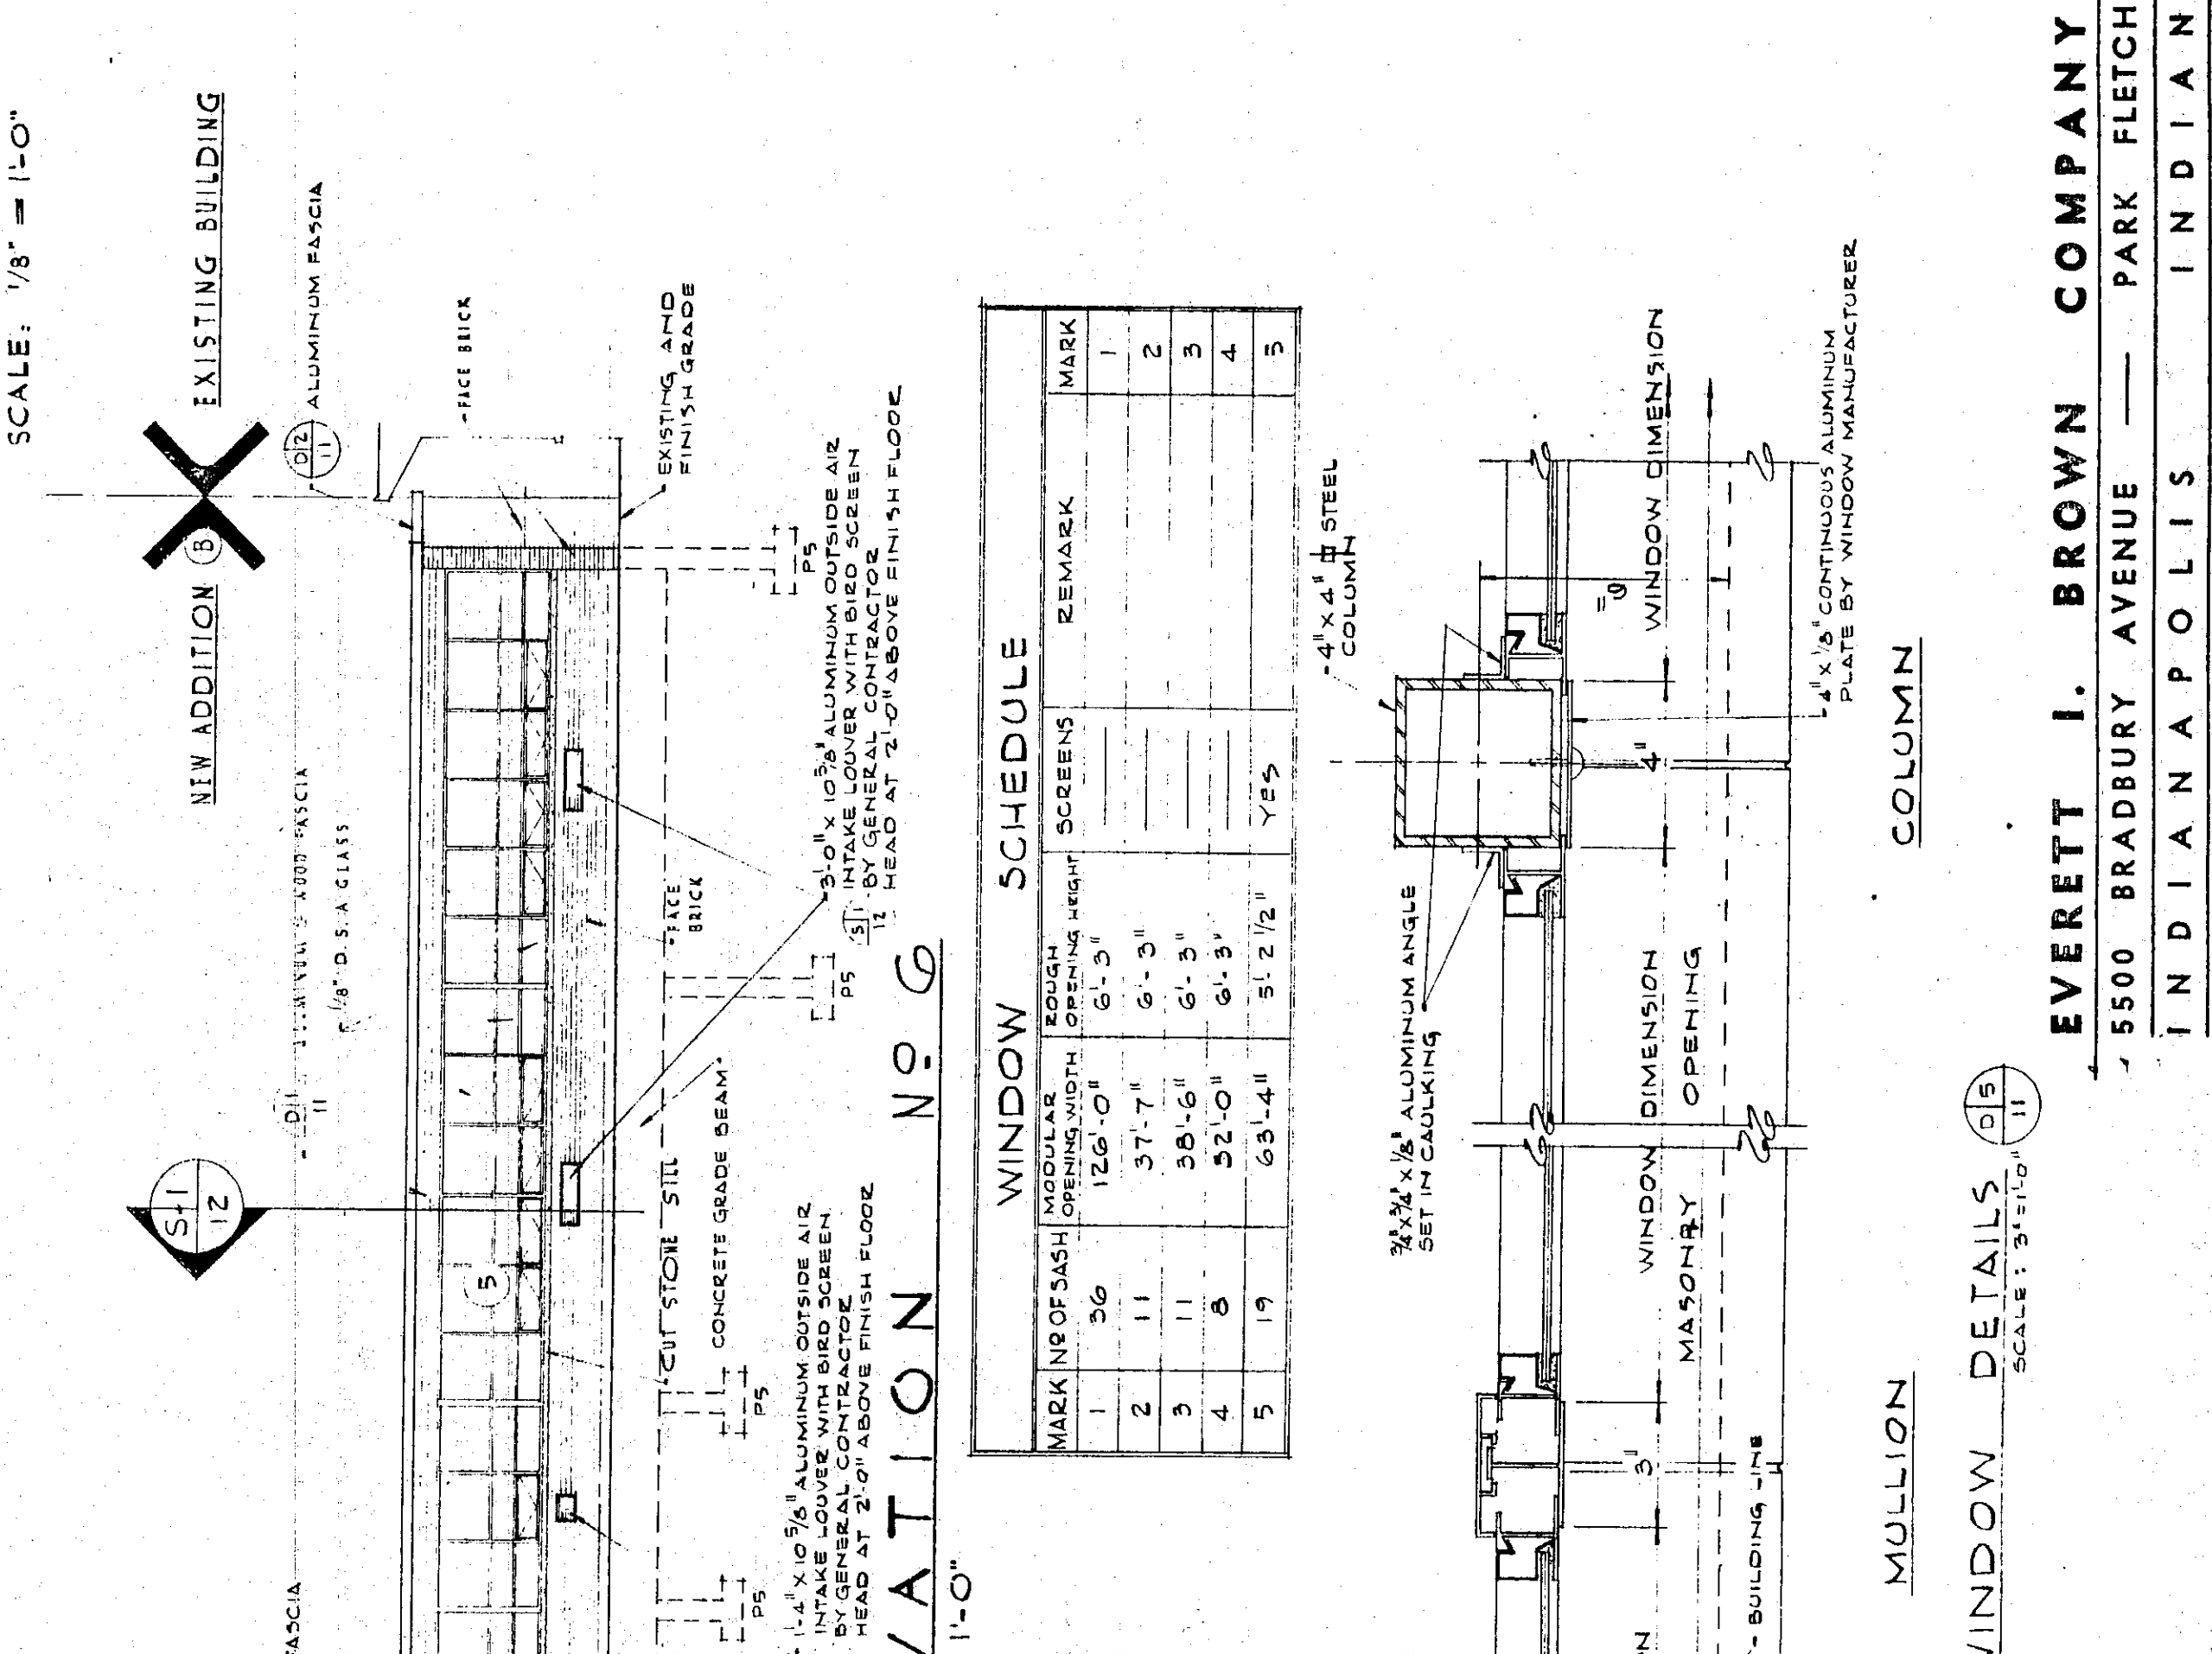


ELEVATION NO. 1
SCALE: 1/8" = 1'-0"

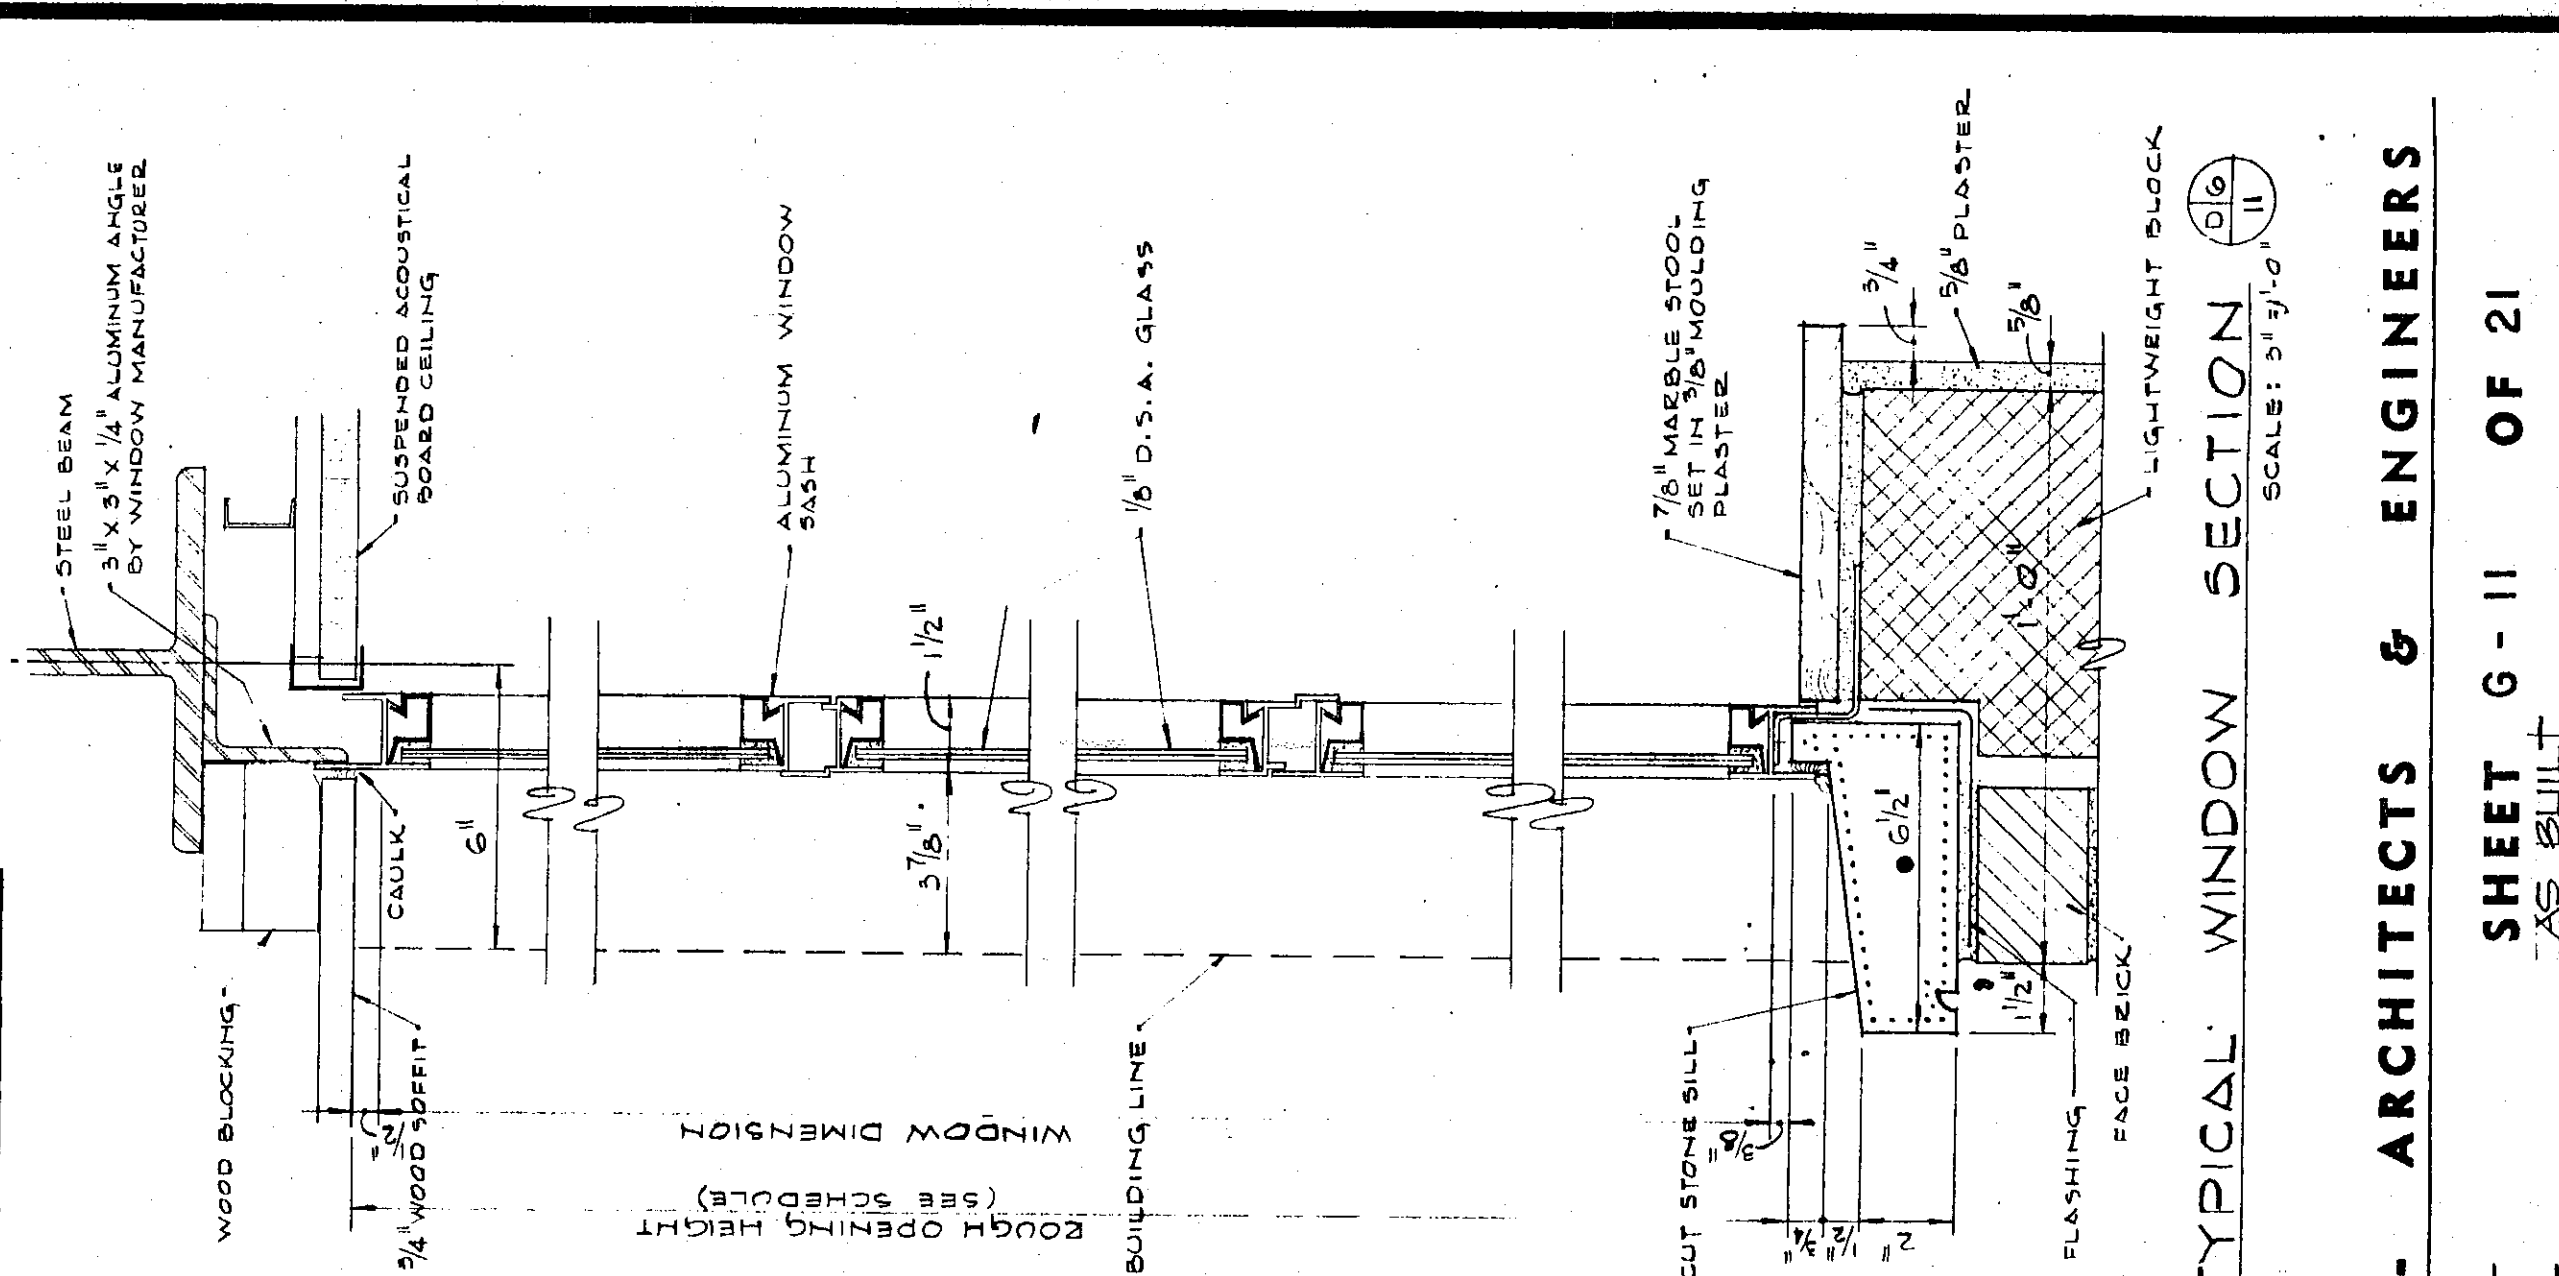

ELEVATION NO. 5
SCALE: 1/8" = 1'-0"

WINDOW SCHEDULE


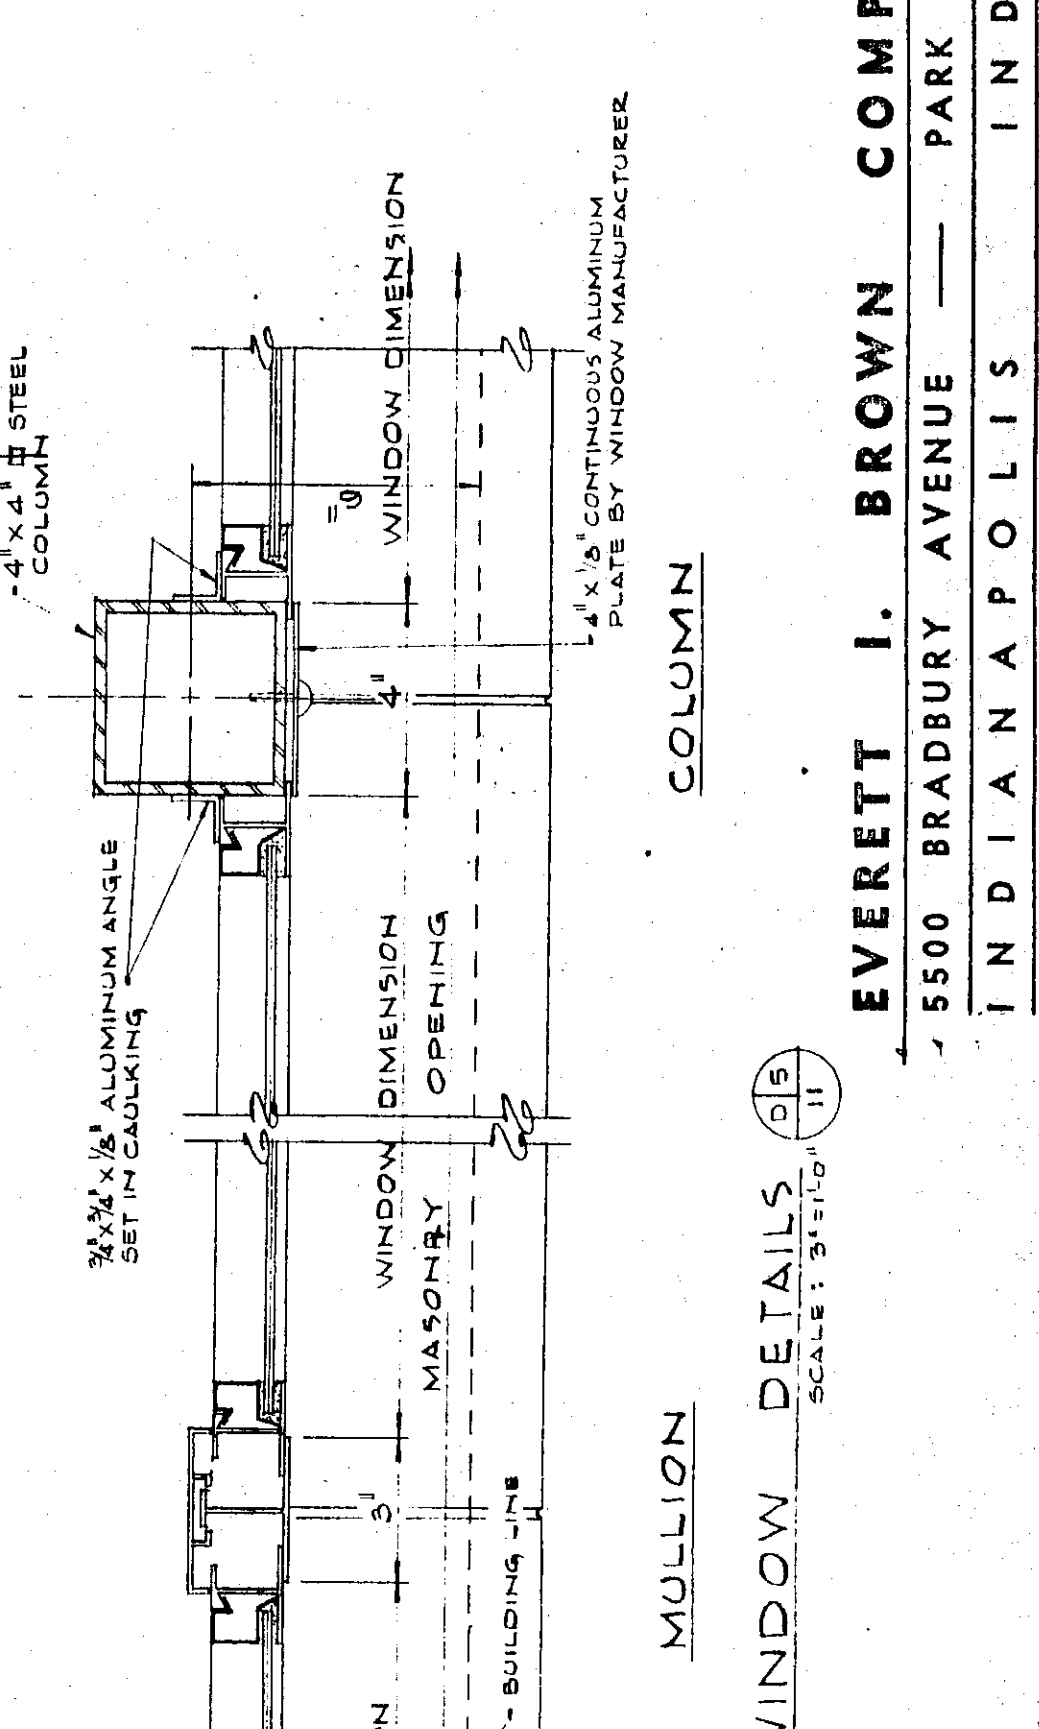

TYPICAL WINDOW SECTION
