SEATING SUMMARY LECTURE B-234	
EACH TABLE HAS 2 SEATS	
NUMBER 50' TABLES	10
NUMBER 52' TABLES	10
NUMBER 54' TABLES	12
NUMBER 56' TABLES	10
NUMBER 58' TABLES	9
NUMBER 60' TABLES	2
TOTAL TABLES	61
TOTAL CHAIRS	122

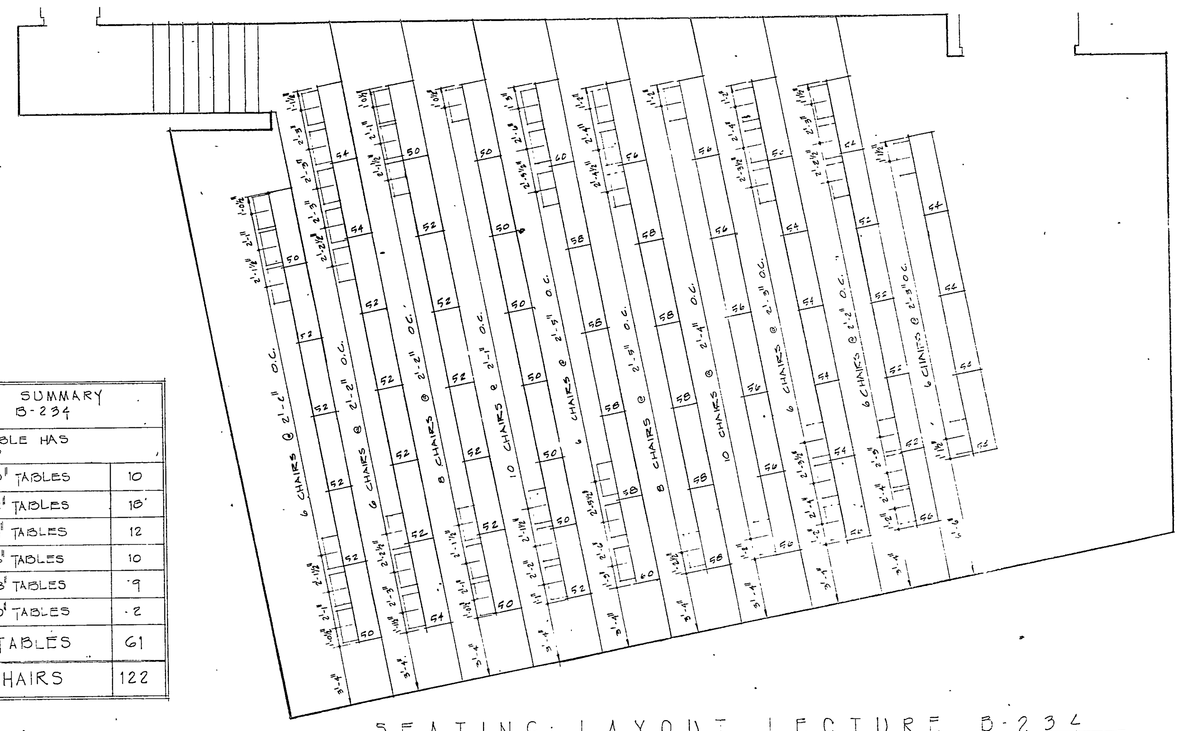

SEATING LAYOUT LECTURE B-234

SCALE: 1/8" = 1'-0"

FOR LECTURE ROOM CHAIRS & TABLES SEE DIVISION #9 OF SPECIFICATIONS

FOYER B-118

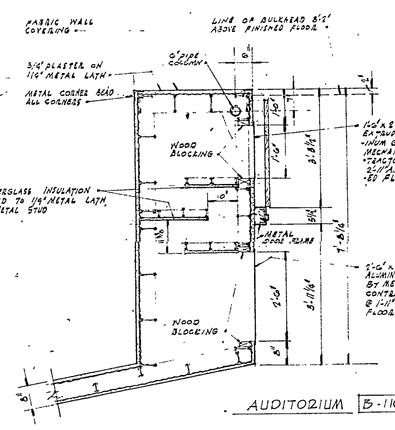

AUDITORIUM B-116

RELIEF AIR CHASE

SCALE 1/2" = 1'-0"

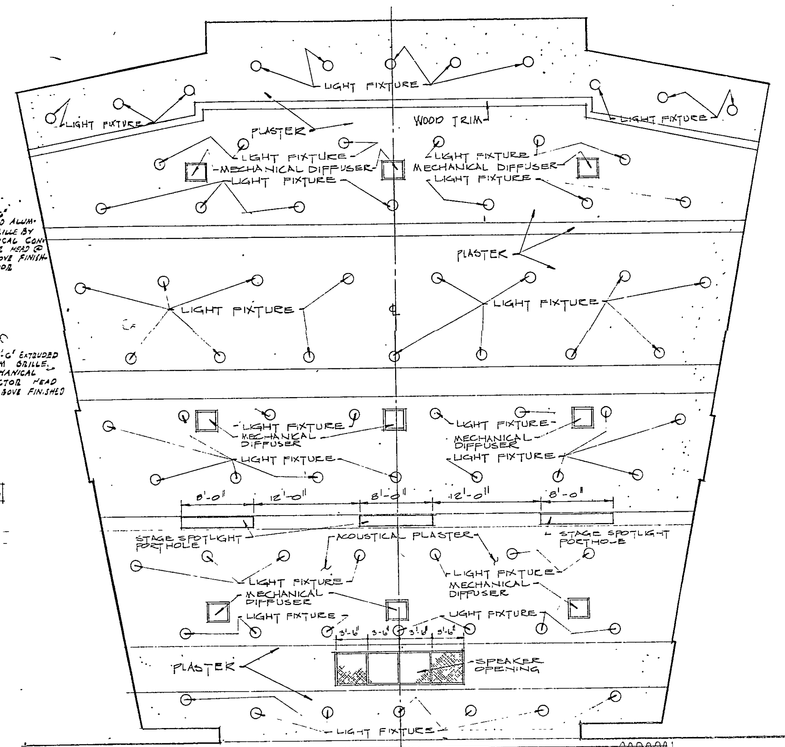

REFLECTED CEILING PLAN AUDITORIUM B-116

STAGE RIGGING PLAN STAGE B-113

SCALE 1/8" = 1'-0"

FOR STAGE RIGGING SEE DIVISION #11 OF SPECIFICATIONS

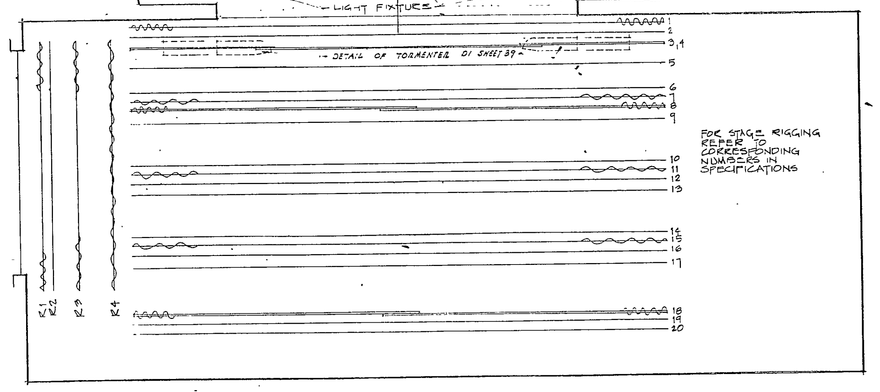

AUDITORIUM CHAIR SUMMARY	
NUMBER OF 20" CHAIRS	288
NUMBER OF 21" CHAIRS	157
NUMBER OF 22" CHAIRS	161
TOTAL	606

✧ LOCATION SYMBOL FOR LIGHT BY SEATING CONTRACTOR

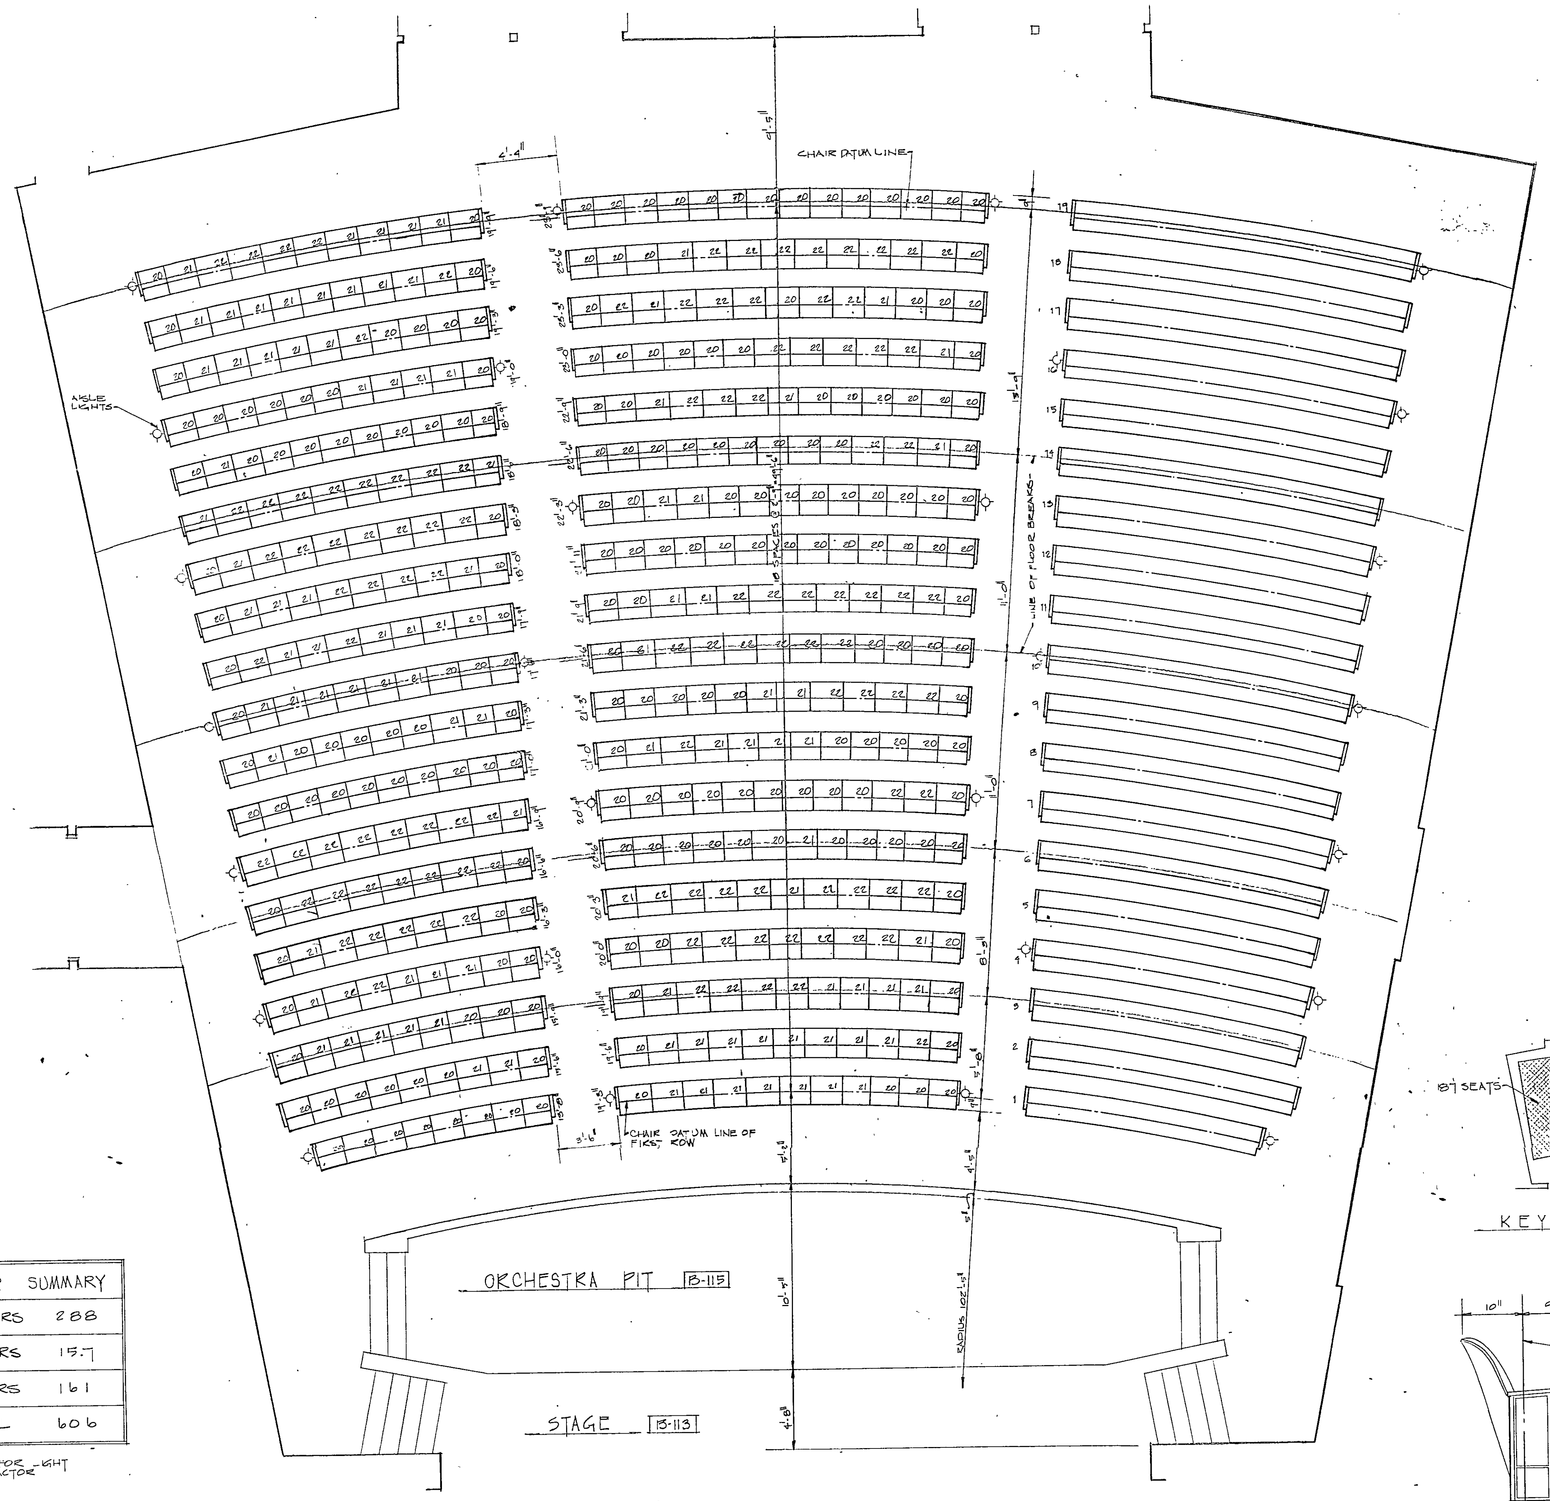

ORCHESTRA PIT B-115

STAGE B-113

SEATING LAYOUT AUDITORIUM B-116

SCALE 1/8" = 1'-0"

NOTE: CHAIR ROW LENGTH DIMENSIONS INCLUDE AN ALLOWANCE OF 2" AT EACH END OF THE ROW FOR THE END STANDARD. FOR AUDITORIUM CHAIRS SEE DIVISION #9 OF SPECIFICATIONS

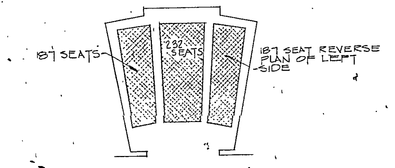

KEY PLAN

NO SCALE

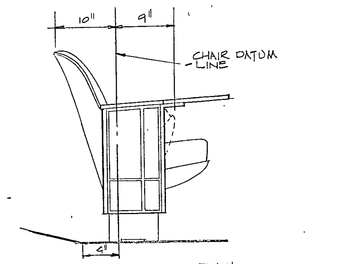

DATUM LINE DETAIL

NO SCALE

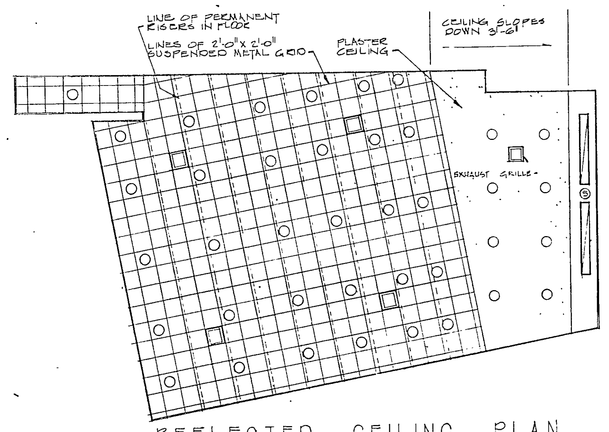

REFLECTED CEILING PLAN LECTURE B-234

SCALE 1/8" = 1'-0"

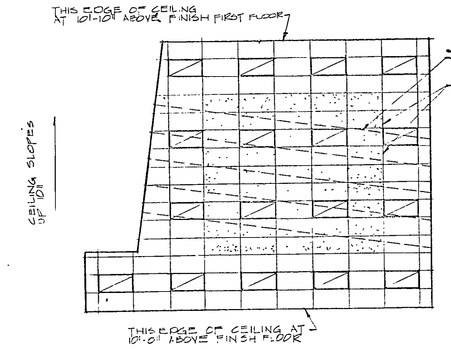

REFLECTED CEILING PLAN CHORAL B-139

SCALE 1/8" = 1'-0"

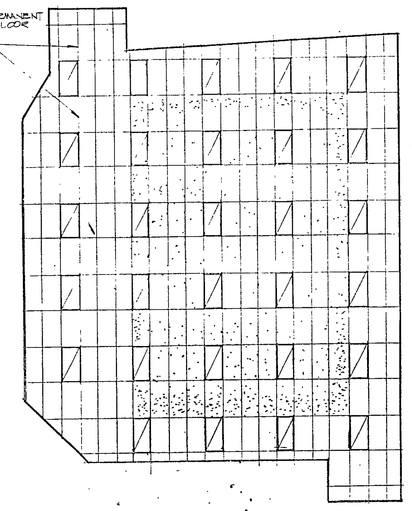

REFLECTED CEILING PLAN INSTRUMENTAL B-106

SCALE 1/8" = 1'-0"

KEY TO SYMBOLS

- LIGHT FIXTURE
- 2'-0" x 4'-0" GYPSUM BOARD LAY IN CEILING
- 2'-0" x 4'-0" ACOUSTICAL BOARD LAY IN CEILING
- SPEAKER
- LIGHT FIXTURE
- MECHANICAL DIFFUSER

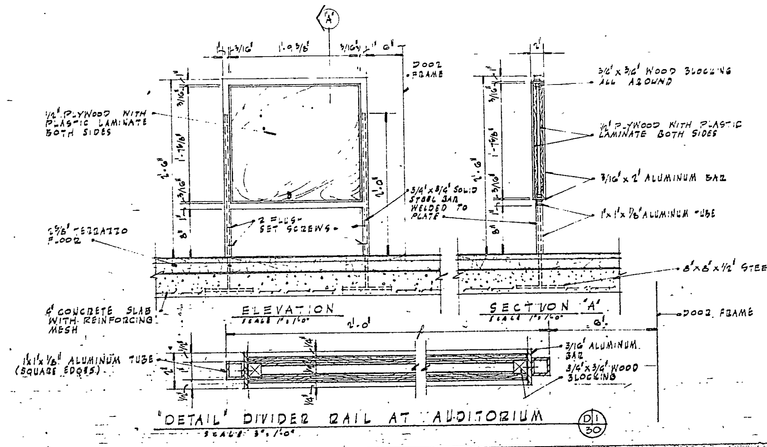

DETAIL DIVIDER RAIL AT AUDITORIUM

SCALE 3/4" = 1'-0"

EVERETT I. BROWN COMPANY -- ARCHITECTS & ENGINEERS

5500 BRADBURY AVENUE — PARK FLETCHER

INDIANAPOLIS INDIANA

SHEET G-30 OF 72

~~AS~~ BUILT

ADDITION TO CHESTERTON HIGH SCHOOL

68-A-12