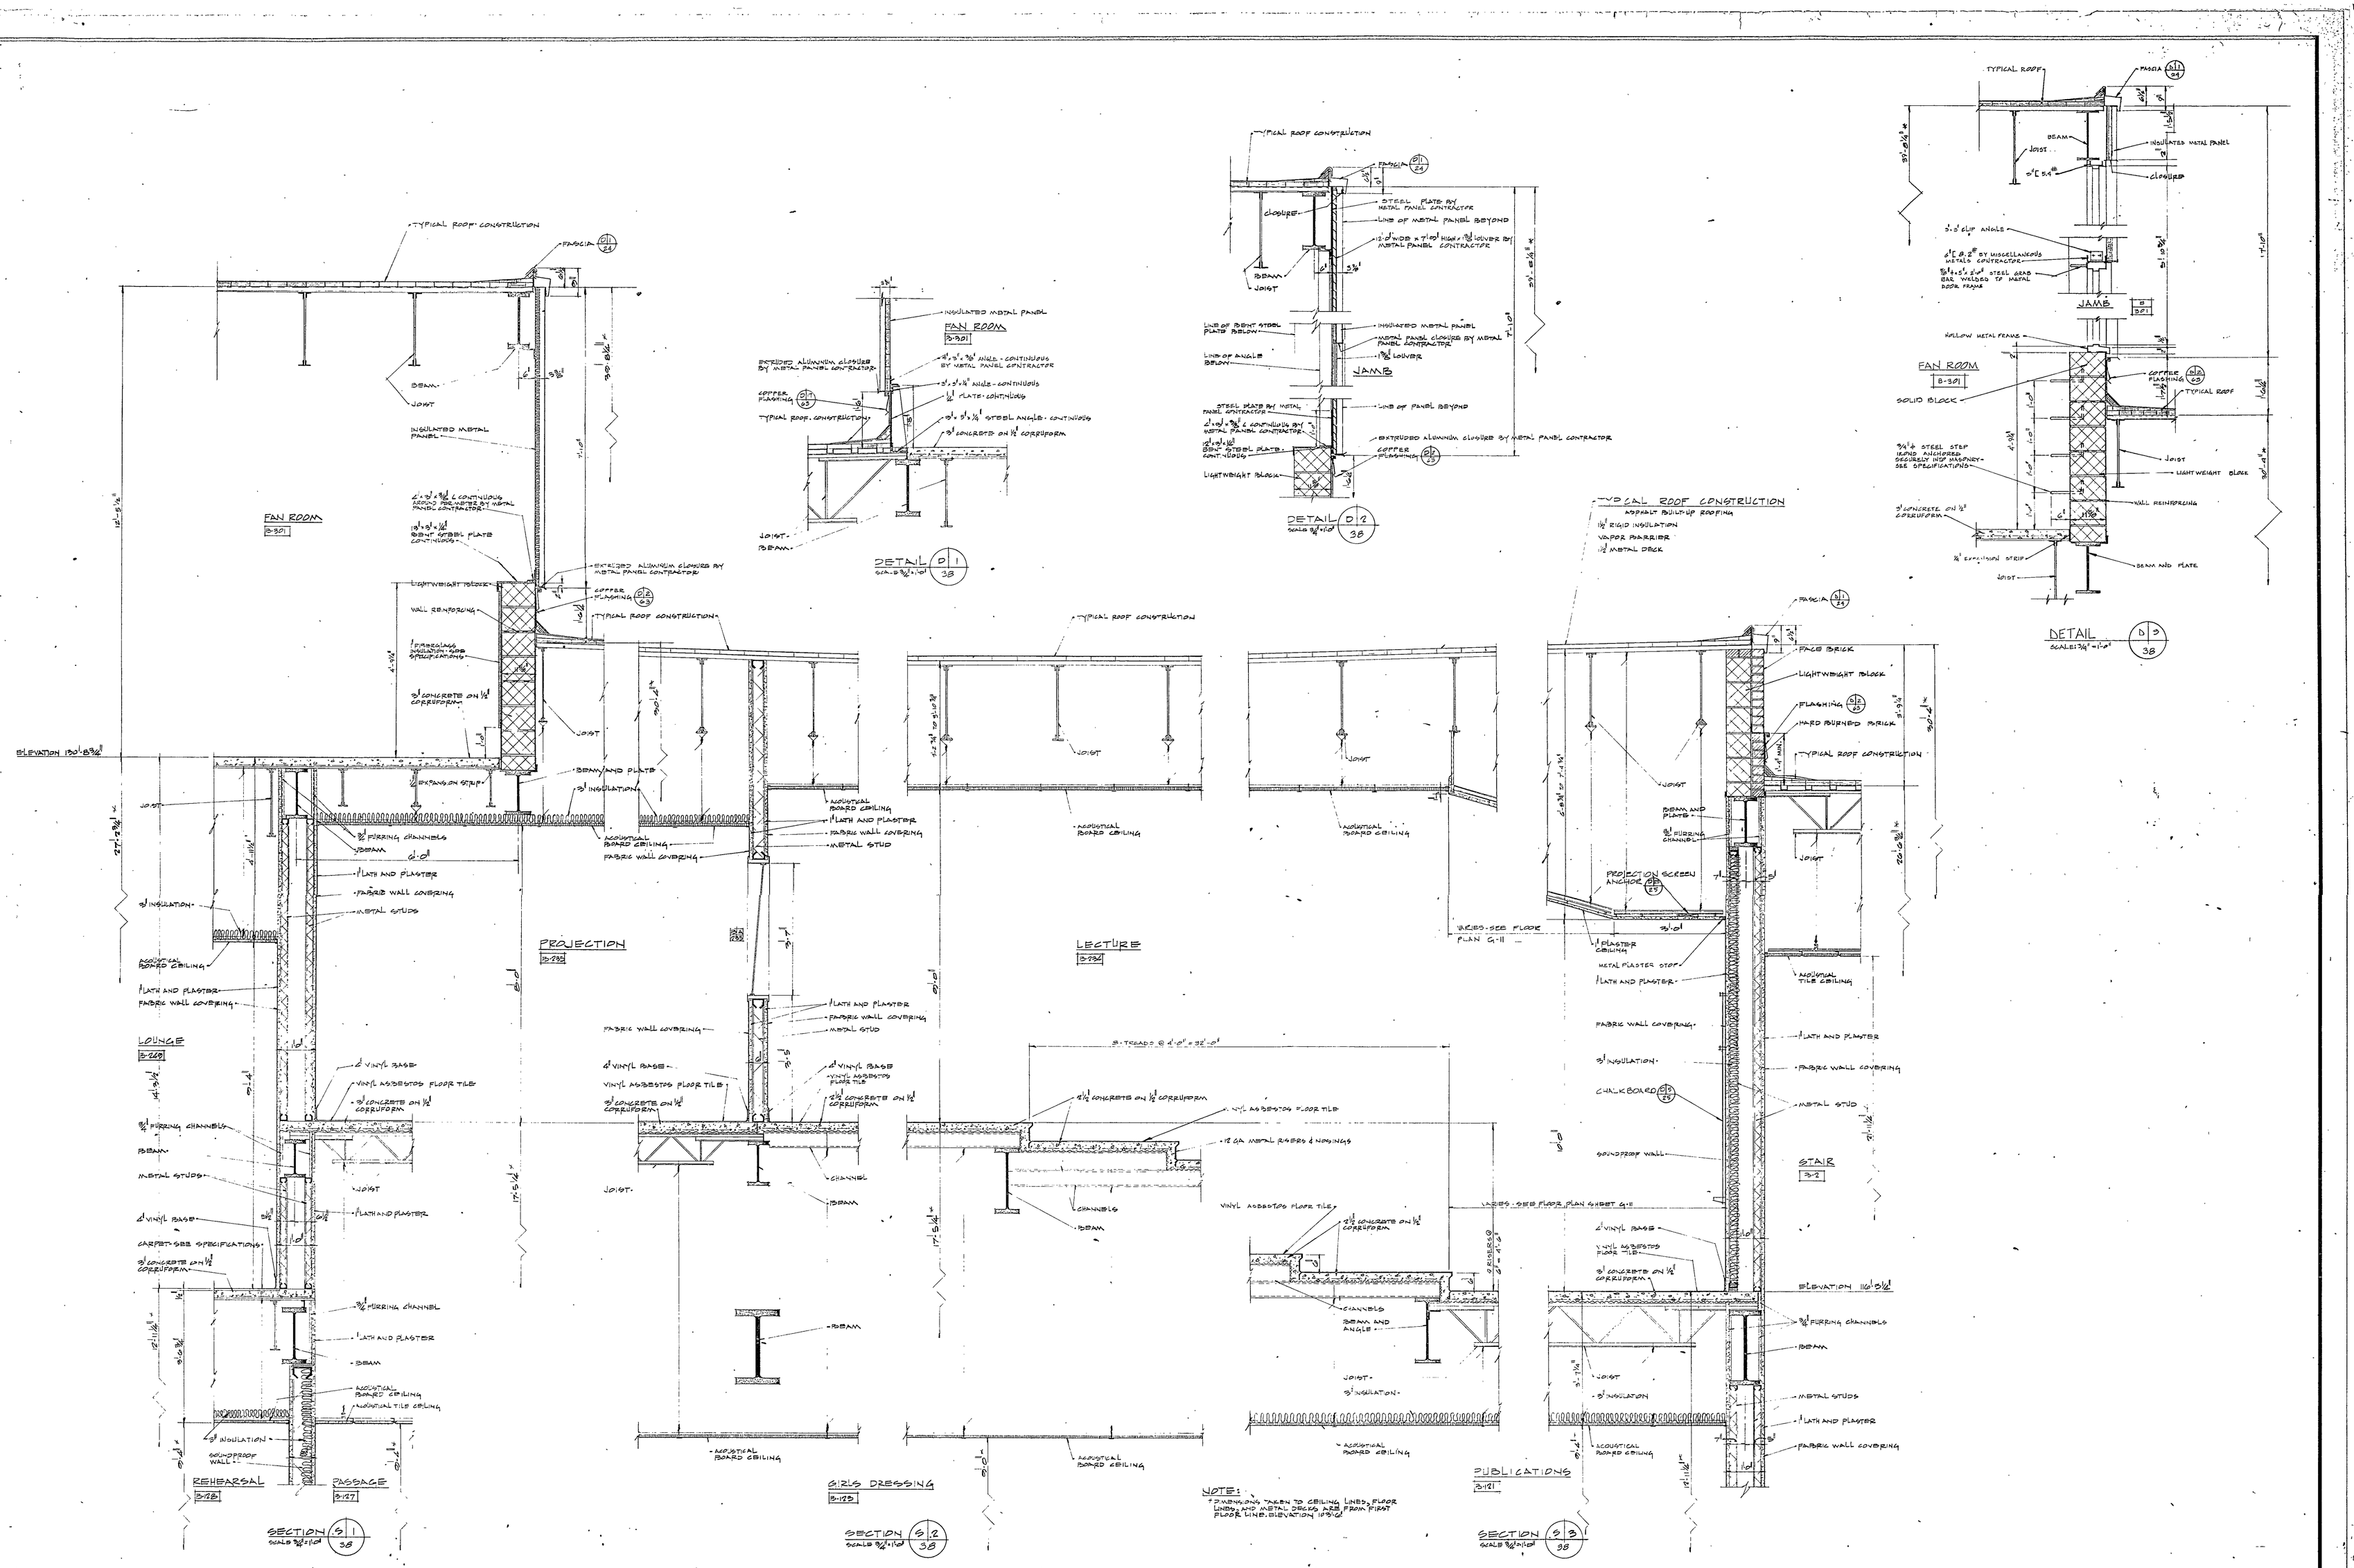


EVERETT I. BROWN COMPANY -- ARCHITECTS & ENGINEERS
5500 BRADBURY AVENUE — PARK FLETCHER
INDIANAPOLIS — INDIANA

SHEET G-38 OF 72
AS BUILT

ADDITION TO CHESTERTON HIGH SCHOOL

68-A-17