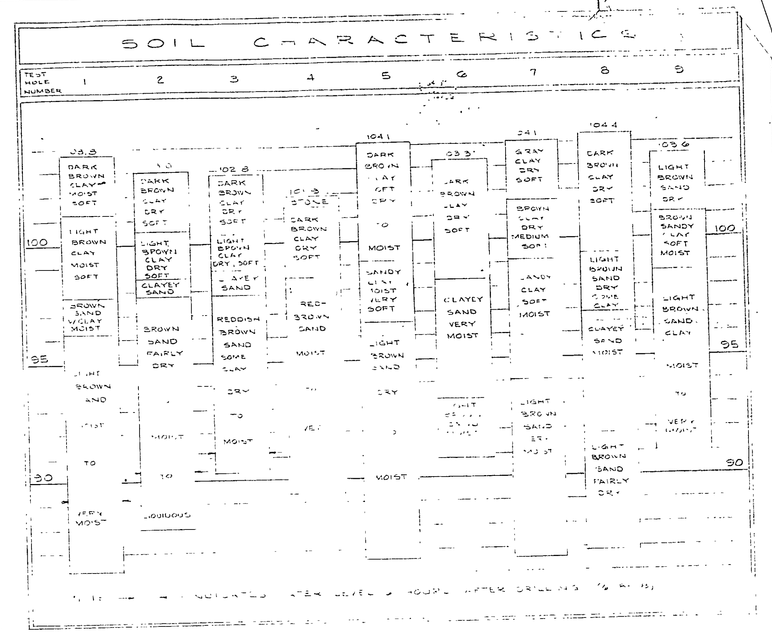

GENERAL NOTES

1. [illegible] IN ALTERNATE G-II TO [illegible] ON THIS SHEET [illegible] IN THE SPECIFICATIONS [illegible] ON THE DRAWINGS. IN THE SPECIFICATIONS [illegible] THE MINIMUM SHOP [illegible] INCLUDING HAVING [illegible] OF THE NEW ADDITION, ALL [illegible] ON SITE OF THE NEW ADDITION. ALL [illegible] ADDITIONAL [illegible] ON THE [illegible]

2. [illegible] ON ANY PLAN [illegible] ELEVATIONS SHOWN [illegible] ELEVATIONS SHOWN [illegible]

3. [illegible] ALL PAVINGS OF THE TYPES SHOWN TO THE FINISH ELEVATIONS [illegible] ELEVATIONS AND [illegible] OF [illegible] SURVEY [illegible] EXISTING PAVINGS AT [illegible] TO [illegible] OF EXISTING PAVINGS FROM VIEW TO [illegible] ADJACENT [illegible] SHALL BE SHELVED [illegible] ADAMS STREET, WHICH SHALL BE [illegible] THE EXISTING [illegible] AS INDICATED ON THE [illegible] SHALL BE CONSTRUCTED OF [illegible] AS RESURFACING ON [illegible]

4. GRADING [illegible] GRADE READY FOR SEED [illegible] AREAS MOUNDED [illegible]
(a) [illegible] PLAN [illegible] SUCCESSFULLY [illegible] THOSE EXISTING [illegible]
(b) GRADE AS SHOWN ON [illegible] TO SEMI-VERTICAL [illegible] IN SMOOTH PARABOLIC [illegible] ELEVATIONS [illegible] GRADES [illegible] FROM VAN TO EXISTING GRADES [illegible] ON THE [illegible] WITH [illegible] WITH [illegible] AFTER [illegible] THE GRADING [illegible] WITH [illegible] DISTRIBUTION UNDER THIS CONTRACT SHALL BE RESTORED TO THEIR ORIGINAL [illegible] UNDER COVERED ON [illegible]
(c) NO GRADE [illegible] INCLUDED IN THIS CONTRACT [illegible] CONSTRUCT IN EXCESS [illegible]
(d) [illegible] BUILT OR [illegible] ON [illegible] SHALL BE [illegible] AT [illegible] IN CHESTERTON [illegible] OPERATIONS.
THE GRADING OF [illegible] SITE [illegible] THE REGRADING [illegible] AND PAVING TO REMAIN THE [illegible] PLANTINGS PATTERN SET FORTH ON THE DRAWINGS.

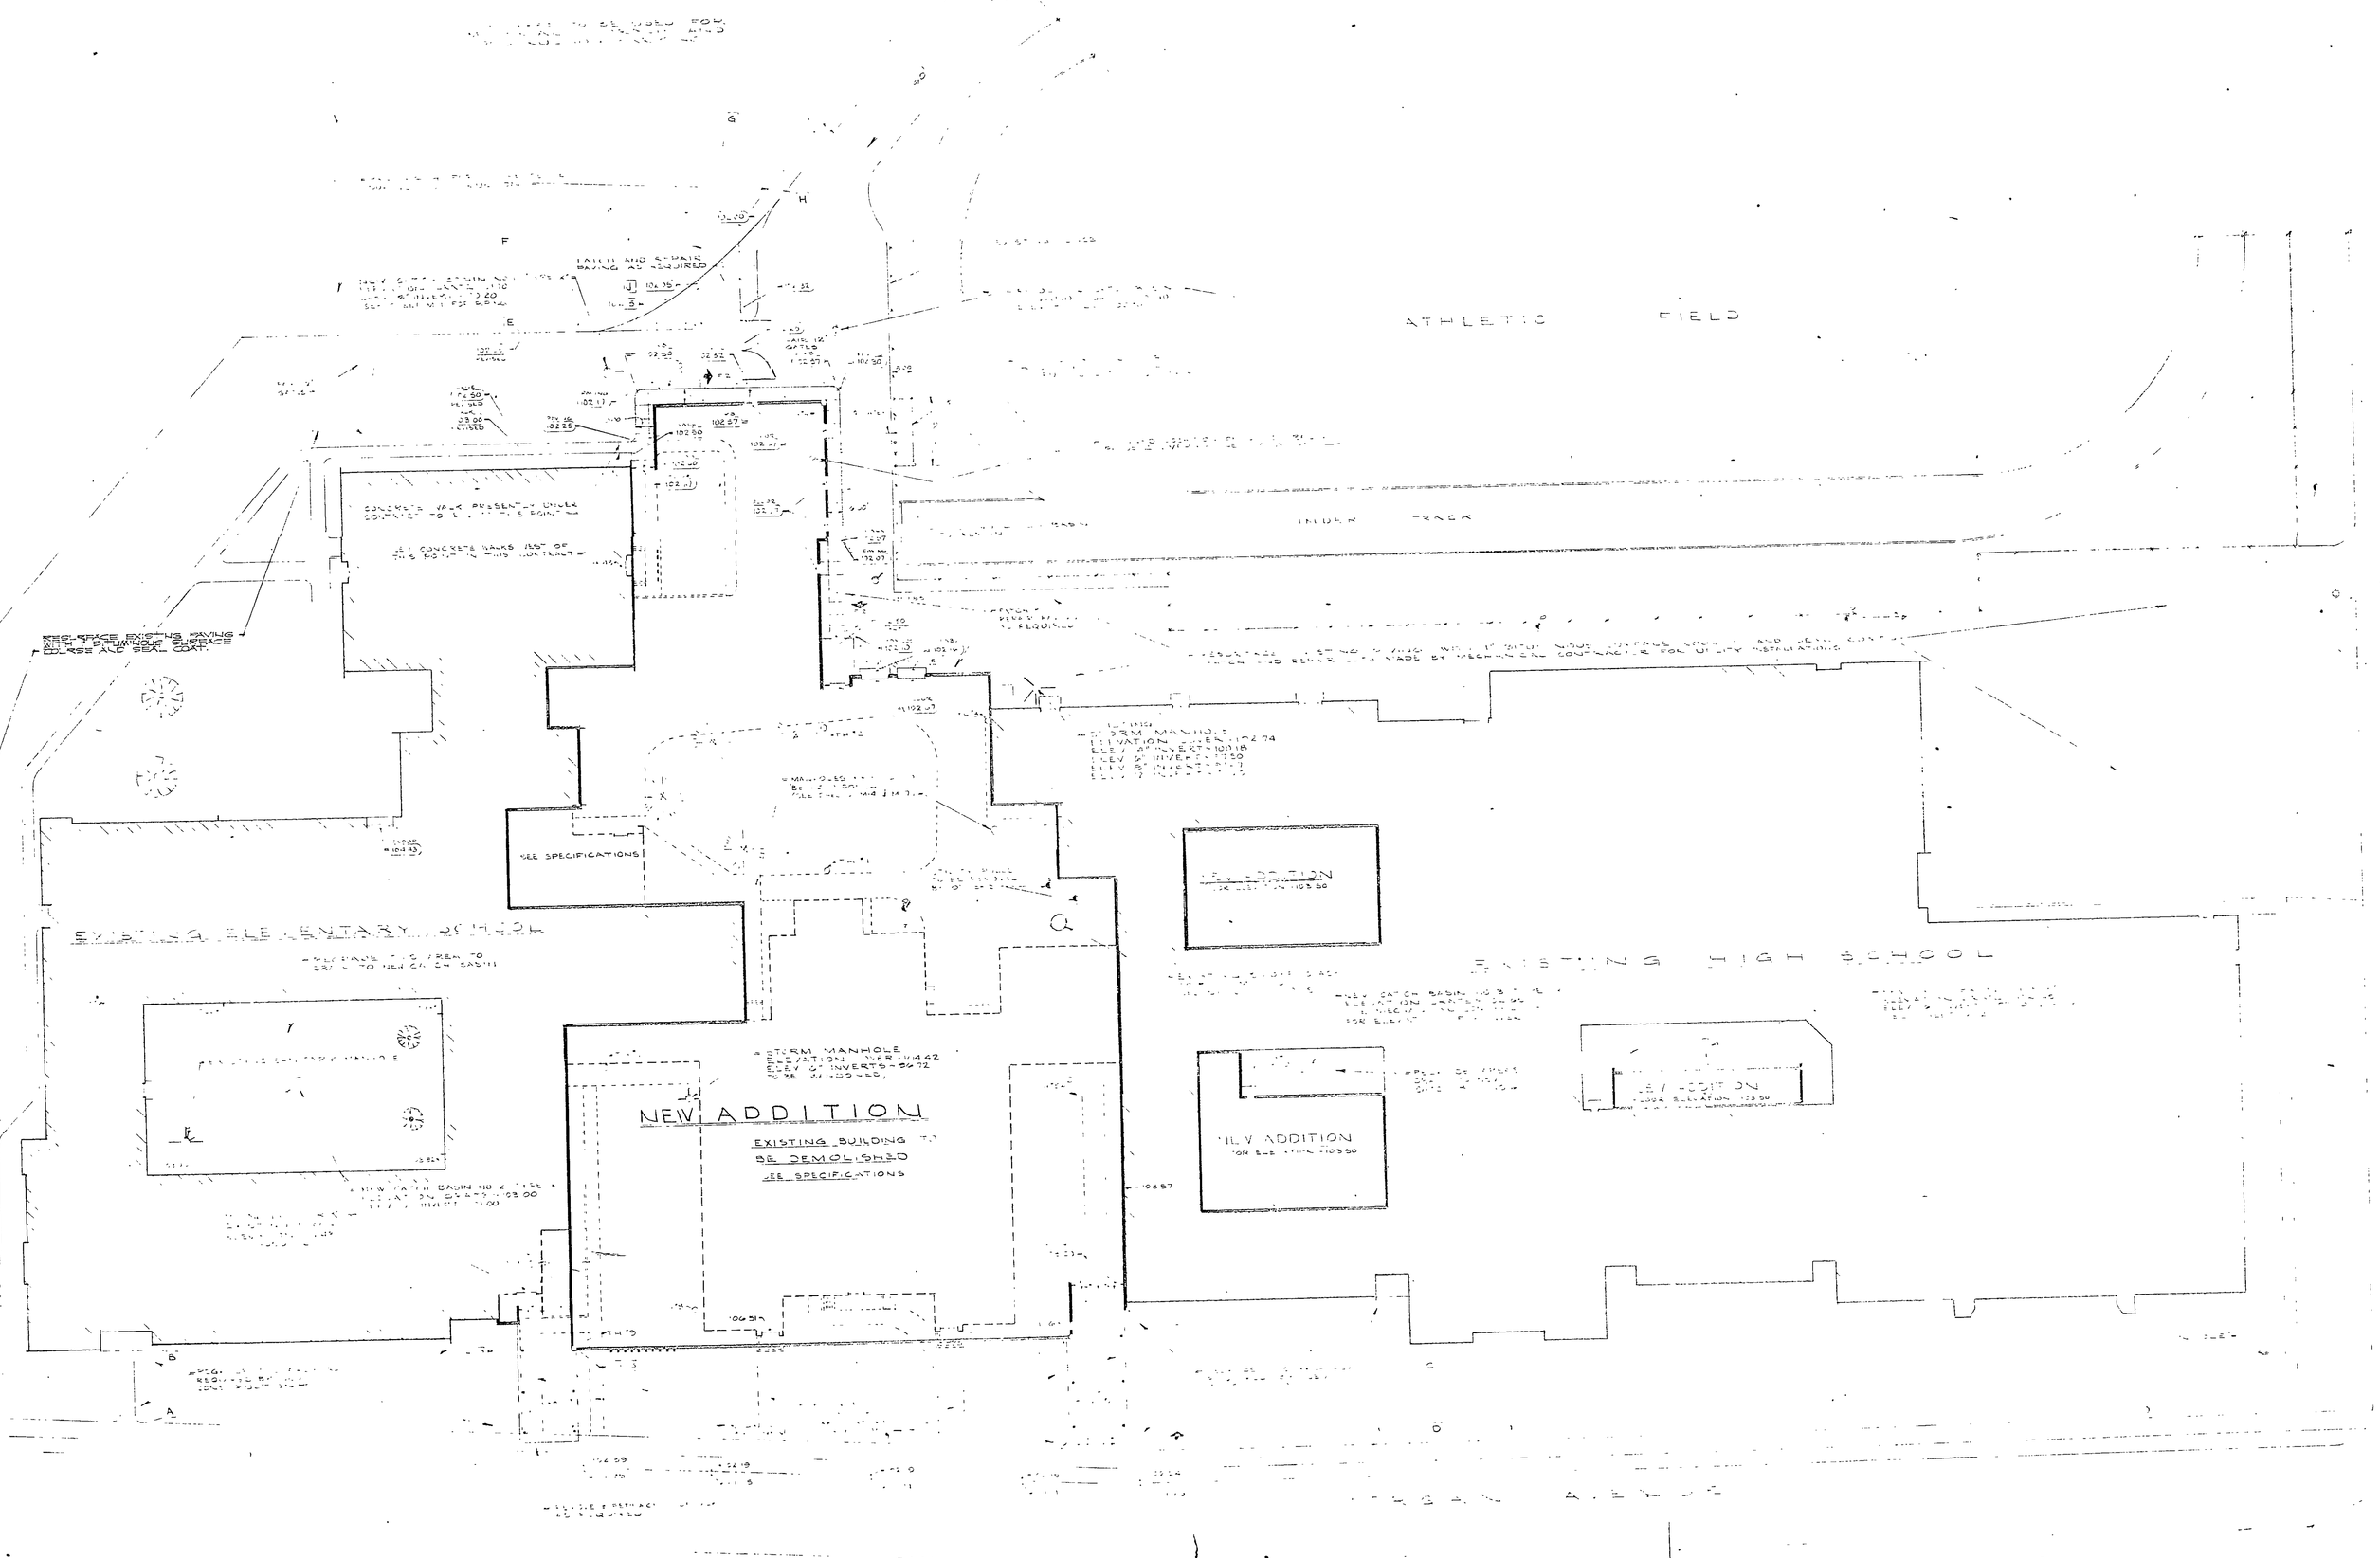

LEGEND

- EXISTING ELEVATION
- FINISH ELEVATION
- EXISTING BUILDING TO REMAIN
- EXISTING BUILDING TO BE DEMOLISHED
- NEW BUILDING
- NEW CONCRETE CURB
- NEW CONCRETE PAVING
- NEW BITUMINOUS PAVING
- CUT ON CUT
- INLET BASIN
- STORM SEWER
- MANHOLE
- SANITARY SEWER
- EXISTING SEWER
- UTILITY POLE
- VALLEY LINE
- TEST HOLE LOCATION
- DRAWING UNIT DESIGNATOR
- TREE TO BE PRESERVED
- TREE TO BE REMOVED

68-C-01

EVERETT I. BROWN COMPANY -- ARCHITECTS & ENGINEERS
5500 BRADBURY AVENUE — PARK FLETCHER
INDIANAPOLIS INDIANA

SHEET G-I OF 72
AS BUILT

ADDITION TO CHESTERTON HIGH SCHOOL