
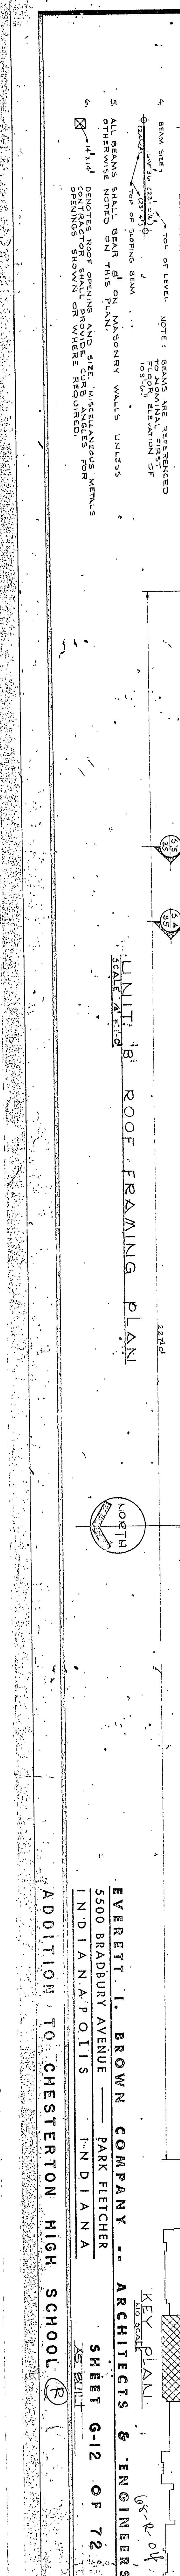



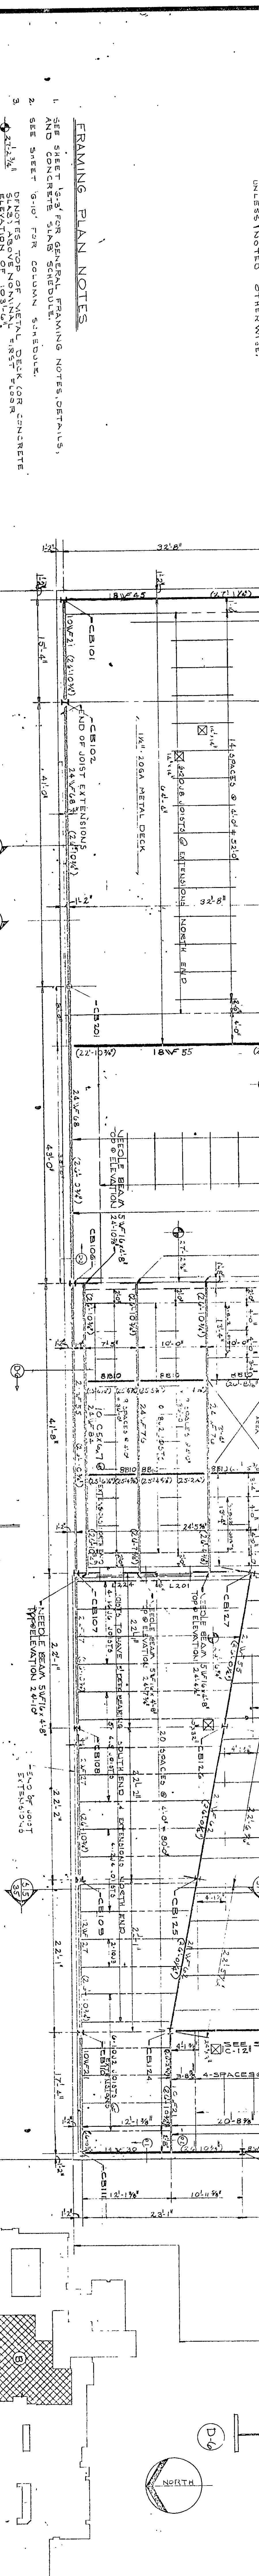

EVERETT L. BROWN COMPANY - ARCHITECTS & ENGINEERS
INDIANAPOLIS - INDIANA
SHEET G-12 OF 72