EVERETT I. BROWN COMPANY -- ARCHITECTS & ENGINEERS
5500 BRADBURY AVENUE — PARK FLETCHER
INDIANAPOLIS INDIANA

GB-S-04

TUNNEL FRAMING PLAN

SCALE: 1/8"=1'-0"

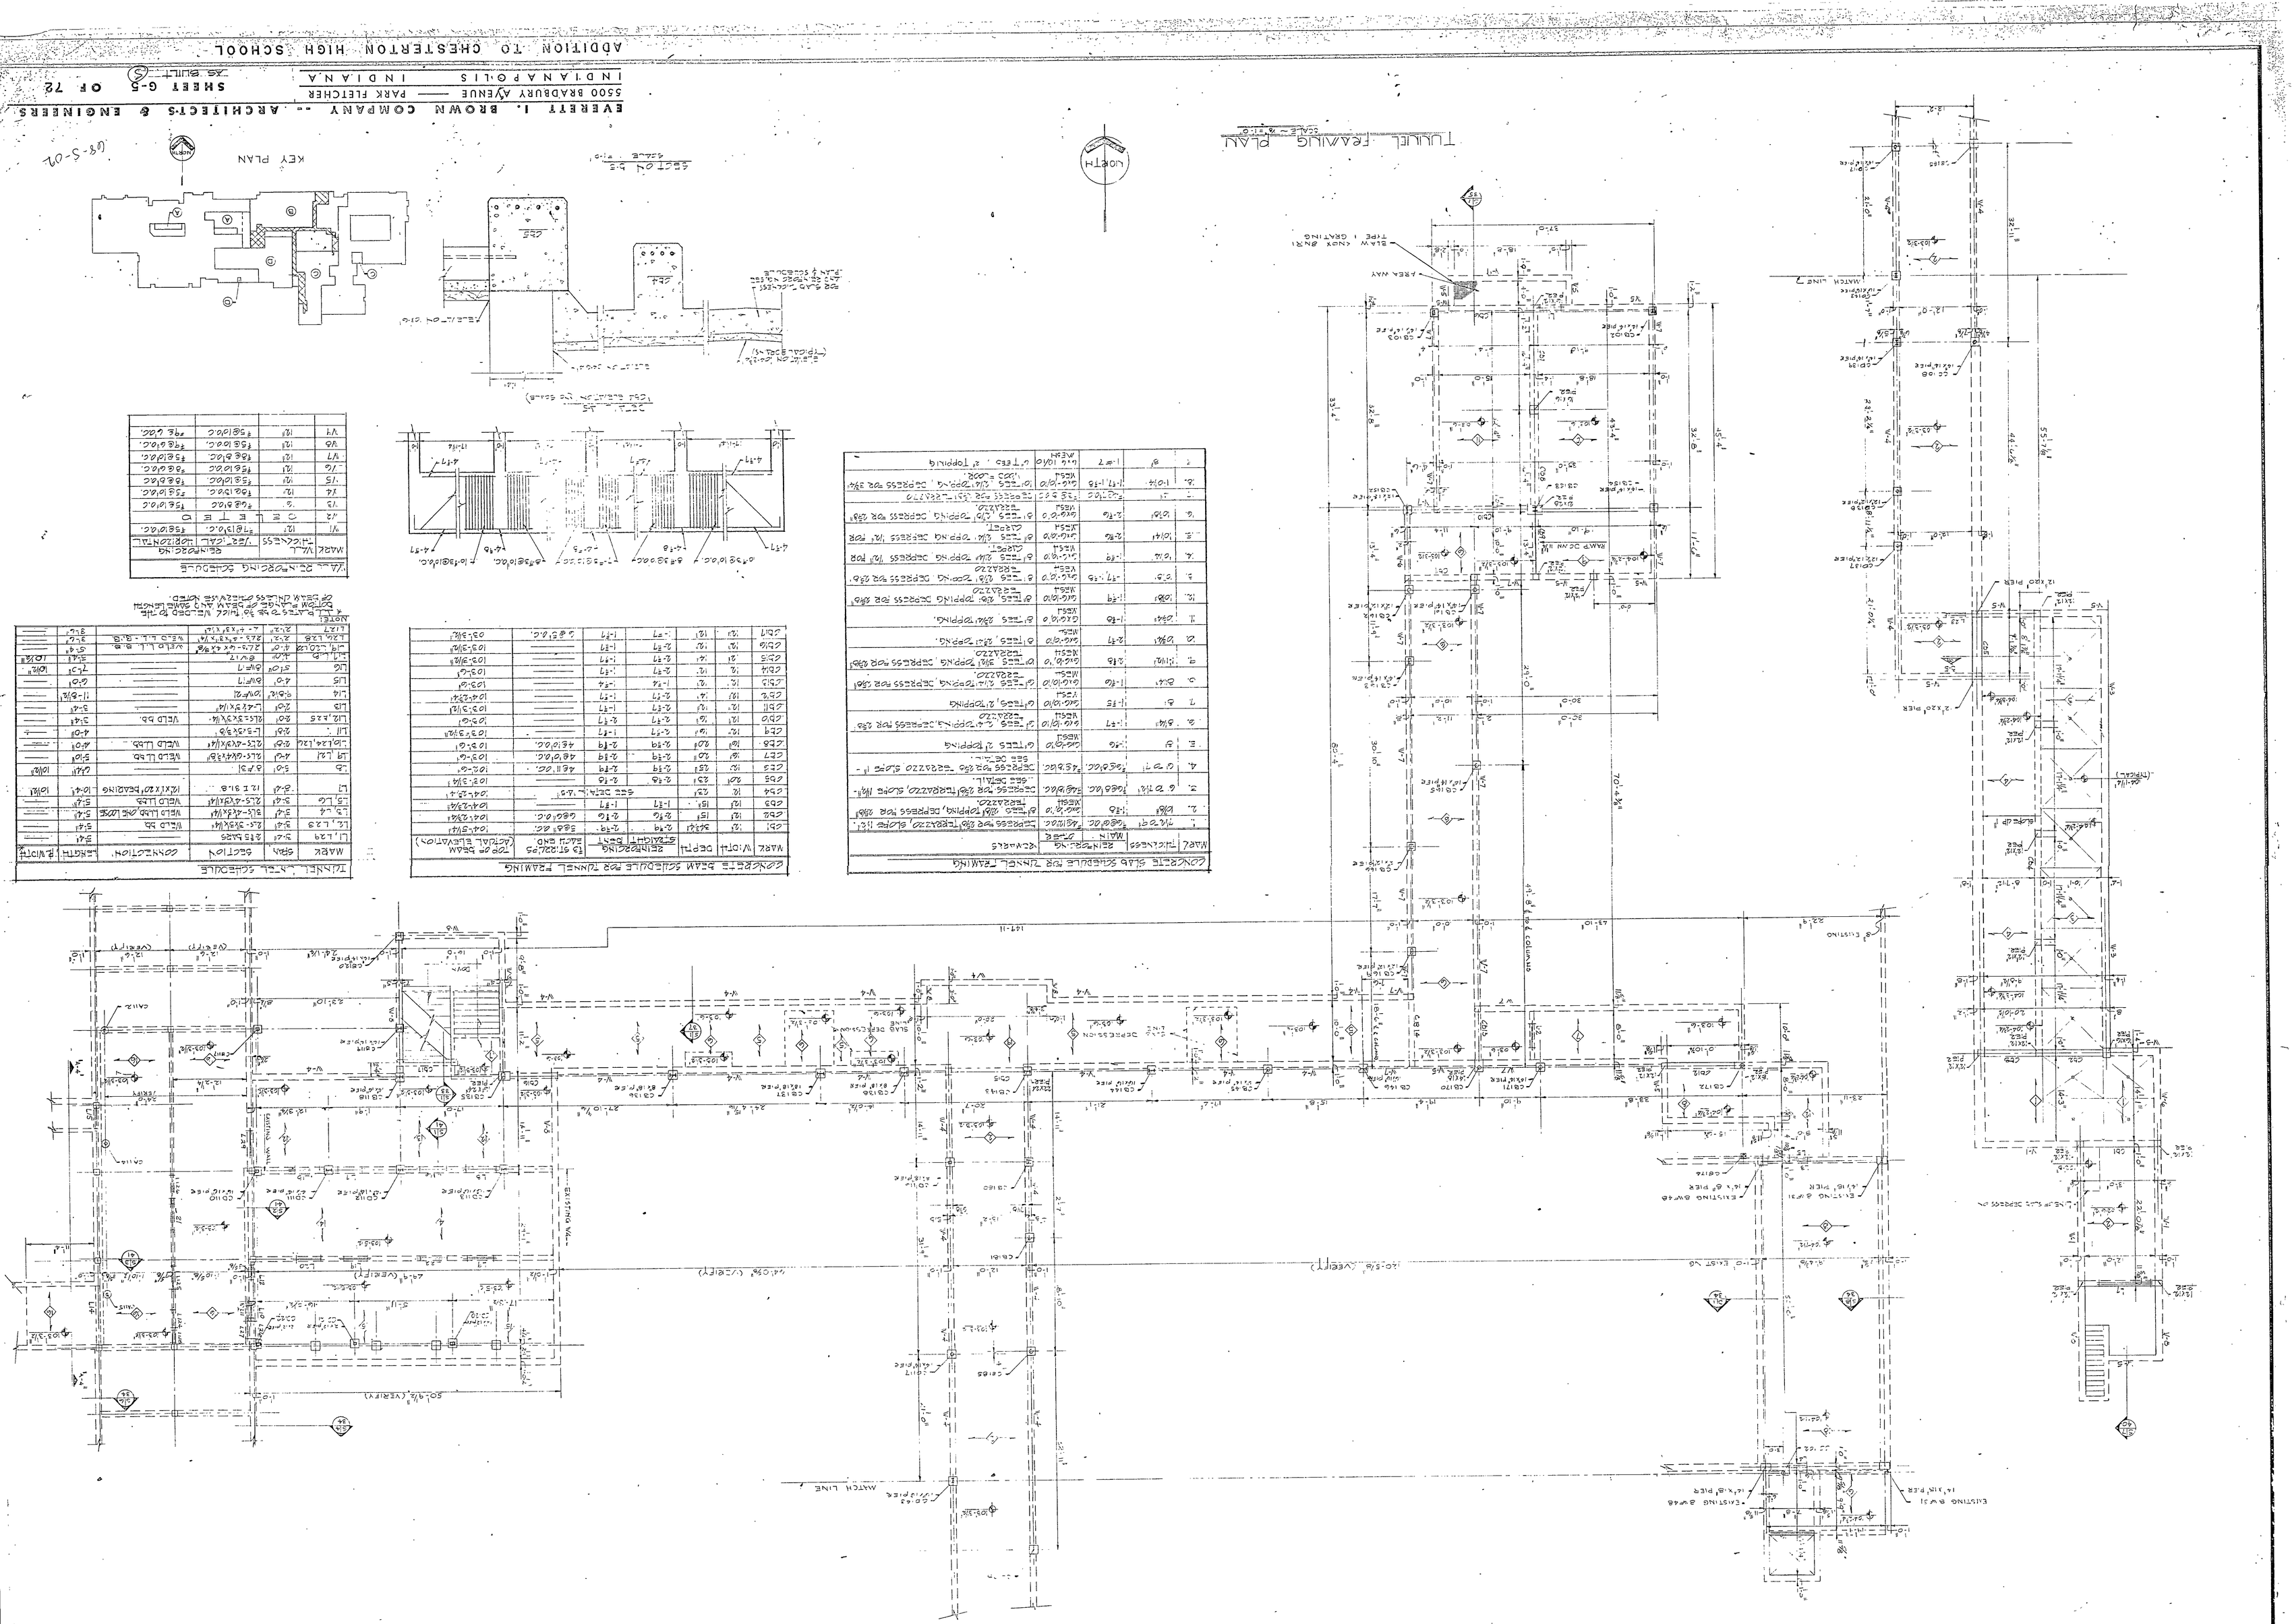

CONCRETE SLAB SCHEDULE FOR TUNNEL FRAMING

