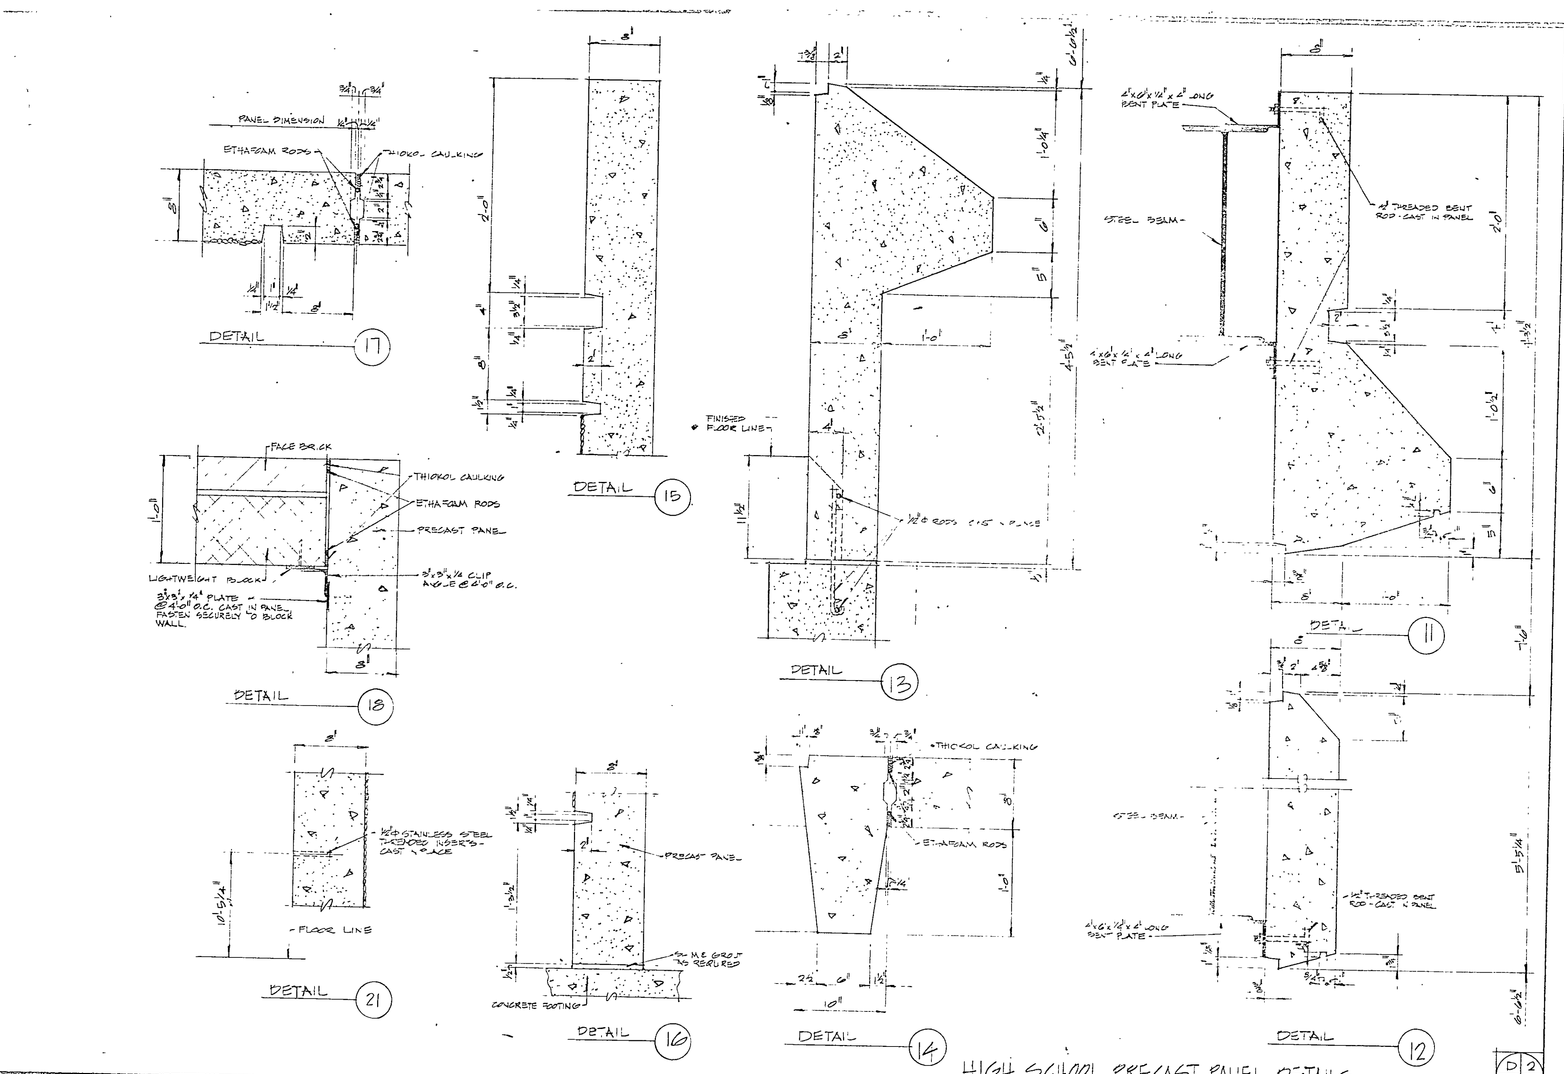

HIGH SCHOOL PRECAST PANEL DETAILS

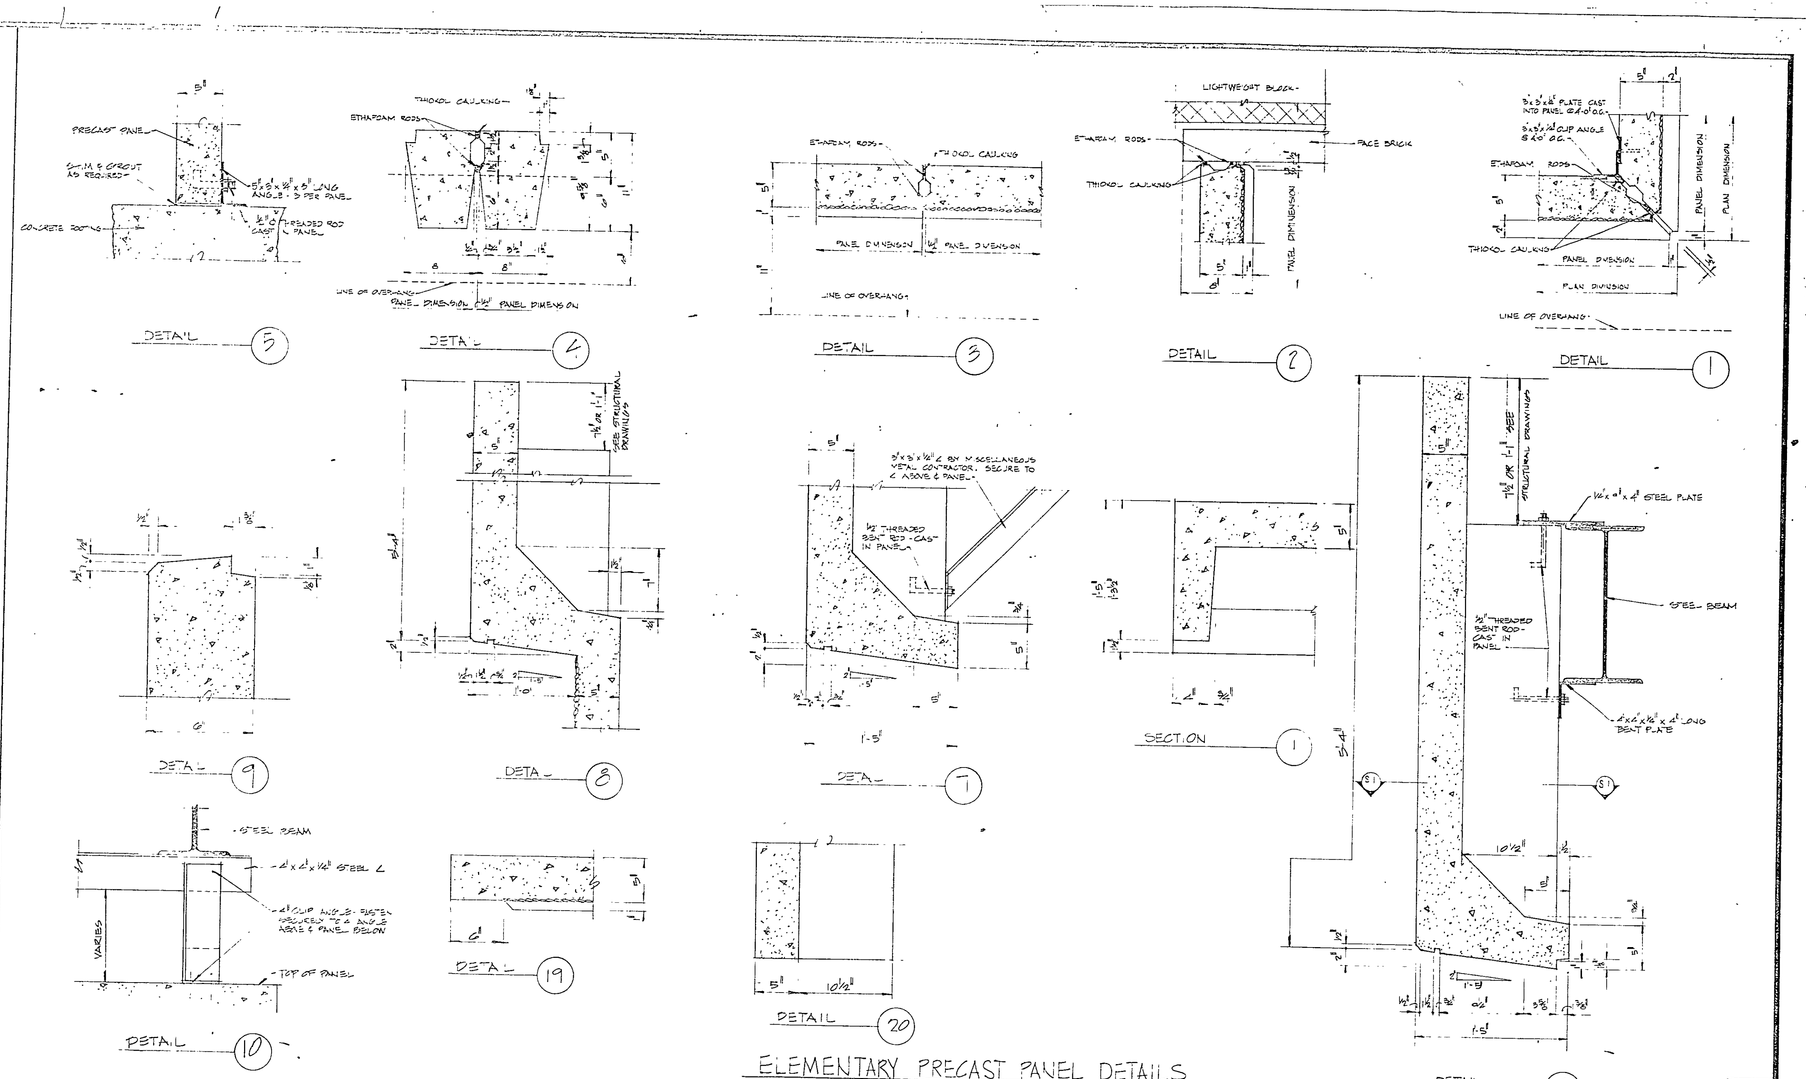

ELEMENTARY PRECAST PANEL DETAILS
SCALE: 1/4" = 1'-0"
(LIBERTY & BRUMMITT ACRES)

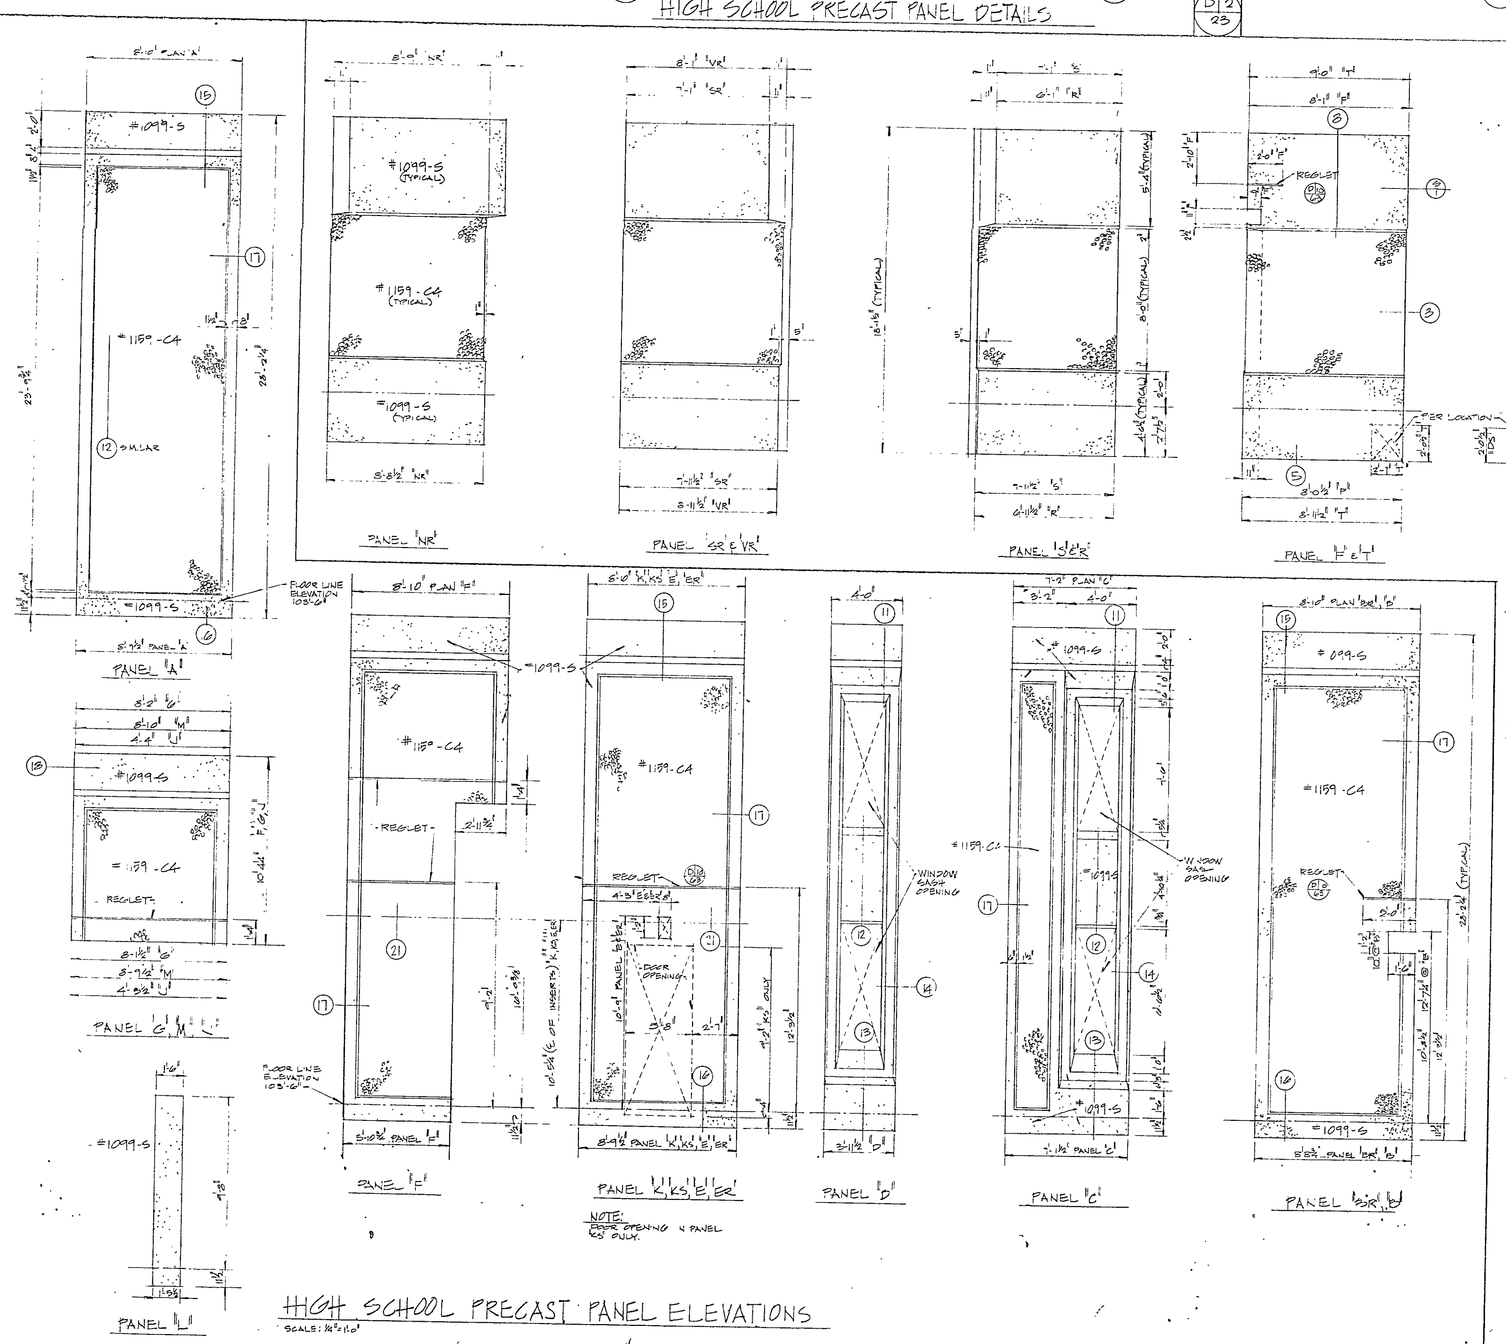

HIGH SCHOOL PRECAST PANEL ELEVATIONS
SCALE: 1/4" = 1'-0"

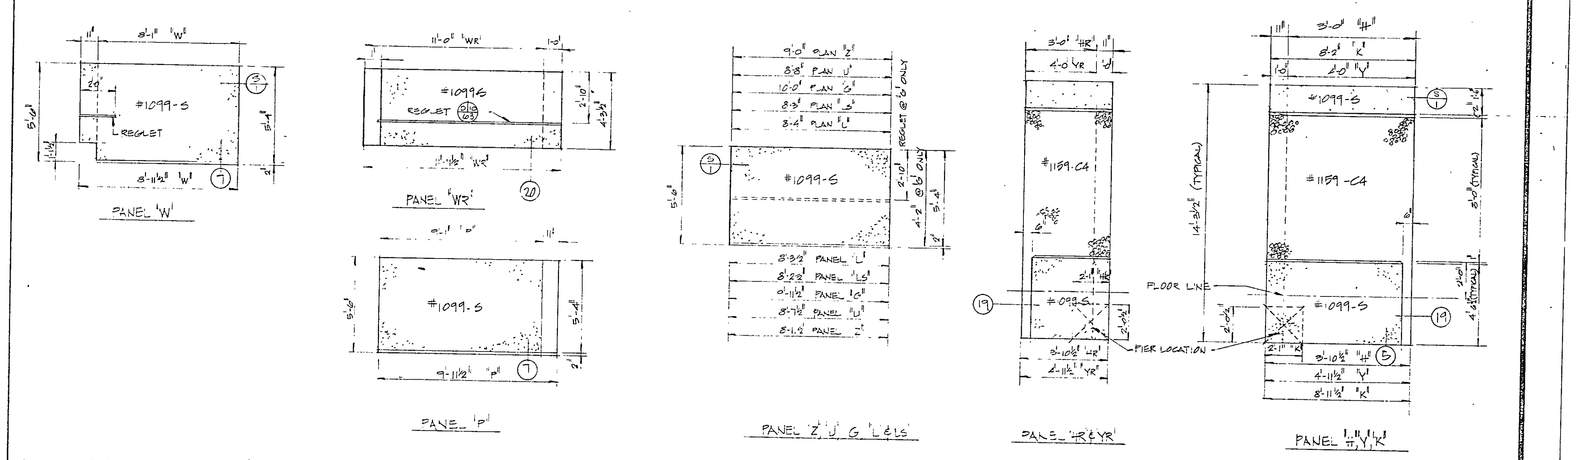

NOTE:
FINAL PRECAST PANEL SHOP DRAWINGS BUT NOT LIMITED TO THE SIZES, SIZE AND TYPE AND COLOR OF AGGREGATE AND THE LOCATION OF AREAS TO HAVE A SMOOTH FINISH SHALL BE SELECTED UPON THE SUCCESSFUL BIDDER AND ARCHITECT TO ANTICIPATE THAT THESE FINISHES SHALL BE SIMILAR TO NUMBERS #1159-C6, #1159-C4, AND #1099-S. SEE SPECIFICATIONS FOR DESCRIPTION.

ELEMENTARY PRECAST PANEL ELEVATIONS
SCALE: 1/4" = 1'-0"
(LIBERTY & BRUMMITT ACRES)

68-5-06

EVERETT I. BROWN COMPANY -- ARCHITECTS & ENGINEERS
5500 BRADBURY AVENUE — PARK FLETCHER.
INDIANAPOLIS INDIANA

SHEET G-23 OF 72
AS BUILT (3)

CHESTERTON H.S., LIBERTY AND BRUMMITT ACRES ELEM. SCHOOLS