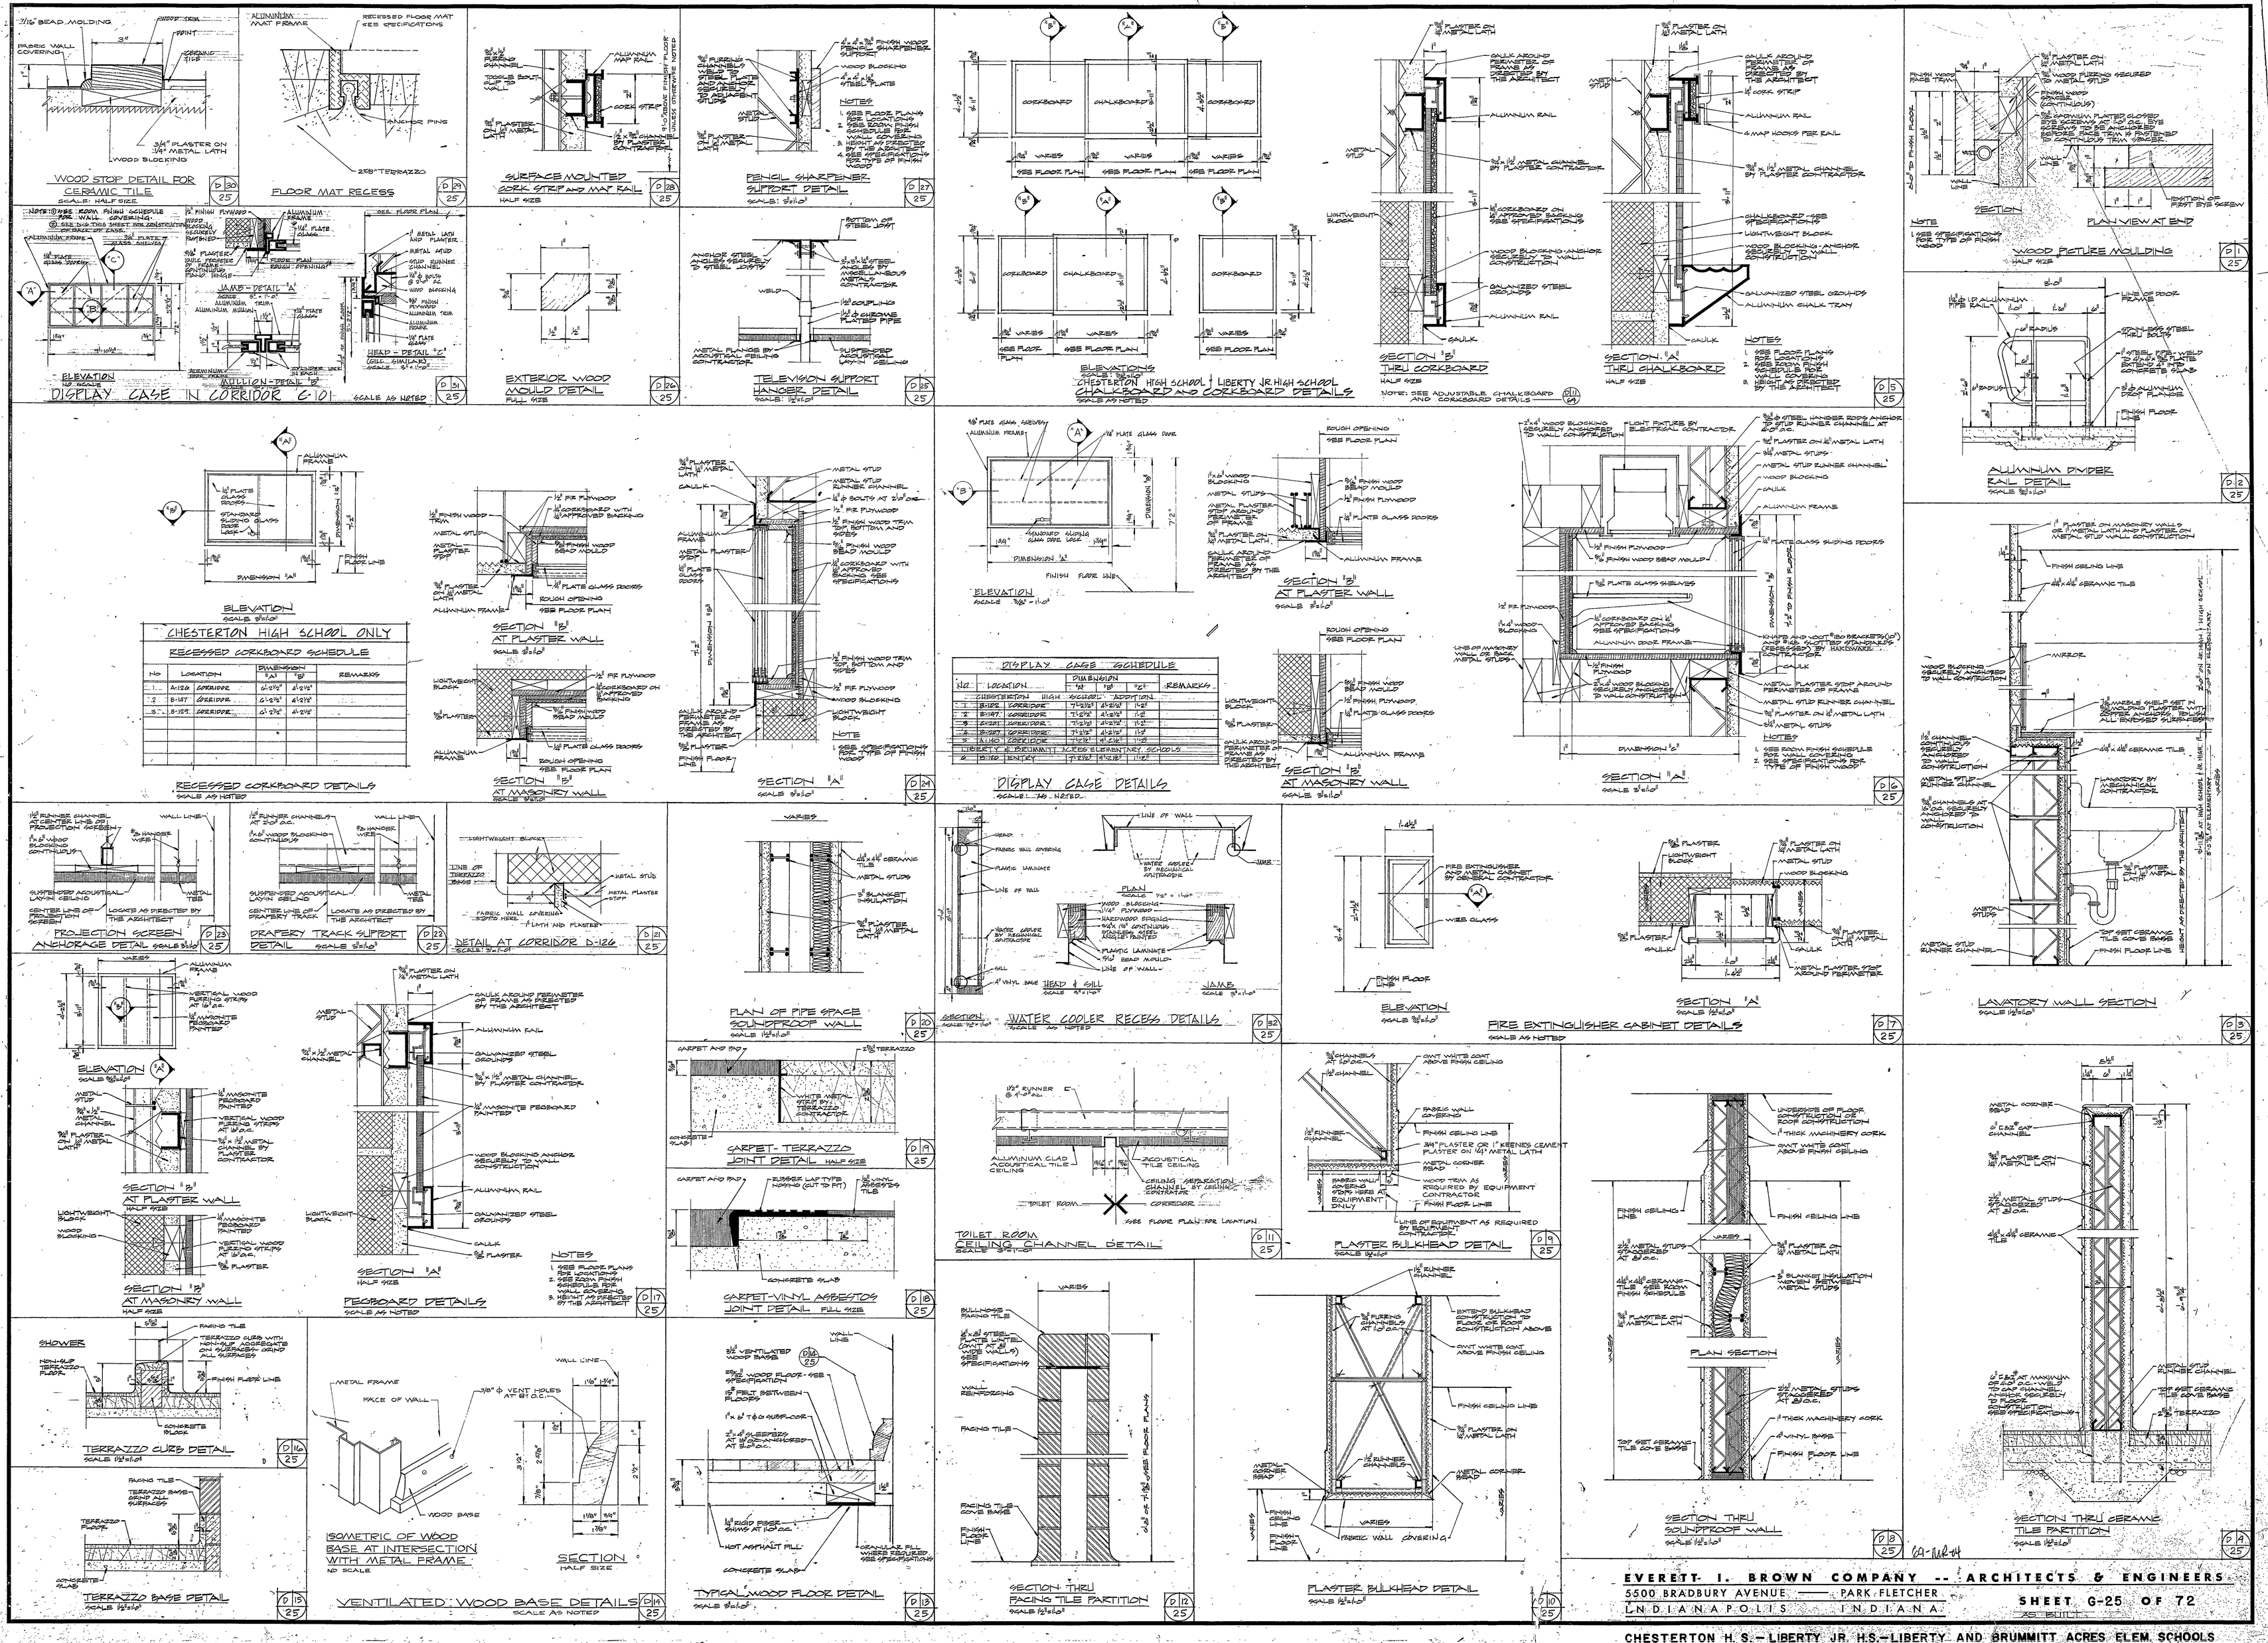

EVERETT I. BROWN COMPANY -- ARCHITECTS & ENGINEERS
5500 BRADBURY AVENUE — PARK FLETCHER
INDIANAPOLIS INDIANA

SHEET G-25 OF 72
AS BUILT

CHESTERTON H. S. – LIBERTY JR. H.S. – LIBERTY AND BRUMMITT ACRES ELEM. SCHOOLS